

PERMIT NUMBER: B 27001568

DATE ACCEPTED:



RESIDENTIAL BUILDING PERMIT APPLICATION

HOWARD COUNTY DEPARTMENT OF INSPECTIONS, LICENSES, AND PERMITS

3430 COURT HOUSE DRIVE, ELLICOTT CITY, MD 21043 - PHONE: (410) 313-2455 OPTION #4
www.howardcountymd.gov

BUILDING SITE ADDRESS REQUIRED

Street Address: 15685 Old Frederick Rd		Unit:
City: Woodbine	State: MD	Zip Code: 21797
Subdivision/Village/Complex Name:		SDP/WP/BA #:
Lot:	Tax Map:	Parcel:
Grading Permit #:		

DESCRIPTION OF WORK REQUIRED

Existing Use: Barn	Proposed Use: Deck off barn	Estimated Cost: \$ 10,000-
Trade Work to Be Completed (Separate Permits Required): <input type="checkbox"/> Mechanical (HVACR) <input type="checkbox"/> Electrical <input type="checkbox"/> Plumbing <input type="checkbox"/> None		
Construct 15'x50' covered porch w/new deck Construct 15'x50' covered porch w/new deck NO STEPS (Future solar panels)		

PROPERTY OWNER INFORMATION REQUIRED

Owner(s) Name(s) (As it appears on tax records): Wynne Family, LLC	Primary Residence: <input type="checkbox"/> Yes <input checked="" type="checkbox"/> No
Owner's Street Address: 15685 Old Frederick Rd	
City: Woodbine	State: Md
Phone: 410-991-0665	Email: wynnebusiness@gmail.com
Zip Code: 21797	

APPLICANT NAME REQUIRED - INDIVIDUAL WHO SIGNS THIS APPLICATION

Business Name: Wynne Family, LLC	Contact Name: Brian Wynne
Street Address: 15685 Old Frederick Rd	
City: Woodbine	State: Md
Phone: 410-991-0665	Email: wynnebusiness@gmail.com
Zip Code: 21797	

CONTRACTOR INFORMATION REQUIRED

Business Name: S+B Services	License #: 88479
Licensee's Name: Dale Chippis	
Street Address: 703 Fairway Dr	
City: Annapolis	State: Md
Phone: 443-463-4777	Email: DALECHIPPIS@gmail.com
Zip Code: 21409	

ARCHITECT/ENGINEER INFORMATION INDIVIDUAL WHO SIGNED PLANS, IF APPLICABLE

Business Name:	Name:
Street Address:	
City:	State:
Phone:	Email:
Zip Code:	

BUILDING CHARACTERISTICS REQUIRED

Primary Structure: <input type="checkbox"/> SF Dwelling <input type="checkbox"/> SF Townhouse <input type="checkbox"/> SF Duplex <input type="checkbox"/> Mobile Home <input type="checkbox"/> Multi-Family Dwelling (MF*)	Condo: <input type="checkbox"/> Yes <input checked="" type="checkbox"/> No
Utilities: <input type="checkbox"/> Electric <input type="checkbox"/> Gas	Water Supply: <input type="checkbox"/> Public <input checked="" type="checkbox"/> Private (Well)
Sewage Disposal: <input type="checkbox"/> Public <input checked="" type="checkbox"/> Private (Septic)	
Heating System: <input type="checkbox"/> Electric <input type="checkbox"/> Natural Gas <input type="checkbox"/> Propane <input type="checkbox"/> Other:	Roadside Tree Project: <input checked="" type="checkbox"/> No <input type="checkbox"/> Yes: #
Sprinkler System: <input type="checkbox"/> NFPA 13 <input type="checkbox"/> NFPA 13R <input type="checkbox"/> NFPA 13D <input type="checkbox"/> None	Fire Alarm System: <input type="checkbox"/> Yes <input type="checkbox"/> No <input type="checkbox"/> Voice Evac

ADDITIONAL RESIDENTIAL INFORMATION (PLEASE SELECT/COMPLETE ALL THAT APPLY)

Model Name & Options:				
# of Bedrooms (SF):	# of efficiency units (MF*):	# of 1 BR (MF*):	# of 2 BR (MF*):	# of 3 BR (MF*):
# Rooms:	# Full Baths:	# Half Baths:	# Fireplaces:	
Garage/Carport Info: <input type="checkbox"/> Attached Garage <input type="checkbox"/> Detached Garage <input type="checkbox"/> Integral Garage <input type="checkbox"/> Carport <input type="checkbox"/> None				
Basement/Foundation Info: <input type="checkbox"/> Slab on Grade <input type="checkbox"/> Post & Pier <input type="checkbox"/> Unfinished Basement <input type="checkbox"/> Finished Basement: <input type="checkbox"/> Full or <input type="checkbox"/> Partial				
1st Fl Width:	1st Fl Depth:	2nd Fl Width:	2nd Fl Depth:	Bsmt Width:
Bsmt Depth:				
Energy Method: <input type="checkbox"/> Prescriptive <input type="checkbox"/> Performance <input type="checkbox"/> UA Alternative <input type="checkbox"/> ERI		Gross Area: sq ft	Occupiable Area: sq ft	

AGREEMENT/ DISCALIMER REQUIRED

THE UNDERSIGNED HEREBY CERTIFIES AND AGREES AS FOLLOWS: (1) THAT HE/SHE IS AUTHORIZED TO MAKE THIS APPLICATION; (2) THAT THE INFORMATION IS CORRECT; (3) THAT HE/SHE WILL COMPLY WITH ALL REGULATIONS OF HOWARD COUNTY WHICH ARE APPLICABLE THERETO; (4) THAT HE/SHE WILL PERFORM NO WORK ON THE ABOVE REFERENCED PROPERTY NOT SPECIFICALLY DESCRIBED IN THIS APPLICATION; (5) THAT HE/SHE GRANTS COUNTY OFFICIALS THE RIGHT TO ENTER ONTO THIS PROPERTY FOR THE PURPOSE OF INSPECTING THE WORK PERMITTED AND POSTING NOTICES.

APPLICANT'S ORIGINAL SIGNATURE: *[Signature]* DATE SIGNED: 4/19/22


FOR OFFICE USE ONLY

CHECKS PAYABLE TO: DIRECTOR OF FINANCE OF HOWARD COUNTY

AGENCIES REQUIRED/APPROVALS:					
<input checked="" type="checkbox"/> PR	<input type="checkbox"/> DPZ	<input checked="" type="checkbox"/> DED	<input checked="" type="checkbox"/> Health	<input type="checkbox"/> SHA	<input type="checkbox"/> CID
SUBMITTAL FEES: 2500		PAYMENT: CAH 1170		ACCEPTED BY: <i>[Signature]</i>	

Elevations	House Grading Information
579.50	Basement Slab Elevation (B.S.E.) at top of 4" concrete slab
579.17	Top of Footing
588.17	Top of 9' high Foundation Wall (ToFW)
589.13	First Floor Elevation (F.F.E. = ToFW + single plate + 2x10 floor Joist + fir board)
588.63	Porch Elevation (at 6" below F.F.E.)
586.13	Finish Grade Below front Porch, 30" max. for no railing
	5 risers Number of risers needed between front porch and leadwalk if 6" riser height
	4 risers Number of risers needed between front porch and leadwalk if 7" riser height
587.83	Garage Rear Elevation (Down 4" from ToFW)
	3 risers Number of Risers Needed between F.F.E. & Garage
587.42	Garage Front Elevation (at bottom of 1" weather lip)

PROPOSED DRYWELL (M-5) SIZE CHART		
DRYWELL No.	LENGTH x WIDTH	DEPTH OF STONE
DW#1	12' x 5'	5'
DW#2	10' x 5'	5'
DW#3	10' x 5'	5'
DW#4	10' x 5'	5'
DW#5	10' x 5'	5'

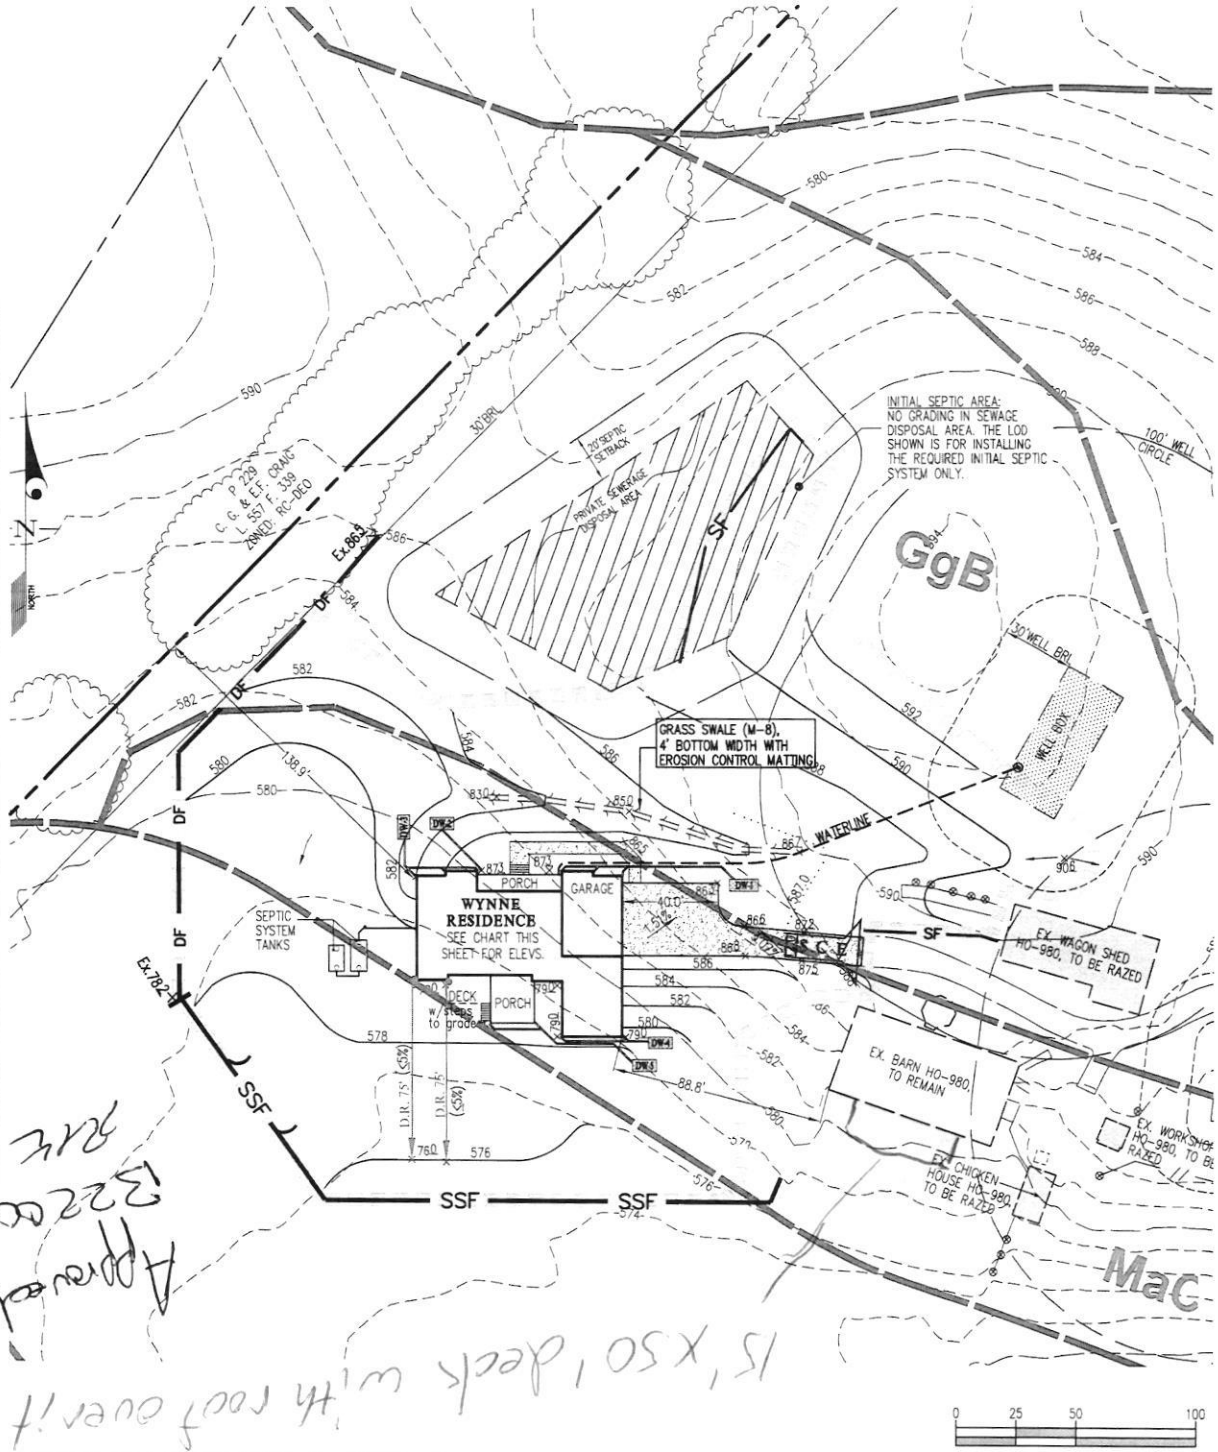

BUILDING PERMIT PLOT PLAN

<p>GLW PLANNING ENGINEERING SURVEYING</p>	DES.	PREPARED FOR:	15685 OLD FREDERICK ROAD WYNNE PROPERTY Tax Parcel 2 (Tax Account No. 315383)	G. L. W. No.	21020
	DRN.	OWNER:		ZONING	RC-DEO
	CHK.	BRIAN WYNNE 2065 HIGHWAY A1A UNIT 1201 INDIAN HARBOUR BEACH, FLORIDA 32937 wynnebrian65@gmail.com		TAX MAP/GRID	8-1
				DATE	AUGUST 2021
			SCALE	1"=50'	
			SHEET	1 OF 2	