

Record Detail * (This section is required.)

Permit Type	Permit Number	Opened Date
Building/Residential/Misc/Porch	B22001648	04/29/2022

Description of Work
 SFD/ CONSTRUCT 23' X 14' SCREENED PORCH, CONSTRUCT 14' X 10' OPEN PORCH, CONSTRUCT 18' X 12' OPEN DECK WITH STAIRS AND LANDING TO GRADE

Approved MK
 5/3/2022
 HL AL

[check spelling](#)

Address * (This section is required.)

Search Reset Clear Get Parcel & Owner

Street #	Street Name	Street Type
7429	HAVEN	CT
Unit Type	Unit #	X Coordinate
--Select--		-76.95138
		Y Coordinate
		39.16902
City	State	Zip Code
HIGHLAND	MD	20777
	Primary	Yes

Parcel * (This section is required.)

Search Reset Clear Get Address & Owner

GIS ID *	Parcel	Parcel Area	Land Value	Improved Value	Exemption Value	Plan Area
11058637	93	1.29	252800	1130100	877300	RURAL

Legal Description
 IMPSLOT 5 1.2886 A.[]7429 HAVEN CT[]ESTAES @ SCHOOLEY MILL

[check spelling](#)

Block	Lot	Census Tract	Council Dist	Inspection Dist	Supervisor Dist	Map #	DAP Zone
	5	605102	5				
Plan Area		State Tax Id		Subdivision Name			
		1405600713		Estates at Schooley Mill			
Section		Area		Tax Map			
				40			
Grid		Zoning District		ADC Map			
40-11		RR-DEO		5051-H3			
SDP No.		Final Plan No.		WP File No.			
		ECP-16-044					
Record Plat No.		WS Contract No.		FDP No.	Primary		
24576-2458					Yes		
Owner Occupied		Year Built		Historic District			
<input type="radio"/> Yes <input type="radio"/> No		2021		<input type="radio"/> Yes <input checked="" type="radio"/> No			
Historic District Registry No.		Stat Area		Flood Plain			
		5-15A		<input type="radio"/> Yes <input checked="" type="radio"/> No			
Building No							

Owner * (This section is required.)

Search Reset Clear

Name *
 TODD C. GARRIGUES
 Address Line 1
 7429 HAVEN COURT
 Address Line 2

Address Line 3

Mail City	Mail State	Mail Zip Code
HIGHLAND	MD	20777
Phone	Primary	
503-970-4663	Yes	
E-mail		

Cell Number _____ Fax Number _____

Professionals (This section is not required.)

Search Reset Clear

License # * 08010095285
License Type * MHIC Ind
Primary Yes

Business Name TIMELESS CONSTRUCTION
First Name DAVID Middle Name Last Name BENFER
Address Line 1 5364 HESPERUS DRIVE
Address Line 2
City COLUMBIA State MD ZIP Code 21044
Phone 1 3016743604 Phone 2 Fax 4432838022
E-mail DCBENFER@GMAIL.COM

Applicant (This section is not required.)

Search As Owner As Lic. Prof As Contact

Type * Applicant
Relationship Applicant
Primary Yes

First Name DAVID MI CHRIS Last Name BENFER
Full Name DAVID CHRISTOPHER BENFER
Organization Name TIMELESS CONSTRUCTION
Street Address 5364 HESPERUS DRIVE
Address Line 2
City COLUMBIA State MD Zip Code 21044(-1846)
Phone 301-674-3604 Cell Fax
E-mail * DCBENFER@GMAIL.COM

Addtl Info

Est Construction Cost * 45000
Housing Units * 0
Number of Buildings * 0
Public Owned No

Construction Type --Select--

PORCH INFORMATION


PORCH INFORMATION

Capital Project-No Fee * Yes No
Capital Project Number
Fee Exempt * Yes No
Roadside Tree Project Permit * Yes No
Roadside Tree Project Permit #
Existing Use * SFD
Type of Porch * Screened Porch
Type of Porch Foundation * New Deck
Total Square Footage * 322 SQFT
Water Supply Private
Sewage Disposal Private
Expiration Date 10/30/2022

PAYMENT INFORMATION

Check 1 Payee 1 Check 2 Payee 2 SAP Doc No SAP Entered

Submit Cancel

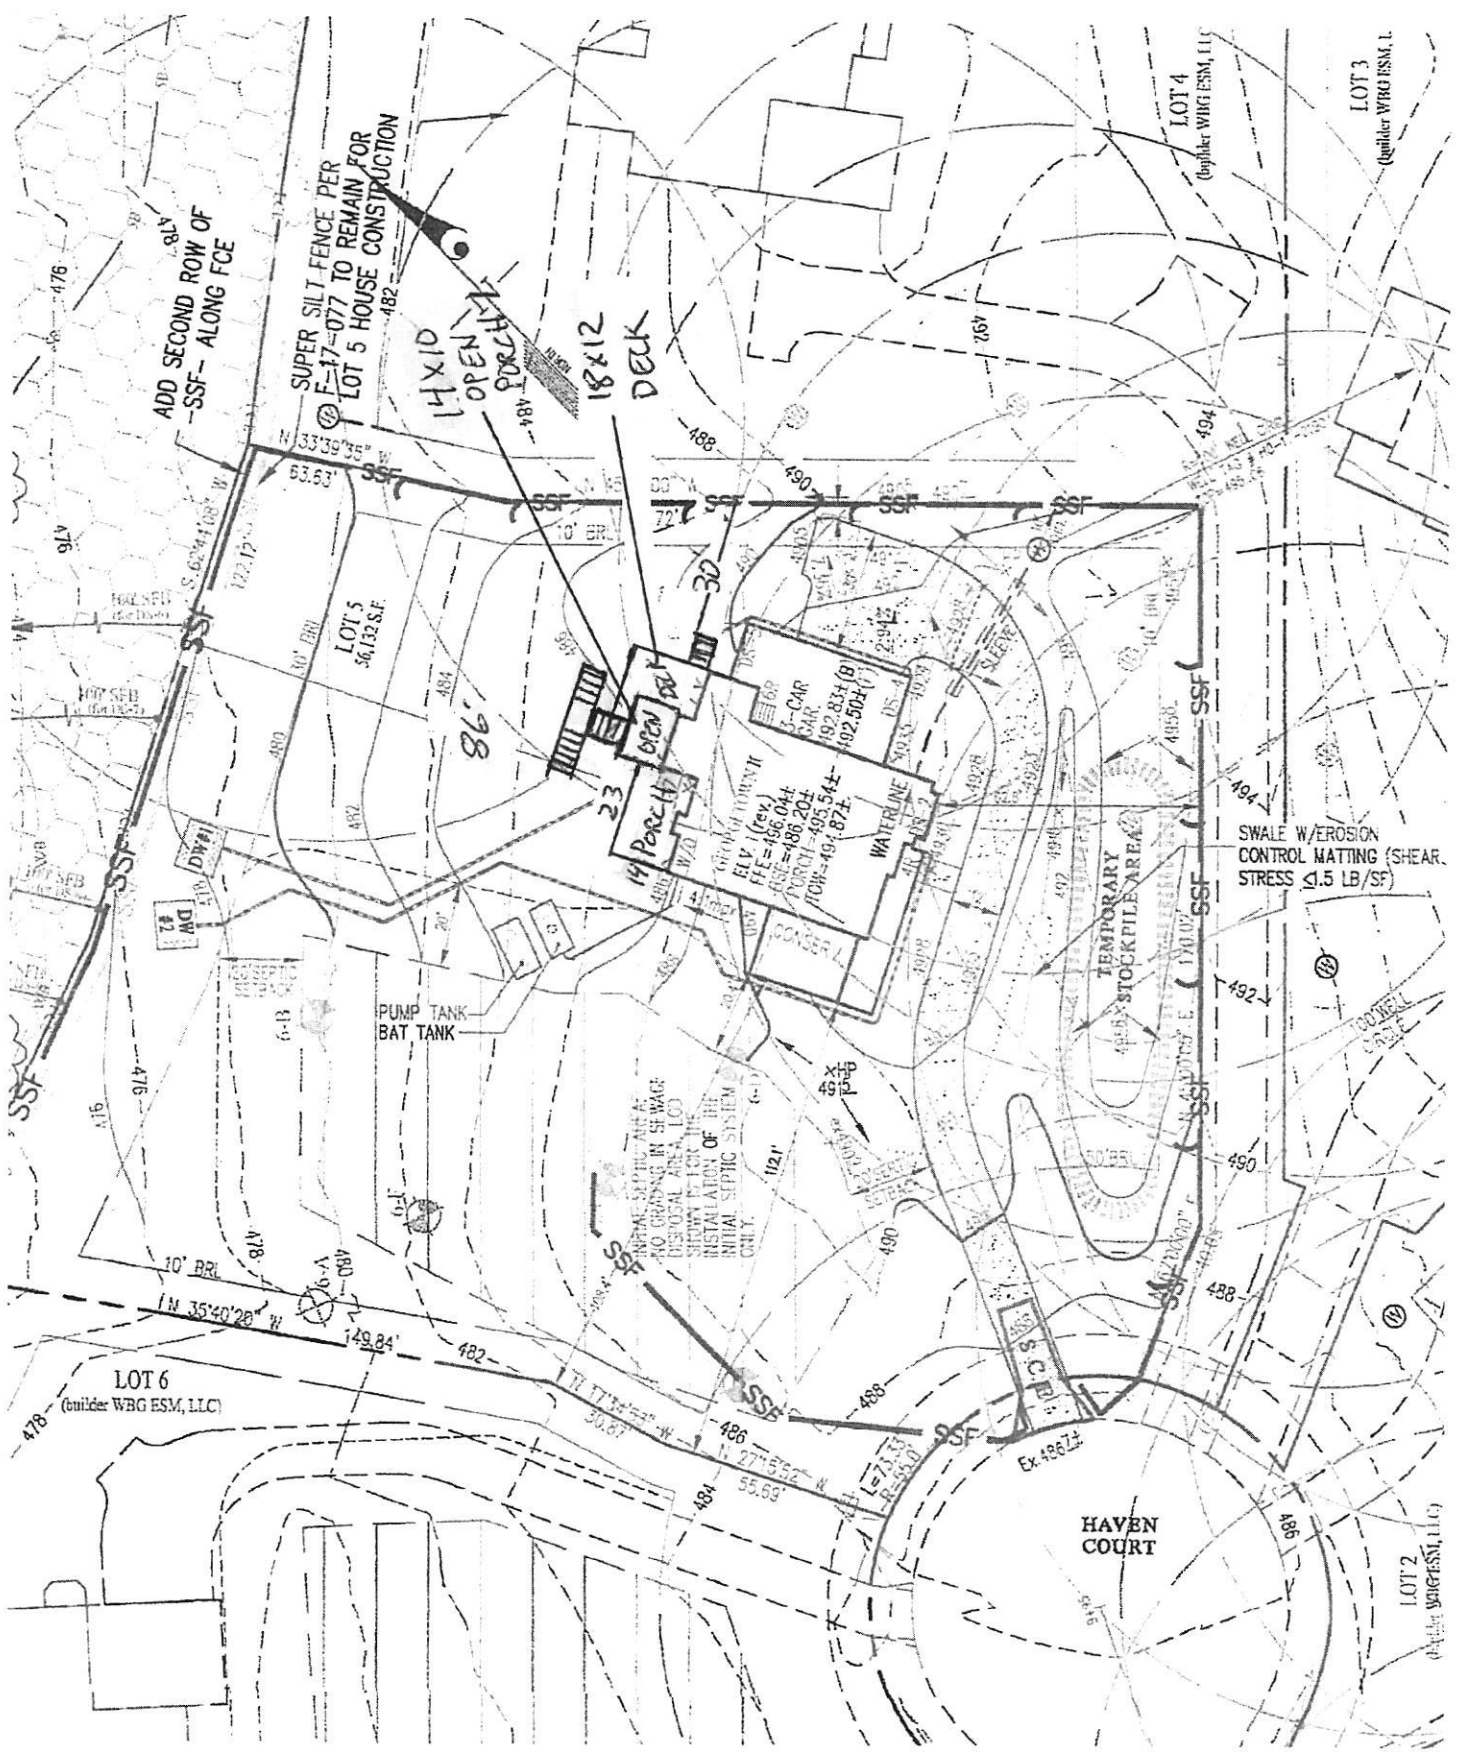

DRYWELL SIZE CHART

DRYWELL No.	LENGTH x WIDTH	DEPTH OF STONE
1	9.5'x11.5'	5'

Scale = 1" = 40'