



HOWARD COUNTY HEALTH DEPARTMENT

72869
W5

DATE
11 / 20 / 20

Received From

Allies Environmental

PHONE #

301-776-8370

5002 Centaurus Ct. - Dayton

For

Well Drilling

CASH

CHECK

NO.

24320

One hundred & Sixty Dollars

— 00/100

Dollars

\$

160 | 00

Received By

V. De Erney

05-372399

| | | | | |
|----------|----------|--|--|----------------------------|
| B | 1 | SEQUENCE NO. (MDE USE ONLY) 66727 | STATE OF MARYLAND APPLICATION FOR PERMIT TO DRILL WELL please type | STATE PERMIT NUMBER --- |
|----------|----------|--|--|----------------------------|

OWNER INFORMATION

Date Received (APA) 11/20/20

8 MM DD YY 13

15 Last Name Allen Owner David + Amie First Name David 34

36 Street or RFD 5002 Centaurus Court 55

57 Town Dayton 70 State MD 72 Zip 21036 76

LOCATION OF WELL

B 3

8 COUNTY Howard 21

23 SUBDIVISION Linden Chapel Hill 42

SECTION 44 46 LOT 7 48 50

52 NEAREST TOWN Dayton 71

DRILLER INFORMATION

Driller's Name Brett Sweeney 76 License No. MSD 237 81

Firm Name Alfred Well Drilling

Address PO Box 129 Annapolis Junction MD 20701

Signature [Signature] Date 11/18/2020

SOURCES OF DRILLING WATER

B 4

1. Public 11 STREET ADDRESS 5002 Centaurus Ct 30

2. _____

3. _____

ON WHICH SIDE OF ROAD (CIRCLE APPROPRIATE BOX)

NORTH
 WEST
 EAST
 SOUTH

34 TS 37 DISTANCE FROM ROAD

ENTER FT OR MI FT 38 39

TAX MAP: 0028 BLK: _____ PARCEL 091

WELL INFORMATION

B 2

1 2

APPROX. PUMPING RATE (GAL. PER MIN.) 8 12

AVERAGE DAILY QUANTITY NEEDED (GAL. PER DAY) 14 20

USE FOR WATER (CIRCLE APPROPRIATE BOX)

D DOMESTIC POTABLE SUPPLY & RESIDENTIAL IRRIGATION

F FARMING (LIVESTOCK WATERING & AGRICULTURAL IRRIGATION)

22 I INDUSTRIAL, COMMERCIAL, DEWATERING

P PUBLIC WATER SUPPLY WELL

T TEST, OBSERVATION, MONITORING

O OPEN LOOP GEOTHERMAL

C CLOSED LOOP GEOTHERMAL

CANCELED

2 loops

NOT TO BE FILLED IN BY DRILLER HEALTH DEPARTMENT APPROVAL

COUNTY NAME _____ COUNTY NO. _____

STATE SIGNATURE _____ INSERT S → 41

DATE ISSUED _____

43 MM DD YY 48 CO SIGNATURE _____ EXP. DATE _____

APPROXIMATE DEPTH OF WELL 320 FEET

24 28

APPROXIMATE DIAMETER OF WELL 6 INCH

NEAREST

METHOD OF DRILLING (circle one)

BORED (or Augered) AIR-ROTary JETTED ROTARY (Hydraulic Rotary) Jetted & DRIVEN

30 AIR-ROTary AIR-PERCussion ROTARY (Hydraulic Rotary)

37 CABLE REVerse-ROTary DRive-POINT

other _____

REPLACEMENT OR DEEPEMED WELLS (CIRCLE APPROPRIATE BOX)

N THIS WELL WILL NOT REPLACE AN EXISTING WELL

Y THIS WELL WILL REPLACE A WELL THAT WILL BE ABANDONED AND SEALED

39 S THIS WELL WILL REPLACE A WELL THAT WILL BE USED AS A STANDBY-CONTACT LOCAL APPROVING AUTHORITY FOR POLICY ON STANDBY WELLS

D THIS WELL WILL DEEPEAN AN EXISTING WELL


PERMIT NUMBER OF WELL TO BE REPLACED OR DEEPEMED (IF AVAILABLE) 41 _____ 52

Not to be filled in by driller (MDE OR COUNTY USE ONLY)

APPROP. PERMIT NUMBER _____ **G** _____

PERMIT No. _____

70 71 72 73 74 75 76 77 78 79

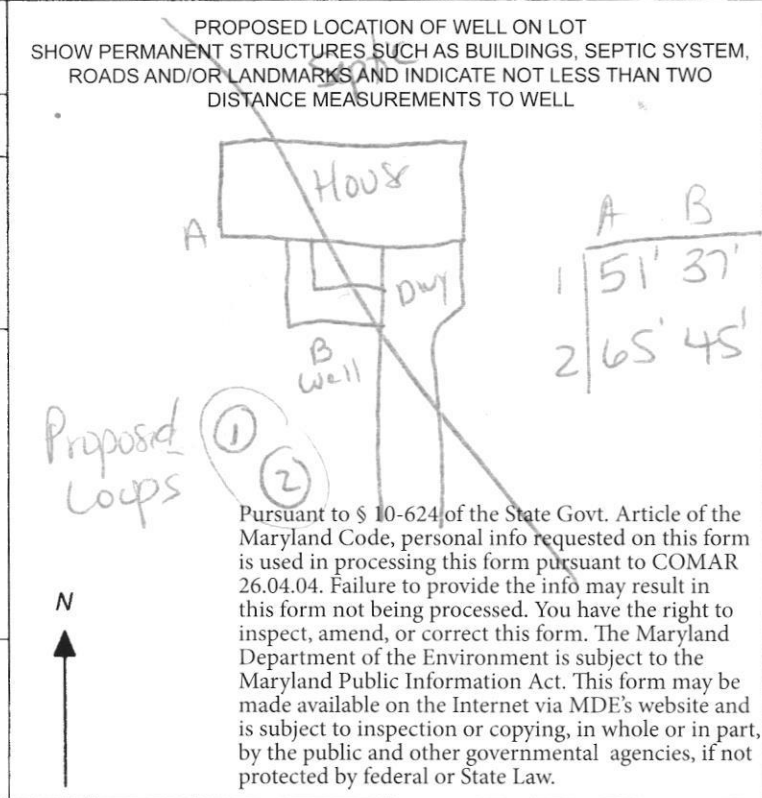


12/2/2020

owner cancelled
well permit - do not
want geothermal
right now

Centarus Ct



SITE PLAN

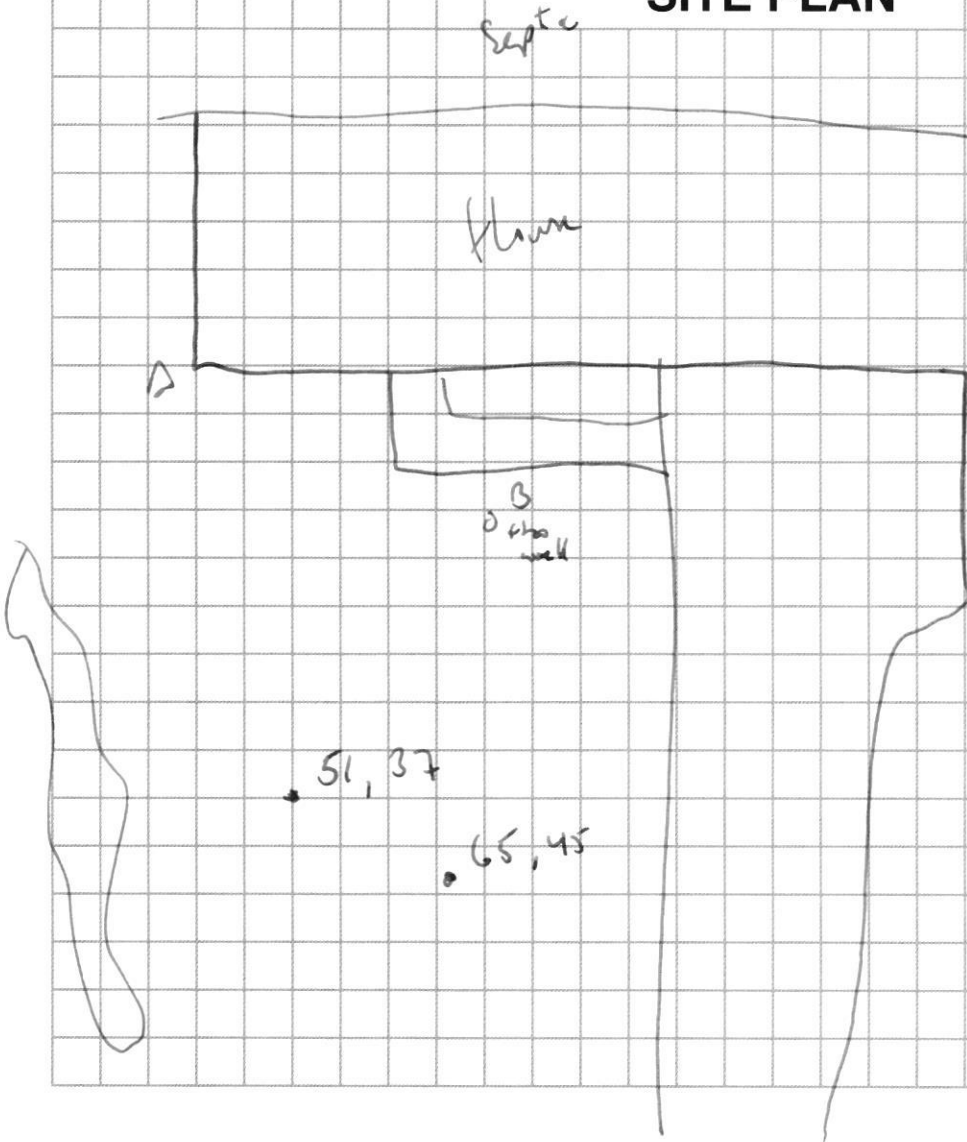

Sediment Control Protocol: _____

Distance From House: 51

From Septic: 100'

From Sewer: N/A

From Property Line: ~ 35'

From Street: 75'

Trees Nearby: NO

Utility Issues: NO

Mats Needed: YES

Access For H/U: N/A

Neighboring Tags: _____

Comments: _____

Person Completing Form: _____