

APPLICATION

PERCOLATION TESTING

A 516902

P _____

HOWARD COUNTY HEALTH DEPARTMENT
BUREAU OF ENVIRONMENTAL HEALTH
3525-H ELLICOTT MILLS DRIVE/ELLICOTT CITY, MARYLAND 21043
TELEPHONE: 313-2640

DISTRICT _____

DATE _____

TO: THE COUNTY HEALTH OFFICER
ELLICOTT CITY, MARYLAND

I HEREBY APPLY FOR THE NECESSARY TEST PRIOR TO APPLICATION FOR PERMIT TO CONSTRUCT (OR RECONSTRUCT) A SEWAGE DISPOSAL SYSTEM.

PROPERTY OWNER Payne

ADDRESS P.O. Box 581 Mt Airy 21771 PHONE _____

AGENT OR PROSPECTIVE BUYER Ridgeview LLC Charles A. Sharp

ADDRESS P.O. Box 228 Clarksville, 21029 PHONE 410 489-4630

PROPERTY LOCATION:

SUBDIVISION Payne Property LOT NO. 6 11

ROAD AND DESCRIPTION Long Corner Rd.

TAX MAP 6 PARCEL # 57

SIZE OF LOT 40, - 60,000 sq. ft. TYPE BLDG. residential
(SINGLE FAMILY DWELLING OR COMMERCIAL)

THE SYSTEM INSTALLED UNDER THIS APPLICATION IS ACCEPTABLE ONLY UNTIL PUBLIC FACILITIES BECOME AVAILABLE. I FULLY UNDERSTAND THE FEE CONNECTED WITH THE FILING OF THIS PERC TEST APPLICATION IS NON-REFUNDABLE UNDER ANY CIRCUMSTANCES. I ALSO AGREE TO COMPLY WITH ALL M.O.S.H.A. REQUIREMENTS IN TESTING THIS LOT. C.A. Sharp
(SIGNATURE OF APPLICANT)

APPROVED BY _____ FOR _____ DATE _____

DISAPPROVED BY _____ FOR _____ DATE _____

HOLD PENDING FURTHER TESTS _____

REASONS FOR REJECTION OR HOLDING _____

PERCOLATION TEST PLAT/PRELIMINARY PLAT - TITLE OR I.D. # _____ DATE _____

SITE DEVELOPMENT PLAN/FINAL PLAT - TITLE OR I.D. # _____ DATE _____

THIS IS NOT A PERMIT

NOT TO SCALE


COUNTY #

SOIL PROFILE

0' **645**
 SAME
 AS
647
 13'

SOIL PROFILE

0'

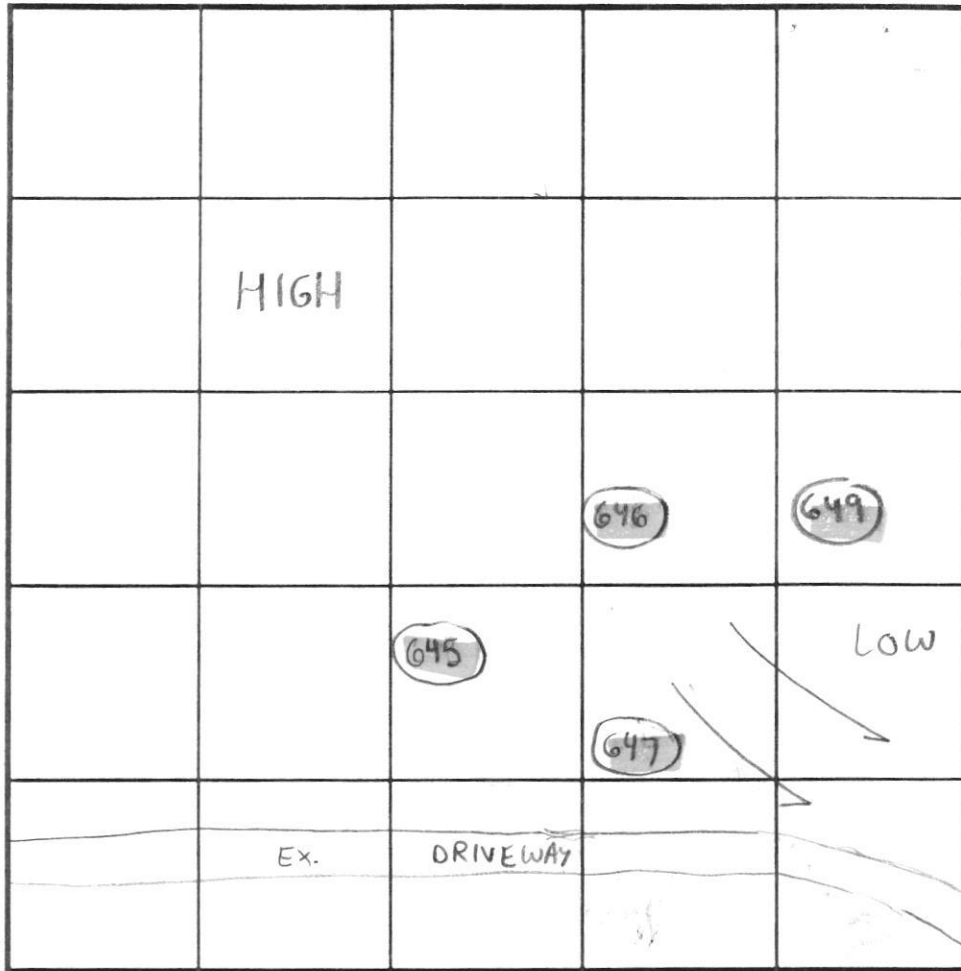

INDICATE NORTH - NAME ADJOINING ROADWAY AS BASE LINE.

646
 4 1/2" Dark Brown Top Soil
 orange/brown silty clay loam
 4'6" Tan beige sandy loam
 ↓
 channery 30-40% MICA SCHIST WEATHERED
 14'

647
 4" Dark Brown Top Soil
 orange/brown silty clay loam
 4'6" Tan beige sandy loam
 ↓
 channery WEATHERED 10-20% silt & frag
 13'10"

DATE	TEST NO.	DEPTH	PRE-WET		TEST - 1" DROP		TIME
			START	STOP	START	STOP	
4/2/02	645	13' V	(VISUAL OK)		SEE	SOIL PROFILE) OK	
	646	4 1/2" / 14' V	11:54 a.m.	11:56 a.m.	11:56 a.m.	12:05 pm	9 min OT
	647	5' / 13'10" V	12:06	12:08 a.m.	12:08 a.m.	12:16 pm	2 min OT
			11:46 a.m.	11:46 a.m.	11:46 a.m.	11:53 pm	7 min STK

REMARKS: Treatment zone verified with deep tests, Holes per stake Contour per plan
 TYPE OF SOIL: Mapped as Glenelg? (Mt. Airy Channery?)
 TESTED BY: SRK & DD Jeff Allen = Backhoe ALSO PRESENT: Chuck Sharp & Richard Dehmit
 TRENCH DESIGN DATA: AVERAGE PERCOLATION TIME: 8 min TRENCH WIDTH: 3'
 INLET DEPTH: 2' MAXIMUM BOTTOM DEPTH: 6' SQ. FT./BEDROOM: 210

APPLICATION

PERCOLATION TESTING

A 516902

P _____

HOWARD COUNTY HEALTH DEPARTMENT
BUREAU OF ENVIRONMENTAL HEALTH
3525-H ELLICOTT MILLS DRIVE/ELLICOTT CITY, MARYLAND 21043
TELEPHONE: 313-2640

DISTRICT _____

DATE _____

TO: THE COUNTY HEALTH OFFICER
ELLICOTT CITY, MARYLAND

I HEREBY APPLY FOR THE NECESSARY TEST PRIOR TO APPLICATION FOR PERMIT TO CONSTRUCT (OR RECONSTRUCT) A SEWAGE DISPOSAL SYSTEM.

PROPERTY OWNER Payne

ADDRESS PO Box 58, Mt Airy, 21771 PHONE _____

AGENT OR PROSPECTIVE BUYER Ridgeview LLC Charles A. Sharp

ADDRESS PO Box 228 Clarksville, 21029 PHONE 410 489-4630

PROPERTY LOCATION:

SUBDIVISION Payne property LOT NO. 7 NB PPA

ROAD AND DESCRIPTION long corner Rd

TAX MAP 6 PARCEL # 57

SIZE OF LOT 40-60,000 sq. ft TYPE BLDG. residential
(SINGLE FAMILY DWELLING OR COMMERCIAL)

THE SYSTEM INSTALLED UNDER THIS APPLICATION IS ACCEPTABLE ONLY UNTIL PUBLIC FACILITIES BECOME AVAILABLE. I FULLY UNDERSTAND THE FEE CONNECTED WITH THE FILING OF THIS PERC TEST APPLICATION IS NON-REFUNDABLE UNDER ANY CIRCUMSTANCES. I ALSO AGREE TO COMPLY WITH ALL M.O.S.H.A. REQUIREMENTS IN TESTING THIS LOT. Charles A. Sharp
(SIGNATURE OF APPLICANT)

APPROVED BY _____ FOR _____ DATE _____

DISAPPROVED BY _____ FOR _____ DATE _____

HOLD PENDING FURTHER TESTS _____

REASONS FOR REJECTION OR HOLDING _____

PERCOLATION TEST PLAT/PRELIMINARY PLAT - TITLE OR I.D. # _____ DATE _____

SITE DEVELOPMENT PLAN/FINAL PLAT - TITLE OR I.D. # _____ DATE _____

THIS IS NOT A PERMIT

NOT TO SCALE

COUNTY #

SOIL PROFILE


0' 648
dark brn topsoil
4-6" red-brn silty clay 1m dense
3/6" tan-beige channery sandy 1m
10-20% mica schist FRAGS WEATHERED
13'

649

6" Topsoil
orange brown silty clay loam
4/6" very beige fine sandy loam w/ white pockets of decayed mica schist channery
13/6" 5-10% rock frags

650

0" Dark Brown Top Soil
4/6" red brown silty clay loam
4/6" Tan/Brown/beige sandy loam channery
12' 5-10% mica schist frags

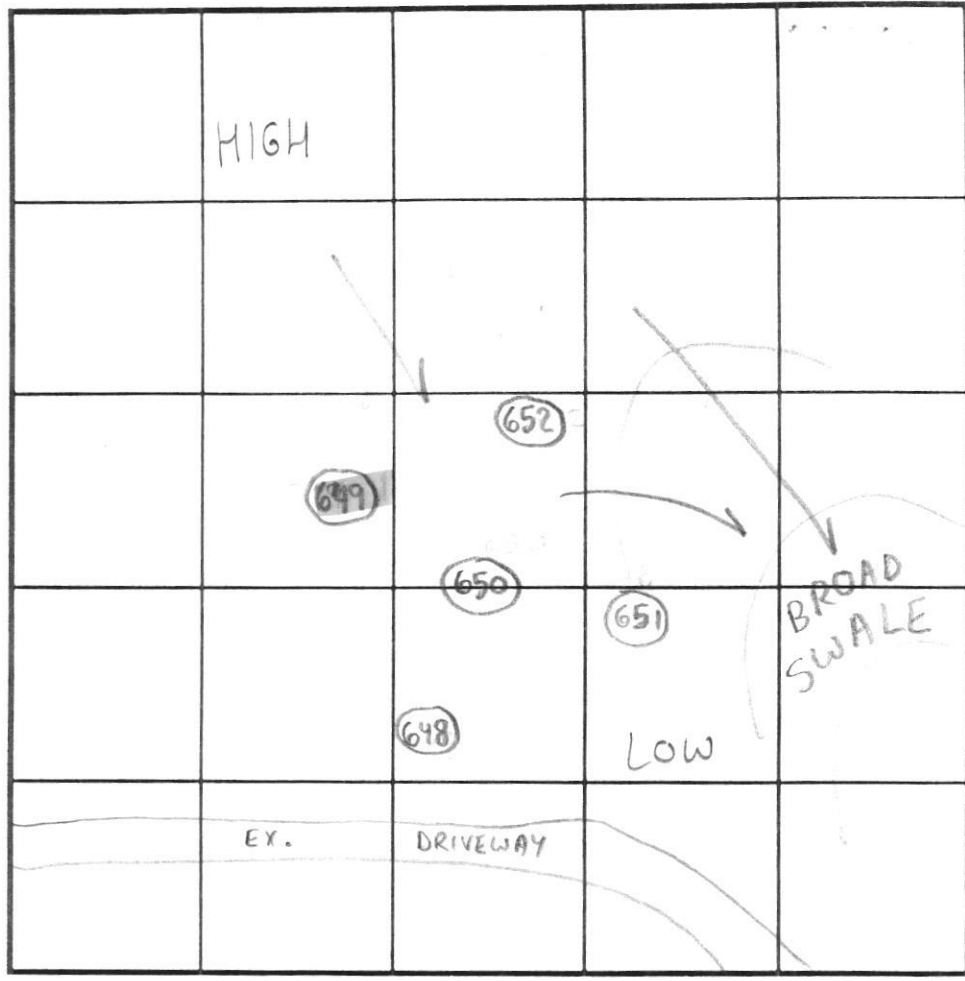

SOIL PROFILE

0' 651
dark-brn topsoil
4-6" red brown silty clay 1m dense
5/4" tan brown sandy clay loam channery
13' 5-15% mica schist frags *


652

6" Dark Brown Top soil
4" dense red brown clay loam w/ rock frags
13/6" red brown/beige sand loam w/ 40-50% mica schist/ quartz frags throughout

INDICATE NORTH - NAME ADJOINING ROADWAY AS BASE LINE.

DATE	TEST NO.	DEPTH	PRE-WET		TEST - 1" DROP		TIME	
			START	STOP	START	STOP		
4/2/02	648	4'T 13'V	10:13am	10:23am	10:23am	10:33am	10min	OK
	649	5'T 13'6"V	11:23a.m.	11:26a.m.	11:26a.m.	11:36a.m.	10min	OK
	650	12'V	(VISUAL)	AL OK	SEE	SOIL PROFILE		OK
	651	5'T 13'V	10:30am	10:45am	10:45am	11:00am	15min	OK
	652	5'T 13/6"V 8'T 13/6"V	10:59am	11:01am	11:01a.m.	11:09am	8 min	OK
			11:15am	11:30am	11:30am	11:45am	15min	

REMARKS * Mica Schist has lithochromatic colors (verigated) Holes per stake
 TYPE OF SOIL Mt. Ainy Channery (Treatment Zone verified w/ deep tests) Contour per plan
 TESTED BY SRK & DD Jeff Allen = Bachelor ALSO PRESENT Chuck Shorp & Richard Demmitt
 TRENCH DESIGN DATA: AVERAGE PERCOLATION TIME 10min TRENCH WIDTH 3'
 INLET DEPTH 2' MAXIMUM BOTTOM DEPTH 56' SQ FT/BEDROOM 210

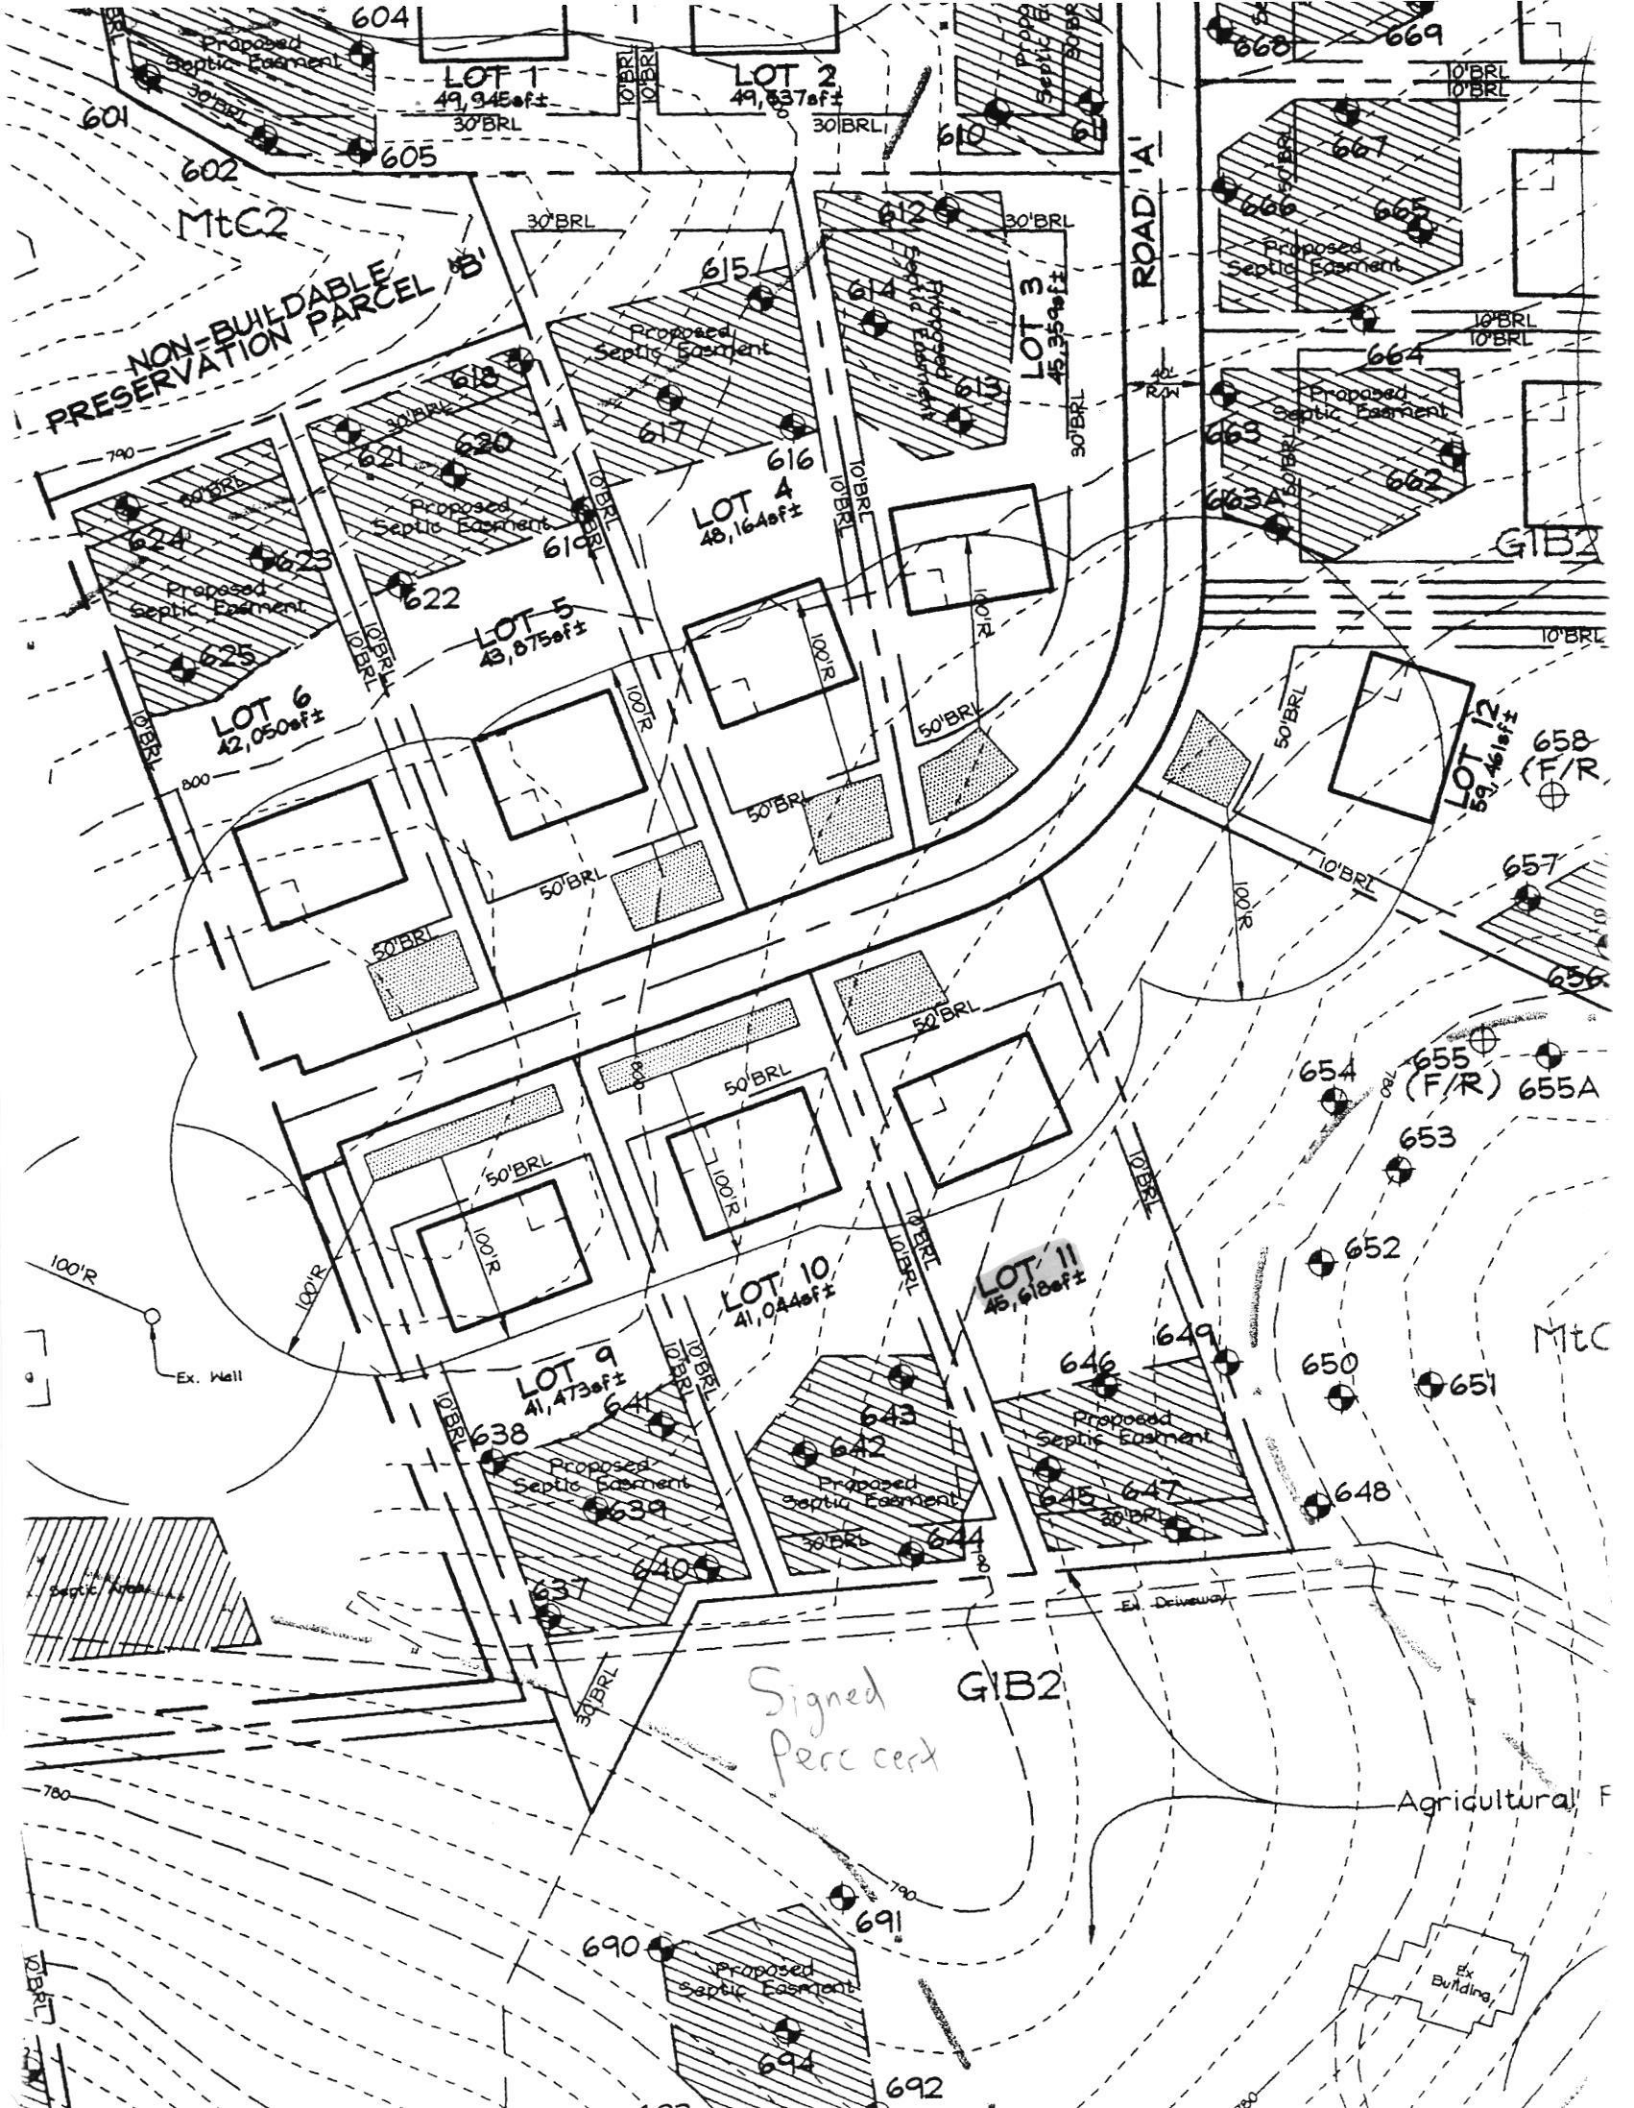

NON-BUILDABLE PRESERVATION PARCEL B

LOT 1
49,945sqft
30'BRL

LOT 2
49,837sqft
30'BRL

LOT 3
45,359sqft
30'BRL

LOT 4
48,164sqft
100'R

LOT 5
43,875sqft
100'R

LOT 6
42,050sqft
100'R

LOT 9
41,473sqft
100'R

LOT 10
41,044sqft
100'R

LOT 11
45,618sqft
100'R

LOT 12
59,461sqft
100'R

SIGNED Perc cert

ROAD A

GIB2

Agricultural F

MTC2

GIB2

MTC

Ex. Building

Ex. Well

Ex. Driveway

700

800

100'R

780

700

692

601

602

605

604

610

615

612

614

615

618

621

623

625

622

617

616

619

620

624

626

627

628

638

639

637

640

641

642

643

646

649

645

647

648

649

650

651

654

653

652

650

648

651

655 (F/R)

655A

657

656

658

659

660

