

APPLICATION

HOWARD COUNTY

SERIAL NUMBER

PERMIT APPLICATION

DEPARTMENT OF INSPECTIONS, LICENSES & PERMIT
3430 COURT HOUSE DRIVE, ELLICOTT CITY, MARYLAND 21043

16025
B00114/81

BUILDING ADDRESS (HOUSE NO., STREET, TOWN OR AREA)
70151 Moorland Drive 38638
Clarksville MD 21029

GRADING/SEDIMENT CONTROL YES NO SDP #

LOT NO.	PARCEL NO.	SEC.	AREA	BLOCK NO.	LIBER	FOLIO
98	475	4	2	12		
SUB DIVISION		ZONE	ZONE MAP	ELEC. DIST.	CENSUS TR.	
Ashleigh Knolls		RR-240	5	5	6051.02	

DESCRIPTION OF WORK AUTHORIZED
2 story, Full basement, 11 rooms,
2 FB, 1 HB, FP, 4 Bedrooms,
3 car front entry garage
Newport Model

OWNER NAME AND ADDRESS
Mitchell + Bros + @ Ashleigh Knolls
1686 E. Gude Dr.
Rockville MD 20850 301-762-9511

SIZE OF BLDG.	FRONT	DEPTH	HEIGHT
1	58'	62'	10'
2	58'	36'	10'
B	58'	50'	10'

OCCUPANT'S NAME AND ADDRESS
Vacant

TYPE OF BLDG.	AREA	VOLUME	ROOF
B. ROOMS			22P Gable
ROOMS			
BATHS			
FIREPLACES			

ARCHITECT OR ENGINEER'S NAME AND ADDRESS
Sutton-Yantis 703-734-9733
1952 Gallows Rd., Vienna, VA

FOOTINGS	FOUNDATION	S. WALLS
16" x 12"	8" concrete	Wood frame w/ Siding

CONTRACTOR'S NAME AND ADDRESS
Same as owner

UTILITIES				
WATER/WELL	SEWER/SEPTIC	GAS	ELECTRICITY	TYPE OF HEAT
<input type="checkbox"/>	<input type="checkbox"/>	X	X	Gas
				AC
				X

I have carefully examined and read this application and know the same is true and correct, and that in doing this work, all provisions of Howard County Ordinances and the State Laws of Maryland will be complied with, whether specified or not; and I will notify the Department of Inspections, and Permits twenty-four hours in advance when I am ready for the inspections called for elsewhere in the application; and that no work will be covered up until such inspections have been complied with.
10-8-98

EXISTING USE	PROPOSED USE	
Vacant	Residential Single Fam. Home	
EST. CONSTRUCTION COST	LICENSE NUMBER	PERMIT FEE
\$169,600.00	CR06495	TBD

President J. [Signature]
TITLE DATE 10/5/98

W/S CODE FOR OFFICE USE ONLY

DISTANCE IN FEET FROM R/W LINE TO FRONT BUILDING LINE _____
SIDE YARD (DISTANCE IN FEET FROM SIDE BLDG. LINE TO SIDE PROPERTY LINE) _____
TO SIDE BUILDING LINE _____
DISTANCE IN FEET, REAR YD. REQUIRING SET _____
BACK (CORNER LOT ONLY) _____ SDP # _____

FUNCTION	DATE	SIGNATURE APPROVAL
ZONING/PLANNING	X	
SHA	X	
SEDIMENT/GRADING	X	
BUILDING OFFICIAL	X	
WATER & SEWER		
HEALTH DEPT.	X 10/9/98	[Signature]
FIRE PROTECTION		
STORM WATER MGM.	X	

Check payable to: DIRECTOR OF FINANCE OF HOWARD COUNTY

CAUTION
To begin construction before a permit placard has been issued and displayed on the job is a violation of the law.
Use and occupancy permit must be applied for two weeks before it will be issued.

IMPORTANT: PLEASE SHOW ZIP CODES AND AREA CODES WHEREVER REQUIRED.


APPROVED _____ DATE _____

LP-69-591
A 2052

Distribution of Copies:
White - Building Official
Green - Planning & Zoning
Yellow - Engineering
Pink - Health Dept.
Gold - S.H.A.

13180 Holly ~~Lock~~ Lock

5/16/22

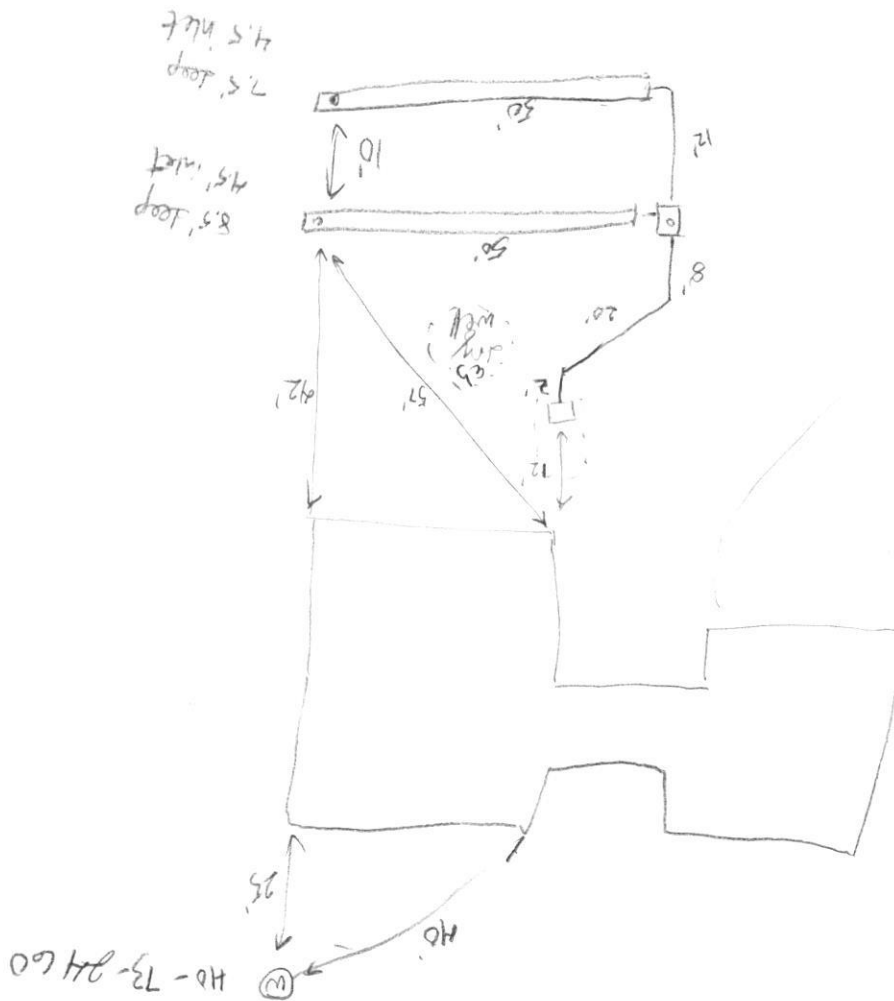

under block tank
outlet baffle
6' deep