


A/P

Lot 45

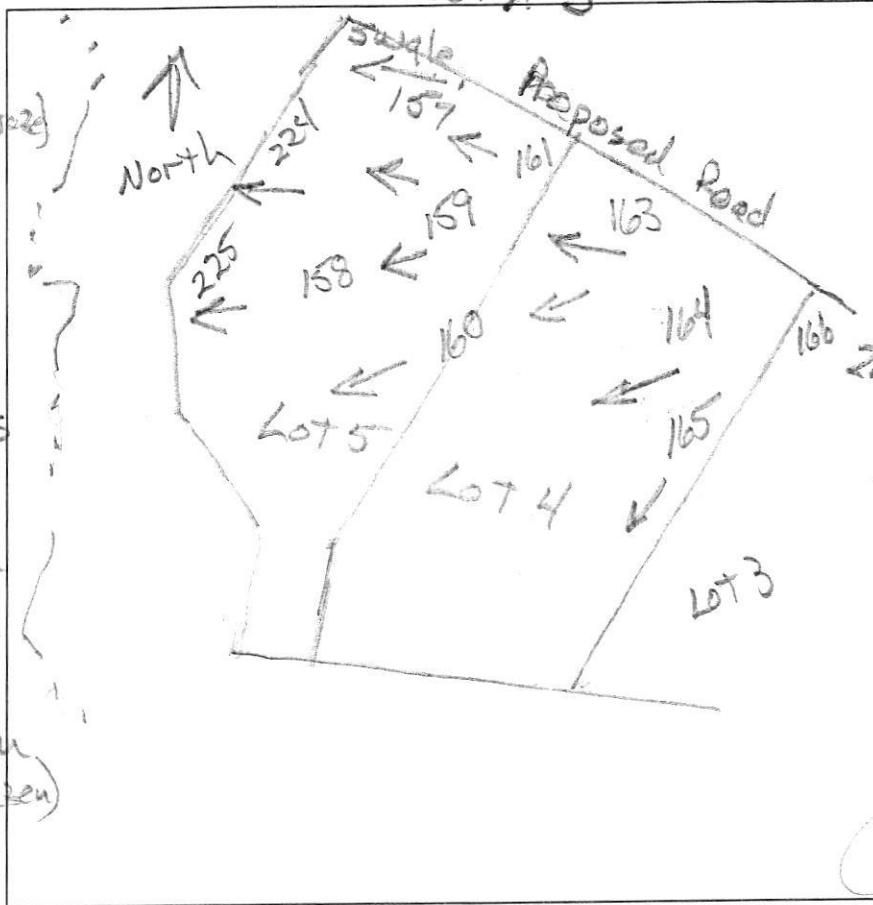

157
0.4' dk L or sl (broken)
brn sl
2msbk
few mica
1.4' brn vells
micaceous
2.2' grey-brn chls
micaceous
7' vells
50% rock

159
0.8' dk brn to brn
sl or L (broken)
brn sl
2msbk
many mica
1.5' brn sl
m
many mica
2.9' grey-brn
chls, mica
m
5.5' brown-brn
micaceous
chls, thick platy

7.3' grey-brn
fills
8'
158
dk brn sl
brn sl, 2msbk
many mica
brn & pale brn
ls, 1f sbk
brn & pale brn & vel-red
ls, thin platy

161
0.4' dk brn sl
brn sl
thin platy
1' grey-brn
ls, many
mica
10% channers
thin platy
2.5' pale grey-brn
ls, thin platy
many mica
7' brn vells
micaceous
10.5'

160
dk brn sl
brn sl
2msbk
to 2c sbk
many mica
1.5' brn to
pale brn
sl, thin platy
many mica
3.5' brn, pale brn
& vel-red
ls, thin platy
many mica
few coarse

DATE	TEST #	DEPTH	START	BREAK 1" DROP	STOP 2" DROP	TIME OF 2ND INCH	P/F/H
3/3/15	157	7'	Visual	1.5'	3'	sidewalk	P
3/3/15	159	3.9' / 8'	10:07	10:09	10:11	2	P
3/3/15	161	3.6' / 10.5'	10:26	10:28	10:30	2	P
3/3/15	160	4.5' / 10'	11:00	11:03	11:01	3	P
3/3/15	158	3.7' / 11'	11:25	11:28	11:31	3	P

REMARKS _____
 SANITARIAN R. Bricker BACKHOE Debbie (Hartfield) OTHERS A.T.
 TEST HOLES USED IN SDA _____ AVG. PERC TIME Sarah Collins SQ. FT/BR _____
 TRENCH WIDTH _____ INLET DEPTH _____ MAX. BOT DEPTH _____ EFFECTIVE S/W _____

Lot 5

A/P

224

0.6' dk brn L
brn sl

1.6' brn L
2msbk

2' yel-red sl
thin platy dense
few mica


3' yel-brn chls
thin platy

9.5' yel-red & brn ls
thin platy
many mica

water seeps

dk brn & grey-brn
ls, thin platy

many mica
m 12 (H. grey)

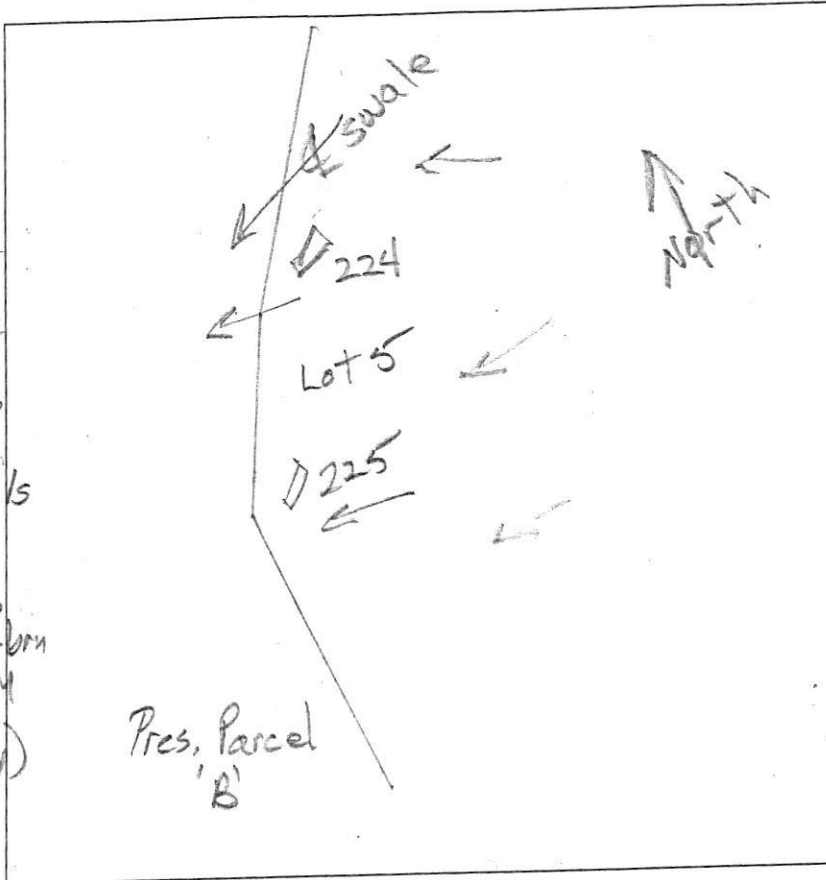

225

0.5' dk brn & brn
2fsbk

1.8' brn L, 2msbk
few mica

2.8' yel-red & brn
sl, 1msbk
many mica

6.2' yel-red, brn
& dk brn chls
thin platy
many mica

10' brn chls, thick
many mica

12' brn sl, thick
many mica

12' water seeps
dk brn & grey-brn ls
thick platy
many mica
m 12 (H. grey)

	DATE	TEST #	DEPTH	START	BREAK 1" DROP	STOP 2" DROP	TIME OF 2ND INCH	P/F/H
0.5'	3/3/16	224	5.7' / 9.5'	10:03	10:10	10:22	12	P
1.8'	3/3/16	225	5.8' / 12.1'	10:33	10:42	11:02	20	P
2.8'								
6.2'								
10'								
12'								

REMARKS

SANITARIAN R. Bricker BACKHOE Hot Fields OTHERS Jason Alexander

TEST HOLES USED IN SDA Scollins AVG. PERC TIME Jason Van Kirk SQ. FT/BR

TRENCH WIDTH _____ INLET DEPTH _____ MAX. BOT DEPTH _____ EFFECTIVE SW _____