

C1 69118

SEQUENCE NO. (MDE USE ONLY)

STATE OF MARYLAND WELL COMPLETION REPORT

THIS REPORT MUST BE SUBMITTED WITHIN 45 DAYS AFTER WELL IS COMPLETED.

1 2 3 6 (THIS NUMBER IS TO BE PUNCHED IN COLS. 3-6 ON ALL CARDS)

COUNTY NUMBER

ST/CO USE ONLY DATE RECEIVED

DATE WELL COMPLETED 4-14-22

Depth of Well 350 (TO NEAREST FOOT)

PERMIT NO. FROM "PERMIT TO DRILL WELL" HD-73-2315

OWNER: Hendricks Vera, WELL SITE ADDRESS: 13416 Arada Ct, TOWN: Highland

WELL LOG table with columns: DESCRIPTION, FEET (FROM, TO), check if water bearing. Includes entries for Grayschist and Sand.

GROUTING RECORD, CASING RECORD, SCREEN RECORD sections with checkboxes and input fields for materials and dimensions.

PUMPING TEST section with fields for HOURS PUMPED, PUMPING RATE, WATER LEVEL, and TYPE OF PUMP USED.

Administrative sections including NUMBER OF UNSUCCESSFUL WELLS, WELL HYDROFRACTURED, and DRILLERS LIC. NO.

DEPTH (nearest ft.) table and MDE USE ONLY section for well completion details.

PUMP INSTALLED section with fields for DRILLER INSTALLED PUMP, TYPE OF PUMP INSTALLED, and CAPACITY.

LATITUDE 39.197031, LONGITUDE 76.925322, and disclaimer text regarding state government information.

C 1 **0714** SEQUENCE NO. (WRA USE ONLY)

1 2 3 (SEQ. NO.) 6

(THIS NUMBER IS TO BE PUNCHED IN COLS. 3-6 ON ALL CARDS)

STATE OF MARYLAND
 WATER RESOURCES ADMINISTRATION
 TAWES STATE OFFICE BLDG., ANNAPOLIS, MD. 21401
WELL COMPLETION REPORT

THIS REPORT MUST BE SUBMITTED WITHIN 30 DAYS AFTER WELL COMPLETION

FILL IN THIS FORM COMPLETELY

COUNTY NUMBER 4756-216

DATE RECEIVED (WRA USE ONLY)

DATE WELL COMPLETED 3/7/78

DEPTH OF WELL

225

22 (TO NEAREST FOOT) 26

PERMIT NO. FROM "PERMIT TO DRILL WELL"

H0-73-2315

28 29 30 31 32 33 34 35 36 37

DRILLERS IDENTIFICATION NO. 15

OWNER: W. L. ... LAST NAME FIRST NAME ...

STREET OR RFD: ... POST OFFICE ...

WELL LOG

STATE THE KIND OF FORMATIONS PENETRATED, THEIR COLOR, DEPTH, THICKNESS AND IF WATER BEARING

DESCRIPTION (USE ADDITIONAL SHEETS IF NECESSARY)	FEET		CHECK IF WATER BEARING
	FROM	TO	
Top Soil	0	2	
Shandy	2	25	✓
Sand Stone	25	40	
Micka	40	50	
Sand Stone	50	55	✓
Micka	55	225	

GROUTING RECORD

WELL HAS BEEN GROUTED (CIRCLE APPROPRIATE BOX) YES NO

TYPE OF GROUTING MATERIAL (CIRCLE BOX): CEMENT BENTONITE CLAY

NO. OF BAGS 10 NO. OF POUNDS 1,000

GALLONS OF WATER 60

DEPTH OF GROUT SEAL (TO NEAREST FOOT) FROM 0 FT. TO 30' open FT.

CASING RECORD

MAIN CASING TYPE STEEL CONCRETE

NOMINAL DIAMETER TOP (MAIN) CASING (NEAREST INCH) 37

TOTAL DEPTH OF MAIN CASING (NEAREST FOOT) 37

OTHER CASING (IF USED)

DIAMETER (INCH) _____ DEPTH (FEET) FROM _____ TO _____

SCREEN RECORD

SCREEN TYPE OR OPEN HOLE: STEEL BRASS OR BRONZE OPEN HOLE

SLOTSIZE 1. _____ 2. _____ 3. _____

DEPTH (NEAREST WHOLE FOOT)

FROM 0 TO 225

1 2 3 (SEQ. NO.) 6

1 8 9 11 15 17 21

2 23 24 26 30 32 36

3 38 39 41 45 47 51

PUMPING TEST

HOURS PUMPED (TO NEAREST HOUR) 6

PUMPING RATE (GALLONS PER MINUTE TO NEAREST GALLON) 2

WATER LEVEL: (DISTANCE FROM LAND SURFACE) BEFORE PUMPING _____ (NEAREST FOOT)

WHEN PUMPING 22 (NEAREST FOOT)

TYPE OF PUMP USED (CIRCLE APPROPRIATE BOX) (FOR PUMPING TEST): AIR PISTON TURBINE

PUMP INSTALLED

DRILLER WILL INSTALL PUMP (CIRCLE APPROPRIATE BOX) YES NO

CAPACITY: GALLONS PER MINUTE (TO NEAREST GALLON) _____


PUMP HORSE POWER _____

PUMP COLUMN LENGTH (NEAREST FOOT) 43

CASING HEIGHT

LAND SURFACE _____ (NEAREST FOOT)

LOCATION OF WELL ON LOT

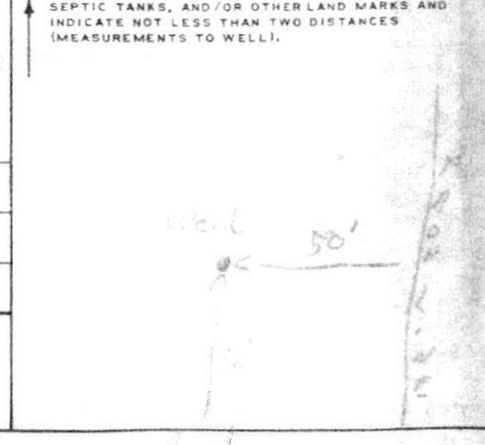

CIRCLE APPROPRIATE BOXES

A WELL WAS ABANDONED AND SEALED WHEN THIS WELL WAS COMPLETED

E ELEVATOR OBTAINED

P TEST WELL CONVERTED TO PRODUCTION WELL

I HEREBY CERTIFY THAT I HAVE COMPLIED WITH ALL CONDITIONS STATED IN THE ABOVE-CAPTIONED "PERMIT TO DRILL WELL" AND THAT INFORMATION CONTAINED IN THIS REPORT IS TRUE, ACCURATE, AND COMPLETE TO THE BEST OF MY KNOWLEDGE, INFORMATION AND BELIEF.

DRILLERS NAME: RALPH MAYNE

(PLEASE PRINT) SIGNATURE: Ralph Mayne

WRA USE ONLY (NOT TO BE FILLED IN BY DRILLER)

TELESCOPE CASING LOG INDICATOR OTHER DATA AVAILABLE

RECEIVED

