

\*\*\*\*\*  
 WATER WELL ABANDONMENT-SEALING REPORT FORM  
 \*\*\*\*\*

**SUBMIT COPIES OF COMPLETED FORM TO:**

- \* COUNTY ENVIRONMENTAL AGENCY (contact MDE, WMA if address needed)
- \* WELL OWNER
- \* MDE, WATER MANAGEMENT ADMINISTRATION, WELL PROGRAM

APPROVED  
 08/22/2021  
 No tag

DATE WELL ABANDONED: 2-9-21 (month/day/year)

\* PERMIT NUMBER OF ABANDONED WELL (if any) \_\_\_\_\_

\* PERMIT NUMBER OF REPLACEMENT WELL: \_\_\_\_\_


\* PERSON ABANDONING WELL: Andrew Huseman WELL DRILLER'S LICENSE NUMBER: 224

CIRCLE: MWD / MSD / MGD

\* OWNER'S NAME: Howard Co. Conservancy Inc

SITE LOCATION MAP

\* WELL LOCATION:  
 COUNTY: Howard  
 NEAREST TOWN: Woodstock  
 TAX MAP 0010 BLOCK 0024 PARCEL 0315  
 SUBDIVISION: \_\_\_\_\_  
 SECTION: \_\_\_\_\_ LOT: \_\_\_\_\_  
 STREET ADDRESS: 10520 Old Frederick Rd

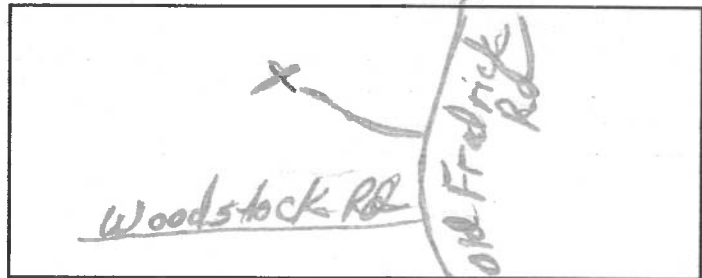

LATITUDE 39.315797

LONGITUDE 76.874483

LOG OF SEALING MATERIAL

\* TYPE OF WELL BEING ABANDONED:  
 DRILLED  JETTED  
 BORED  HAND DUG  
 OTHER (specify) \_\_\_\_\_

\* USE CODE:  
 DOMESTIC  MUNICIPAL/PUBLIC  
 IRRIGATION  INDUSTRIAL  
 TEST/OBSERVATION  GEOTHERMAL

\* TYPE OF CASING:  
 STEEL  PLASTIC  
 CONCRETE  OTHER (specify) \_\_\_\_\_

MATERIAL	FEET	
	FROM	TO
<u>Bentonite</u>	<u>50</u>	<u>0</u>
VOLUME OF MATERIAL USED		
<u>800lbs Bentonite</u>		

SIZE OF CASING: 6 INCHES IN DIAMETER

DEPTH OF WELL: 50 FEET DEEP

WAS ANY CASING REMOVED?  YES  NO  
 If yes, length removed, in feet: \_\_\_\_\_

WAS CASING RIPPED OR PERFORATED?  YES  NO

SIGNATURE-MASTER WELL DRILLER OR SUPERVISING SANITARIAN LICENSE# 224

MWD / MSD / MGS 2-9-21  
 CIRCLE ONE DATE

COUNTY

Pursuant to § 10-624 of the State Govt. Article of the Maryland Code, personal info requested on this form is used in processing this form pursuant to COMAR 26.04.04. Failure to provide the info may result in this form not being processed. You have the right to inspect, amend, or correct this form. The Maryland Department of the Environment is subject to the Maryland Public Information Act. This form may be made available on the Internet via MDE's website and is subject to inspection or copying, in whole or in part, by the public and other governmental agencies, if not protected by federal or State Law.

Real Property Data Search ( w2)

Search Result for HOWARD COUNTY

<a href="#">View Map</a>	<a href="#">View GroundRent Redemption</a>	<a href="#">View GroundRent Registration</a>
--------------------------	--	--

Special Tax Recapture: None

Account Identifier: District - 03 Account Number - 317927

Owner Information

Owner Name:	HOWARD COUNTY CONSERVANCY INC THE	Use: Principal Residence:	RESIDENTIAL NO
Mailing Address:	10520 OLD FREDERICK RD WOODSTOCK MD 21163-	Deed Reference:	/02841/ 00428

Location & Structure Information

Premises Address:	10520 OLD FREDERICK RD WOODSTOCK 21163-0000	Legal Description:	75.87844 A 10520 OLD FREDERICK RD HOWARD COUNTY CONSERVANC
-------------------	--	--------------------	---

Map:	Grid:	Parcel:	Neighborhood:	Subdivision:	Section:	Block:	Lot:	Assessment Year:	Plat No:	18611
0010	0024	0315	3010103.14	0003				2022	Plat Ref:	

Town: None

Primary Structure Built	Above Grade Living Area	Finished Basement Area	Property Land Area	County Use
			75.8700 AC	000000

Stories	Basement	Type	Exterior	Quality	Full/Half Bath	Garage	Last Notice of Major Improvements
			/				

Value Information

	Base Value	Value As of 01/01/2019	Phase-in Assessments As of 07/01/2021	As of 07/01/2022
Land:	37,900	37,900		
Improvements	16,900	16,900		
Total:	54,800	54,800	54,800	
Preferential Land:	0			

Transfer Information

Seller: STATE OF MARYLAND TO THE USE OF	Date: 04/03/1993	Price: \$0
Type: ARMS LENGTH MULTIPLE	Deed1: /02841/ 00428	Deed2:
Seller:	Date:	Price:
Type:	Deed1:	Deed2:
Seller:	Date:	Price:
Type:	Deed1:	Deed2:

Exemption Information

Partial Exempt Assessments:	Class	07/01/2021	07/01/2022
County:	031	0.00	
State:	031	54,800.00	
Municipal:	031	0.00	0.00

Special Tax Recapture: None

Homestead Application Information

Homestead Application Status: No Application

Homeowners' Tax Credit Application Information

Homeowners' Tax Credit Application Status: No Application Date: