

4-13' Lot
2010 00047

APPLICATION

A 22547

P _____

SEWAGE DISPOSAL TESTING

STATE OF MARYLAND - DEPARTMENT OF HEALTH AND MENTAL HYGIENE

HOWARD COUNTY HEALTH DEPARTMENT
ENVIRONMENTAL HEALTH SERVICES
P. O. BOX 476, ELLICOTT CITY, MARYLAND 21043
TELEPHONE: 465-5000, EXT. 356

DISTRICT 4

DATE 11/25/75

Preliminary

TO: THE COUNTY HEALTH OFFICER
ELLICOTT CITY, MARYLAND

I, HEREBY, APPLY FOR THE NECESSARY TEST IN ORDER TO CONSTRUCT (OR RECONSTRUCT) A SEWAGE DISPOSAL SYSTEM.

PROPERTY OWNER Howard Associates

Any questions call:

ADDRESS _____ PHONE Joel Abramson
730-7733

PROPERTY LOCATION:

SUBDIVISION _____ LOT NO. 13 D

ROAD AND DESCRIPTION Old Frederick Road

SIZE OF LOT 1.441 acres TYPE BLDG. 3 or 4

NUMBER OF BEDROOMS

IF NOT SINGLE RESIDENCE DESCRIBE _____ (Single Fmly. Dwllg.)

THE SYSTEM INSTALLED UNDER THIS APPLICATION IS ACCEPTABLE ONLY UNTIL PUBLIC FACILITIES BECOME AVAILABLE.

BLDG. PERMIT SIGNED
AND RETURNED 2/25/77
Serial No. 29284

SIGNATURE OF APPLICANT /s/ Joel Abramson

APPROVED BY Frank Shiner FOR Arguill & French DATE 4/8/76
(KIND OF SYSTEM) _____


REJECTED BY _____ FOR _____ DATE _____
(KIND OF SYSTEM) _____

HOLD PENDING FURTHER TESTS _____ DATE _____

REASONS FOR REJECTION OR HOLDING _____

THIS IS NOT A PERMIT

Owner: Howard Associates
 Teachers Building
 Suite 117
 Columbia, Maryland
 21044

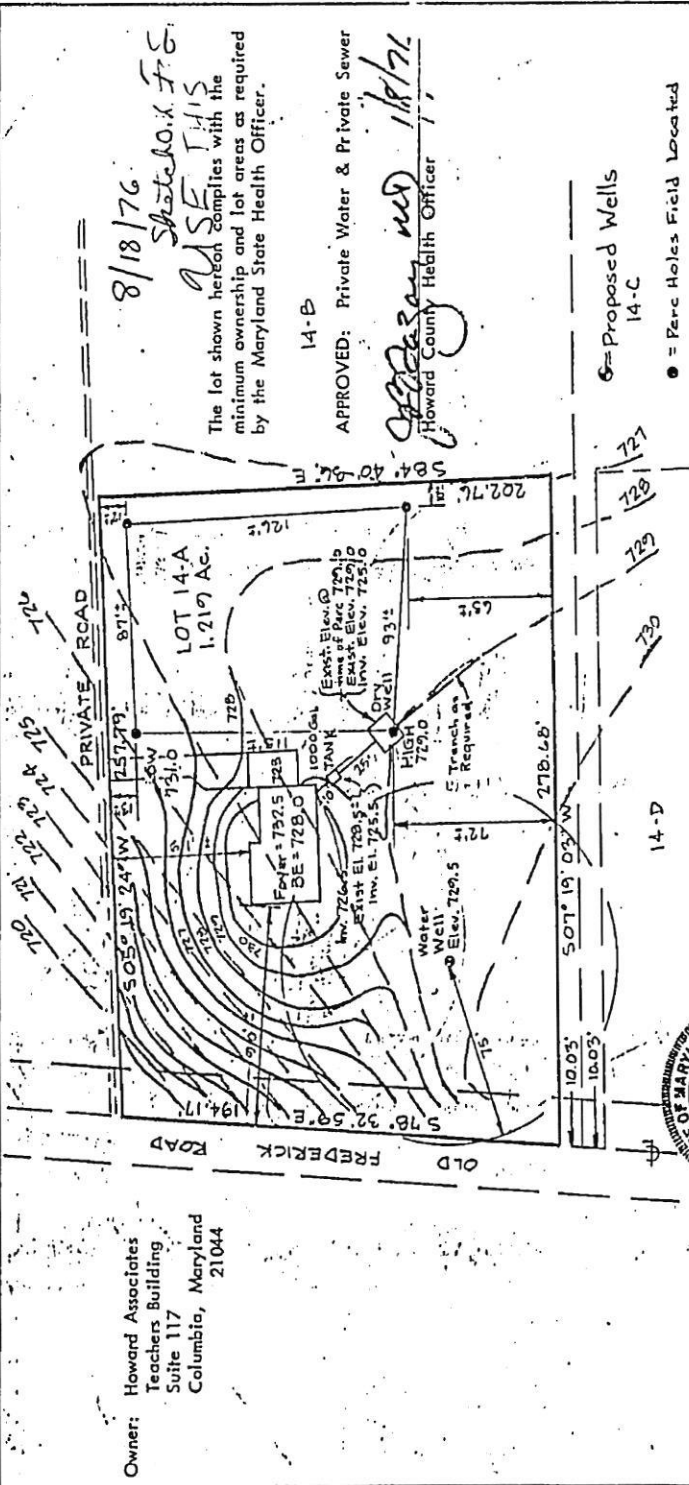

	REFERENCE 	MERIDIAN RICHARD P. BROWNE ASSOCIATES CONSULTING ENGINEERS, PLANNERS WASHINGTON, D.C. COLUMBIA, MD.	MAP OF PROPERTY OF HOWARD ASSOCIATES SITUATED IN 4th Election District Howard County, Md.
PROJECT No. _____ W. O. No. _____	DATE 10-15-75 SCALE 1"=50' DRAWN C.B.M. CHECKED _____ REV. 6-2-76		

BRUNING 43-105 11334

4-13' Lateral
on 10,000 ft.
Preliminary

APPLICATION

A 2/982

SEWAGE DISPOSAL TESTING

STATE OF MARYLAND - DEPARTMENT OF HEALTH AND MENTAL HYGIENE

HOWARD COUNTY HEALTH DEPARTMENT
ENVIRONMENTAL HEALTH SERVICES
P. O. BOX 476, ELLICOTT CITY, MARYLAND 21043
TELEPHONE: 465-3000, EXT. 356

P. _____
DISTRICT 4
DATE 8/20/75

TO: THE COUNTY HEALTH OFFICER
ELLICOTT CITY, MARYLAND

I, HEREBY, APPLY FOR THE NECESSARY TEST IN ORDER TO CONSTRUCT (OR RECONSTRUCT) A SEWAGE DISPOSAL SYSTEM.

PROPERTY OWNER Howard Associates

ADDRESS Suite 118, Teachers Bldg., Columbia, Md. PHONE 730-7733

PROPERTY LOCATION:

SUBDIVISION _____ LOT NO. 14A

ROAD AND DESCRIPTION R/W off Old Frederick Road

SIZE OF LOT 1.219 acres TYPE BLDG. 3 or 4

NUMBER OF BEDROOMS
(Single Fmly. Dwlg.)

IF NOT SINGLE RESIDENCE DESCRIBE _____

THE SYSTEM INSTALLED UNDER THIS APPLICATION IS ACCEPTABLE ONLY UNTIL PUBLIC FACILITIES BECOME AVAILABLE.

SIGNATURE OF APPLICANT /s/ Joel Abramson


✓ APPROVED BY Frank Skinner FOR Orywell & trench DATE 1/27/76
(KIND OF SYSTEM)

REJECTED BY _____ FOR _____ DATE _____
(KIND OF SYSTEM)

HOLD PENDING FURTHER TESTS _____ DATE _____

REASONS FOR REJECTION OR HOLDING _____
BLDG. PERMIT SIGNED
AND RETURNED 8/28/76

THIS IS NOT A PERMIT

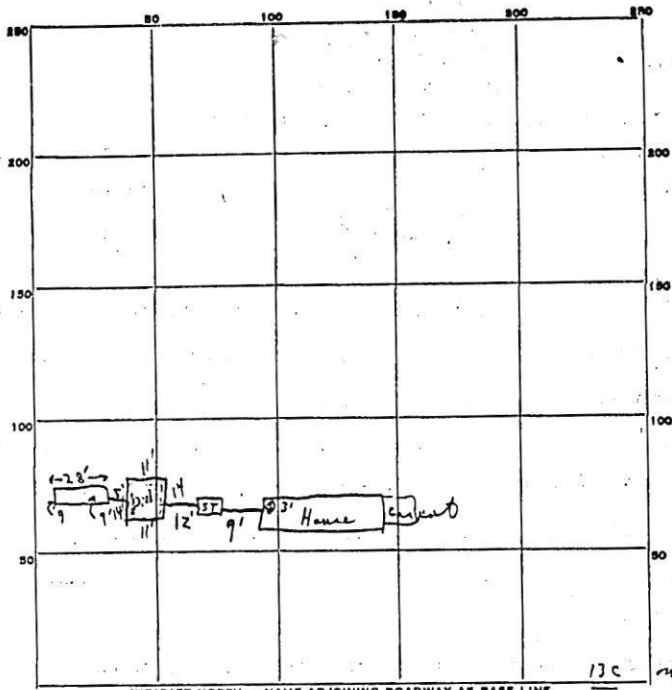

13C

714 Middle trail

PERMIT CARD Up on house S.T. P.W
 SEPTIC TANK, LEVEL ok CLEANOUTS ok | ok
 DISTRIBUTION BOX, LEVEL N/A

Trench
 TRENCH, DEPTH 9 FT. TRENCH WIDTH - FT.
 GRAVEL DEPTH 6 IN. TOTAL LENGTH 28 FT. 16 8
 NUMBER OF TRENCHES 1 TOTAL BOTTOM AREA -
 SEEPAGE PITS, INSIDE DIAMETER 50 1/2 FT. DEPTH BELOW INLET 6 1/2 FT. 328
 ABSORBENT AREA 496 + SQ. FT. 3050

10.00
 76
 6 1/2

REMARKS 6/22/77 Trench ok for gravel only 6/23/77 No charge
6/24/77 so final - ok in A.M.
C.B.D.

DATE SYSTEM APPROVED 6/24/77 copies INSPECTOR C.B.D.

