

8/21/64 approved
B H

PERMIT

P. 08938

A. 08513

SEWAGE DISPOSAL SYSTEM

MARYLAND STATE DEPARTMENT OF HEALTH

HOWARD COUNTY

INDEXED

ELLICOTT CITY

DISTRICT 3

DATE 8/24/64

Elwood Scaggs IS PERMITTED TO INSTALL ALTER

ADDRESS Laurel, Maryland PHONE PA 5-0324

A SEWAGE DISPOSAL SYSTEM LOCATED AT _____

SUBDIVISION _____ ROAD 835 Day Road LOT _____

PROPERTY OWNER ~~Glarence Hasler~~ Jonathan Follmer

ADDRESS Day Rd., Sykesville, Maryland

SPECIFICATIONS 3 bedrooms

DRAIN FIELD _____ DEPTH _____ FEET, BOTTOM AREA _____ SQ. FT.

SEEPAGE PITS _____ ABSORBENT SIDE-WALL AREA _____ SQ. FT.

SEPTIC TANK CAPACITY 750 GALLONS

FOR GARBAGE GRINDER, INCREASE DISPOSAL AREA 22% & TANK CAPACITY 50%.

OTHER Dry well - 300 sq. ft. absorbent side wall area below inlet pipe.


Locate dry well 140 ft. from front lot line and 130 ft. from left side line as lot is seen when facing it from Day Rd.

PLANS APPROVED BY R. D. Fletcher DATE 6/3/64

FILL SEPTIC TANK AND DISTRIBUTION BOX WITH WATER BEFORE CALLING FOR AN INSPECTION. COVER NO WORK UNTIL INSPECTED AND APPROVED.

NEITHER THE HOWARD COUNTY COMMISSIONERS NOR THE HEALTH DEPARTMENT IS RESPONSIBLE FOR THE SUCCESSFUL OPERATION OF ANY SYSTEM.

A 085-13

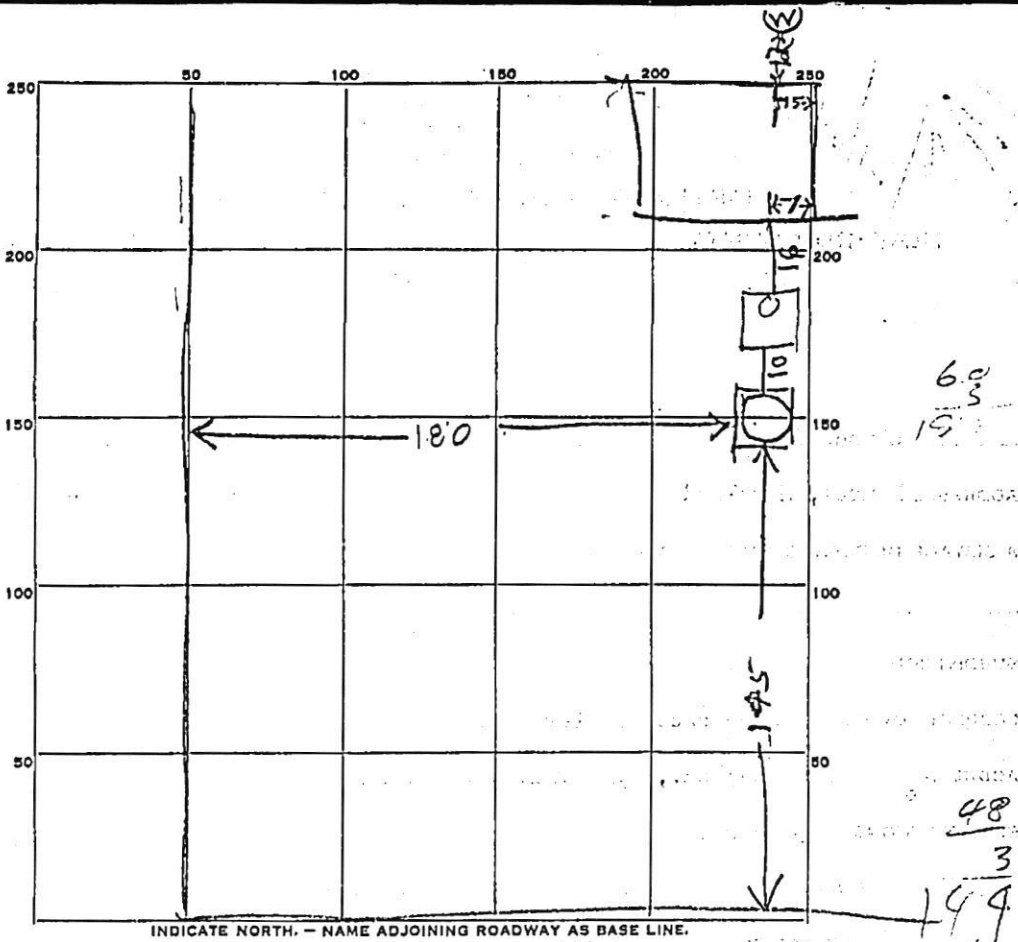

PERMIT CARD _____

SEPTIC TANK, LEVEL OK 750 concrete CLEANOUTS OK

DISTRIBUTION BOX, LEVEL _____

TILE FIELD, DEPTH _____ FT. TRENCH WIDTH _____ FT.

GRAVEL DEPTH _____ IN. TOTAL LENGTH _____ FT.

NUMBER OF TRENCHES _____ TOTAL BOTTOM AREA _____

SEEPAGE PITS, INSIDE DIAMETER 10 FT. DEPTH BELOW INLET 9 FT.

ABSORBENT AREA 323 SQ. FT. counting stone

REMARKS Dry Well J. is 2 ft. below grade


About 1 ft. stone around floor well

(W) = means water well (in back)

DATE SYSTEM APPROVED 31 AUG 69

INSPECTOR Raymond H. [Signature]

31
9
323
37
9
323

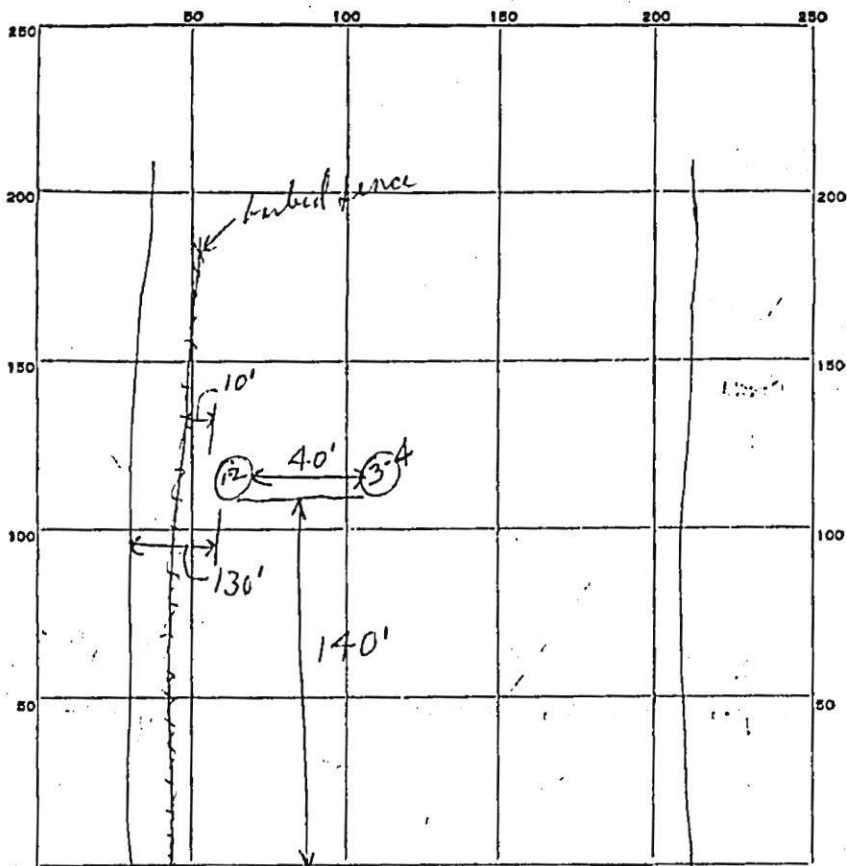

INDICATE NORTH. NAME ADJOINING ROADWAY AS BASE LINE.
Day Rd.

DATE	TEST NO.	DEPTH	PRE-WET		TEST - 1" DROP		TIME
			START	STOP	START	STOP	
6/3/64	1	9 ft.	939	942	942	949	7 min.
	2	4 ft.	940	942	942	950	8 min.
	3	9 ft.	952	—	—	—	1 min.
	4	4 ft.	956	958	958	1002	4 min.

SOIL AUGER FINDING _____

TESTED BY ADF 6/3/64

REMARKS _____

ALSO PRESENT Shannon Bassler LOT NO. _____