



# APPLICATION

## FOR PERCOLATION TESTING AND SITE EVALUATION

TEST DATE(S) \_\_\_\_\_ TEST TIME \_\_\_\_\_ A/P \_\_\_\_\_

AGENCY REVIEW: \_\_\_\_\_ DATE \_\_\_\_\_

DO NOT WRITE ABOVE THIS LINE

I HEREBY APPLY FOR THE NECESSARY TESTING/EVALUATION PRIOR TO ISSUANCE OF SEWAGE DISPOSAL SYSTEM PERMIT(S) TO:

CHECK AS NEEDED:

- CONSTRUCT NEW SEPTIC SYSTEM(S)
- REPAIR/ADD TO AN EXISTING SEPTIC SYSTEM
- REPLACE AN EXISTING SEPTIC SYSTEM

CHECK AS NEEDED:

- NEW STRUCTURE(S)
- ADDITION TO AN EXISTING STRUCTURE
- REPLACE AN EXISTING STRUCTURE

CHECK ONE:

- CREATE NEW LOT(S)
- BUILD ON AN EXISTING LOT IN A SUBDIVISION
- BUILD ON AN EXISTING PARCEL OF RECORD

IS THE PROPERTY WITHIN 2500' OF ANY RESERVOIR?

- YES
- NO

THE TYPE OF STRUCTURE IS:

- RESIDENTIAL WITH \_\_\_\_\_ PROPOSED BEDROOMS IN THE COMPLETED STRUCTURE. (NOTE *UNKNOWN* IF APPROPRIATE)
- COMMERCIAL (PROVIDE DETAIL OF NUMBERS AND TYPES OF EMPLOYEES/ CUSTOMERS ON ACCOMPANYING PLAN)
- INSTITUTIONAL/GOVERNMENT (PROVIDE DETAIL OF NUMBERS AND TYPES OF EMPLOYEES/USERS ON ACCOMPANYING PLAN)

PROPERTY OWNER(S) \_\_\_\_\_

DAYTIME PHONE \_\_\_\_\_ CELL \_\_\_\_\_ FAX \_\_\_\_\_

MAILING ADDRESS \_\_\_\_\_  
STREET CITY/TOWN STATE ZIP

APPLICANT \_\_\_\_\_

DAYTIME PHONE \_\_\_\_\_ CELL \_\_\_\_\_ FAX \_\_\_\_\_

MAILING ADDRESS \_\_\_\_\_  
STREET CITY/TOWN STATE ZIP

APPLICANT'S ROLE: DEVELOPER BUILDER BUYER RELATIVE/FRIEND REALTOR CONSULTANT

PROPERTY LOCATION  
SUBDIVISION/PROPERTY NAME Meriweather Farm LOT NO. 3

PROPERTY ADDRESS \_\_\_\_\_  
STREET TOWN/POST OFFICE

TAX MAP PAGE(S) \_\_\_\_\_ GRID \_\_\_\_\_ PARCEL(S) \_\_\_\_\_ PROPOSED LOT SIZE \_\_\_\_\_


AS APPLICANT, I UNDERSTAND THE FOLLOWING: THE SYSTEM INSTALLED SUBSEQUENT TO THIS APPLICATION IS ACCEPTABLE ONLY UNTIL PUBLIC SEWERAGE IS AVAILABLE. THIS APPLICATION IS COMPLETE WHEN ALL APPLICABLE FEES AND A SUITABLE SITE PLAN HAVE BEEN RECEIVED. I ACCEPT THE RESPONSIBILITY FOR COMPLIANCE WITH ALL M.O.S.H.A. AND "MISS UTILITY" REQUIREMENTS. APPROVAL IS BASED UPON SATISFACTORY REVIEW OF A PERC CERTIFICATION PLAN.

TEST RESULTS WILL BE MAILED TO APPLICANT. \_\_\_\_\_  
SIGNATURE OF APPLICANT

HOWARD COUNTY HEALTH DEPARTMENT, BUREAU OF ENVIRONMENTAL HEALTH, WELL AND SEPTIC PROGRAM  
3525-H ELLICOTT MILLS DRIVE, ELLICOTT CITY, MARYLAND 21043-4544 (410) 313-1771 FAX (410) 313-2648  
TDD (410) 313-2323 TOLL FREE 1-877-4MD-DHMH

# LOT 3

A/P

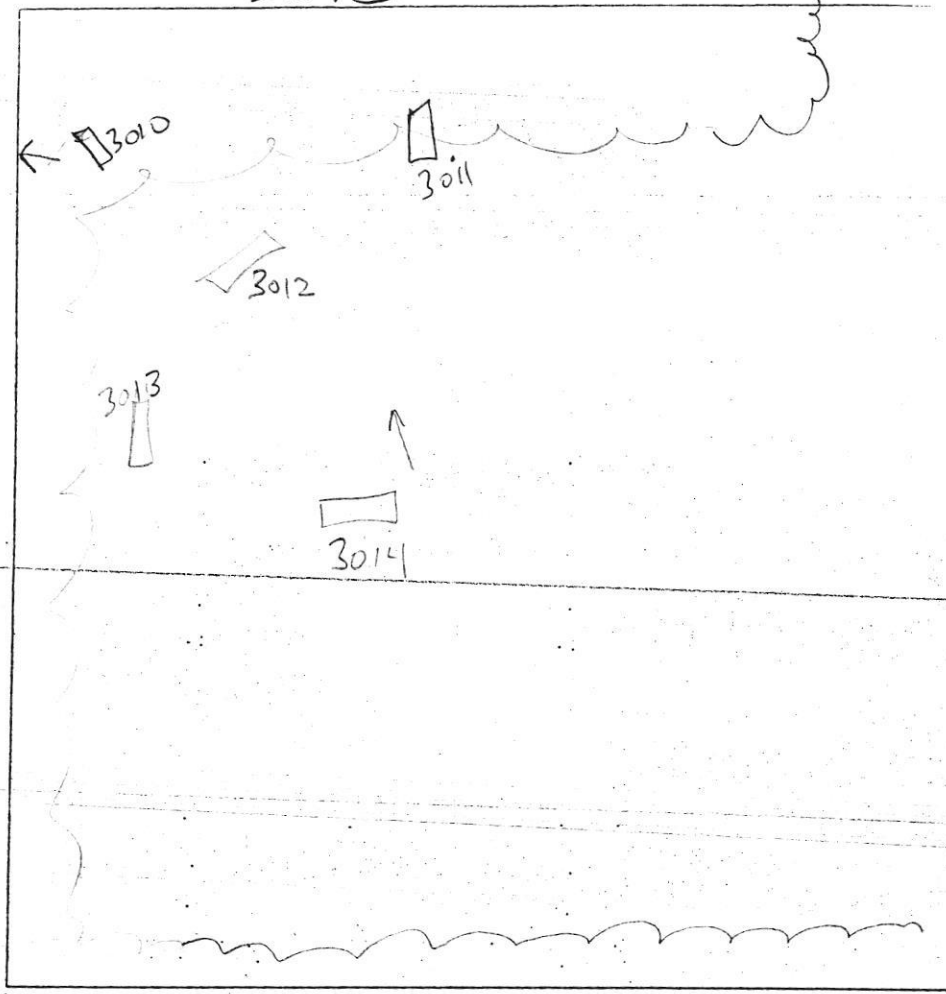

3013  
6"  
brown  
orange brown  
hl → sil  
cw granular  
6'  
yellow brown  
sil sg  
cw  
trace rock  
12.5"

3010  
5"  
brown  
yellow brown  
sg sil  
cw  
4.1  
5% chert  
coarse chert  
yellow brown  
sil sg  
5% chert  
coarse chert  
speculate  
10.9"


3011  
6"  
brown  
yellow brown  
sil sg  
5% chert  
3'  
orange band  
3.10"  
yellow brown  
sil sg  
5% gravel  
cobble  
10.10"

3014  
9"  
brown  
orange brown  
hl → sil  
cw blk  
5% gravel  
4'  
yellow brown  
sil  
gritty due to rock  
strains  
5% gravel  
cobble  
10.3'

3012  
10"  
brown  
orange brown  
hl → sil  
cw blk  
~ 5'  
pink orange  
sil sg  
cw  
5% decomposing  
rock

DATE	TEST #	DEPTH	START	BREAK 1" DROP	STOP 2" DROP	TIME OF 2nd INCH	P/F/H
6-28-05	3014	4'7" / 10'3"	9:58 <sup>02</sup>	10:01 <sup>53</sup>	10:09 <sup>58</sup>	8 <sup>05</sup>	P
	3013	5' / 12'5"	10:06 <sup>32</sup>	10:11 <sup>30</sup>	10:18 <sup>08</sup>	6 <sup>28</sup>	P
	3012	11'10"					VP
	3010	4'5" / 10'9"	11:21 <sup>42</sup>	11:24 <sup>43</sup>	11:30 <sup>17</sup>	5 <sup>26</sup>	P
	3011	4'8" / 10'10"	12:38 <sup>54</sup>	12:41 <sup>34</sup>	12:43 <sup>34</sup>	2	P

REMARKS Holes dug per plan  
 SANITARIAN SF BACKHOE Level Land OTHERS Tim Feago  
 TEST HOLES USED IN SDA \_\_\_\_\_ AVG. PERC TIME 54 SQ. FT/BR \_\_\_\_\_  
 TRENCH WIDTH \_\_\_\_\_ INLET DEPTH \_\_\_\_\_ MAX. BOT DEPTH \_\_\_\_\_ EFFECTIVE SW \_\_\_\_\_

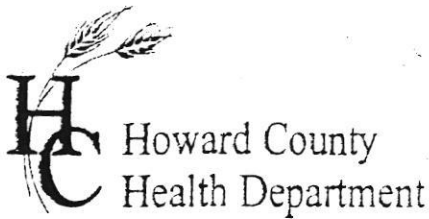

# APPLICATION

## FOR PERCOLATION TESTING AND SITE EVALUATION

Lot 1 1/2, Lot 2

TEST DATE(S) \_\_\_\_\_ TEST TIME \_\_\_\_\_ A/P \_\_\_\_\_

AGENCY REVIEW: \_\_\_\_\_ DATE \_\_\_\_\_

DO NOT WRITE ABOVE THIS LINE

I HEREBY APPLY FOR THE NECESSARY TESTING/EVALUATION PRIOR TO ISSUANCE OF SEWAGE DISPOSAL SYSTEM PERMIT(S) TO:

CHECK AS NEEDED:

- CONSTRUCT NEW SEPTIC SYSTEM(S)
- REPAIR/ADD TO AN EXISTING SEPTIC SYSTEM
- REPLACE AN EXISTING SEPTIC SYSTEM

CHECK AS NEEDED:

- NEW STRUCTURE(S)
- ADDITION TO AN EXISTING STRUCTURE
- REPLACE AN EXISTING STRUCTURE

CHECK ONE:

- CREATE NEW LOT(S)
- BUILD ON AN EXISTING LOT IN A SUBDIVISION
- BUILD ON AN EXISTING PARCEL OF RECORD

IS THE PROPERTY WITHIN 2500' OF ANY RESERVOIR?

- YES
- NO

THE TYPE OF STRUCTURE IS:

- RESIDENTIAL WITH \_\_\_\_\_ PROPOSED BEDROOMS IN THE COMPLETED STRUCTURE. (NOTE *UNKNOWN* IF APPROPRIATE)
- COMMERCIAL (PROVIDE DETAIL OF NUMBERS AND TYPES OF EMPLOYEES/ CUSTOMERS ON ACCOMPANYING PLAN)
- INSTITUTIONAL/GOVERNMENT (PROVIDE DETAIL OF NUMBERS AND TYPES OF EMPLOYEES/USERS ON ACCOMPANYING PLAN)

PROPERTY OWNER(S) \_\_\_\_\_

DAYTIME PHONE \_\_\_\_\_ CELL \_\_\_\_\_ FAX \_\_\_\_\_

MAILING ADDRESS \_\_\_\_\_  
STREET CITY/TOWN STATE ZIP

APPLICANT \_\_\_\_\_

DAYTIME PHONE \_\_\_\_\_ CELL \_\_\_\_\_ FAX \_\_\_\_\_

MAILING ADDRESS \_\_\_\_\_  
STREET CITY/TOWN STATE ZIP

APPLICANT'S ROLE: DEVELOPER BUILDER BUYER RELATIVE/FRIEND REALTOR CONSULTANT

PROPERTY LOCATION  
SUBDIVISION/PROPERTY NAME Meriweather Farm LOT NO. 2

PROPERTY ADDRESS \_\_\_\_\_  
STREET TOWN/POST OFFICE

TAX MAP PAGE(S) \_\_\_\_\_ GRID \_\_\_\_\_ PARCEL(S) \_\_\_\_\_ PROPOSED LOT SIZE \_\_\_\_\_


AS APPLICANT, I UNDERSTAND THE FOLLOWING: THE SYSTEM INSTALLED SUBSEQUENT TO THIS APPLICATION IS ACCEPTABLE ONLY UNTIL PUBLIC SEWERAGE IS AVAILABLE. THIS APPLICATION IS COMPLETE WHEN ALL APPLICABLE FEES AND A SUITABLE SITE PLAN HAVE BEEN RECEIVED. I ACCEPT THE RESPONSIBILITY FOR COMPLIANCE WITH ALL M.O.S.H.A. AND "MISS UTILITY" REQUIREMENTS. APPROVAL IS BASED UPON SATISFACTORY REVIEW OF A PERC CERTIFICATION PLAN.

TEST RESULTS WILL BE MAILED TO APPLICANT.

SIGNATURE OF APPLICANT \_\_\_\_\_

HOWARD COUNTY HEALTH DEPARTMENT, BUREAU OF ENVIRONMENTAL HEALTH, WELL AND SEPTIC PROGRAM  
3525-H ELLICOTT MILLS DRIVE, ELLICOTT CITY, MARYLAND 21043-4544 (410) 313-1771 FAX (410) 313-2648  
TDD (410) 313-2323 TOLL FREE 1-877-4MD-DHMH

1/5/22 A.P. ~~Wanna~~

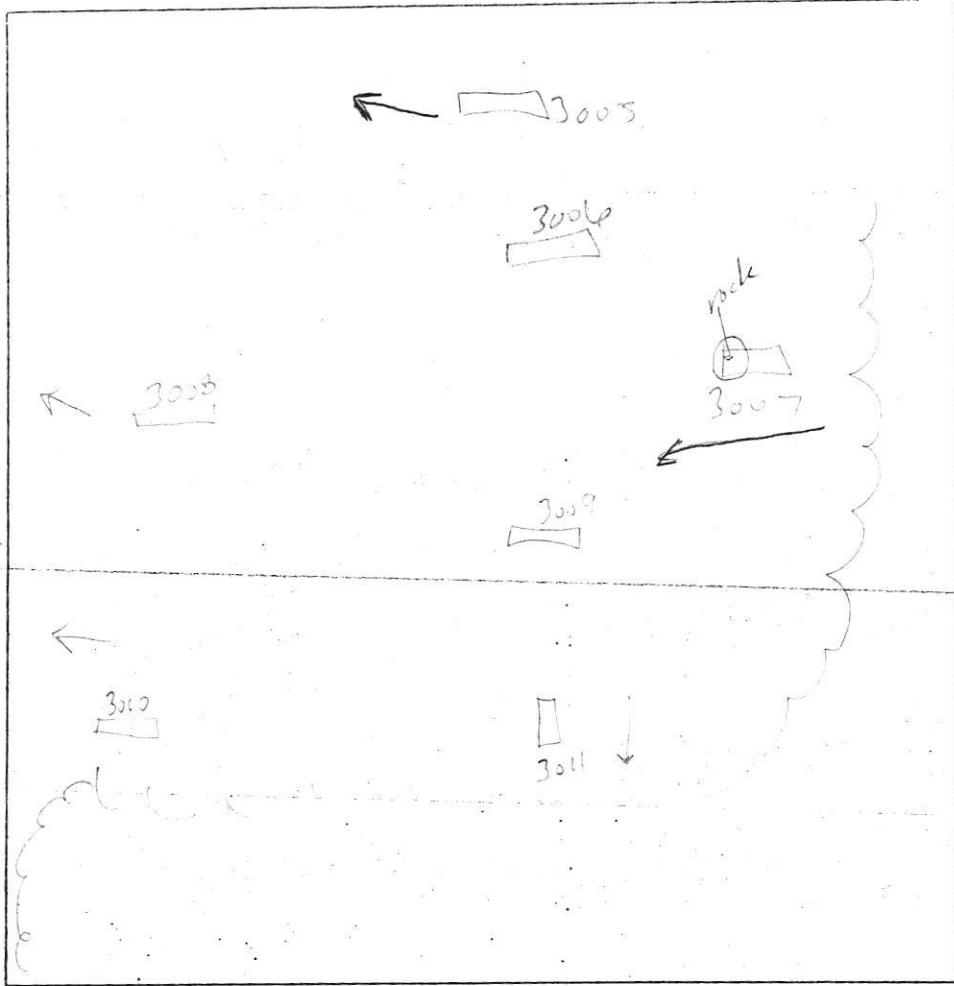

3006  
brown L  
yellow/orange  
brown  
sIL  
cw  
3'  
yellow brown  
sL sg  
10-15%  
concrete chert  
gravel

3005  
brown L  
orange brown  
sIL  
25% gravel  
concrete chert  
2'10"  
4/5-50  
stony

3007  
brown L  
orange brown  
hL  
cw sbk  
1'  
yellow brown  
sL sg  
more  
on  
downhill  
side  
25% cobbles  
stony








3009  
brown L  
root S  
orange brown  
L fine  
cw  
5% gravel  
chert  
3'3"

3008  
yellow orange  
brown  
sIL sg  
10%  
chert/gravel  
cobbles  
9'

3008  
brown L  
orange brown  
L cw  
gr bk  
5% gravels  
~5'  
orange brown  
sIL  
gr sbk  
7'  
rock starts  
10-15%  
gravel/  
cobbles  
stony  
10'

DATE	TEST #	DEPTH	START	BREAK 1" DROP	STOP 2" DROP	TIME OF 2nd INCH	P/F/H
6-28-05	Lot 3 3009	4'4" / 9'	11:31	11:33	11:38	5	P
	3008	5'4" / 10'	12:52 <sup>21</sup>	1:00 <sup>45</sup>	1:13 <sup>24</sup>	12 <sup>21</sup>	P
report	3006	4'1" / 8'	11:43 <sup>42</sup> 11:47 <sup>38</sup>	11:44 11:48 <sup>37</sup>	11:44 <sup>55</sup> 11:50 <sup>57</sup>	2	P
	3005	7'7"	concluded rock HB				F
	3007	4' / 13'	1:13 <sup>27</sup>	1:14 <sup>54</sup>	1:17 <sup>27</sup>	2 <sup>27</sup>	P
	3004?						

REMARKS Holes dug per plan  
 SANITARIAN SF / KN BACKHOE Level Land OTHERS Tim Frage  
 TEST HOLES USED IN SDA \_\_\_\_\_ AVG. PERC TIME \_\_\_\_\_ SQ. FT/BR \_\_\_\_\_  
 TRENCH WIDTH \_\_\_\_\_ INLET DEPTH \_\_\_\_\_ MAX. BOT DEPTH \_\_\_\_\_ EFFECTIVE SW \_\_\_\_\_

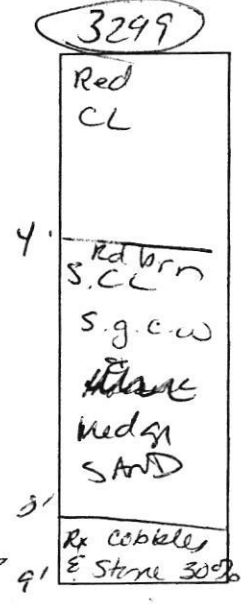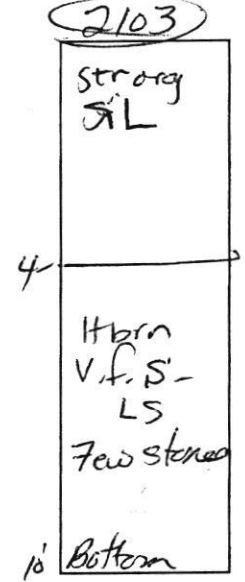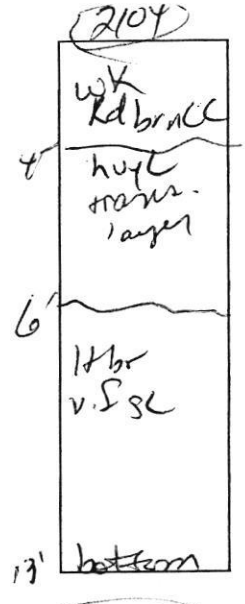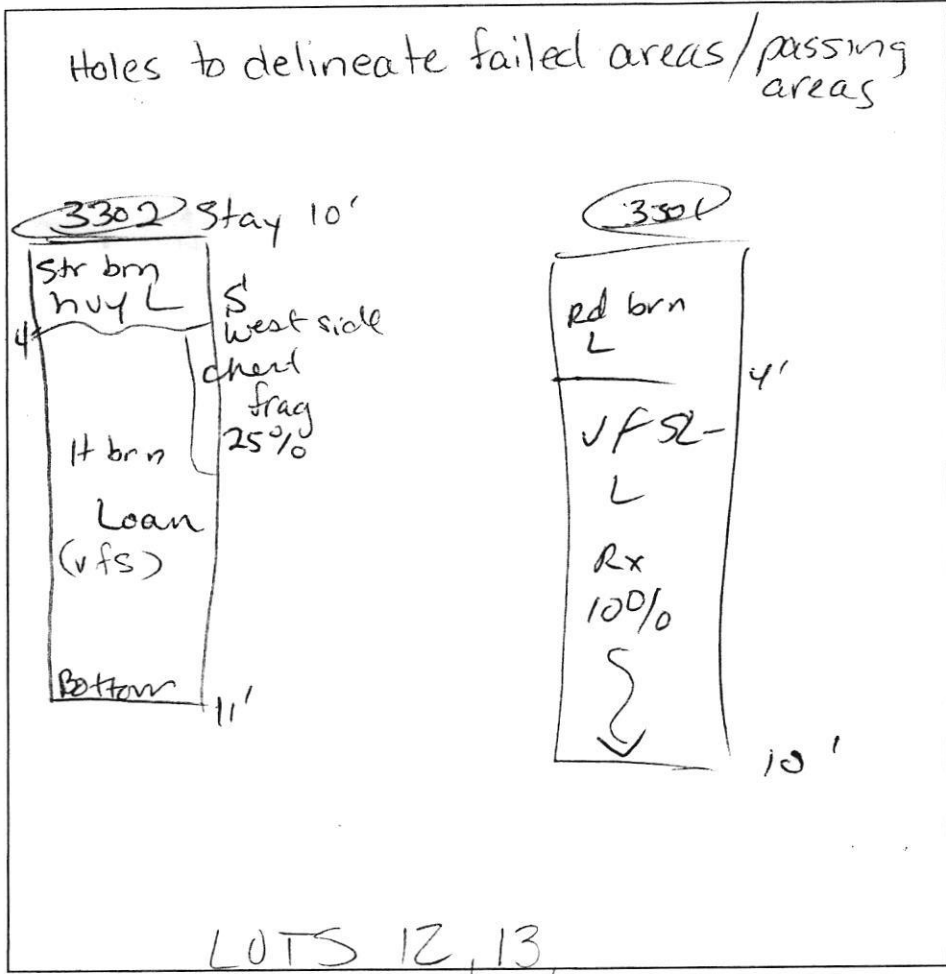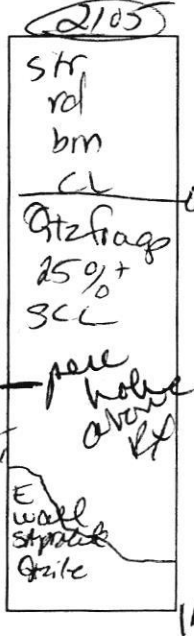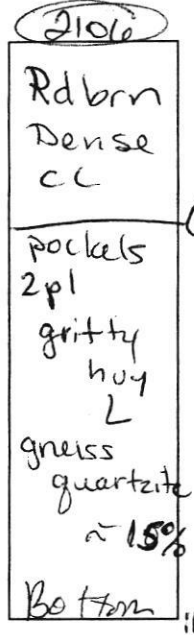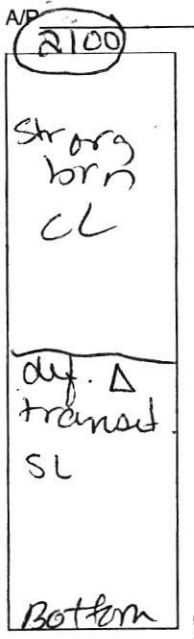


DATE	TEST #	DEPTH	START	BREAK 1" DROP	STOP 2" DROP	TIME OF 2nd INCH	P/F/H
9/15/65	2001	11' Bot	5gall 1:09	1:14	1:21	7	P
	2106	7 1/2' / 11'	1:28	1:42	2:08	26	P
	2105	6 1/2' / 11'	1:45	1:54	2:03	9	P
	2104	4 1/2' / 11'	2:04	2:08	2:15	7	P
	2103	5gallon @ 10'	2:08	2:16	2:16	8	P
	3299	4' 3" / 9'	2:36	2:42	2:54	12	P
	3300	Excessive Rx	Refused	7'			F
	3301	5' / 10'	3:00	3:03	3:07	4	P
	MP 3302	FOUND SOIL	Delineation of excessive chert frags & accept soil.				

REMARKS \_\_\_\_\_

SANITARIAN Kacie BACKHOE Level 2 AND OTHERS Fagan

TEST HOLES USED IN SDA \_\_\_\_\_ AVG. PERC TIME \_\_\_\_\_ SQ. FT/BR \_\_\_\_\_

TRENCH WIDTH \_\_\_\_\_ INLET DEPTH \_\_\_\_\_ MAX. BOT DEPTH \_\_\_\_\_ EFFECTIVE SW \_\_\_\_\_

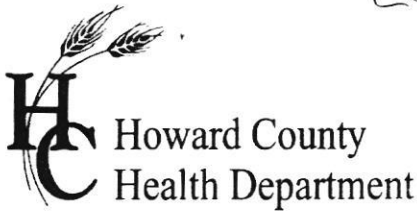

LOT 9,

# APPLICATION

## FOR PERCOLATION TESTING AND SITE EVALUATION

TEST DATE(S) \_\_\_\_\_ TEST TIME \_\_\_\_\_ A/P \_\_\_\_\_

AGENCY REVIEW: \_\_\_\_\_ DATE \_\_\_\_\_

DO NOT WRITE ABOVE THIS LINE

I HEREBY APPLY FOR THE NECESSARY TESTING/EVALUATION PRIOR TO ISSUANCE OF SEWAGE DISPOSAL SYSTEM PERMIT(S) TO:

CHECK AS NEEDED:

- CONSTRUCT NEW SEPTIC SYSTEM(S)
- REPAIR/ADD TO AN EXISTING SEPTIC SYSTEM
- REPLACE AN EXISTING SEPTIC SYSTEM

CHECK AS NEEDED:

- NEW STRUCTURE(S)
- ADDITION TO AN EXISTING STRUCTURE
- REPLACE AN EXISTING STRUCTURE

CHECK ONE:

- CREATE NEW LOT(S)
- BUILD ON AN EXISTING LOT IN A SUBDIVISION
- BUILD ON AN EXISTING PARCEL OF RECORD

IS THE PROPERTY WITHIN 2500' OF ANY RESERVOIR?

- YES
- NO

THE TYPE OF STRUCTURE IS:

- RESIDENTIAL WITH \_\_\_\_\_ PROPOSED BEDROOMS IN THE COMPLETED STRUCTURE (NOTE **UNKNOWN** IF APPROPRIATE)
- COMMERCIAL (PROVIDE DETAIL OF NUMBERS AND TYPES OF EMPLOYEES/ CUSTOMERS ON ACCOMPANYING PLAN)
- INSTITUTIONAL/GOVERNMENT (PROVIDE DETAIL OF NUMBERS AND TYPES OF EMPLOYEES/USERS ON ACCOMPANYING PLAN)

PROPERTY OWNER(S) \_\_\_\_\_

DAYTIME PHONE \_\_\_\_\_ CELL \_\_\_\_\_ FAX \_\_\_\_\_

MAILING ADDRESS \_\_\_\_\_  
STREET CITY/TOWN STATE ZIP

APPLICANT \_\_\_\_\_

DAYTIME PHONE \_\_\_\_\_ CELL \_\_\_\_\_ FAX \_\_\_\_\_

MAILING ADDRESS \_\_\_\_\_  
STREET CITY/TOWN STATE ZIP

APPLICANT'S ROLE: DEVELOPER BUILDER BUYER RELATIVE/FRIEND REALTOR CONSULTANT

PROPERTY LOCATION  
SUBDIVISION/PROPERTY NAME \_\_\_\_\_ LOT NO. \_\_\_\_\_

PROPERTY ADDRESS \_\_\_\_\_  
STREET TOWN/POST OFFICE

TAX MAP PAGE(S) \_\_\_\_\_ GRID \_\_\_\_\_ PARCEL(S) \_\_\_\_\_ PROPOSED LOT SIZE \_\_\_\_\_



AS APPLICANT, I UNDERSTAND THE FOLLOWING: THE SYSTEM INSTALLED SUBSEQUENT TO THIS APPLICATION IS ACCEPTABLE ONLY UNTIL PUBLIC SEWERAGE IS AVAILABLE. THIS APPLICATION IS COMPLETE WHEN ALL APPLICABLE FEES AND A SUITABLE SITE PLAN HAVE BEEN RECEIVED. I ACCEPT THE RESPONSIBILITY FOR COMPLIANCE WITH ALL M.O.S.H.A. AND "MISS UTILITY" REQUIREMENTS. APPROVAL IS BASED UPON SATISFACTORY REVIEW OF A PERC CERTIFICATION PLAN.

TEST RESULTS WILL BE MAILED TO APPLICANT. \_\_\_\_\_  
SIGNATURE OF APPLICANT

HOWARD COUNTY HEALTH DEPARTMENT, BUREAU OF ENVIRONMENTAL HEALTH, WELL AND SEPTIC PROGRAM  
3525-H ELLICOTT MILLS DRIVE, ELLICOTT CITY, MARYLAND 21043-4544 (410) 313-1771 FAX (410) 313-2648  
TDD (410) 313-2323 TOLL FREE 1-877-4MD-DHMH



LEGEND	
SYMBOL	DESCRIPTION
---	EXISTING CONTOUR 2' INTERVAL
---	PROPOSED CONTOUR 2' INTERVAL
X362.5	SPOT ELEVATION
---SF---SF---	SUPER SILT FENCE
---SF---	SILT FENCE
-----PESHC-----	PERMANENT SOIL STABILIZATION MATTING
---	LIMITS OF DISTURBANCE
---	SOILS LINE & TYPE

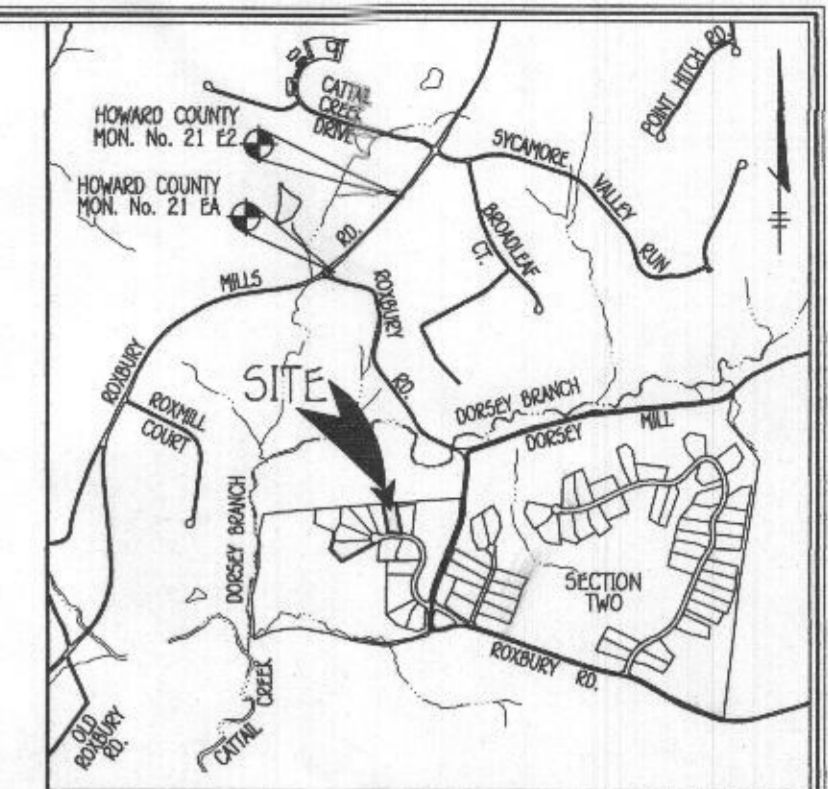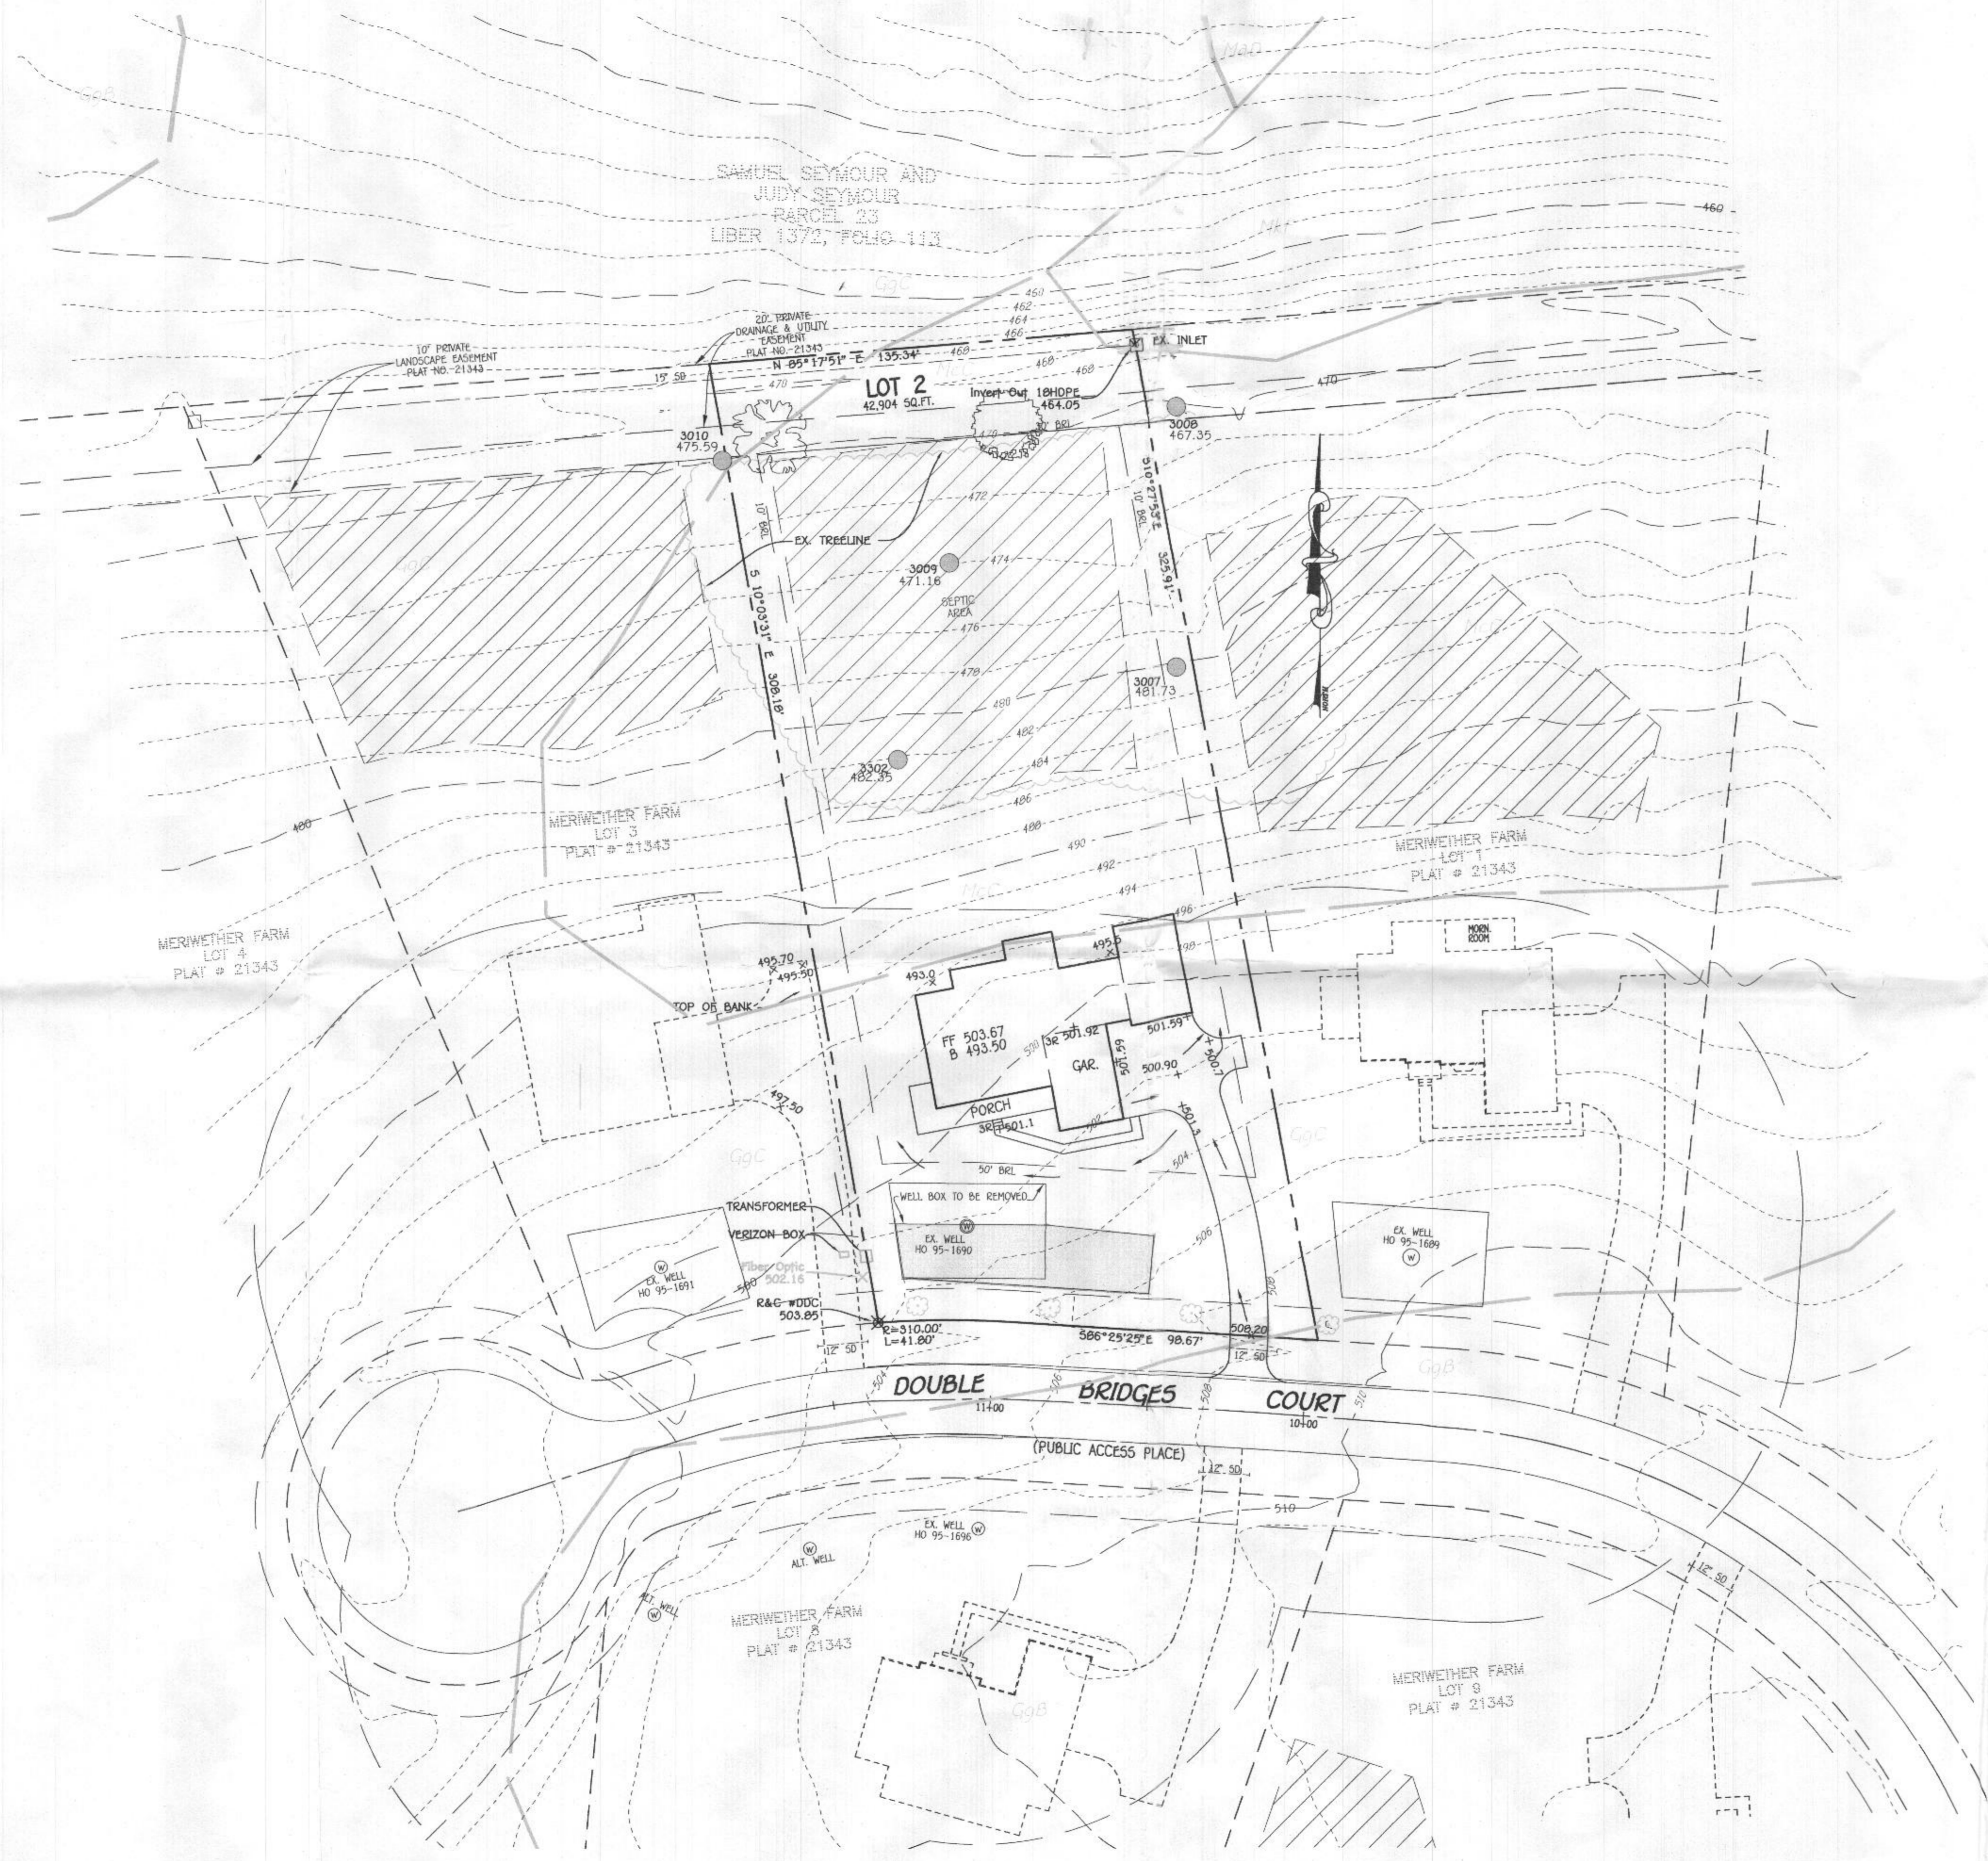

VICINITY MAP  
SCALE: 1" = 2000'  
HOWARD COUNTY ADC MAP  
MAP NO: 4812, GRID NO: D-9

**GENERAL NOTES:**

- THIS AREA DESIGNATES A PRIVATE SEWERAGE EASEMENT OF AT LEAST 10,000 SQUARE FEET AS REQUIRED BY THE MARYLAND STATE DEPARTMENT OF THE ENVIRONMENT FOR INDIVIDUAL SEWERAGE DISPOSAL IMPROVEMENTS OF ANY NATURE IN THIS AREA ARE RESTRICTED UNTIL PUBLIC SEWERAGE IS AVAILABLE. THESE EASEMENTS SHALL BECOME NULL AND VOID UPON CONNECTION TO A PUBLIC SEWERAGE SYSTEM. THE COUNTY HEALTH OFFICER SHALL HAVE THE AUTHORITY TO GRANT ADJUSTMENTS TO THE PRIVATE SEWERAGE EASEMENT, RECOGNITION OF A MODIFIED SEWERAGE EASEMENT SHALL NOT BE NECESSARY.
- ADJUSTMENTS TO SEPTIC EASEMENT AREA IS NOT PERMITTED WITHOUT ADDITIONAL TESTING.
- THE LOT SHOWN HEREON COMPLIES WITH THE MINIMUM OWNERSHIP WIDTH AND LOT AREA AS REQUIRED BY THE MARYLAND STATE DEPARTMENT OF THE ENVIRONMENT.
- EXISTING WELLS AND/OR SEWERAGE EASEMENTS WITHIN 100 FEET OF THE PROPERTY HAVE BEEN SHOWN FROM ALL REASONABLE EFFORTS.
- ALL HOUSE SITES SHOWN COMPLY WITH MINIMUM BUILDING RESTRICTION REGULATIONS.
- TOPOGRAPHY SHOWN HEREON BASED ON FIELD RUN TOPOGRAPHIC SURVEY CONDUCTED BY FISHER, COLLINS & CARTER, INC. IN DECEMBER 2015. TOPOGRAPHY IS SUPPLEMENTED BY HOWARD COUNTY 200 SCALE TOPOGRAPHY.
- BOUNDARY OUTLINE BASED ON AVAILABLE DEED OF RECORD WITHOUT THE BENEFIT OF A FIELD SURVEY AT THIS TIME.
- ANY CHANGES TO A PRIVATE SEWERAGE EASEMENT SHALL REQUIRE A REVISED PERC CERTIFICATION PLAN.
- PLAT NOS. 21339 THRU 21344.

PERC CERTIFICATION  
I certify that the locations shown hereon are based on field locations done under my direct supervision and are correct to the best of my professional knowledge and belief.

*Terrell A. Fisher*  
Signature of Professional Land Surveyor  
Terrell A. Fisher, Professional Land Surveyor  
12/13/17  
Date

APPROVED FOR PRIVATE WATER AND PRIVATE SEWERAGE SYSTEMS,  
HOWARD COUNTY HEALTH DEPARTMENT.

*Mauna Rossman*  
Signature of Mauna Rossman  
COUNTY HEALTH OFFICER  
4/7/2017  
DATE

SOILS LEGEND		
SOIL	NAME	CLASS
GgB	Glenelg loam, 3 to 8 percent slopes	B
GgC	Glenelg loam, 8 to 15 percent slopes	B
McC	Manor-channery loam, 8 to 15 percent slopes	B
MaD	Manor loam, 15 to 25 percent slopes	B
MkF	Manor-Brinklow complex, 25 to 65 percent slopes, very rocky	B



WELL CERTIFICATION:  
THE EXISTING WELL, TAG NO. HO-95-1690, HAS BEEN FIELD LOCATED AND IS ACCURATELY SHOWN.

PERC RECERTIFICATION PLAT  
MERIWETHER FARM  
SECTION ONE  
LOT 2

BUILDER/DEVELOPER  
BURKARD HOMES  
5300 DORSEY HILL DRIVE,  
SUITE 107  
ELLCOTT CITY, MARYLAND 21042  
(443) 367-0422

TAX MAP NO.: 21 PARCEL NO.: 24 GRID NO.: 21  
ZONED: RC-DEO PLAT NO.: 21342  
4TH ELECTION DISTRICT HOWARD COUNTY, MARYLAND  
SCALE: 1"=30' DATE: MARCH 27, 2017  
SHEET 1 OF 1

LEGEND	
SYMBOL	DESCRIPTION
---	EXISTING CONTOUR 2' INTERVAL
- - -	PROPOSED CONTOUR 2' INTERVAL
x362.5	SPOT ELEVATION
---SF---	SUPER SILT FENCE
-SF-SF-	SILT FENCE
PS&PC	PERMANENT SOIL STABILIZATION MATTING
LOD	LIMITS OF DISTURBANCE
---	SOILS LINE & TYPE

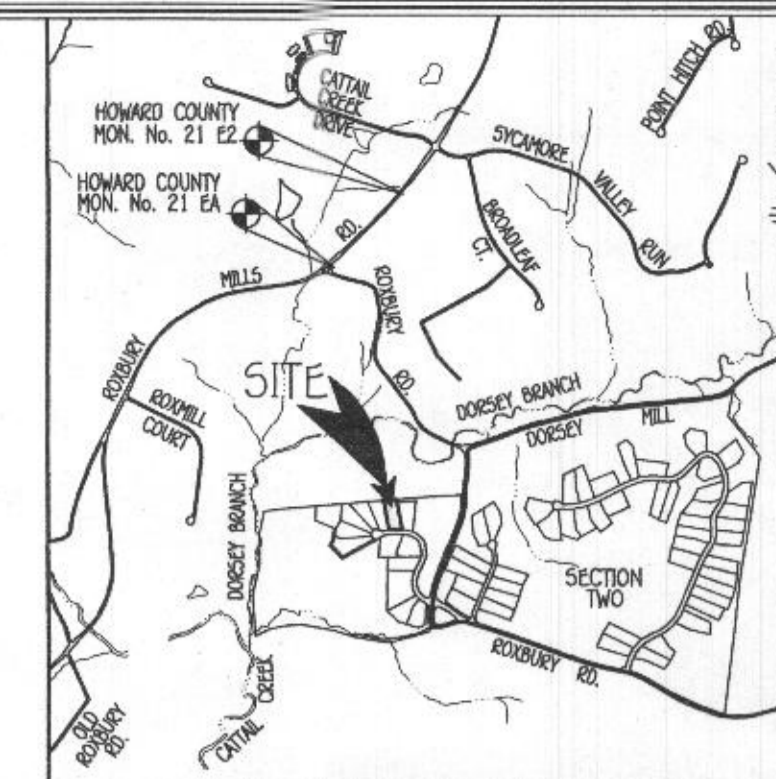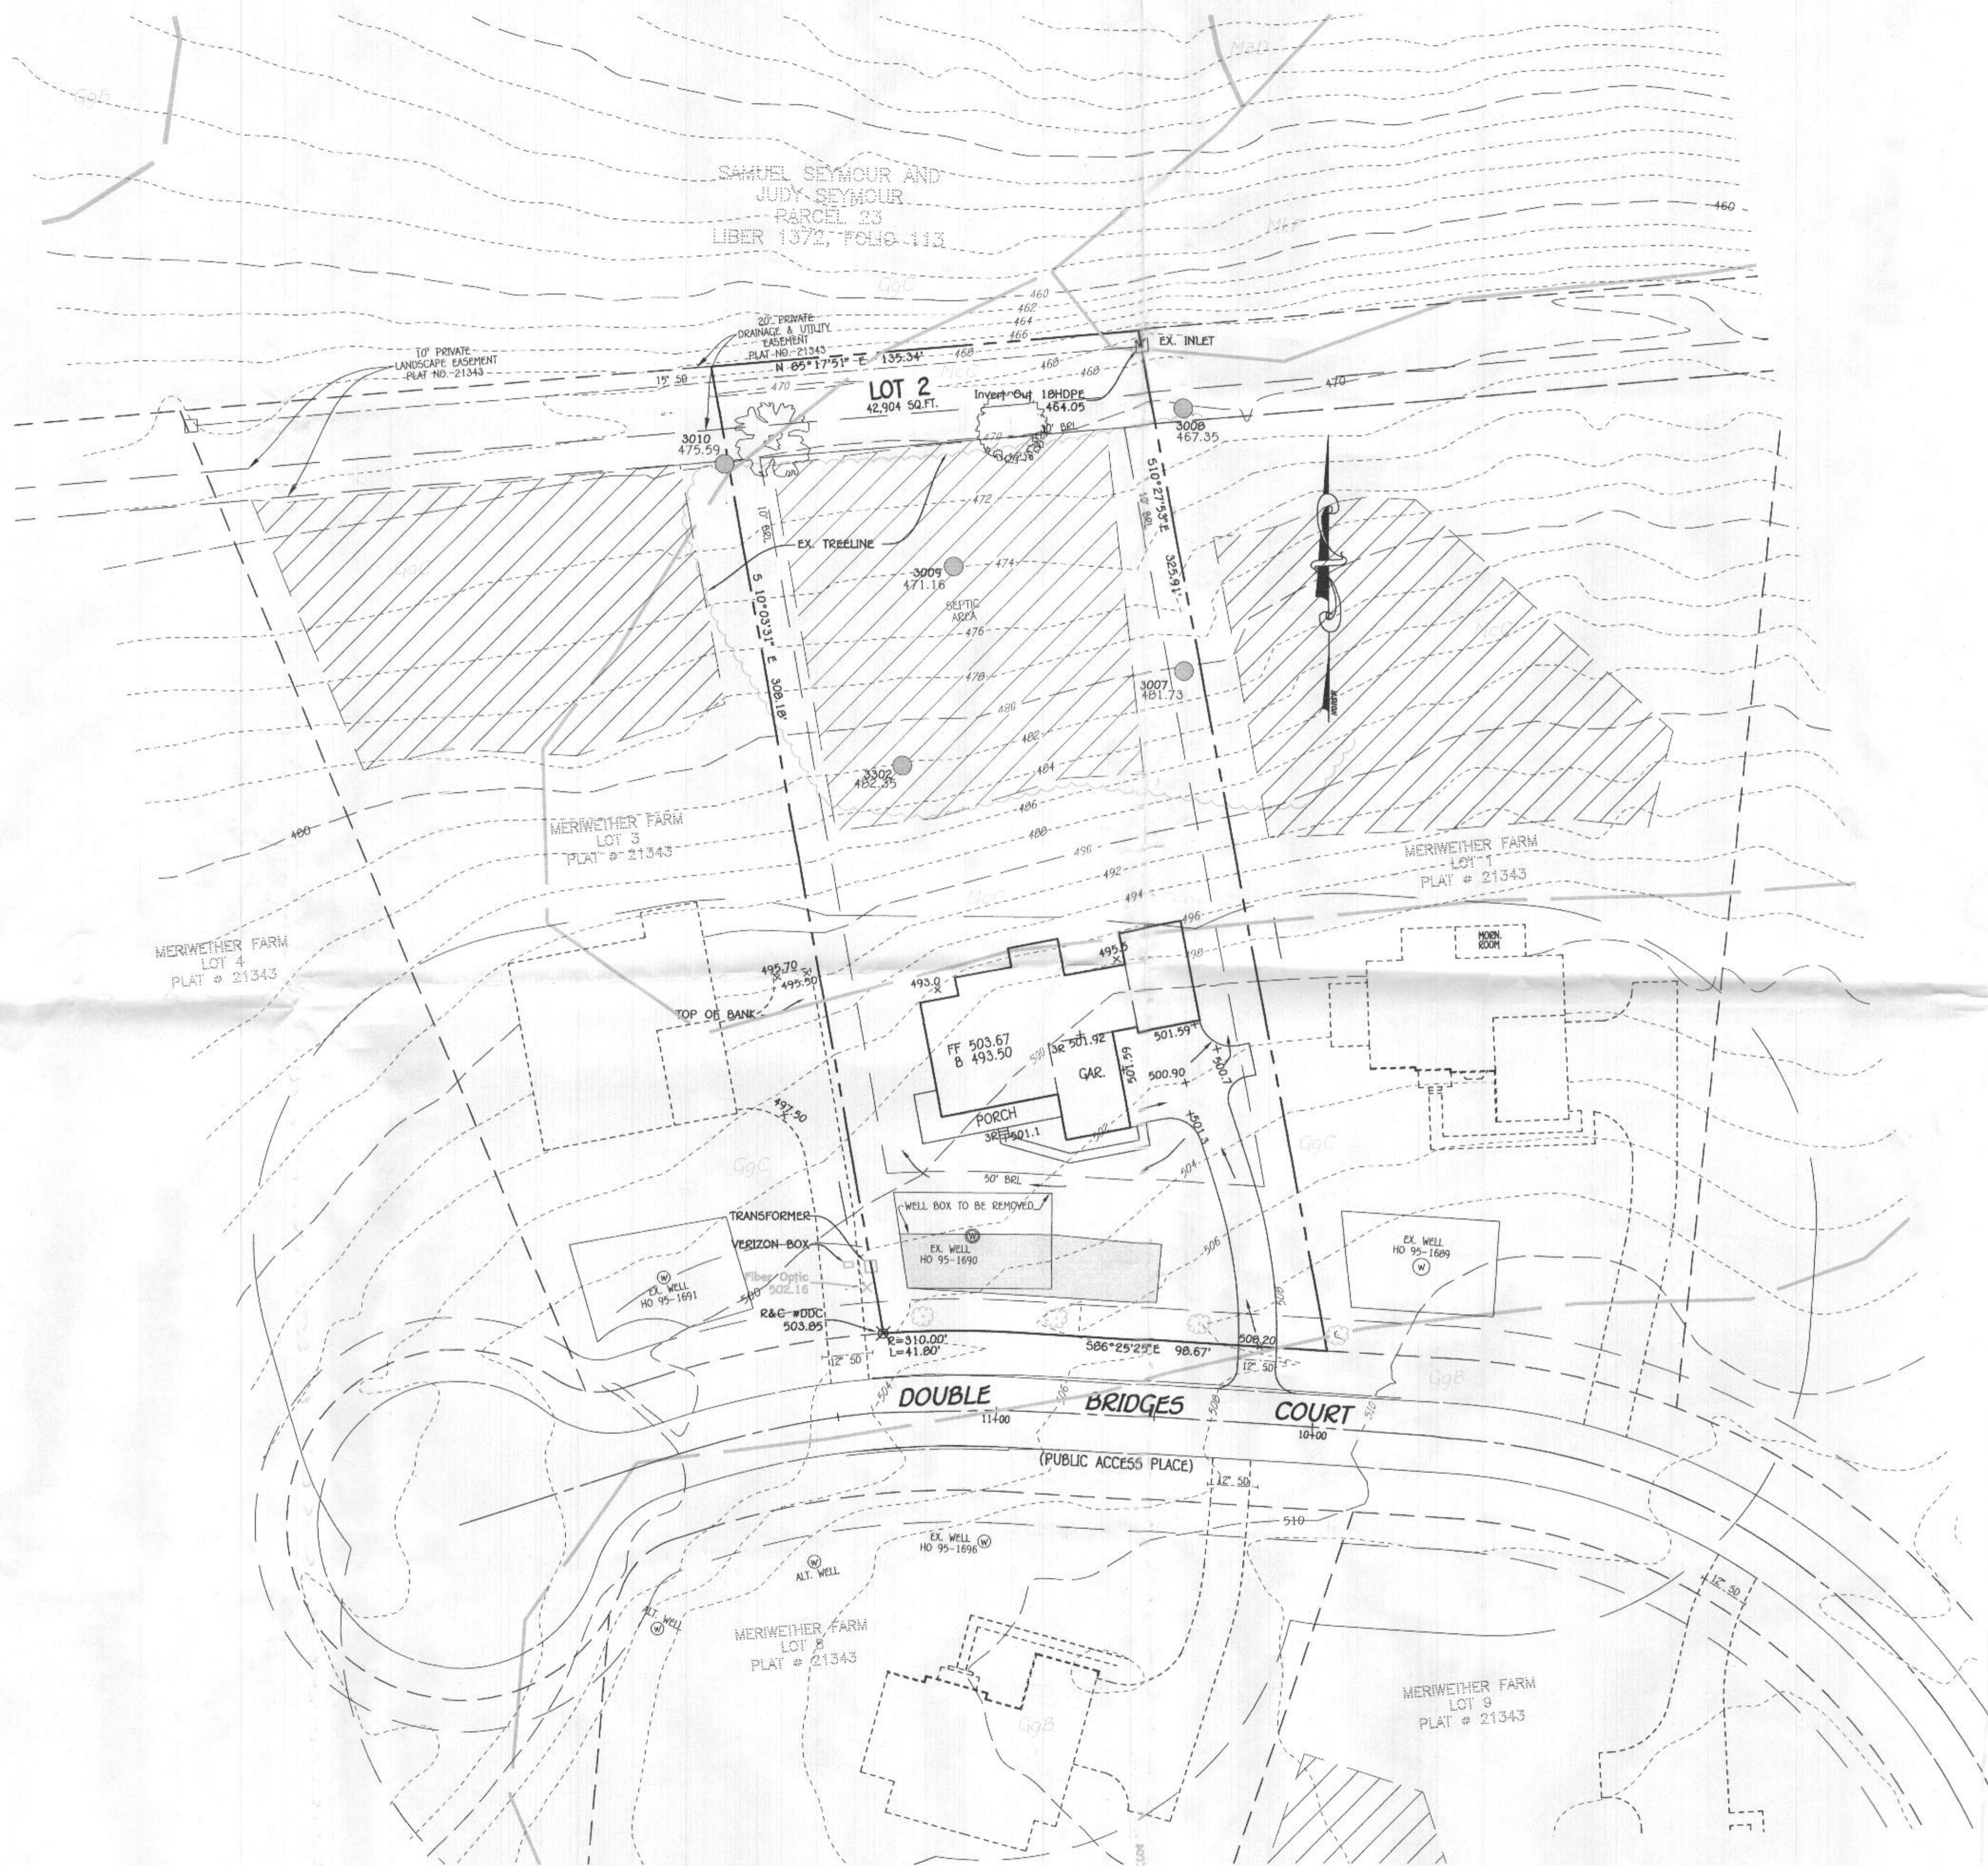

VICINITY MAP  
SCALE: 1" = 2000'  
HOWARD COUNTY ADC MAP  
MAP NO.: 4812, GRID NO.: D-9

**GENERAL NOTES:**

- THIS AREA DESIGNATES A PRIVATE SEWERAGE EASEMENT OF AT LEAST 10,000 SQUARE FEET AS REQUIRED BY THE MARYLAND STATE DEPARTMENT OF THE ENVIRONMENT FOR INDIVIDUAL SEWERAGE DISPOSAL IMPROVEMENTS OF ANY NATURE IN THIS AREA ARE RESTRICTED UNTIL PUBLIC SEWERAGE IS AVAILABLE. THESE EASEMENTS SHALL BECOME NULL AND VOID UPON CONNECTION TO A PUBLIC SEWERAGE SYSTEM. THE COUNTY HEALTH OFFICER SHALL HAVE THE AUTHORITY TO GRANT ADJUSTMENTS TO THE PRIVATE SEWERAGE EASEMENT. RECORDED OF A MODIFIED SEWERAGE EASEMENT SHALL NOT BE NECESSARY.
- ADJUSTMENTS TO SEPTIC EASEMENT AREA IS NOT PERMITTED WITHOUT ADDITIONAL TESTING.
- THE LOT SHOWN HEREON COMPLIES WITH THE MINIMUM OWNERSHIP WIDTH AND LOT AREA AS REQUIRED BY THE MARYLAND STATE DEPARTMENT OF THE ENVIRONMENT.
- EXISTING WELLS AND/OR SEWERAGE EASEMENTS WITHIN 100 FEET OF THE PROPERTY HAVE BEEN SHOWN FROM ALL REASONABLE EFFORTS.
- ALL HOUSE SITES SHOWN COMPLY WITH MINIMUM BUILDING RESTRICTION REGULATIONS.
- TOPOGRAPHY SHOWN HEREON BASED ON FIELD RUN TOPOGRAPHIC SURVEY CONDUCTED BY FISHER, COLLINS & CARTER, INC. IN DECEMBER 2015. TOPOGRAPHY IS SUPPLEMENTED BY HOWARD COUNTY 200 SCALE TOPOGRAPHY.
- BOUNDARY OUTLINE BASED ON AVAILABLE DEED OF RECORD WITHOUT THE BENEFIT OF A FIELD SURVEY AT THIS TIME.
- ANY CHANGES TO A PRIVATE SEWERAGE EASEMENT SHALL REQUIRE A REVISED PERC CERTIFICATION PLAN.
- PLAT NOS. 21339 THRU 21344.

PERC CERTIFICATION  
I certify that the locations shown hereon are based on field locations done under my direct supervision and are correct to the best of my professional knowledge and belief.

*Terrell A. Fisher*  
Signature of Professional Land Surveyor  
Terrell A. Fisher, Professional Land Surveyor  
Date: 3/27/17  
Expires 12/13/17

APPROVED FOR PRIVATE WATER AND PRIVATE SEWERAGE SYSTEMS,  
HOWARD COUNTY HEALTH DEPARTMENT.

*Terrell A. Fisher*  
Signature of Professional Land Surveyor  
COUNTY HEALTH OFFICER  
Date: 4/7/2017

SOILS LEGEND		
SOIL	NAME	CLASS
GgB	Glencig loam, 3 to 8 percent slopes	B
GgC	Glencig loam, 8 to 15 percent slopes	B
McC	Manor-channery loam, 8 to 15 percent slopes	B
MdD	Manor loam, 15 to 25 percent slopes	B
MlF	Manor-Brinklow complex, 25 to 65 percent slopes, very rocky	B

WELL CERTIFICATION:  
THE EXISTING WELL, TAG NO. HO-95-1690, HAS BEEN FIELD LOCATED AND IS ACCURATELY SHOWN.

PERC RECERTIFICATION PLAT  
MERIWETHER FARM  
SECTION ONE  
LOT 2

BUILDER/DEVELOPER  
BURKARD HOMES  
5300 DORSEY HALL DRIVE,  
SUITE 107  
ELLCOTT CITY, MARYLAND 21042  
(443) 367-0422

TAX MAP NO.: 21 PARCEL NO.: 24 GRID NO.: 21  
ZONED: RC-DEO PLAT NO.: 21342  
4TH ELECTION DISTRICT HOWARD COUNTY, MARYLAND  
SCALE: 1"=30' DATE: MARCH 27, 2017  
SHEET 1 OF 1