


SITE INSPECTION SHEET

OWNER: Elkridge FD PHONE #: _____
ADDRESS: 6264 Old Washington Rd. CONTRACTOR: _____
_____ WELL TAG #: _____
SUBDIVISION: _____ LOT: _____ COUNTY #: _____
PROPOSAL: _____

LOCATION DIAGRAM

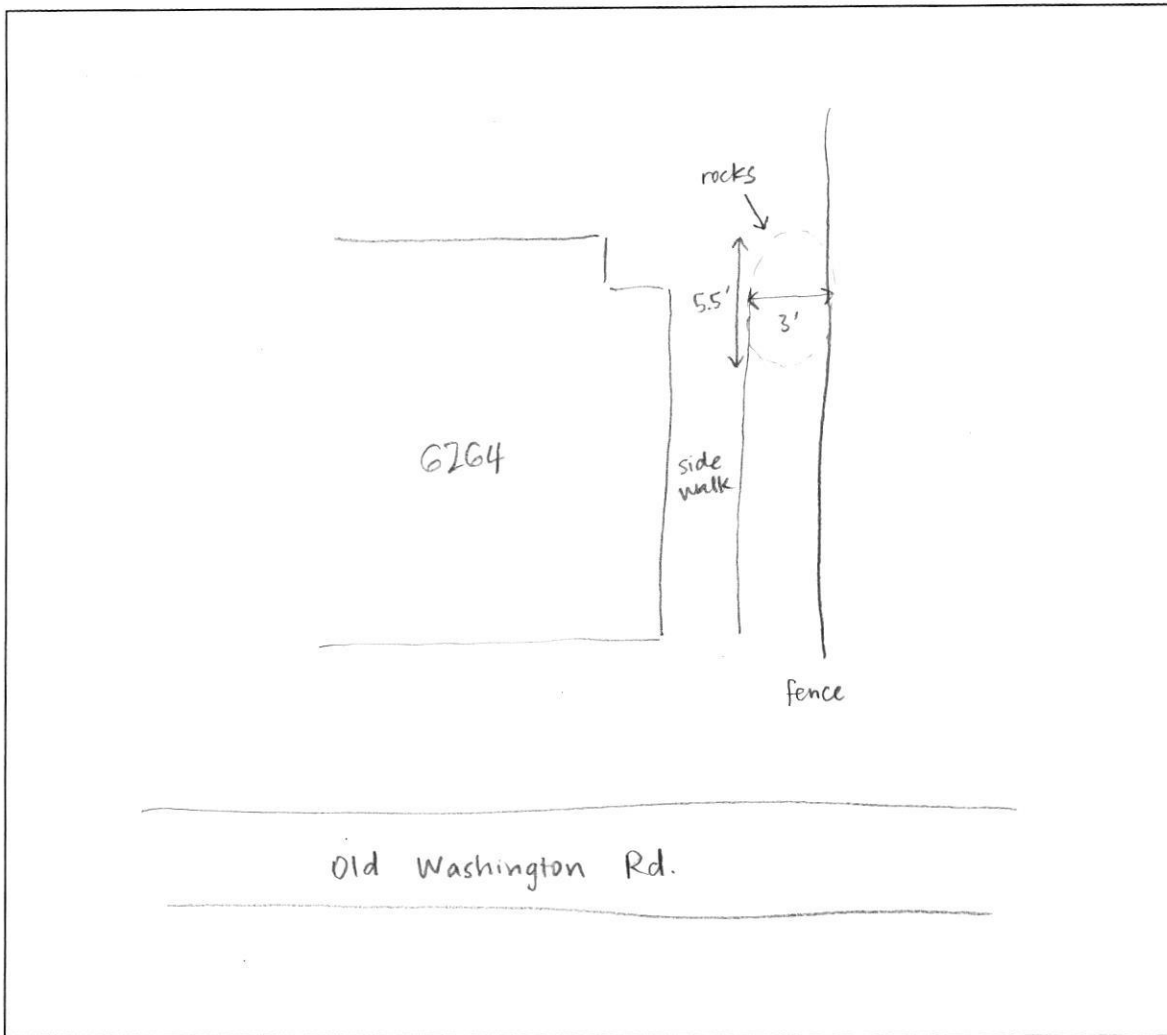

COMMENTS: Site visit to see hand dug well. Russell with the Elkridge FD filled hole with rocks for safety purposes. They'll monitor area and add more rocks if settling occurs. Neighbor at 6253 had some settling at fence adjacent to hole.

DATE: 4/6/15 INSPECTOR: Sarah Collins



4/6/15
6264 Old Washington Rd.

