


# LOT 2

AP

③  
Brown L  
1'  
Red/Brown micaceous sl w/ 5% Saponite  
3 1/2'  
Yellow/Brown micaceous sl w/ 10% chert Qtz + flaggy Saponite  
11'

④  
Brown L  
1/2'  
Yellow/Brown sl w/ 30-40% flaggy mica schist  
5 1/2'  
Yellow/Brown micaceous sl w/ < 50% strong Qtz/ mica schist  
7 1/2'

②  
Brown L  
1'  
Yellow/Brown micaceous sl  
4'  
Yellow/Brown micaceous sl w/ 25-30% mica schist  
7 1/2'  
Yellow/Brown micaceous sl w/ 40% mica schist  
11'

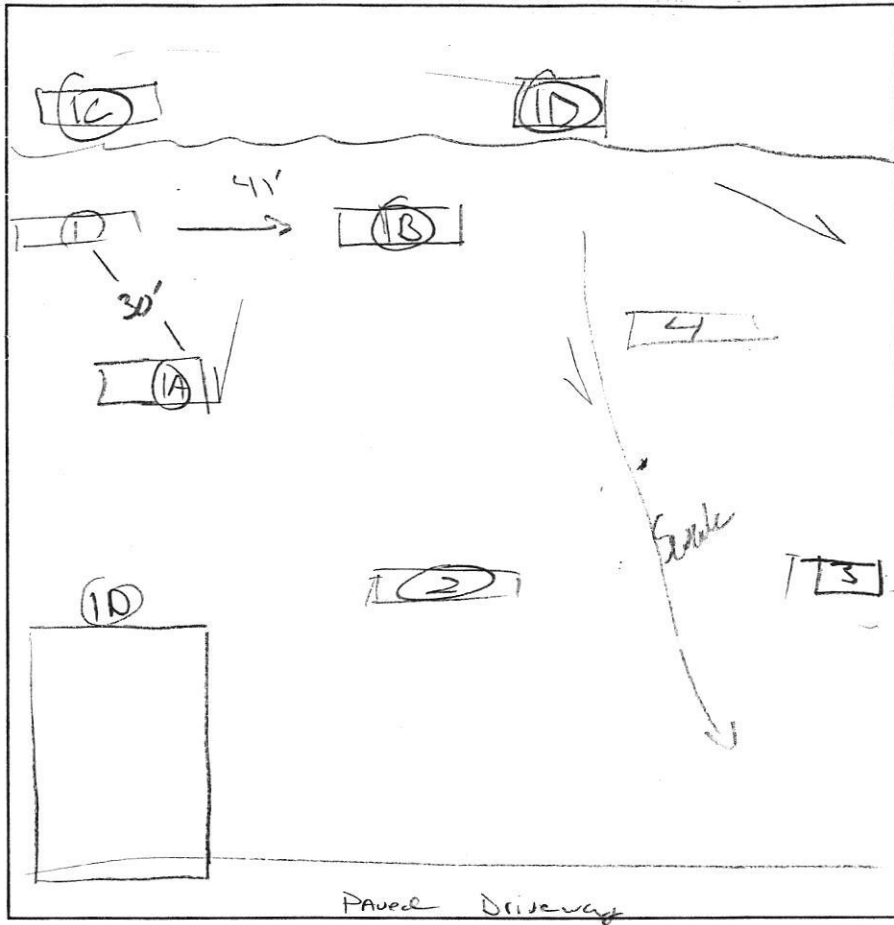

①A  
Brown L  
1'  
Yellow/Brown micaceous sl w/ 15-20% mica schist  
8'  
Yellow/Brown mica schist  
40%  
11'

①B  
L 50% Rock  
L  
L

①E  
Brown L  
1'  
Yellow/Brown sl w/ 10% sap  
3 1/2'  
Yellow/Brown giny mica  
sl w/ 35-40% sap  
9'

DATE	TEST #	DEPTH	START	BREAK 1" DROP	STOP 2" DROP	TIME OF 2ND INCH	P/F/H
9/2/04	3	4' / 11'	11:57	12:00	12:03	3min	P
	4	7 1/2' - Visual -			450%	Rock	F
	1A	3 1/2' / 11'	2:08	2:09	2:11	2min	P
	2	3' / 11'	1:41	1:42	1:44	2min	P
	Z	Re-Pour	1:46	1:49	1:52	3min	P
	1B	8' - Visual -			450%	Rock	F
	1E	3 1/2' / 9'	3:53	3:55	3:57	2min	P


REMARKS #1 Pull 30' downhill - trying to find where Rock stops! (shallow system)  
 SANITARIAN KJB / PP BACKHOE \_\_\_\_\_ OTHERS \_\_\_\_\_  
 TEST HOLES USED IN SDA \_\_\_\_\_ AVG. PERC TIME \_\_\_\_\_ SQ. FT/BR \_\_\_\_\_  
 TRENCH WIDTH \_\_\_\_\_ INLET DEPTH \_\_\_\_\_ MAX. BOT DEPTH \_\_\_\_\_ EFFECTIVE SW \_\_\_\_\_

35 AP

Brown l  
2.5  
brown sl  
1'

yellow brown  
w orange striations  
sl  
5'

11 ↑  
5% quartz  
10'

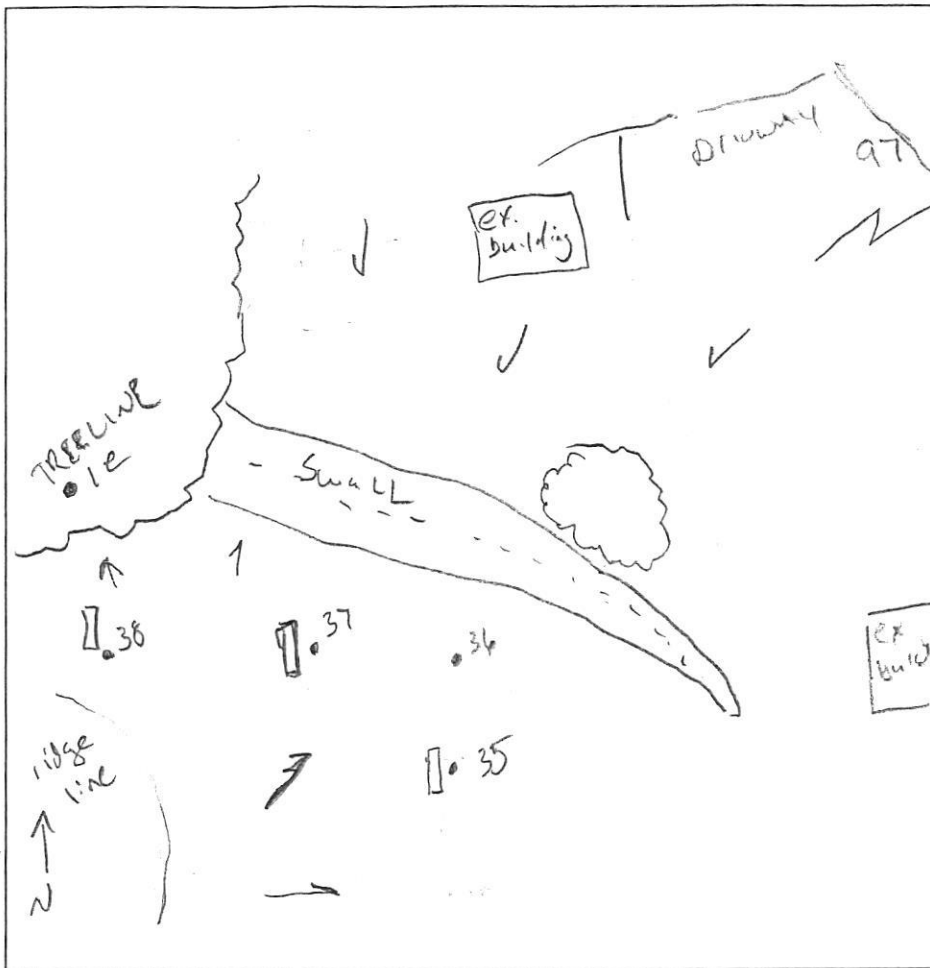

39

brown l  
orange brown sl  
platy structure  
3'

light yellow brown grey sl  
5'

11 ↑  
w/ 5-10% schist  
weakly cemented sl blocks  
10'

hard bottom

36

brown l  
Brown sl  
5% roots  
3 1/2'

Yellow/Brown  
micaceous  
sl w/ channing etc  
Trace Rock  
10'

gray/yellow  
micaceous  
sl  
Trace Rock  
12 1/2'

37

brown l  
orange sl - micaceous  
light yellow grey sl  
micaceous  
5'

yellow brown sl  
w/ micaceous  
weakly cemented  
5-10% schist  
8'

6 - roots

DATE	TEST #	DEPTH	START	BREAK 1" DROP	STOP 2" DROP	TIME OF 2nd INCH	P/F/H
9/30	35	4 / 12	10:11 <sup>30</sup>	10:12 <sup>56</sup>	10:15 <sup>30</sup>	2:20	P
	36	4 1/2' / 12 1/2'	10:25	10:28	10:32	4 min	P
	37	ll	VISUAL	PASS.			
	38	4 / 10	11:01	11:03	11:08	5	P
	IE	ALREADY TESTED	(IN NOTES)				P

REMARKS Lot 2 - dug 2 stake. trying to find new 10,000 # # 36 - Be sure to stay 25' from seale

SANITARIAN K.B./P.Y BACKHOE \_\_\_\_\_ OTHERS \_\_\_\_\_

TEST HOLES USED IN SDA \_\_\_\_\_ AVG. PERC TIME \_\_\_\_\_ SQ. FT/BR \_\_\_\_\_

TRENCH WIDTH \_\_\_\_\_ INLET DEPTH \_\_\_\_\_ MAX. BOT DEPTH \_\_\_\_\_ EFFECTIVE SW \_\_\_\_\_