




4 PART. RIGHT SIDE ELEVATION w/ OPT. 012 - SIDE LOAD GARAGE
 SCALE: 1/4" = 1'-0"
 ELEV. 2 - SHOWN

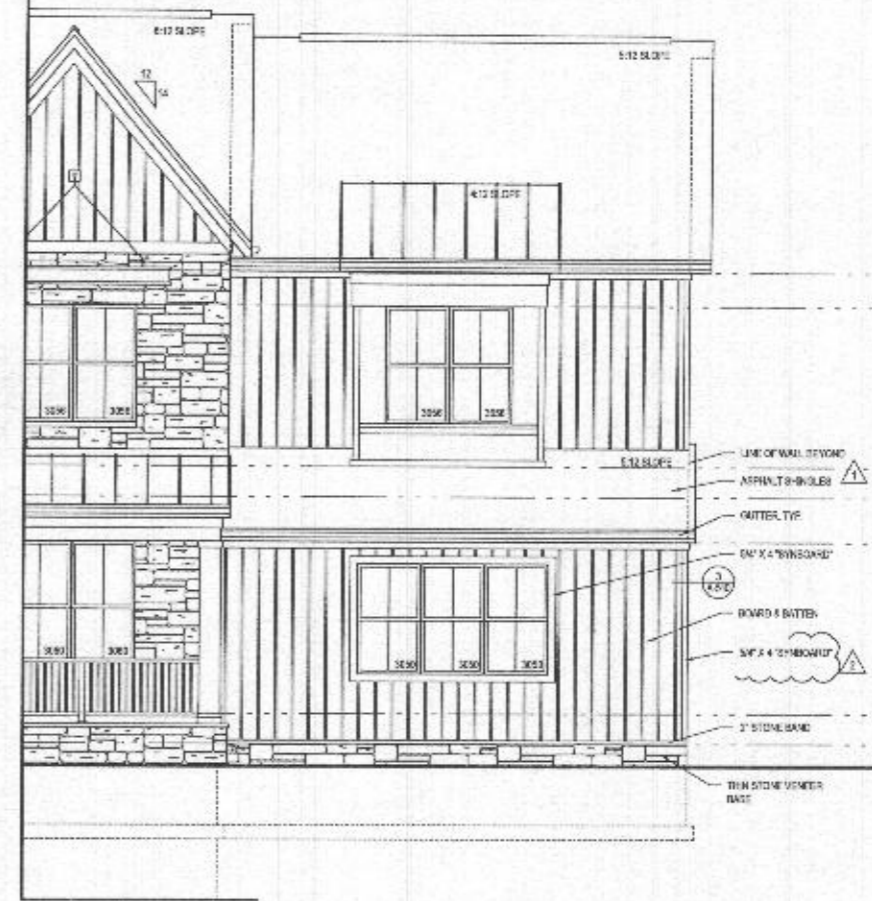

3 PART. FRONT ELEVATION w/ OPT. 012 - SIDE LOAD GARAGE
 SCALE: 1/4" = 1'-0"
 ELEV. 2 - SHOWN

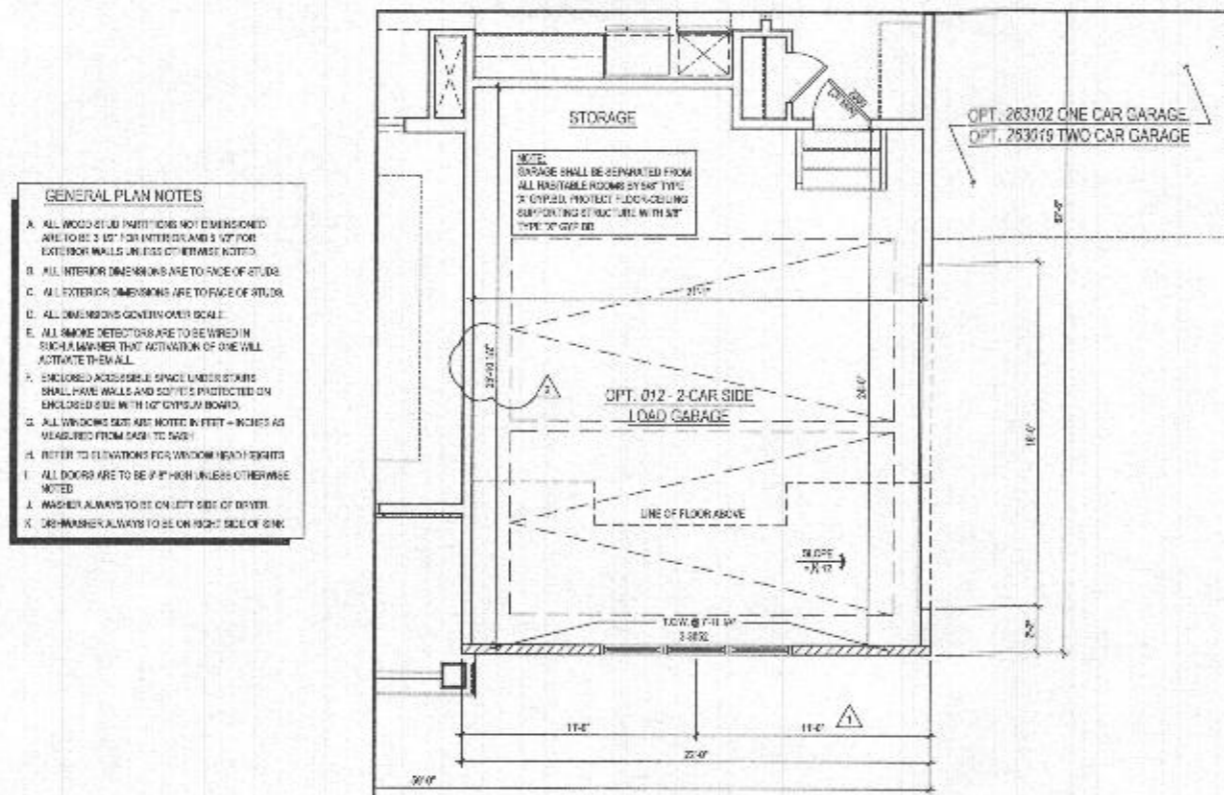

2 PART. FIRST FLOOR PLAN w/ OPT. 012 - SIDE LOAD GARAGE
 SCALE: 1/4" = 1'-0"
 ELEV. 2 - SHOWN

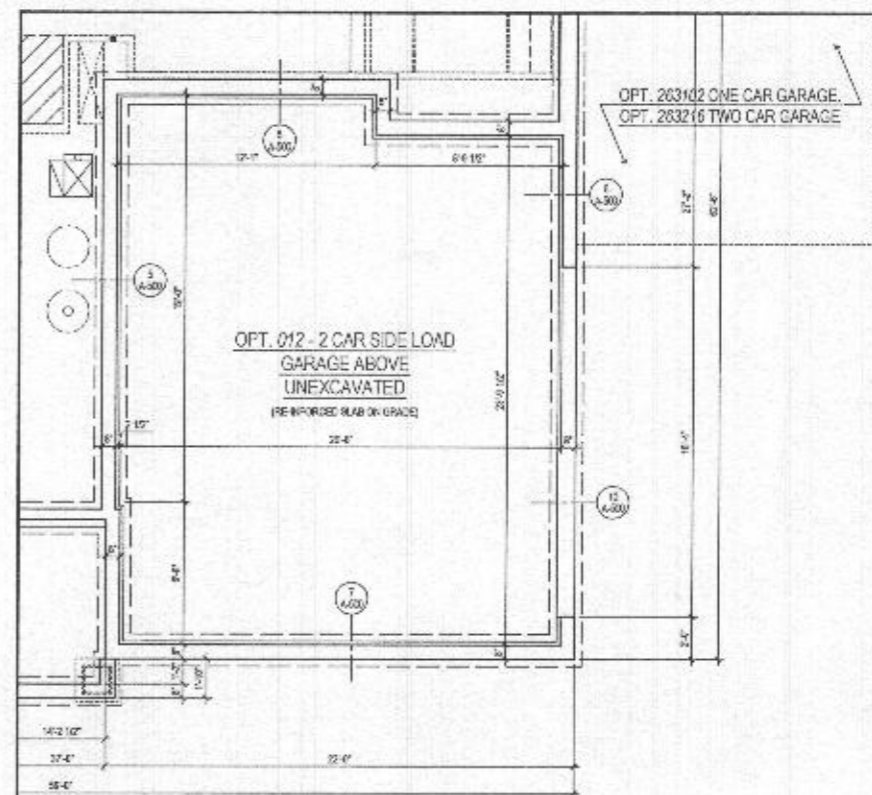

1 PART. BASEMENT FLOOR PLAN w/ OPT. 012 - SIDE LOAD GARAGE
 SCALE: 1/4" = 1'-0"
 ELEV. 1 - SHOWN

- GENERAL PLAN NOTES**
- A. ALL WOOD STUD PARTITIONS NOT DIMENSIONED ARE TO BE 2 1/2" FOR INTERIORS AND 3 1/2" FOR EXTERIOR WALLS UNLESS OTHERWISE NOTED.
 - B. ALL INTERIOR DIMENSIONS ARE TO FACE OF STUD.
 - C. ALL EXTERIOR DIMENSIONS ARE TO FACE OF STUD.
 - D. ALL DIMENSIONS GOVERN OVER SCALE.
 - E. ALL SMOKE DETECTORS ARE TO BE WIRED IN SUCH A MANNER THAT ACTIVATION OF ONE WILL ACTIVATE THEM ALL.
 - F. ENCLOSED ACCESSIBLE SPACE UNDER STAIRS SHALL HAVE WALLS AND SOFTS PROTECTED ON ENCLOSED SIDE WITH 1/2" GYPSUM BOARD.
 - G. ALL WINDOWS SIZE ARE NOTED IN FEET - INCHES AS MEASURED FROM CASE TO CASE.
 - H. REFER TO ELEVATIONS FOR WINDOW HEAD HEIGHTS.
 - I. ALL DOORS ARE TO BE 6 7/8" HIGH UNLESS OTHERWISE NOTED.
 - J. HANDES ALWAYS TO BE ON LEFT SIDE OF DOOR.
 - K. DOOR HANDES ALWAYS TO BE ON RIGHT SIDE OF DOOR.

File No: TOL0812_A400.dwg
 Plot By: amk

8521 Leesburg Pike
 Suite 700 | Vienna, VA 22182
 P: 571.830.1800 | F: 571.830.1801
 www.lessarddesign.com

OWNER:

TOLL BROTHERS

15775 BELMONT EXECUTIVE PLAZA
 ASHBURN, VA 20147
 P: 571.221.8088
 CONTACT: CHRISTINA LEMLEY
 clemley@tollbrothers.com

MARYLAND


PARKHURST

OPTIONS


ISSUE / REVISION		
NO.	DESCRIPTION	DATE
1	ISSUED	05.20.13
2	PERMIT SET	05.10.13
3	PERMIT SET	05.16.13
4	PERMIT SET	12.11.13

PROJECT NO: TOL0812
 DRAWN BY: amk
 CHECKED BY: amk
 PLOT DATE: 04.25.2014
 PLOT NAME: TOL0812_A400.dwg


A-400b

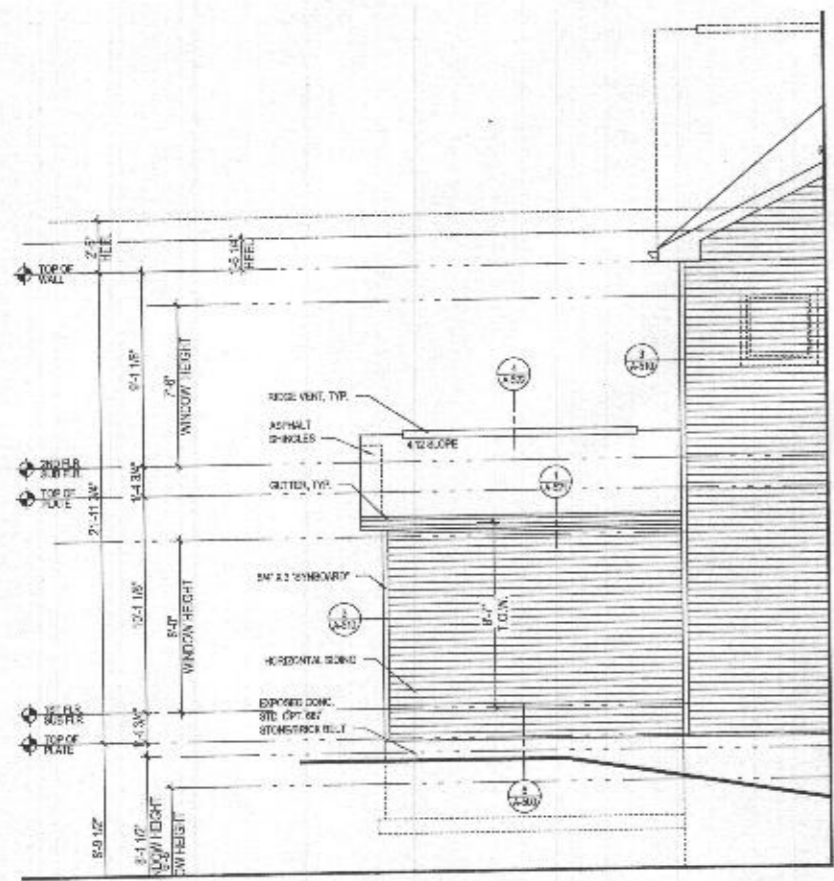

6 PART. REAR ELEVATION w/ OPT. 263102 - ONE CAR GARAGE
 SCALE 1/4"=1'-0"
 ELEV. 1 - SHOWN

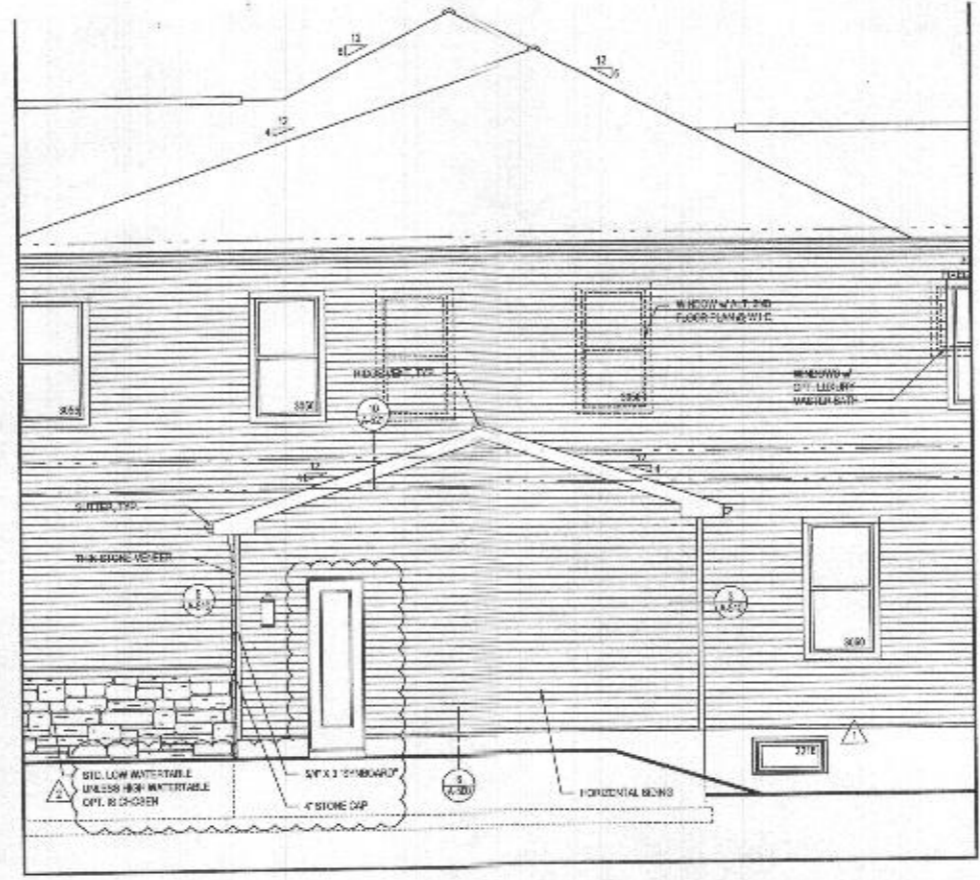


5 PART. RIGHT SIDE ELEVATION w/ OPT. 263102 - ONE CAR GARAGE
 SCALE 1/4"=1'-0"
 ELEV. 1 - SHOWN

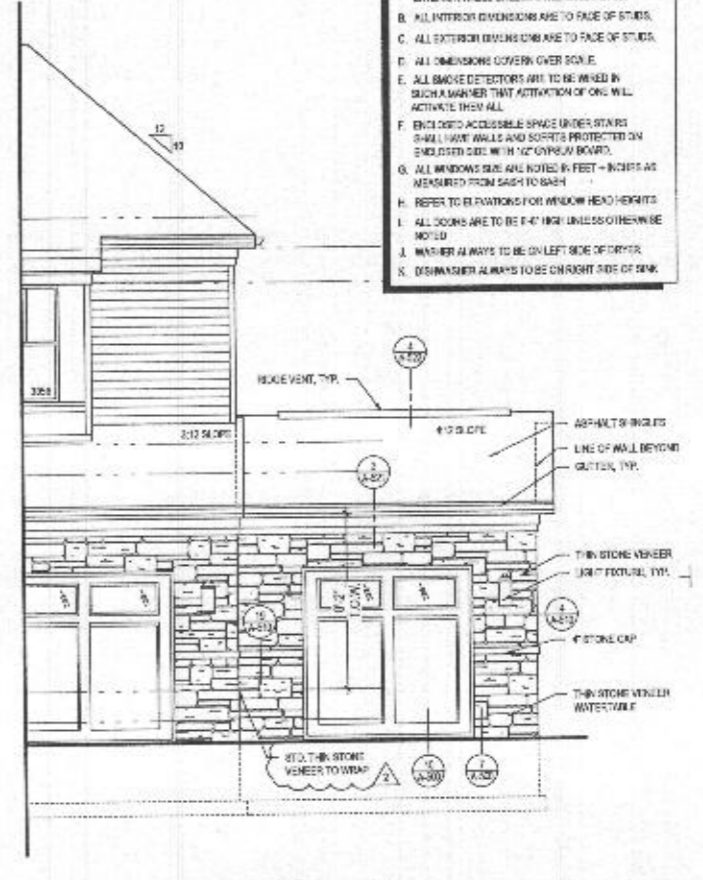


4 PART. FRONT ELEVATION w/ OPT. 263102 - ONE CAR GARAGE
 SCALE 1/4"=1'-0"
 ELEV. 1 - SHOWN


- GENERAL PLAN NOTES**
- A. ALL WOOD STUD PARTITIONS NOT DIMENSIONED ARE TO BE 2" X 10" FOR INTERIOR AND 2" X 12" FOR EXTERIOR WALLS UNLESS OTHERWISE NOTED.
 - B. ALL INTERIOR DIMENSIONS ARE TO FACE OF STUDS.
 - C. ALL EXTERIOR DIMENSIONS ARE TO FACE OF STUDS.
 - D. ALL DIMENSIONS COVER OVER SOLE.
 - E. ALL SMOKE DETECTORS ARE TO BE WIRED IN SUCH A MANNER THAT ACTIVATION OF ONE WILL ACTIVATE THEM ALL.
 - F. FINISH OVER ACCESSIBLE SPACE UNDER STAIRS SHALL HAVE WALLS AND SCOTTS PROTECTED ON END/STAIR SIDE WITH 1/2" OVERLAY BOARD.
 - G. ALL WINDOWS SHALL HAVE 6" FEET + INCHES AS MEASURED FROM SASH TO SASH.
 - H. REFER TO ELEVATIONS FOR WINDOW HEAD HEIGHTS.
 - I. ALL DOORS ARE TO BE 6'-4" HIGH UNLESS OTHERWISE NOTED.
 - J. WASHNER ALWAYS TO BE ON LEFT SIDE OF DOOR.
 - K. DRYER ALWAYS TO BE ON RIGHT SIDE OF DOOR.

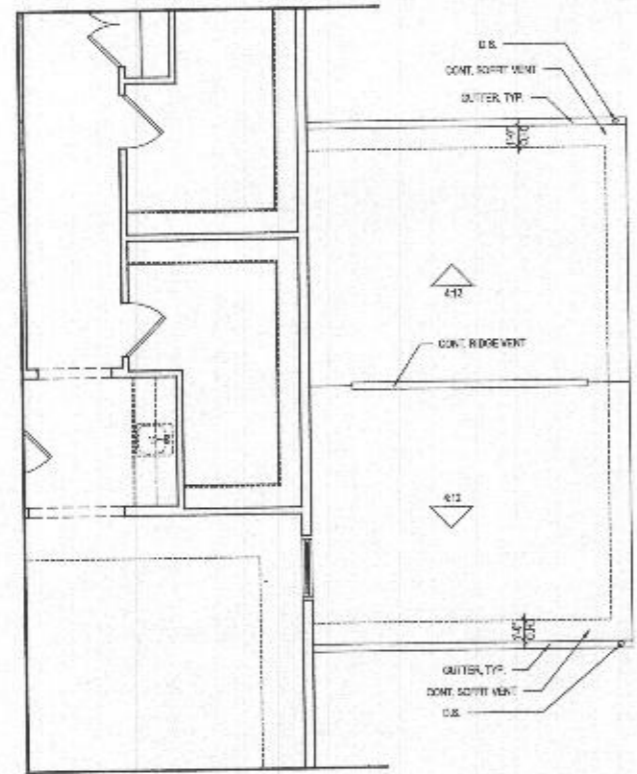

3 PART. SECOND FLOOR PLAN w/ OPT. 263102 - ONE CAR GARAGE
 SCALE 1/4"=1'-0"
 ELEV. 1 - SHOWN

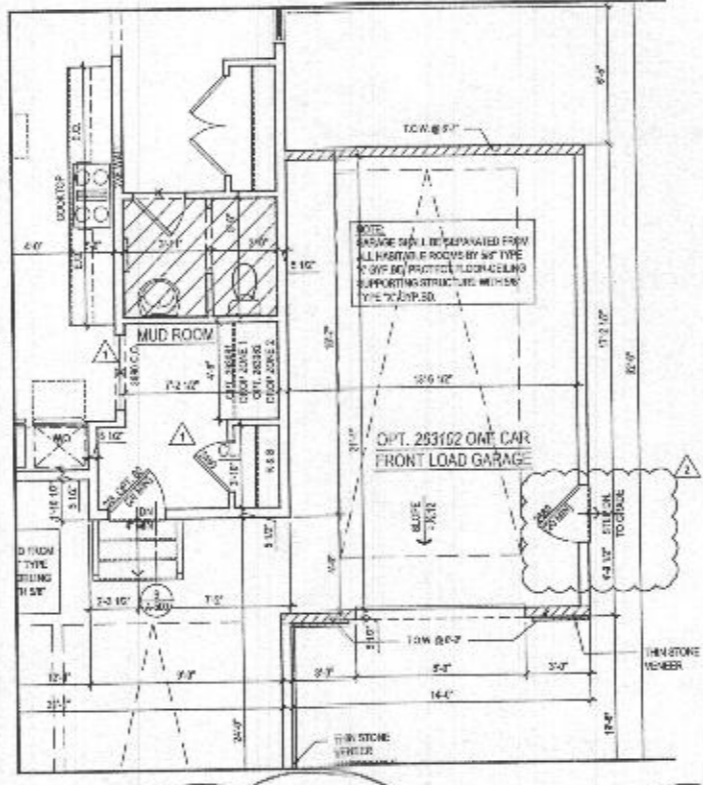

2 PART. FIRST FLOOR PLAN w/ OPT. 263102 - ONE CAR GARAGE
 SCALE 1/4"=1'-0"
 ELEV. 1 - SHOWN

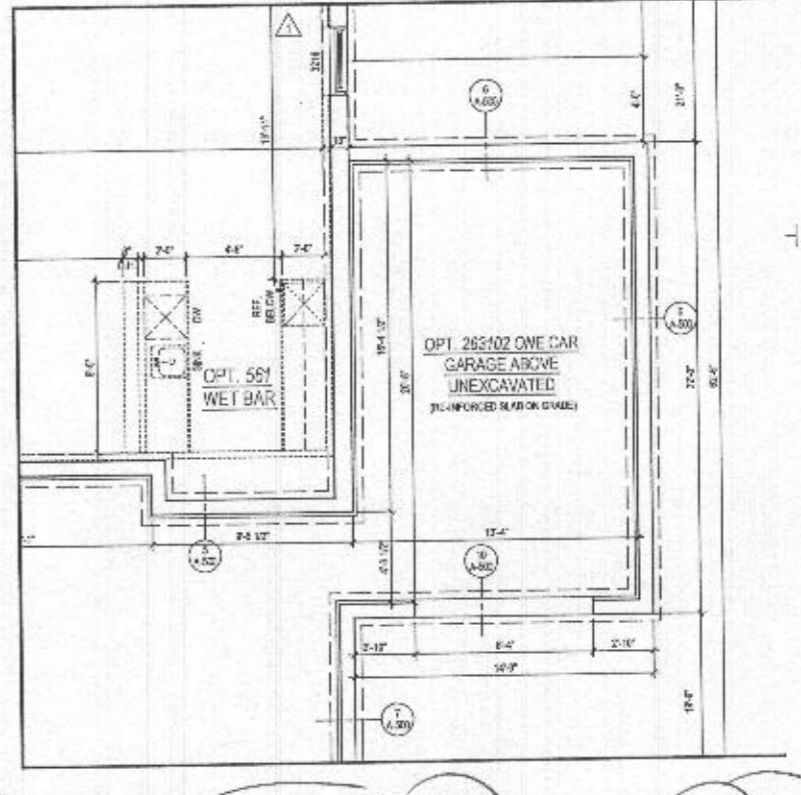

1 PART. BASEMENT FLOOR PLAN w/ OPT. 263102 - ONE CAR GARAGE
 SCALE 1/4"=1'-0"
 ELEV. 1 - SHOWN

lessard DESIGN
 8521 Leesburg Pike
 Suite 700 | Vienna, VA 22182
 P: 571.830.1500 | F: 571.830.1801
 www.lessarddesign.com

TOLL BROTHERS
 10725 BELMONT EXPLORING PLAZA
 GAITHERSBURG, VA 20147
 P: 571.251.8058
 CONTACT: CHRISTINA LENLEY
 clenley@tollbrothers.com

MARYLAND
PARKHURST OPTIONS

NO.	DESCRIPTION	DATE
1	NO. 1	05.15.10
2	NO. 2	05.16.10
3	NO. 3	05.17.10

PROJECT NO: 108.001
 DRAWN BY: M.L.S.
 CHECKED BY: M.L.S.
 PLOT DATE: JUN. 23, 2010
 FILE NAME: 108.001.dwg

A-401

Plot by: malk
 Plot by: malk

Health Dept


6042 Bricker Road

Lot 19

Willow Creek
(Willowshire)

Approved
RJE
11/12/2021

- GENERAL PLAN NOTES**
- ALL WOOD STUD PARTITIONS NOT OTHERWISE SPECIFIED ARE TO BE 2" X 4" FOR 8' SPAN AND 2" X 6" FOR 12' SPAN UNLESS OTHERWISE NOTED.
 - ALL INTERIOR DIMENSIONS ARE TO FACE OF STUD.
 - ALL EXTERIOR DIMENSIONS ARE TO FACE OF STUD.
 - ALL DIMENSIONS GOVERN OVER SCALE.
 - ALL SMOKE DETECTORS ARE TO BE WIRE IN SLEATH MOUNTED THAT ACTIVATION OF ONE WILL ACTIVATE THEM ALL.
 - ENJOYABLE ACCESSIBLE BRACE UNDER STAIRS SHALL HAVE WALLS AND SUPPORTS PROTECTED ON EXPOSURE SIDE WITH 1/2" GYPSUM BOARD.
 - ALL WINDOWS SHALL BE NOTED IN FEET + INCHES AS MEASURED FROM SASH TO SASH.
 - REFER TO ELEVATIONS FOR WINDOW HEAD HEIGHTS.
 - ALL DOORS ARE TO BE 6' 8" UNLESS OTHERWISE NOTED.
 - WASHER SINKS ARE TO BE ON LEFT SIDE OF CUPB.
 - DISHWASHER SINKS ARE TO BE ON RIGHT SIDE OF CUPB.

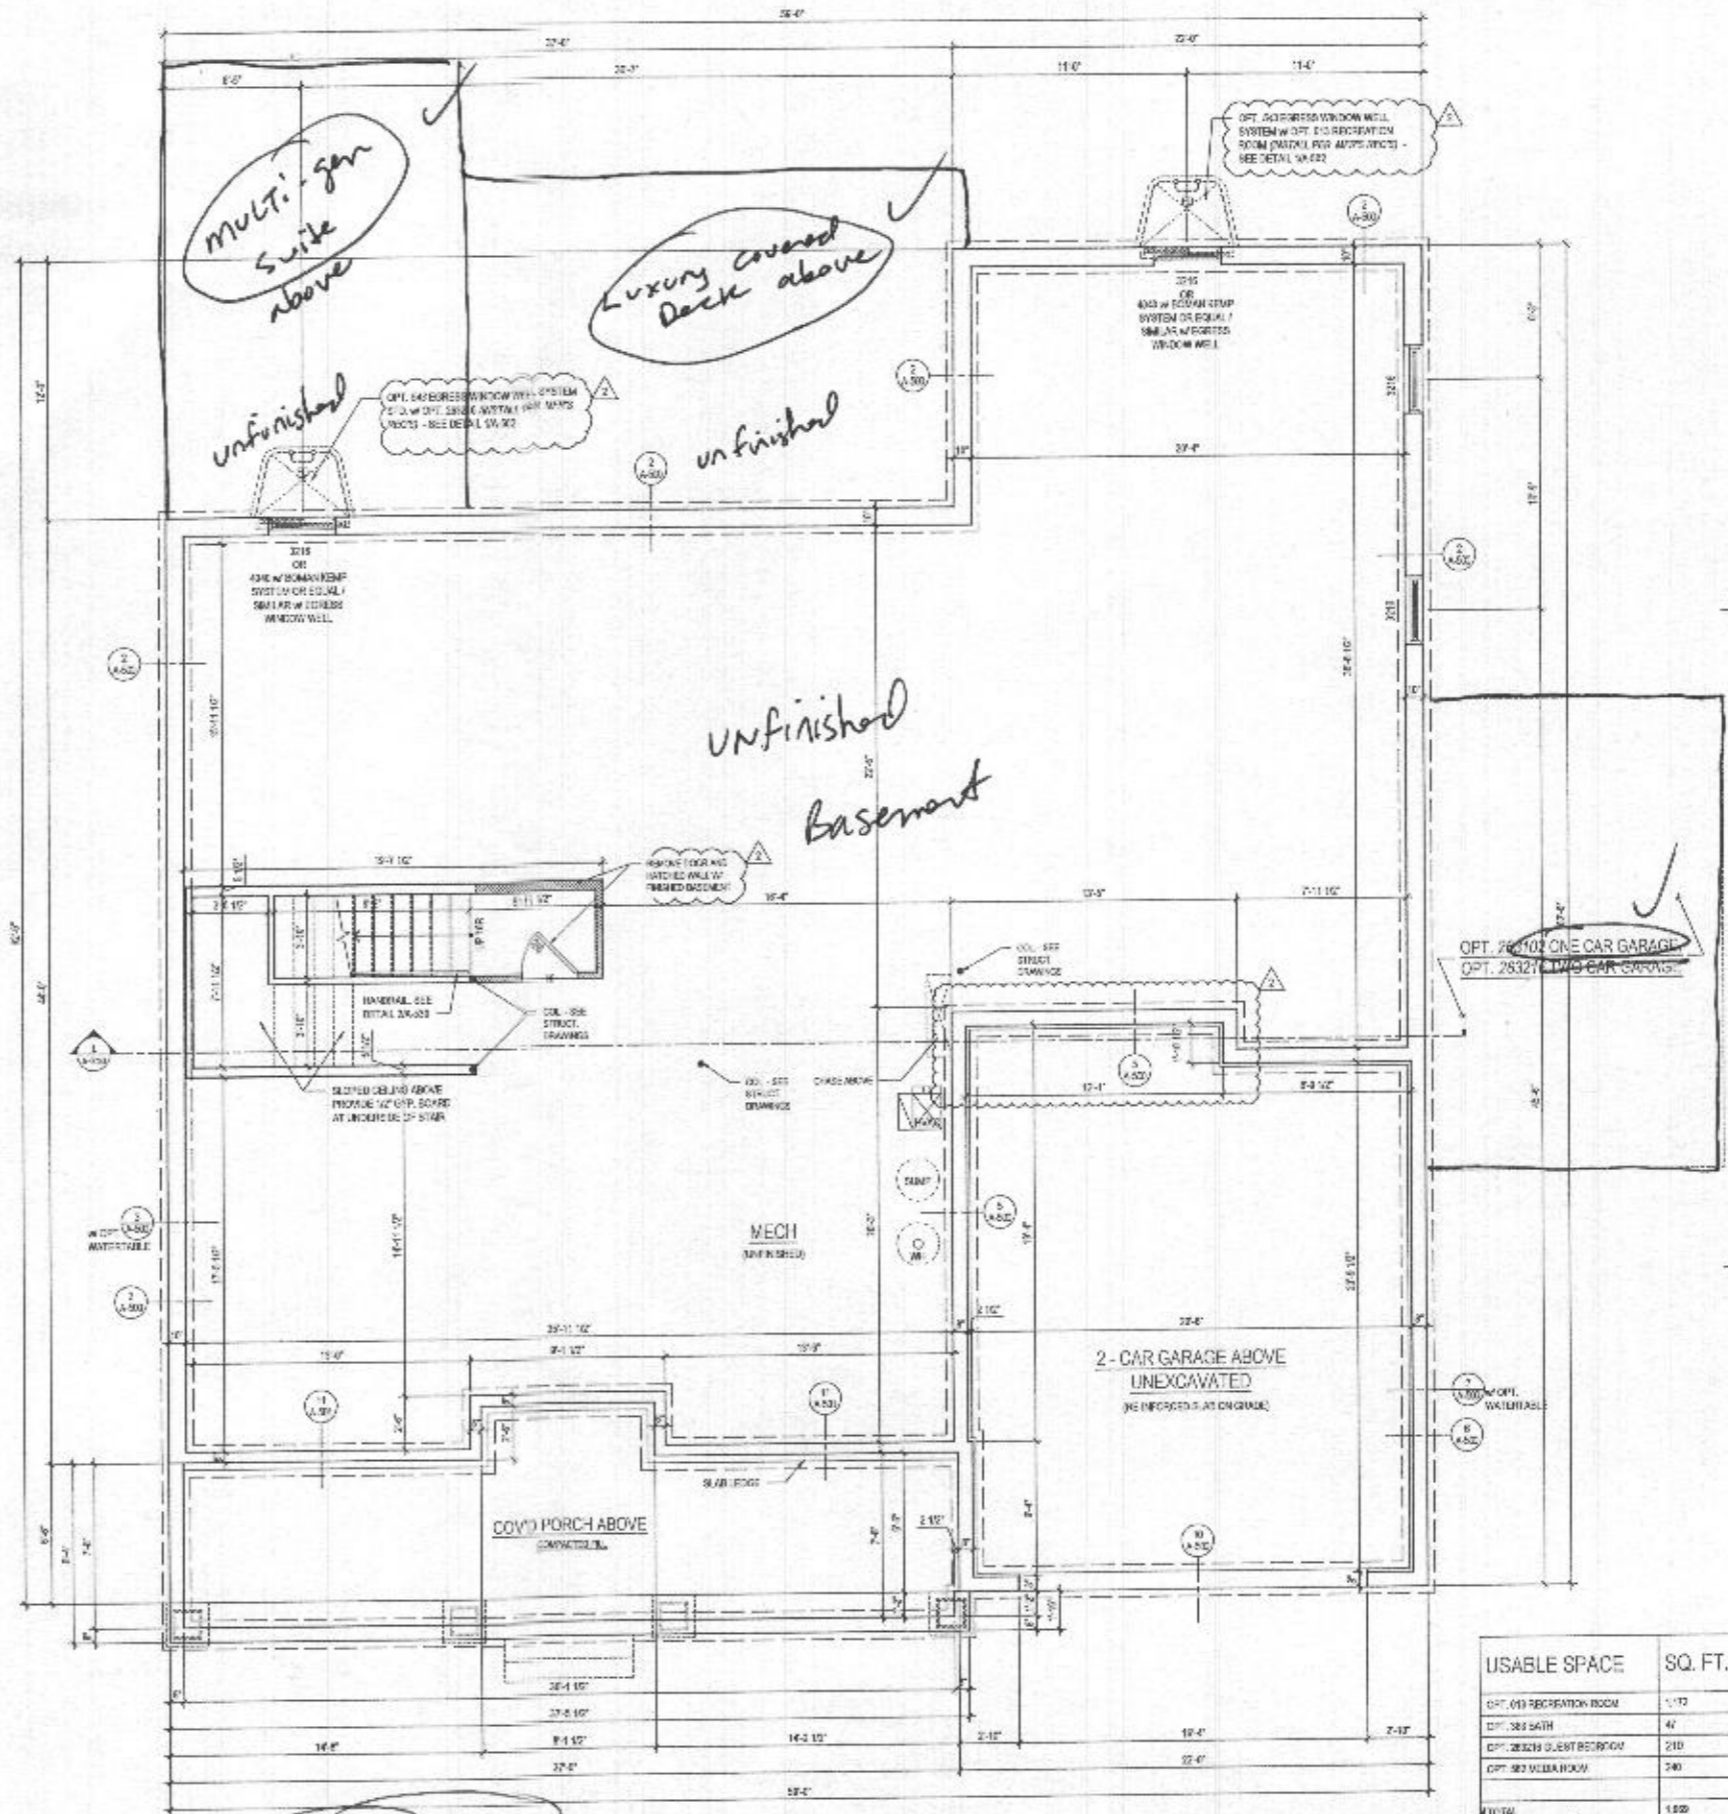

1 BASEMENT FLOOR PLAN
A-100 / SCALE 1/8"=1'-0"

@ ELEV. 1 - CRAFTSMAN
@ UNFINISHED CONDITION

USABLE SPACE	SQ. FT.
OPT. 013 RECREATION ROOM	1170
OPT. 022 BATH	47
OPT. 02023 GUEST BEDROOM	210
OPT. 020 MEDIA ROOM	240
TOTAL	1,667

See add pages for "Modern farmhouse" elev.

ARCHITECT

8521 Ladbury Pike
Suite 200 | Vienna, VA 22182
P: 571.833.1800 | F: 571.833.1801
www.lessarddesign.com

OWNER

TOLL BROTHERS
13725 BELMONT EXECUTIVE PLAZA
AUSTIN, VA 22147
P: 571.291.8000
CONTACT: CHRISTINA LEMLEY
christina@tollbrothers.com

PROJECT NAME

MARYLAND

PARKHURST
FLOOR PLANS

PROJECT TITLE

NO.	DESCRIPTION	DATE
1	REV. SET	05.25.19
2	REPRINT SET	05.15.19
3	NEW STAIRS	05.15.19
4	REV. FINISH	12.11.20

PROJECT NO: 70-0304

DRAWN BY: AJS

CHECKED BY: AJS


DATE: 08.25.20

SCALE: 1/8"=1'-0"

A-100


HEALTH DEPT

B21003935

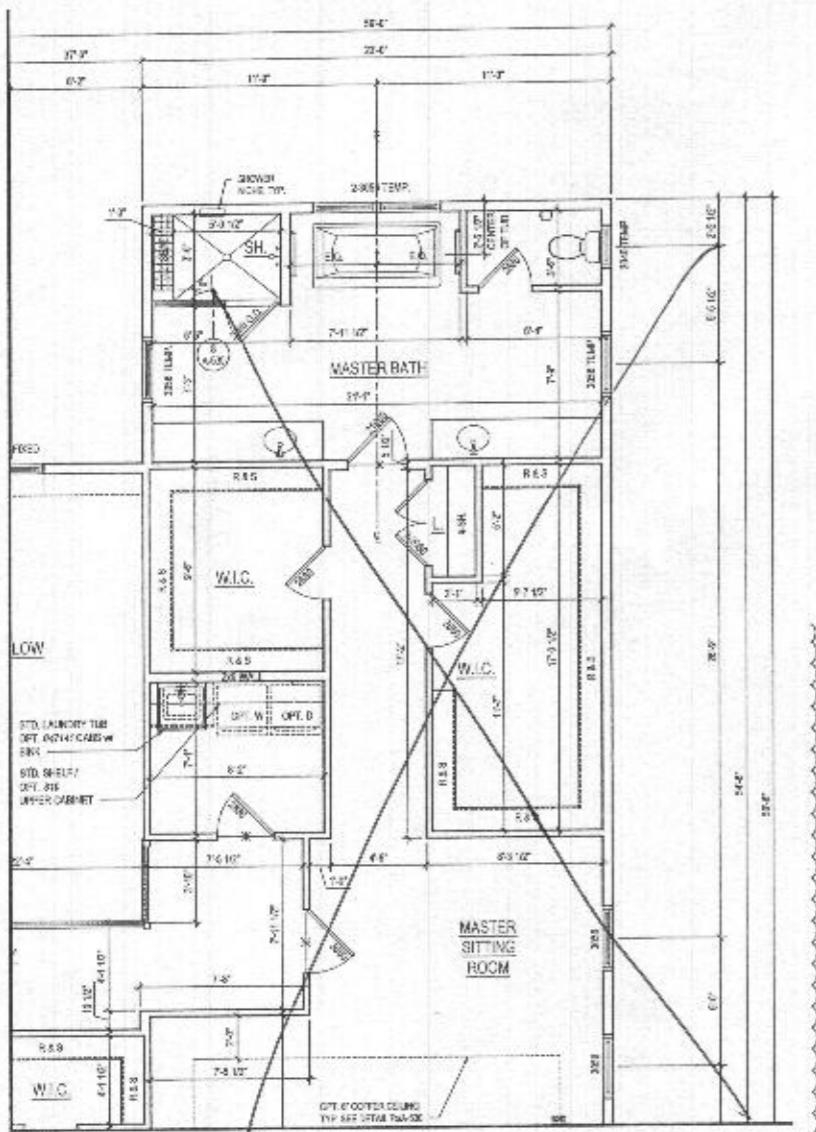

2 PART. SECOND FLOOR PLAN w/ OPT. 030 - ADDITIONAL WALK IN CLOSET
 A-120 SCALE 1/4"=1'-0"

- GENERAL PLAN NOTES**
- ALL WOOD STUD PARTITIONS NOT DIMENSIONED ARE TO BE 2" TOP FOR INTERIOR AND 4" TOP FOR EXTERIOR WALLS UNLESS OTHERWISE NOTED.
 - ALL INTERIOR DIMENSIONS ARE TO FACE OF STUDS.
 - ALL EXTERIOR DIMENSIONS ARE TO FACE OF STUDS.
 - ALL DIMENSIONS GOVERN OVER SCALE.
 - ALL SMOKE DETECTORS ARE TO BE WIRED IN SUCH A MANNER THAT ACTIVATION OF ONE WILL ACTIVATE THEM ALL.
 - BLINDS WITH ACCESSIBLE SPACE UNDER STAIRS SHALL BE WALL MOUNTED OR SUPPORTED ON END OF STAIR WITH 1/2" OF CLEARANCE.
 - ALL WINDOW SIZES ARE IN INCHES IN FEET + INCHES AS MEASURED FROM SASH TO SASH.
 - REFER TO SPECIFICATIONS FOR WINDOW HEAD HEIGHTS.
 - ALL DOORS ARE TO BE 6'8" HIGH UNLESS OTHERWISE NOTED.
 - WASHER & DRYER TO BE ON LEFT SIDE OF DRIVER.
 - DISHWASHER & SINK TO BE ON RIGHT SIDE OF SINK.

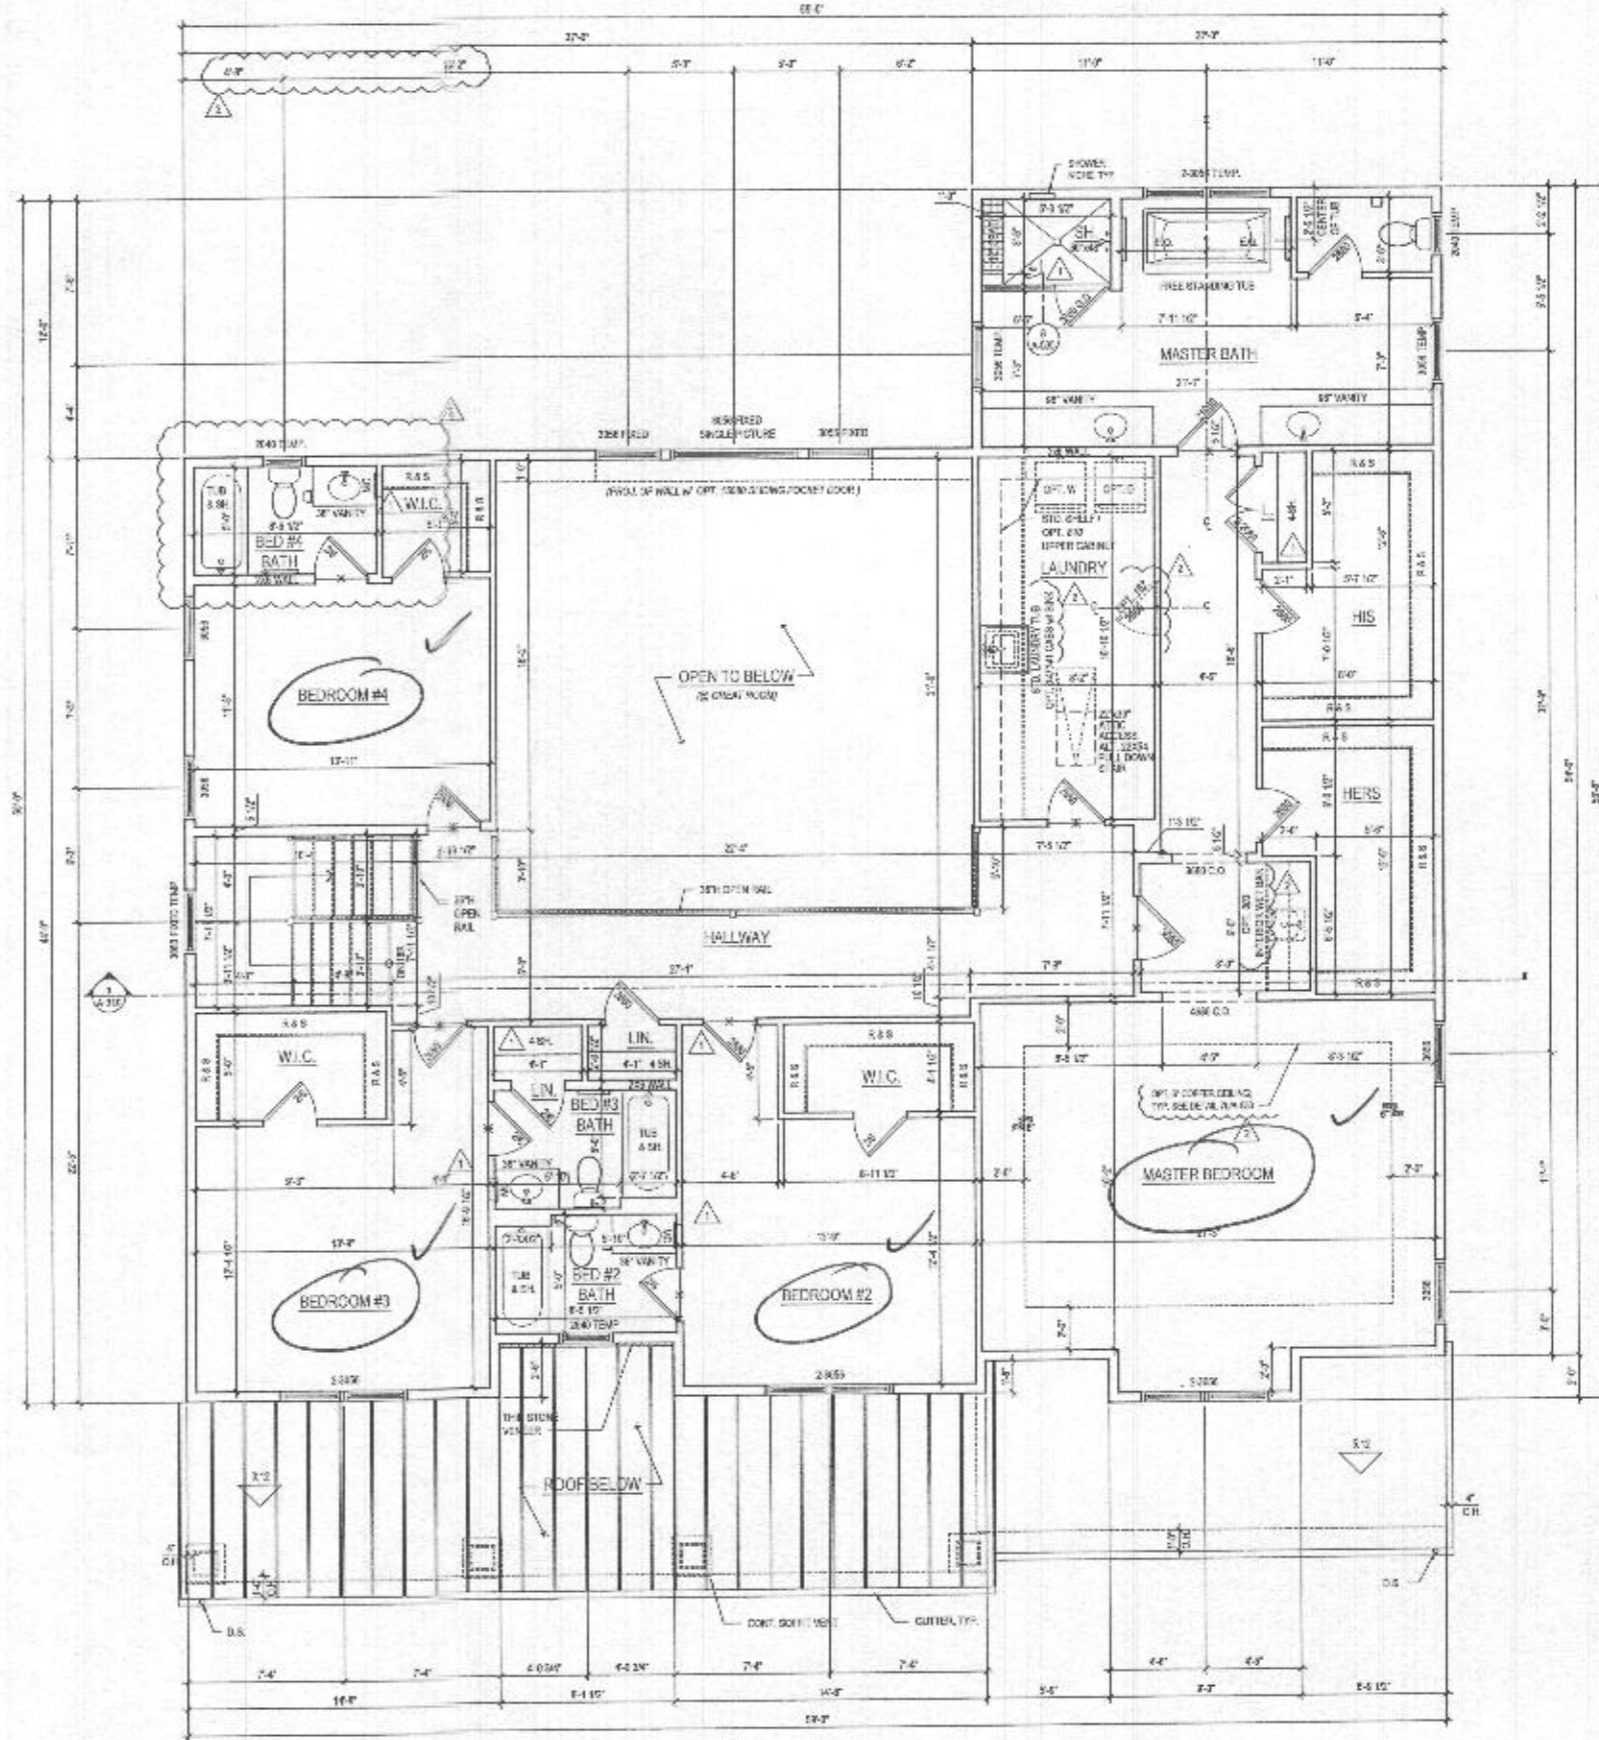

1 SECOND FLOOR PLAN
 A-120 SCALE 1/4"=1'-0"

@ ELEV. 1 - CRAFTSMAN *shown*

See add'l pages for "modern farmhouse" elev

ARCHITECT:

lessard
DESIGN

2521 Leesburg Pike
 Suite 700 | Vienna, VA 22182
 P: 571.830.1800 | F: 571.830.1801
 www.lessarddesign.com

OWNER:

TOLL BROTHERS
 13775 BELMONT EXECUTIVE PLAZA
 ASHBURN, VA 20147
 P: 571.255.0056
 CONTACT: CHRISTINA LEWLEY
 clwley@tollbrothers.com

PROJECT NAME: MARYLAND


SHEET TITLE: **PARKURST FLOOR PLANS**

NO.	DESCRIPTION	DATE
1	REV SET	05.24.10
2	PERMIT SET	06.14.10
3	REV NEW STANDARDS	06.15.10
4	REV FUNDAL	12.11.20

PROJECT NO: 104.063
 DRAWN BY: JAVIER
 CHECKED BY: JAVIER
 PLOT DATE: 01.30.2010
 FILE NAME: 104.063.A120.dwg


A-120

- GENERAL PLAN NOTES**
- A. ALL WOOD STUD PARTITIONS NOT DIMENSIONED ARE TO BE 2" X 4" FOR INTERIORS AND 2" X 6" FOR EXTERIOR WALLS UNLESS OTHERWISE NOTED.
 - B. ALL INTERIOR DIMENSIONS ARE TO FACE OF STUD.
 - C. ALL EXTERIOR DIMENSIONS ARE TO FACE OF STUD.
 - D. ALL DIMENSIONS GOVERN OVER DATE SCALE.
 - E. ALL WINDOW DETAILINGS ARE TO BE AS PER SUCH A MANUFACTURER THAT ACTIVATION OF ONE WILL AUTOMATICALLY ACTIVATE THEM ALL.
 - F. ENCLOSED ACCESSIBLE SPACE UNDER STAIRS SHALL HAVE WALLS AND CEILING PROTECTED ON ENCLOSED SIDE WITH 1/2" GYP BOARD.
 - G. ALL WINDOW SIZES ARE NOTED IN FEET - INCHES AS MEASURED FROM BASH TO SASH.
 - H. REFER TO ELEVATIONS FOR WINDOW HEAD HEIGHTS.
 - I. ALL DOORS ARE TO BE 6'-8" HIGH UNLESS OTHERWISE NOTED.
 - J. WASHER ALWAYS TO BE ON LEFT SIDE OF SINK.
 - K. DISHWASHER ALWAYS TO BE ON RIGHT SIDE OF SINK.

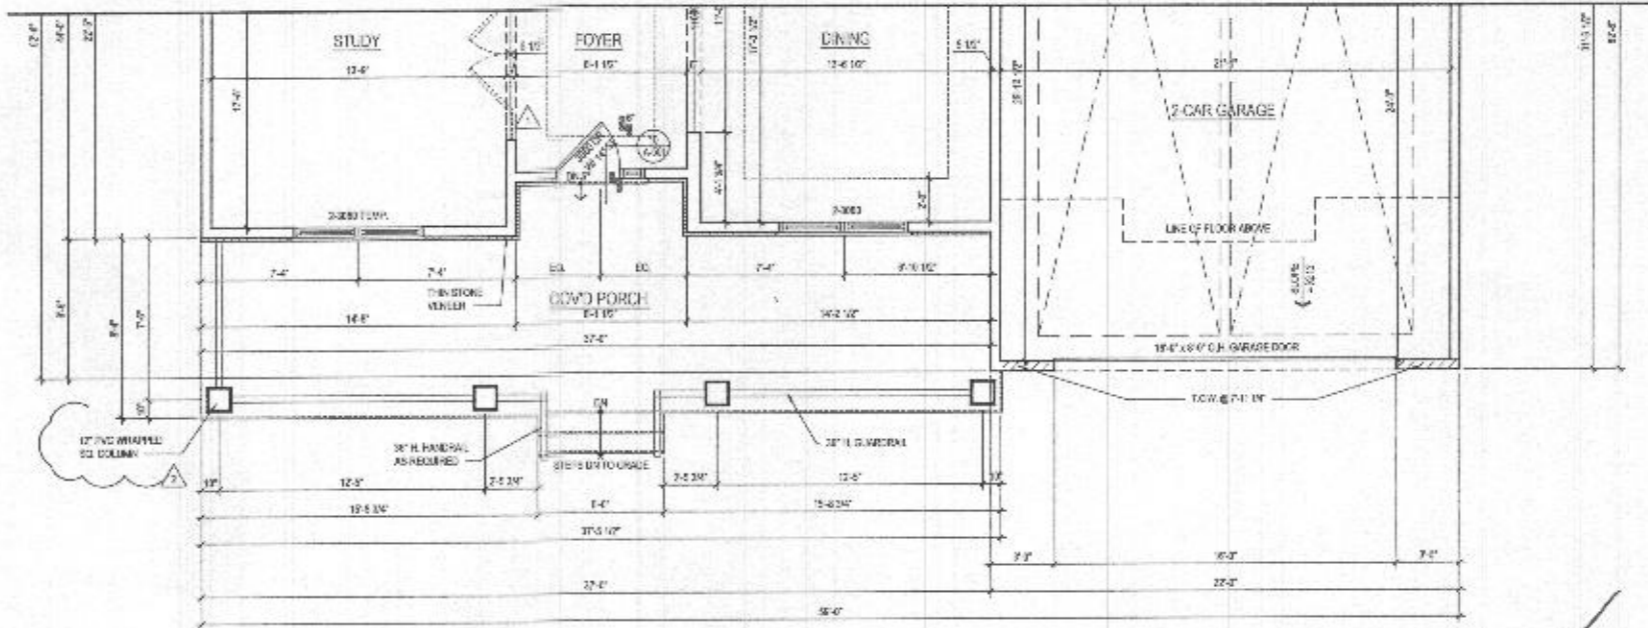

2 FIRST FLOOR PLAN
A-140 SCALE: 1/8"=1'-0"
12/15/2019

@ ELEV. 2 - MODERN FARMHOUSE

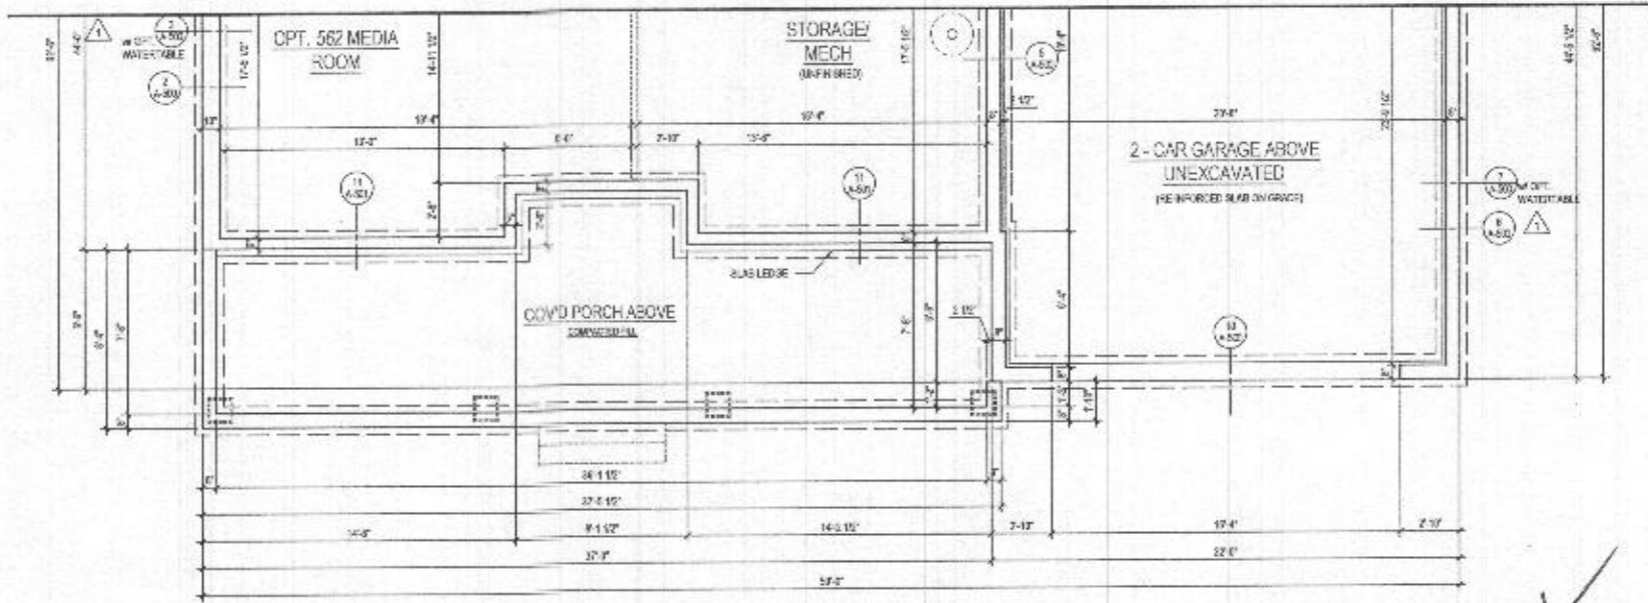

1 BASEMENT FLOOR PLAN
A-140 SCALE: 1/8"=1'-0"
12/15/2019

@ ELEV. 2 - MODERN FARMHOUSE

ARCHITECT

lessard DESIGN
8321 Leesburg Pike
Suite 730 | Vienna, VA 22182
P: 571.830.1800 | F: 571.830.1801
www.lessarddesign.com

OWNER

TOLL BROTHERS
10975 BELMONT EXECUTIVE PLAZA
ASHLAND, VA 23047
P: 571.261.0066
CONTACT: CHRISTINA LEMLEY
dlemley@tollbrothers.com

PROJECT NAME: MARYLAND PARKHURST FLOOR PLANS


ISSUE / REVISION

NO.	DESCRIPTION	DATE
010	010	02.28.19
020	020	02.19.19
030	030	02.16.19
040	040	12.11.20

PROJECT NO: 104-3010
DRAWN BY: [Signature]
CHECKED BY: [Signature]
PLOT DATE: 11/20/2021
FILE NAME: 104-3010-A140.dwg

A-140

- GENERAL PLAN NOTES**
- ALL WOOD STUD PARTITIONS NOT DIMENSIONED ARE TO BE 2 1/2" FOR INTERIOR AND 4 1/2" FOR EXTERIOR WALLS UNLESS OTHERWISE NOTED.
 - ALL INTERIOR DIMENSIONS ARE TO FACE OF STUDS.
 - ALL EXTERIOR DIMENSIONS ARE TO FACE OF STUDS.
 - ALL DIMENSIONS GOVERN OVER SCALE.
 - ALL SWITCHES/OUTLETS ARE TO BE WIRED IN SUCH A MANNER THAT ACTIVATION OF ONE WILL NOT AFFECT THE OTHER.
 - ENCLOSED ACCESSIBLE SPACE UNDER STAIRS SHALL HAVE WALLS AND SKIFFS PROTECTED ON ENCLOSED SIDE WITH 1/2" SYSTEM BOARD.
 - ALL WINDOW SIZES ARE NOTED IN FEET + INCHES AS MEASURED FROM SASH TO SASH.
 - REFER TO ELEVATIONS FOR WINDOW HEAD HEIGHTS.
 - ALL DOORS ARE TO BE 4 FT HIGH UNLESS OTHERWISE NOTED.
 - WASHERS ALWAYS TO BE ON LEFT SIDE OF DOOR.
 - DOOR KICKERS ALWAYS TO BE ON RIGHT SIDE OF DOOR.

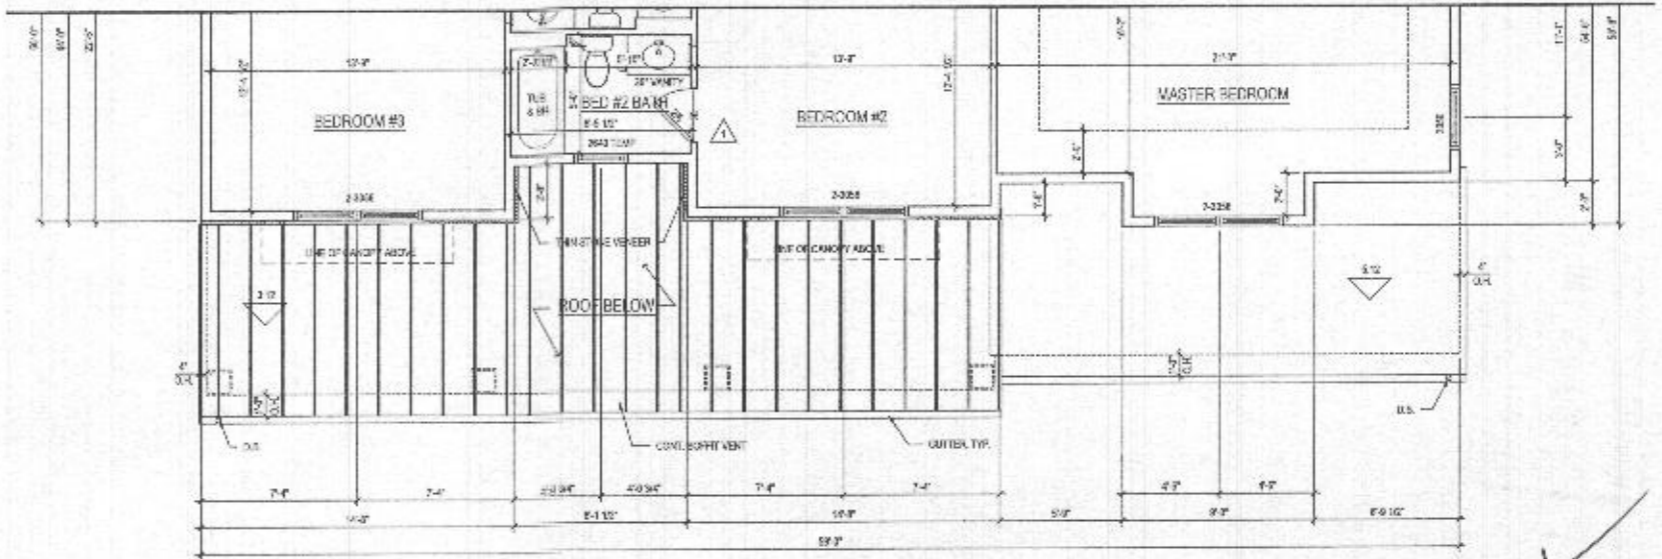

SECOND FLOOR PLAN
 A-141 SCALE: 1/4" = 1'-0"
 12/28/24

@ ELEV. 2 - MODERN FARMHOUSE

ARCHITECT:

5521 Leesburg Pike
 Suite 200 | Vienna, VA 22182
 P: 571.433.1806 | F: 571.830.1801
 www.lessarddesign.com

SEAL & SIGNATURE

OWNER:

TOLL BROTHERS
 19725 BELMONT EXECUTIVE PLAZA
 ASHBURN, VA 22047
 P: 571.201.5088
 CONTACT: CRISTINA LENLEY
 clenley@tollbrothers.com

PROJECT NAME:

MARYLAND


PARKHURST FLOOR PLANS

SHEET TITLE:


NO.	ISSUE / REVISION	DATE
01	ISSUE	05.23.23
02	REVISION	08.23.23
03	REVISION	09.23.23
04	REVISION	12.11.23

PROJECT NO: 101-0416
 DRAWN BY: JACOB
 CHECKED BY: JACOB
 PLOT DATE: 12/28/24
 FILE NAME: 101-0416-200

A-141

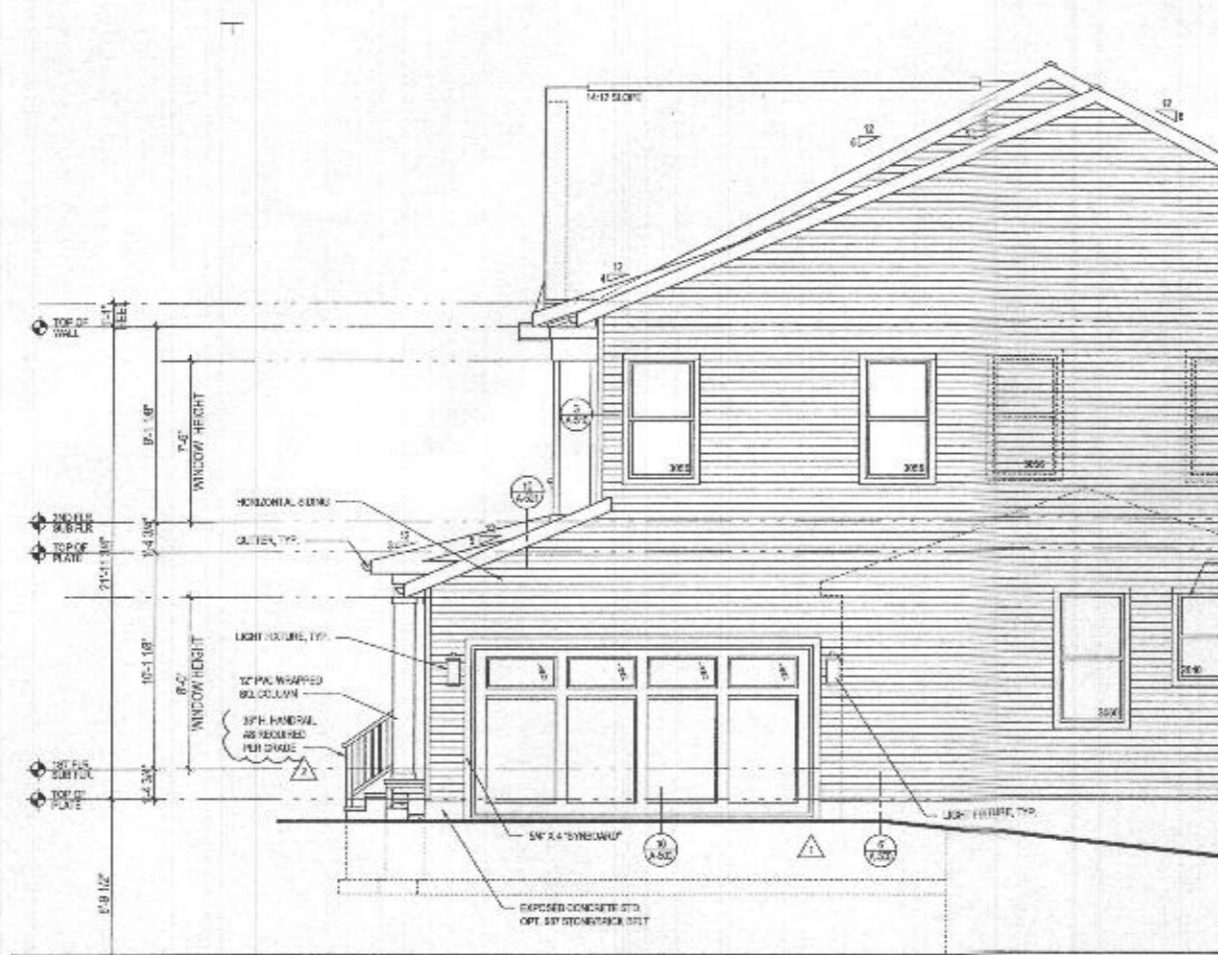


4 PART. RIGHT SIDE ELEVATION w/ OPT. 012 - SIDE LOAD GARAGE
 SCALE: 1/4"=1'-0"
 ELEV. 2 - SHOWN

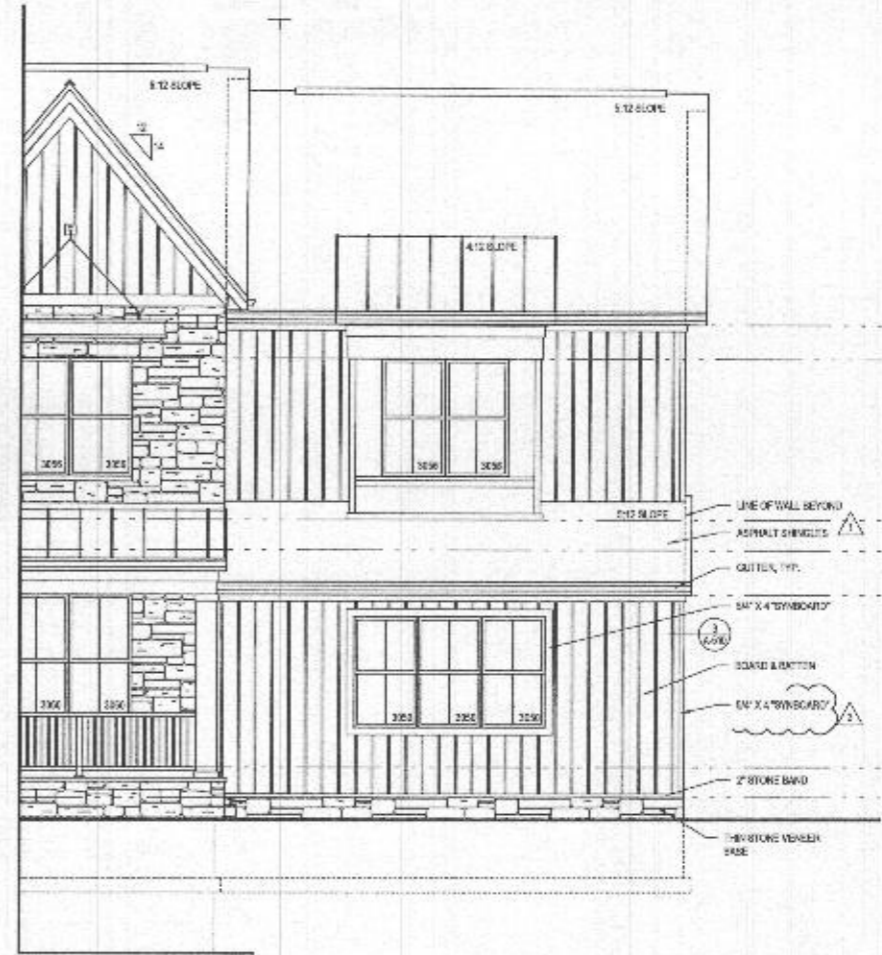


3 PART. FRONT ELEVATION w/ OPT. 012 - SIDE LOAD GARAGE
 SCALE: 1/4"=1'-0"
 ELEV. 2 - SHOWN

- GENERAL PLAN NOTES**
- A. ALL WOOD STUD PARTITIONS NOT EMPHATICALLY NOTED ARE TO BE 2" X 4" FOR INTERIOR AND 2" X 6" FOR EXTERIOR WALLS UNLESS OTHERWISE NOTED.
 - B. ALL INTERIOR DIMENSIONS ARE TO FACE OF STUDS.
 - C. ALL EXTERIOR DIMENSIONS ARE TO FACE OF STUDS.
 - D. ALL DIMENSIONS GOVERN OVER SCALE.
 - E. ALL SMOKE DETECTORS ARE TO BE WIRED IN SUCH A MANNER THAT ACTIVATION OF ONE WILL ACTIVATE "BELL" ALL.
 - F. FINISH ACCESSIBLE SPACE UNDER STAIRS IS ALL WAYS WALLS AND SCAFFS TO PROTECT ON FINISHED SIDE WITH 1/2" Gypsum BOARD.
 - G. ALL WINDOW SIZES ARE NOTED IN FEET + INCHES AS MEASURED FROM SASH TO SASH.
 - H. REFER TO ELEVATIONS FOR WINDOW HEAD HEIGHTS.
 - I. ALL DOORS ARE TO BE 8'-0" HIGH UNLESS OTHERWISE NOTED.
 - J. WASHERS ALWAYS TO BE ON LEFT SIDE OF CRYER.
 - K. DRY-WASHER ALWAYS TO BE ON RIGHT SIDE OF SINK.

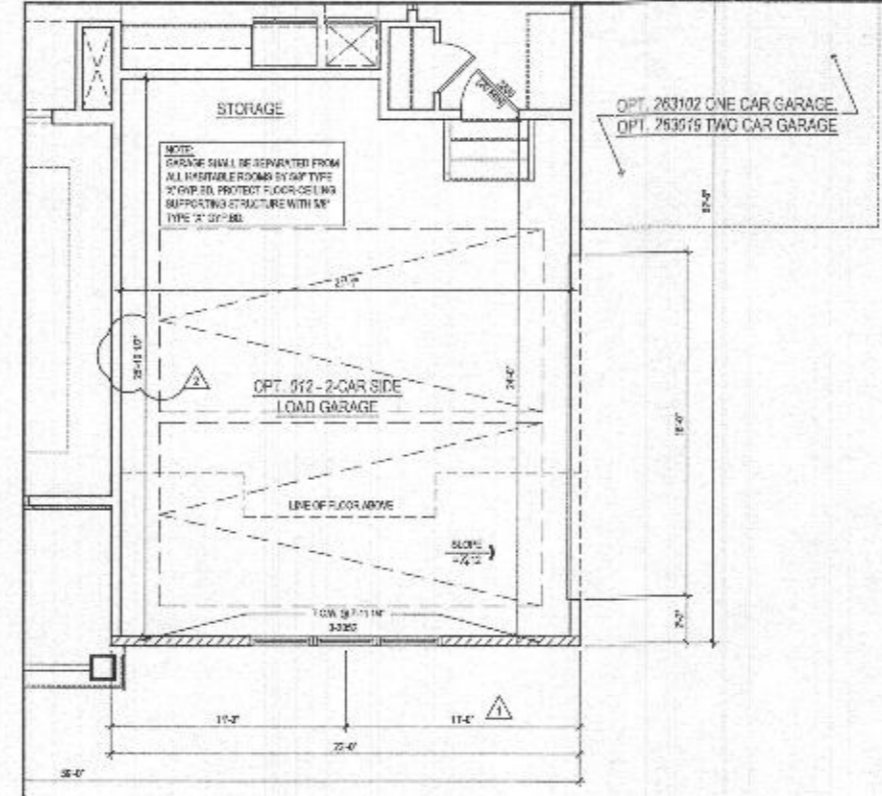

2 PART. FIRST FLOOR PLAN w/ OPT. 012 - SIDE LOAD GARAGE
 SCALE: 1/4"=1'-0"
 ELEV. 1 - SHOWN

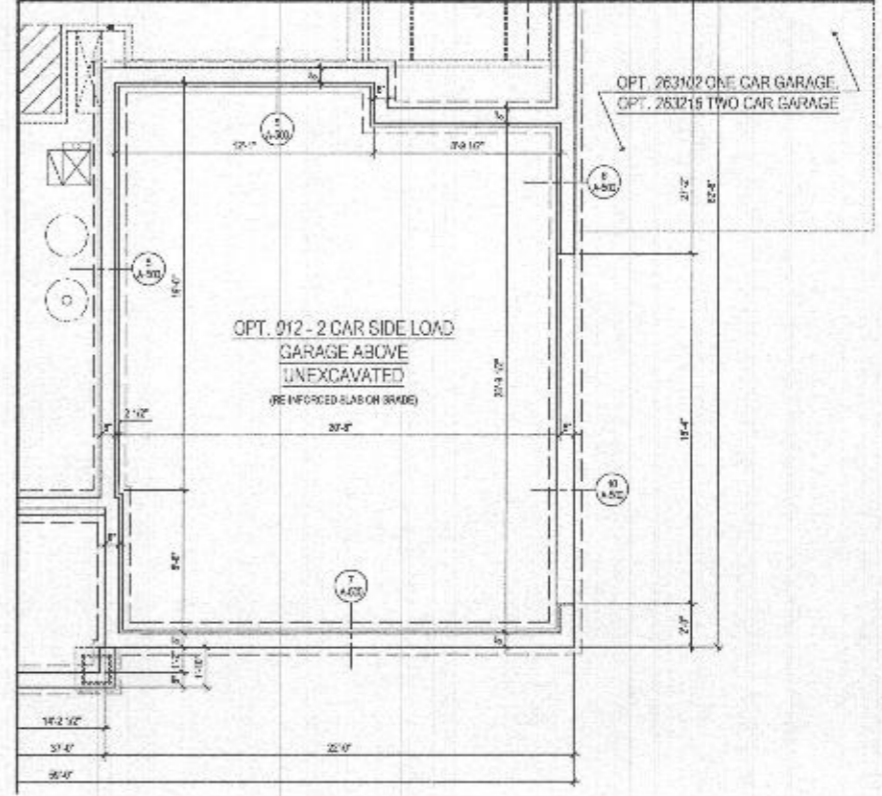

1 PART. BASEMENT FLOOR PLAN w/ OPT. 012 - SIDE LOAD GARAGE
 SCALE: 1/4"=1'-0"
 ELEV. 1 - SHOWN

ARCHITECT:

8521 Leesburg Pike
 Suite 700 | Vienna, VA 22182
 P: 571.830.1800 | F: 571.830.1801
 www.lessarddesign.com

OWNER:

TOLL BROTHERS
 19775 BELMONT EXECUTIVE PLAZA
 ALEXANDRIA, VA 22304
 P: 571.252.8058
 CONTACT: CHRISTINA LENLEY
 lenley@tollbrothers.com

PROJECT NAME:

MARYLAND


PARKHURST
 OPTIONS

SHEET TITLE:

NO.	DESCRIPTION	DATE
1	ISSUE SET	05.20.10
2	PERMIT SET	09.10.10
3	NO. NEW STANDARDS	09.10.10
4	NO. #232241	12.12.10


PROJECT NO: 1063018
 DRAWN BY: JAC
 CHECKED BY: JAC
 PLOT DATE: 04.26.11
 FILE NAME: 1063018_P043.dwg

A-400b

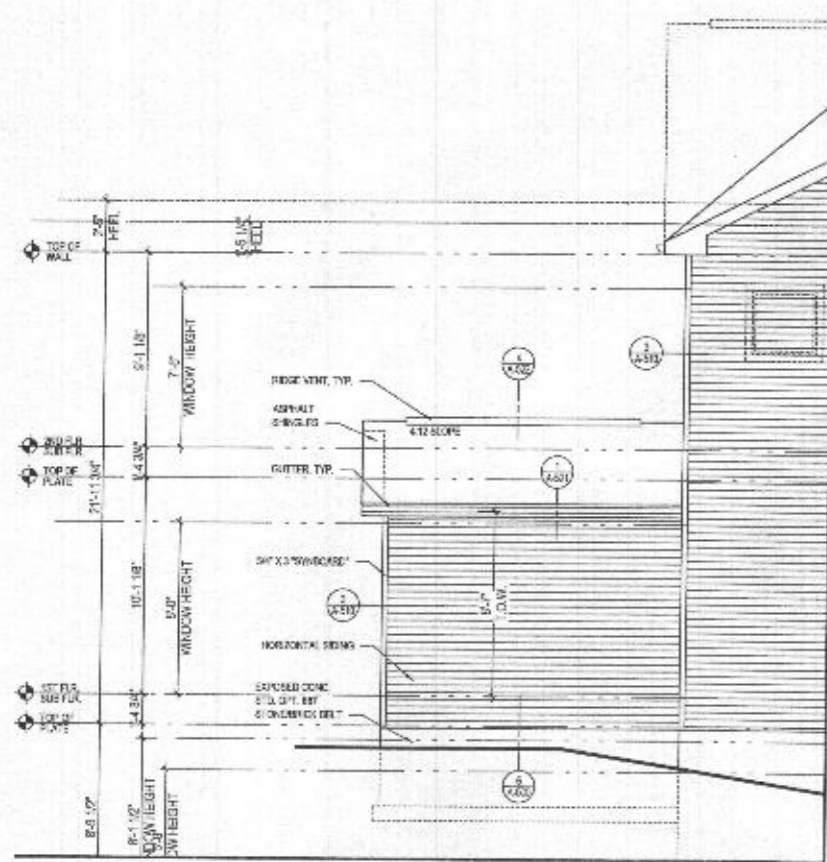


6 PART. REAR ELEVATION
A-401 SCALE: 1/4"=1'-0"
TYPICAL WALL

w/ OPT. 263102 - ONE CAR GARAGE
ELEV. 1 - SHOWN

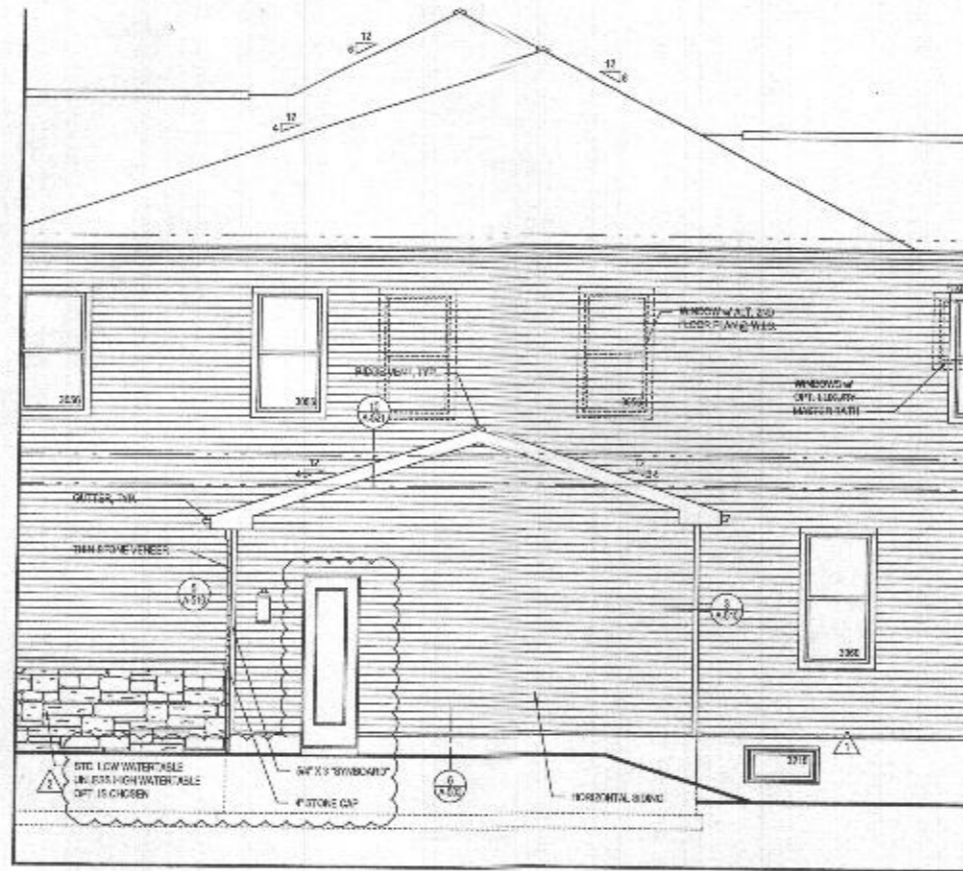


5 PART. RIGHT SIDE ELEVATION
A-401 SCALE: 1/4"=1'-0"
TYPICAL WALL

w/ OPT. 263102 - ONE CAR GARAGE
ELEV. 1 - SHOWN

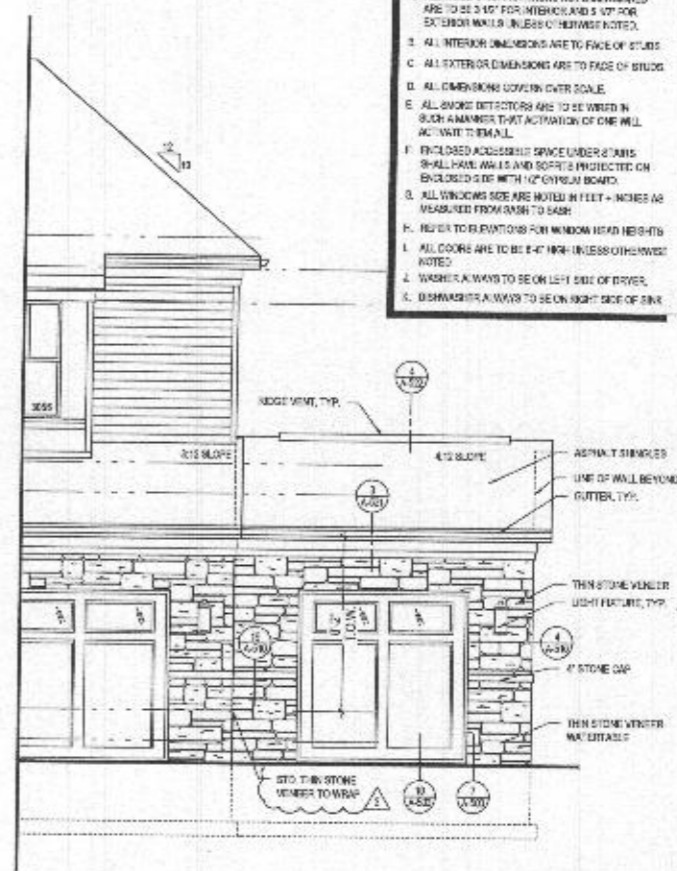


4 PART. FRONT ELEVATION w/ OPT. 263102 - ONE CAR GARAGE
A-401 SCALE: 1/4"=1'-0"
TYPICAL WALL


- GENERAL PLAN NOTES**
- A. ALL WOOD STUD PARTITIONS NOT DIMENSIONED ARE TO BE 2x4" FOR INTERIORS & 2x6" FOR EXTERIOR WALLS UNLESS OTHERWISE NOTED.
 - B. ALL INTERIOR DIMENSIONS ARE TO FACE OF STUDS.
 - C. ALL EXTERIOR DIMENSIONS ARE TO FACE OF STUDS.
 - D. ALL DIMENSIONS GIVEN ON SCALE.
 - E. ALL EXPOSED INTERIORS ARE TO BE FINISHED IN SUCH A MANNER THAT ACTIVATION OF ONE WILL ACTIVATE TO REMAIN.
 - F. ENCLOSED ACCESSIBLE SPACE UNDER STAIRS SHALL HAVE WALLS AND SLOTTES PROTECTED ON ENCLOSED SIDE WITH 1/2" OSB OR 1/2" OSB BOARD.
 - G. ALL WINDOWS ARE NOTED IN FEET - INCHES AS INDICATED FROM FINISH TO FINISH.
 - H. REFER TO ELEVATIONS FOR WINDOW HEAD HEIGHTS.
 - I. ALL DOORS ARE TO BE 4'-0" HIGH UNLESS OTHERWISE NOTED.
 - J. WORKER'S KWAYS TO BE ON LEFT SIDE OF DOOR.
 - K. DISHWASHER KWAY TO BE ON RIGHT SIDE OF SINK.

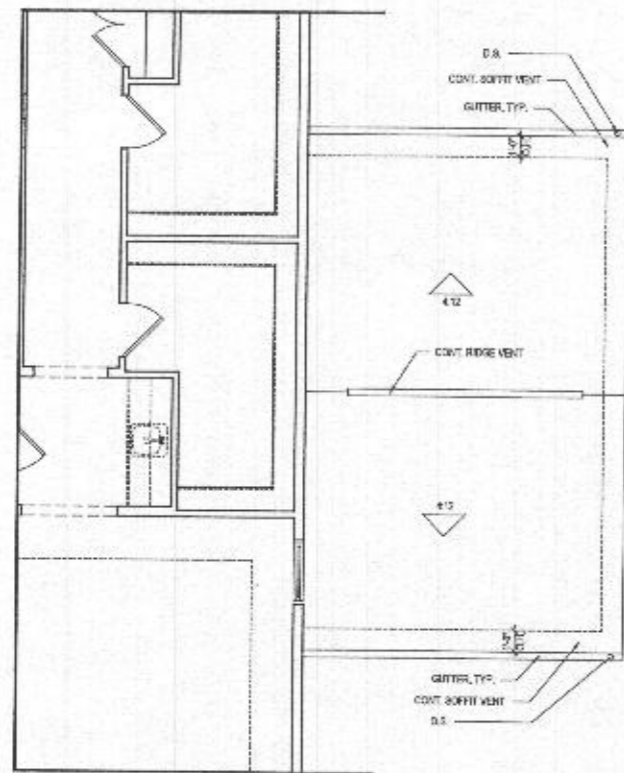

3 PART. SECOND FLOOR PLAN w/ OPT. 263102 - ONE CAR GARAGE
A-401 SCALE: 1/4"=1'-0"
TYPICAL WALL

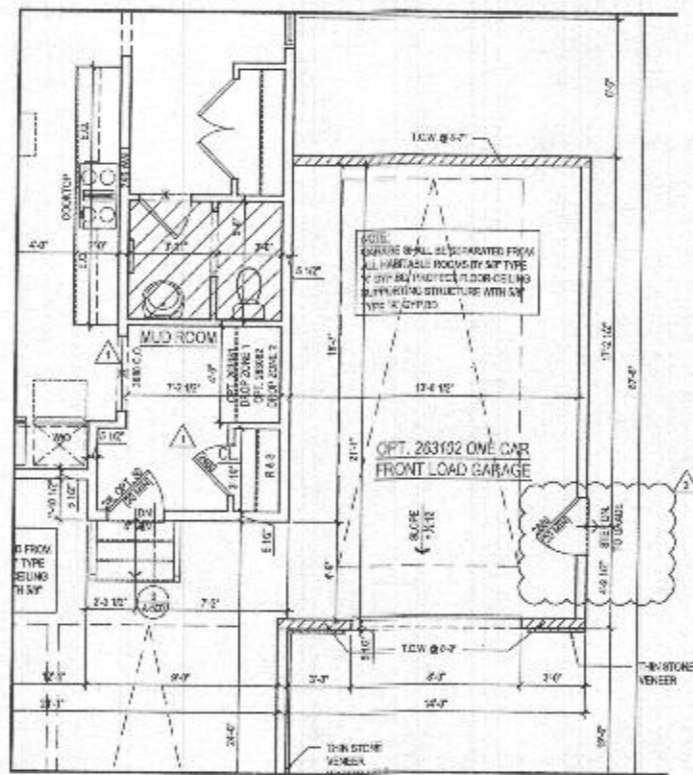

2 PART. FIRST FLOOR PLAN w/ OPT. 263102 - ONE CAR GARAGE
A-401 SCALE: 1/4"=1'-0"
TYPICAL WALL

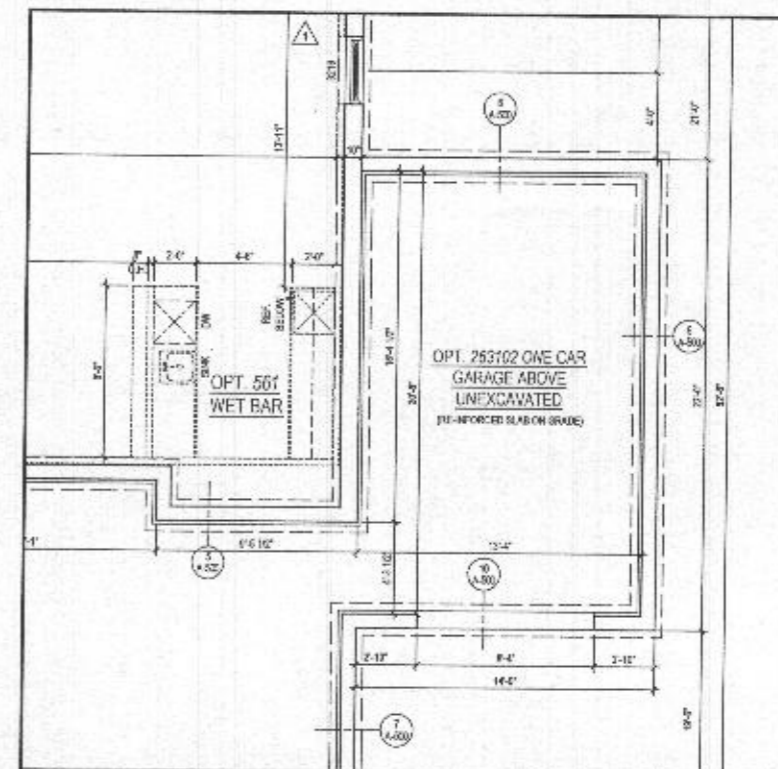

1 PART. BASEMENT FLOOR PLAN w/ OPT. 263102 - ONE CAR GARAGE
A-401 SCALE: 1/4"=1'-0"
TYPICAL WALL

ARCHITECT:

8521 Leesburg Pike
Suite 210 | Vienna, VA 22182
P: 571.830.1803 | F: 571.830.1801
www.lessarddesign.com

OWNER:

TOLL BROTHERS
19715 BELMONT EXECUTIVE PLAZA
ARLINGTON, VA 22247
P: 571.221.8068
CONTACT: CHRISTINA LEWIS
clewis@tollbrothers.com

PROPERTY NAME: MARYLAND

PARKHURST OPTIONS

PROJECT NO: 10100011

DRAWN BY: ALAN

CHECKED BY: ALAN

DATE: 05.26.13

FILE NAME: 10100011

PROJECT NO: 10100011

DRAWN BY: ALAN


CHECKED BY: ALAN

DATE: 05.26.13


FILE NAME: 10100011

A-401


- GENERAL PLAN NOTES**
- A. ALL WOOD STUD PARTITIONS NOT DIMENSIONED ARE TO BE 2 1/2" FOR INTERIOR, AND 5 1/2" FOR EXTERIOR WALLS UNLESS OTHERWISE NOTED.
 - B. ALL INTERIOR DIMENSIONS ARE TO FACE OF STUDS.
 - C. ALL EXTERIOR DIMENSIONS ARE TO FACE OF STUDS.
 - D. ALL DIMENSIONS GOVERN OVER SCALE.
 - E. ALL SMOKE DETECTORS ARE TO BE WIRED IN SUCH A MANNER THAT ACTIVATION OF ONE WILL NOTWAVE TO THEM ALL.
 - F. ENCLOSED JOISTS OR BATT SPACE UNDER STAIRS SHALL HAVE MESH AND GYP-SUM BOARD OR ENCLOSED SIDE WITH 1/2" GYP-SUM BOARD.
 - G. ALL WINDOWS ARE TO BE NOTED IN PLAN - INCHES ARE MEASURED FROM SASH TO SASH.
 - H. REFER TO ELEVATIONS FOR WINDOW HEAD HEIGHTS.
 - I. ALL DOORS ARE TO BE 6'8" UNLESS OTHERWISE NOTED.
 - J. NUMBER ALWAYS TO BE ON LEFT SIDE OF DOOR.
 - K. DOOR SWICH ALWAYS TO BE ON RIGHT SIDE OF SW.

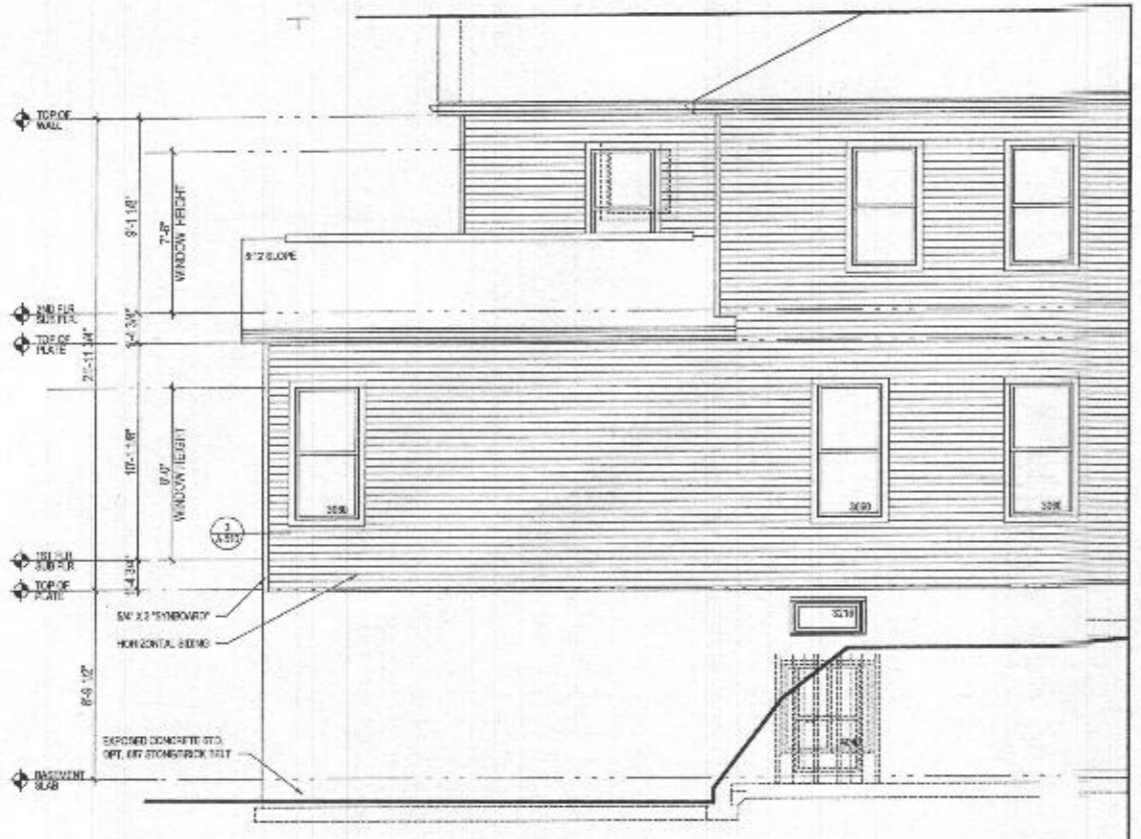


5 PART. LEFT ELEV.
 A-407 SCALE: 1/4"=1'-0"
 w/ OPT. 263073 MULTI-GEN. SUITE
 w/ COVD OUTDOOR LIVING @ WALKOUT CONDITION

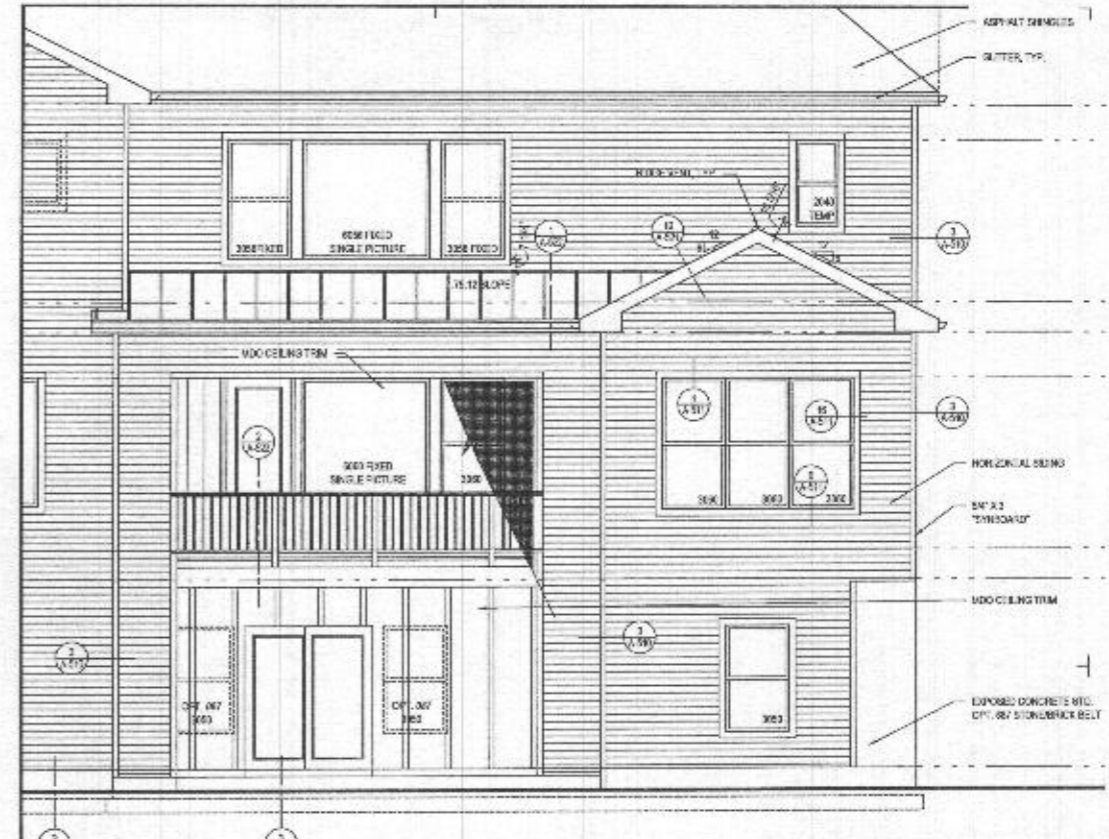


4 REAR ELEVATION
 A-407 SCALE: 1/4"=1'-0"
 w/ OPT. 263073 MULTI-GEN. SUITE
 w/ COVD OUTDOOR LIVING @ WALKOUT CONDITION

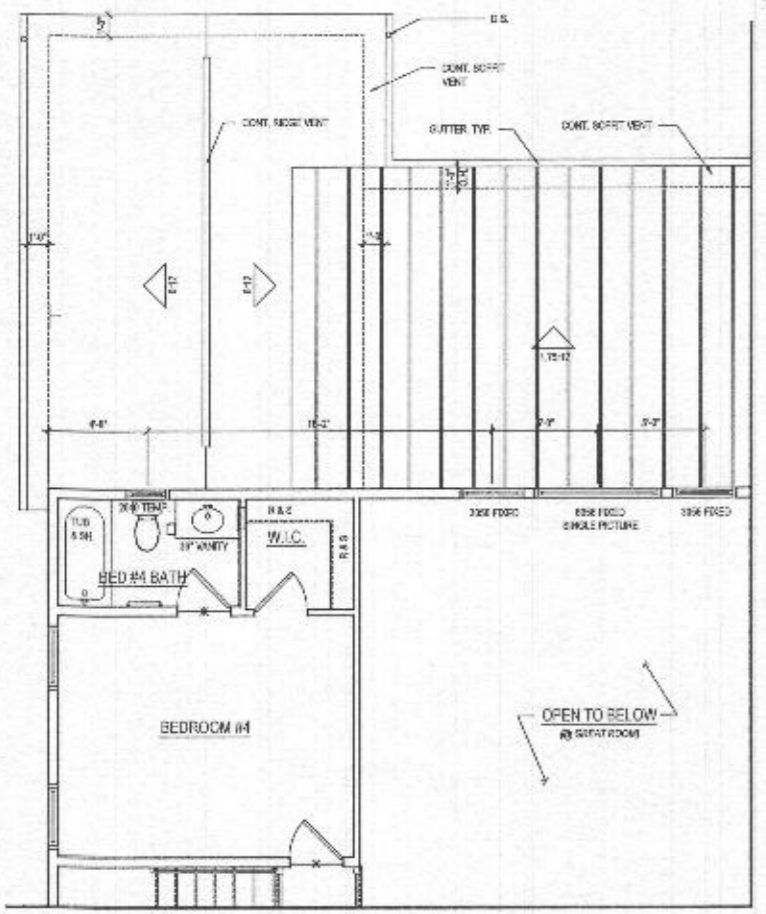

3 PART. SECOND FLOOR PLAN
 A-407 SCALE: 1/4"=1'-0"
 w/ OPT. 263073 MULTI-GEN. SUITE
 w/ COVD OUTDOOR LIVING @ WALKOUT CONDITION

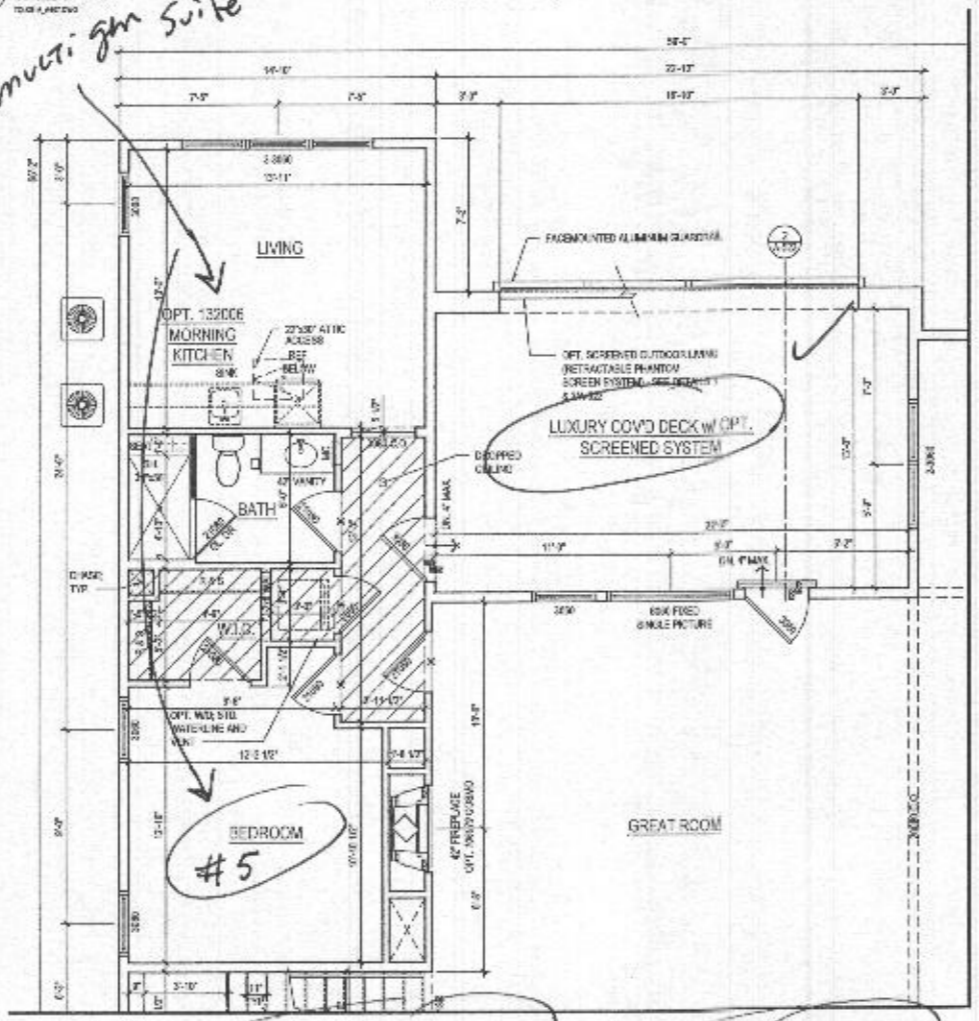

2 PART. FIRST FLOOR PLAN
 A-407 SCALE: 1/4"=1'-0"
 w/ OPT. 263073 MULTI-GEN. SUITE
 w/ COVD OUTDOOR LIVING @ WALKOUT CONDITION

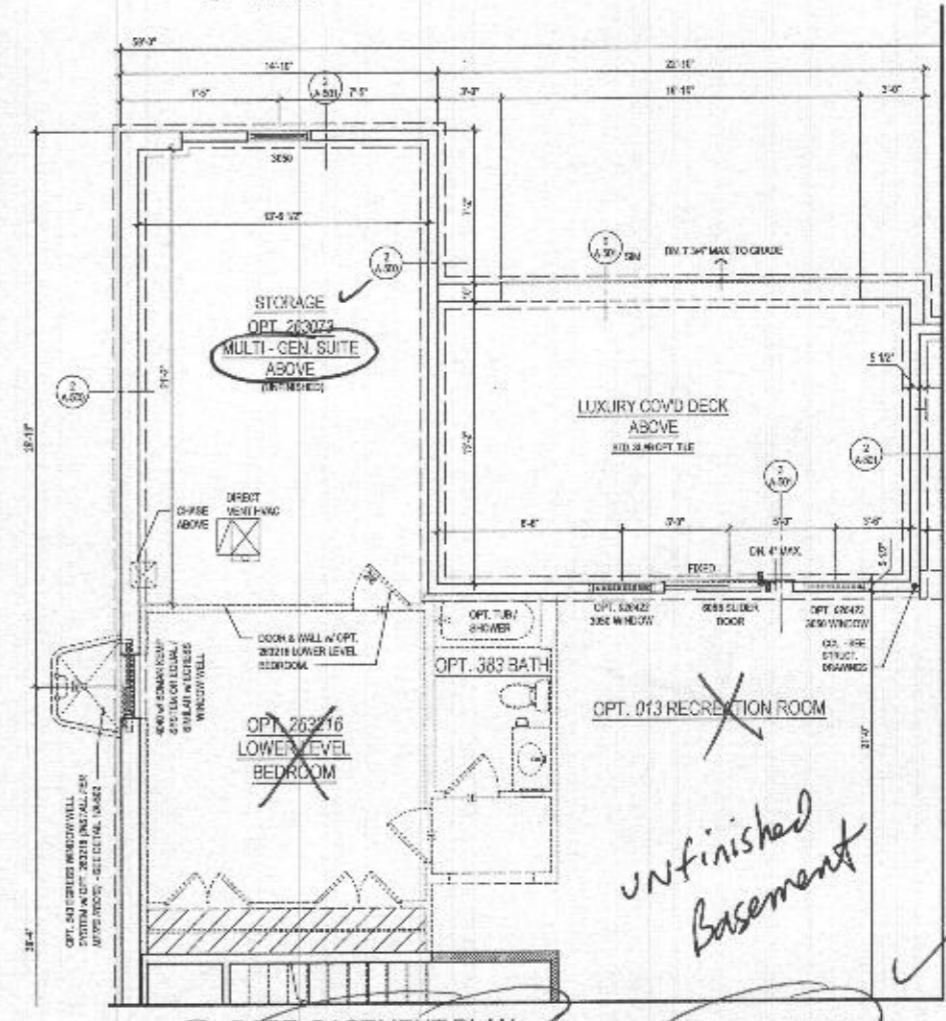

1 PART. BASEMENT PLAN
 A-407 SCALE: 1/4"=1'-0"
 w/ OPT. 263073 MULTI-GEN. SUITE
 w/ COVD OUTDOOR LIVING @ WALKOUT CONDITION

lessard DESIGN
 8571 Leesburg Pike
 Suite 700 | Vienna, VA 22182
 P: 571.830.1800 | F: 571.830.1801
 www.lessarddesign.com

ARCHITECT: *lessard*

OWNER: **TOLL BROTHERS**
 15775 BELMONT EXECUTIVE PLAZA
 ASHBURN, VA 20147
 P: 571.291.8700
 CONTACT: CHRISTINA LEMLEY
 clemley@tollbrothers.com

PROJECT NAME: **MARYLAND PARKHURST OPTIONS**

NO.	DESCRIPTION	DATE
1	W/ OPT. 263073 MULTI-GEN. SUITE	06.15.16
2	PERMIT SET	06.15.16
3	W/ NEW STANDARD	06.15.16
4	W/ R. 202241	12.11.20

PROJECT NO: **A-407**

File No: TOL0813_A-407.dwg