

APPLICATION

PERCOLATION TESTING

A 38497

P _____

HOWARD COUNTY HEALTH DEPARTMENT
BUREAU OF ENVIRONMENTAL HEALTH
P.O. BOX 476 ELLICOTT CITY, MARYLAND 21043
TELEPHONE: 461-9933

DISTRICT 3

DATE 10/20/86

TO: THE COUNTY HEALTH OFFICER
ELLICOTT CITY, MARYLAND

I, HEREBY, APPLY FOR THE NECESSARY TEST IN ORDER TO CONSTRUCT (OR RECONSTRUCT) A SEWAGE DISPOSAL SYSTEM.

PROPERTY OWNER Retubent Land Co., Inc.

ADDRESS Randolph Ayers man PHONE 531-5539

PROSPECTIVE BUYER _____

ADDRESS _____ PHONE _____

PROPERTY LOCATION:

SUBDIVISION Triadelphia Woods LOT NO. LOT 51 Prelimin 3249 6/29

ROAD AND DESCRIPTION Triadelphia Rd on right 1/2 mile west of Carroll Mill Rd. 12600 Golden OAK DR.

TAX MAP 22 PARCEL # 528

SIZE OF LOT 3+ Acre TYPE BLDG. _____ (SINGLE FAMILY DWELLING OR COMMERCIAL)

THE SYSTEM INSTALLED UNDER THIS APPLICATION IS ACCEPTABLE ONLY UNTIL PUBLIC FACILITIES BECOME AVAILABLE. I FULLY UNDERSTAND THE FEE CONNECTED WITH THE FILING OF THIS PERC TEST APPLICATION IS NON-REFUNDABLE UNDER ANY CIRCUMSTANCES. I ALSO AGREE TO COMPLY WITH ALL M.O.S.H.A. REQUIREMENTS IN TESTING THIS LOT.

Richard J. Donnell
(SIGNATURE OF APPLICANT)

APPROVED BY S. A. H. L. FOR Deep trenches DATE 5-23-89

REJECTED BY _____ FOR _____ DATE _____

HOLD PENDING FURTHER TESTS _____ DATE _____

REASONS FOR REJECTION OR HOLDING 2-17-87 Perc Satisfactory, Hold for Subdivision Plat. S. A. H. L.

BUDG. PERMIT SIGNED 5/23/89
AND RETURNED 2006 S. A. H. L.

BP 26065

THIS IS NOT A PERMIT


① ② ③ ④
SOIL PROFILE

0"
6"
3"
12"

A1-3

Yellow Br to
Yellow Red
Silt Loam
9% clay
40% fines

Red Yellow
to Br Silt
Loam
Highly
micaceous
20%+

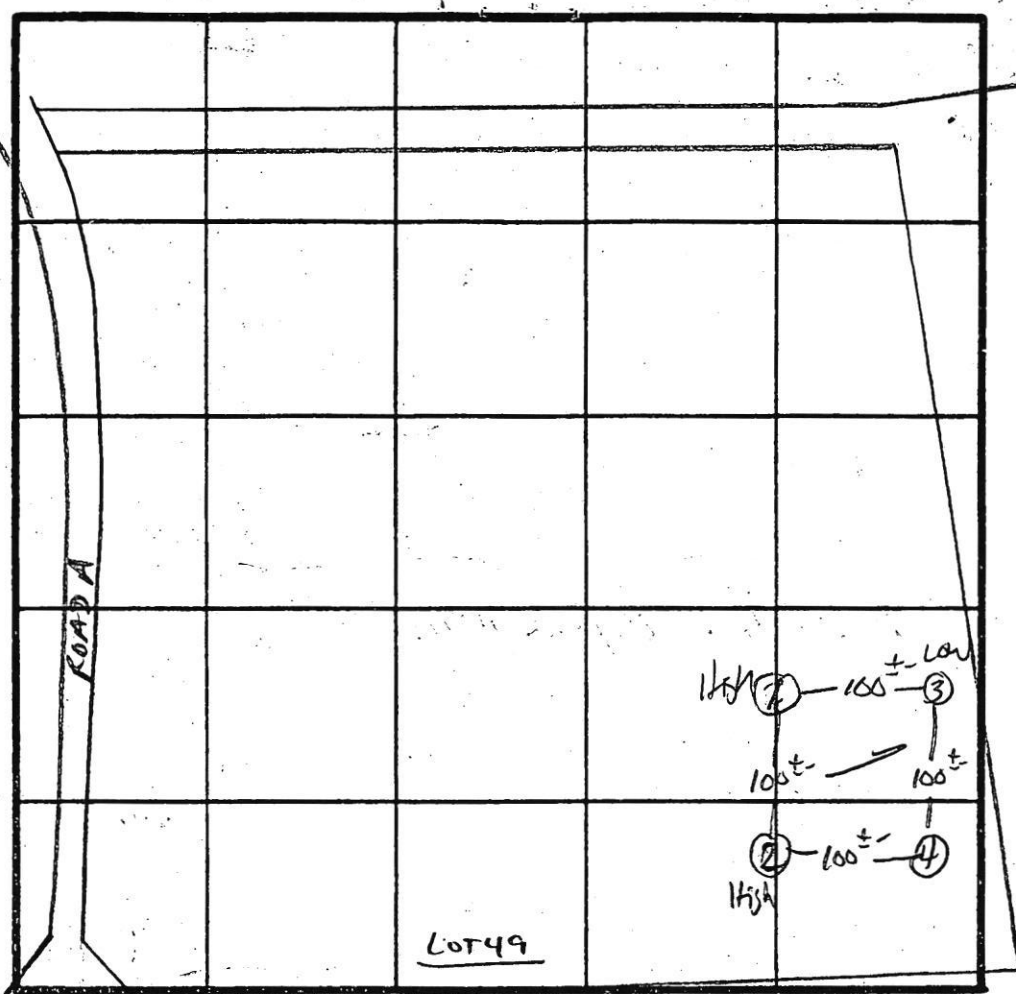

x PERC
8 min
170#/BR
INLET 3'
BOTTOM 8'

INDICATE NORTH - NAME ADJOINING ROADWAY AS BASE LINE.

TRIADELPHIA Rd.

DATE	TEST NO.	DEPTH	PRE-WET		TEST - 1" DROP		TIME
			START	STOP	START	STOP	
4/17/87	1 S	3"	1134	1140	1140	1149	9 min
		7.5"	1132	1133	1133	1135	2 min
	IV	13' UNIFORM SOIL below 3'					
	2 V	12' UNIFORM SOIL below 3'					
	3 S	3"	1153	1154	1154	1156	2 min
	3 V	12.5' UNIFORM SOIL below 3'					
	4 S	3.5"	1137	1145	1145	1103	18 min
	4 V	12.5' UNIFORM SOIL below 3'					

13
18
310

REMARKS: 1 holes per PLAT

TYPE OF SOIL: MANDOR

JIM RICHARD