

# APPLICATION

PERCOLATION TESTING

A 518006-DD

P \_\_\_\_\_

HOWARD COUNTY HEALTH DEPARTMENT  
BUREAU OF ENVIRONMENTAL HEALTH  
3525-H ELLICOTT MILLS DRIVE/ELLICOTT CITY, MARYLAND 21043  
TELEPHONE: 313-2640

DISTRICT \_\_\_\_\_

DATE 11/22/02

TO: THE COUNTY HEALTH OFFICER  
ELLICOTT CITY, MARYLAND

I HEREBY APPLY FOR THE NECESSARY TEST PRIOR TO APPLICATION FOR PERMIT TO CONSTRUCT (OR RECONSTRUCT) A SEWAGE DISPOSAL SYSTEM.

PROPERTY OWNER RICHARD MYRTLE & WIFE

ADDRESS 3504 MYRTLE ST. PHONE \_\_\_\_\_

AGENT OR PROSPECTIVE BUYER EDIGATO SQ. 29438-3723  
JAMES KEELTY & CO. INC.

ADDRESS 61 E. PADONIA RD. PHONE 410-252-8600  
TIMONUM, MD 21093

PROPERTY LOCATION:

DIVISION \_\_\_\_\_ LOT NO. 3130

ROAD AND DESCRIPTION 1795 WOODSTOCK RD.  
WOODSTOCK MD 21163

TAX MAP 10 PARCEL # 925

SIZE OF LOT 148.636 AC TYPE BLDG. SINGLE FAMILY  
(SINGLE FAMILY DWELLING OR COMMERCIAL)

THE SYSTEM INSTALLED UNDER THIS APPLICATION IS ACCEPTABLE ONLY UNTIL PUBLIC FACILITIES BECOME AVAILABLE. I FULLY UNDERSTAND THE FEE CONNECTED WITH THE FILING OF THIS PERC TEST APPLICATION IS NON-REFUNDABLE UNDER ANY CIRCUMSTANCES. I ALSO AGREE TO COMPLY WITH ALL M.O.S.H.A. REQUIREMENTS IN TESTING THIS LOT. Richard Myrtle  
Pauline F. Myrtle  
(SIGNATURE OF APPLICANT)

APPROVED BY \_\_\_\_\_ FOR \_\_\_\_\_ DATE \_\_\_\_\_

DISAPPROVED BY \_\_\_\_\_ FOR \_\_\_\_\_ DATE \_\_\_\_\_

HOLD PENDING FURTHER TESTS \_\_\_\_\_

REASONS FOR REJECTION OR HOLDING \_\_\_\_\_

PERCOLATION TEST PLAT/PRELIMINARY PLAT - TITLE OR I.D. # \_\_\_\_\_ DATE \_\_\_\_\_

SITE DEVELOPMENT PLAN/FINAL PLAT - TITLE OR I.D. # \_\_\_\_\_ DATE \_\_\_\_\_

# THIS IS NOT A PERMIT

518006-M

COUNTY #

SOIL PROFILE

0' Hole  
aving  
in form  
water  
@ 9 1/2'  
1:53pm  
Red  
clay  
loam  
3'  
Brown  
Loamy  
and  
somewhat  
coarse  
12'

60% clay  
black


RD  
Brn  
Lm  
3'

N  
wall

offg  
Brn  
Lm  
5'  
3'  
Str.  
ybrn  
Lm S  
Trace  
rx  
MASSIVE  
Soil Struct  
Bottom  
14'

330/332  
Rd Brn  
SLm  
3'

Lt brn  
white  
y brown  
md grain  
SAND  
Trace  
Rx  
Massive  
Soil  
Structure  
Bottom  
13'

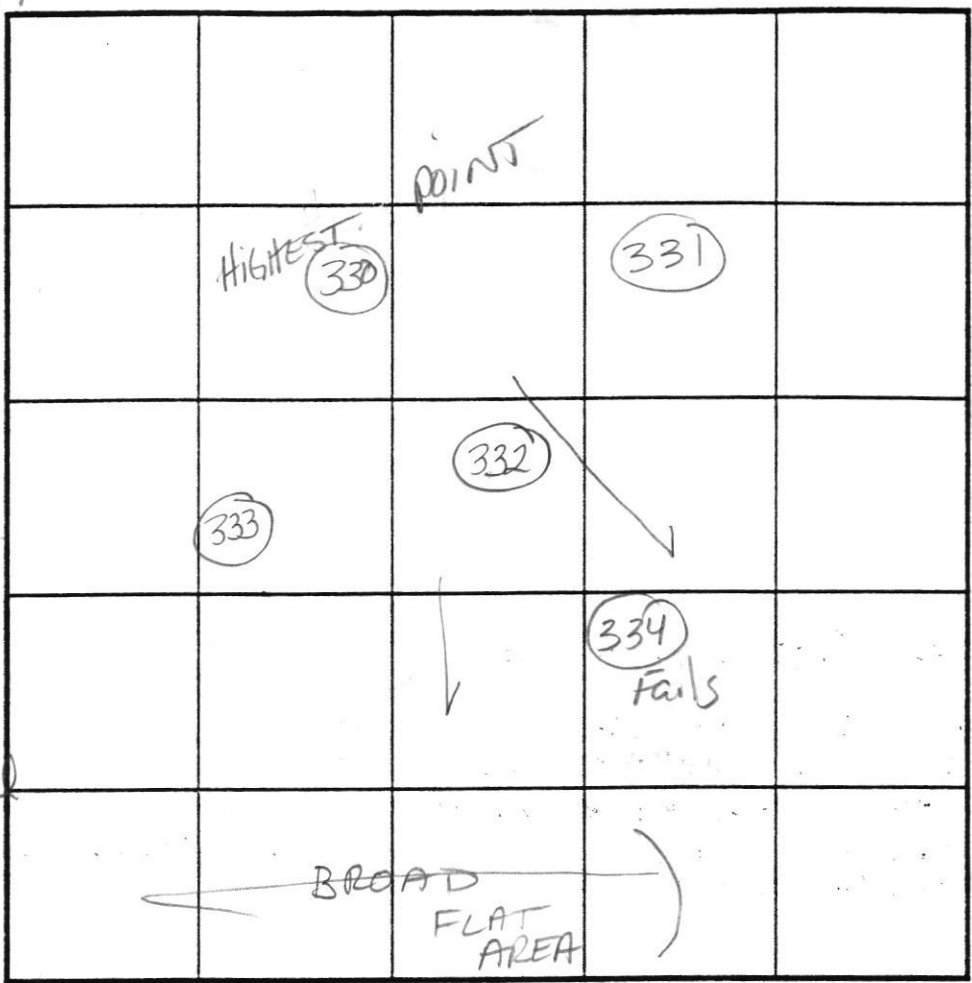

INDICATE NORTH - NAME ADJOINING ROADWAY AS BASE LINE.

SOIL PROFILE

0' DK brn  
1' CLLM  
org brn  
L Sand  
2 1/2' strong brn  
wk rd  
brn  
Fine  
SLm  
14 1/2' Bottom

DATE	TEST NO.	DEPTH	PRE-WET		TEST - 1" DROP		TIME	
			START	STOP	START	STOP		
3-12-03	334	SEE Soil Profile					(F)	
	333	5' M / 14'	2:14	2:16	2:16	2:20	4 OK	
	330	Visual					OK	
	332	6' M / 14'	2:25	2:29	2:29	2:32	4min OK	
	331	6' M / 14.5'	2:41	2:43	2:43	2:48	50K	
		↑ WATER SEEPAGE AT 12 1/2'						
		TESTS RAN IN TX ZONE						

REMARKS: Holes staked and dug per plan  
 TYPE OF SOIL: SHALLOW SYSTEM ONLY  
 TESTED BY: RN & FA ALSO PRESENT: Bob S. & KELLY  
 TRENCH DESIGN DATA: AVERAGE PERCOLATION TIME \_\_\_\_\_ TRENCH WIDTH \_\_\_\_\_  
 INLET DEPTH \_\_\_\_\_ MAXIMUM BOTTOM DEPTH \_\_\_\_\_ SQ. FT./BEDROOM \_\_\_\_\_

