



# HOWARD COUNTY HEALTH DEPARTMENT

70973 AS

P5

DATE  
2 / 28 / 22

Received From

Fuyro Senior Center

PHONE #

410-795 5670

For

Dentist Repair

CASH

CHECK

NO.

7448

14787 Armonson Way

Woods rd

Three hundred + thirty 1/10 Dollars - 0/10


Dollars

\$

330 00

Received By

V. DeKrom

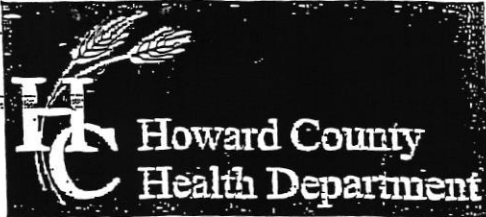

Bureau of Environmental Health

8930 Stanford Boulevard, Columbia, MD 21045

Phone: 410-313-2540 Fax: 410-313-2548

TDD 410-313-2323 | Toll Free 1-866-313-6300

www.hchealth.org

Facebook: www.facebook.com/hcohealth

Twitter: HowardCoHealthDep

Maura J. Rossman, M.D., Health Officer

9570973

APPLICATION

FOR PERCOLATION TESTING AND SITE EVALUATION

PROPERTY LOCATION

SUBDIVISION/PROPERTY NAME

PROPERTY ADDRESS

14787 Addison Way Woodbine MD 21797

TAX ACCOUNT #

317203

TAX MAP

0008

GRID

0016

PARCEL

0077

LOT NO.

PROPOSED LOT

SIZE (ACRES)

0.987 acres

ZONING CATEGORY

04

TIER

PROPERTY OWNER(S)

Kenneth/Julia Pdk

DAYTIME PHONE

410-963-6533

CELL

410-442-1236

EMAIL

MAILING ADDRESS

same

APPLICANT

Fogles Septic

RELATIONSHIP TO OWNER:

None

DAYTIME PHONE

410-895-5670

CELL

EMAIL

MAILING ADDRESS

580 Obrecht Rd Sykesville Md 21784

I HEREBY APPLY FOR THE NECESSARY TESTING/EVALUATION PRIOR TO ISSUANCE OF SEWAGE DISPOSAL SYSTEM PERMIT(S):

PROPERTY:

- PROPERTY: SUBDIVISION: NUMBER OF LOTS INCLUDING RESIDUE: SUBDIVISION CLASSIFICATION (PER DEPT. OF PLANNING AND ZONING) MAJOR MINOR CONSTRUCT NEW OSDS ON UNDEVELOPED LOT REPAIR OR REPLACE FAILING OSDS UPGRADE EXISTING OSDS

BUILDING:

- BUILDING: RESIDENTIAL WITH EXISTING OR PROPOSED BEDROOMS IN THE COMPLETED STRUCTURE COMMERCIAL (PROVIDE DETAIL OF TYPE OF USE AND NUMBERS OF EMPLOYEES/CUSTOMERS ON ACCOMPANYING PLAN)


IS THE PROPERTY WITHIN 2500 FEET OF ANY RESERVOIR?

- YES NO

AS APPLICANT, I UNDERSTAND THE FOLLOWING:

- THIS APPLICATION IS VALID FOR TWO (2) YEARS FROM DATE OF FEE PAYMENT AND APPROVAL IS BASED UPON HEALTH OFFICER SIGNATURE OF A PERC CERTIFICATION PLAN PRIOR TO EXPIRATION OF THIS PERMIT. THE APPLICATION FEE IS NON-REFUNDABLE THIS APPLICATION MUST BE ACCOMPANIED BY ALL APPLICABLE FEES AND A SUITABLE SITE PLAN IN ORDER TO BE PROCESSED THIS IS A PUBLIC DOCUMENT

I declare and affirm that to the best of my knowledge, the information contained herein is correct. I declare that I am the owner of the property or duly authorized to make this application on behalf of the owner. I agree to comply with all applicable state and county regulations. By signature of this application, I hereby grant Howard County Health Department officials the right to enter onto the property for the purpose of inspecting the property as directly related to the requested permit/service. Jeff Palmer 2-28-22 SIGNATURE OF APPLICANT DATE

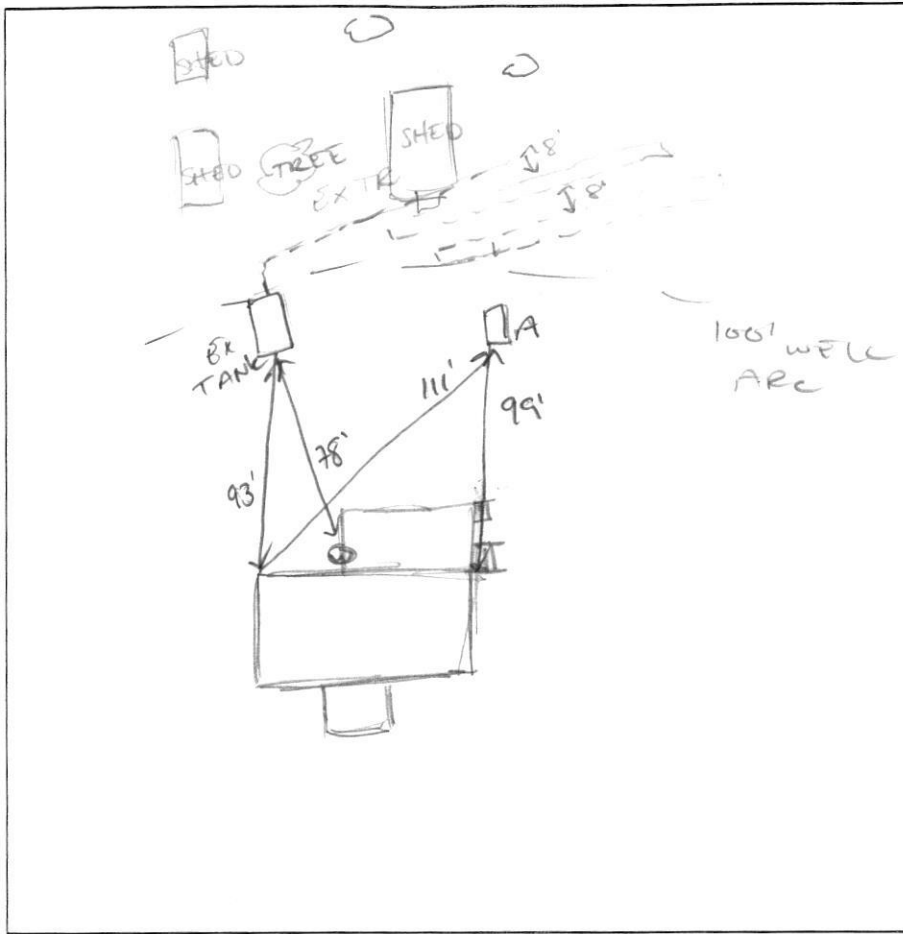

0" A  
 3" DE BRN  
 10" SCL SBK  
 16" YEL BRN  
 36" SCL ABK  
 RED/YEL BRN  
 RBY SBK  
 SL mfr wso  
 FEW BOULDER 18" x 24" x 8"  
 7' BRN/YEL  
 10' SSL SBK  
 mfr wso  
 14' RED + YEL  
 SSL SBK  
 mfr wso  
 R PATENT

Site Log

DATE	TEST #	DEPTH	START	BREAK 1" DROP	STOP 2" DROP	TIME OF 2ND INCH	P/F/H
03/11/2022	A	5.5' / 14'	5:45	14:00	26:00	12m	P
		5 gal @ bottom				5-8m	

REMARKS EX TR EXPOSED - 2' WIDE, ORANGE BURK, UNDER SUBSURFACE HYD. PRAS.

SANITARIAN CABANG 001997 BACKHOE FOGLEP OTHERS

TEST HOLES USED IN SDA \_\_\_\_\_ AVG. PERC TIME 0.8 SQ. FT/BR 4

TRENCH WIDTH 3' INLET DEPTH 4' MAX. BOT DEPTH 10' EFFECTIVE SW 5'

$\frac{150.4}{.08} = 750$   
 $3'w \cdot 5'_{sw} \cdot .36 = 90'$  2x45' TRS  
 $2'w \cdot 5'_{sw} \cdot .31 = 117'$  2x59' TRS

Real Property Data Search

Search Result for HOWARD COUNTY

[View Map](#)                      [View GroundRent Redemption](#)                      [View GroundRent Registration](#)

Special Tax Recapture: None

**Account Identifier:**                      **District - 04 Account Number - 317203**

Owner Information

<b>Owner Name:</b>	POLK KENNETH DAVID POLK JULIA ROSETTA	<b>Use:</b>	RESIDENTIAL
		<b>Principal Residence:</b>	YES
<b>Mailing Address:</b>	14787 ADDISON WAY WOODBINE MD 21797-8628	<b>Deed Reference:</b>	/09207/ 00611

Location & Structure Information

<b>Premises Address:</b>	14787 ADDISON WAY WOODBINE 21797-0000	<b>Legal Description:</b>	.987 A 14787 ADDISON WAY WOODBINE
--------------------------	--	---------------------------	---

<b>Map:</b>	<b>Grid:</b>	<b>Parcel:</b>	<b>Neighborhood:</b>	<b>Subdivision:</b>	<b>Section:</b>	<b>Block:</b>	<b>Lot:</b>	<b>Assessment Year:</b>	<b>Plat No:</b>
0008	0016	0077	4010103.14	1003				2020	Plat Ref:

Town: None

<b>Primary Structure Built</b>	<b>Above Grade Living Area</b>	<b>Finished Basement Area</b>	<b>Property Land Area</b>	<b>County Use</b>
1944	2,204 SF		42,993 SF	

<b>Stories</b>	<b>Basement</b>	<b>Type</b>	<b>Exterior</b>	<b>Quality</b>	<b>Full/Half Bath</b>	<b>Garage</b>	<b>Last Notice of Major Improvements</b>
2	NO	STANDARD UNIT	SIDING/	3	2 full		

Value Information

	Base Value	Value As of 01/01/2020	Phase-in Assessments	
			As of 07/01/2021	As of 07/01/2022
<b>Land:</b>	197,900	180,900		
<b>Improvements</b>	103,400	112,400		
<b>Total:</b>	301,300	293,300	293,300	293,300
<b>Preferential Land:</b>	0	0		

Transfer Information

<b>Seller:</b> POLK JULIA ROSETTA	<b>Date:</b> 05/31/2005	<b>Price:</b> \$0
<b>Type:</b> NON-ARMS LENGTH OTHER	<b>Deed1:</b> /09207/ 00611	<b>Deed2:</b>
<b>Seller:</b> POLK JULIA ROSETTA	<b>Date:</b> 05/24/1989	<b>Price:</b> \$5,000
<b>Type:</b> NON-ARMS LENGTH OTHER	<b>Deed1:</b> /02001/ 00064	<b>Deed2:</b>
<b>Seller:</b> HARRISON ROSEATTE	<b>Date:</b> 12/16/1985	<b>Price:</b> \$2,000
<b>Type:</b> NON-ARMS LENGTH OTHER	<b>Deed1:</b> /01417/ 00713	<b>Deed2:</b>

Exemption Information

<b>Partial Exempt Assessments:</b>	<b>Class</b>		07/01/2021	07/01/2022
<b>County:</b>	000		0.00	
<b>State:</b>	000		0.00	
<b>Municipal:</b>	000		0.00 0.00	0.00 0.00

Special Tax Recapture: None

Homestead Application Information

**Homestead Application Status:** Approved 10/24/2008

Homeowners' Tax Credit Application Information

**Homeowners' Tax Credit Application Status:** No Application                      **Date:**