


Kingsbury Residence
14301 Fox Creek Ct
Cookeville

Kevin Mattero
AKMattero Plumbing
301-704-5171
AKMATTERO@gmail.com



APPROVED
WALK-THRU BUILDING PERMIT
BP# B21004792 A#
APP. SAN Spencer DATE: 4/14/2022
DESC. OF WORK: Tying in stone
to existing septic

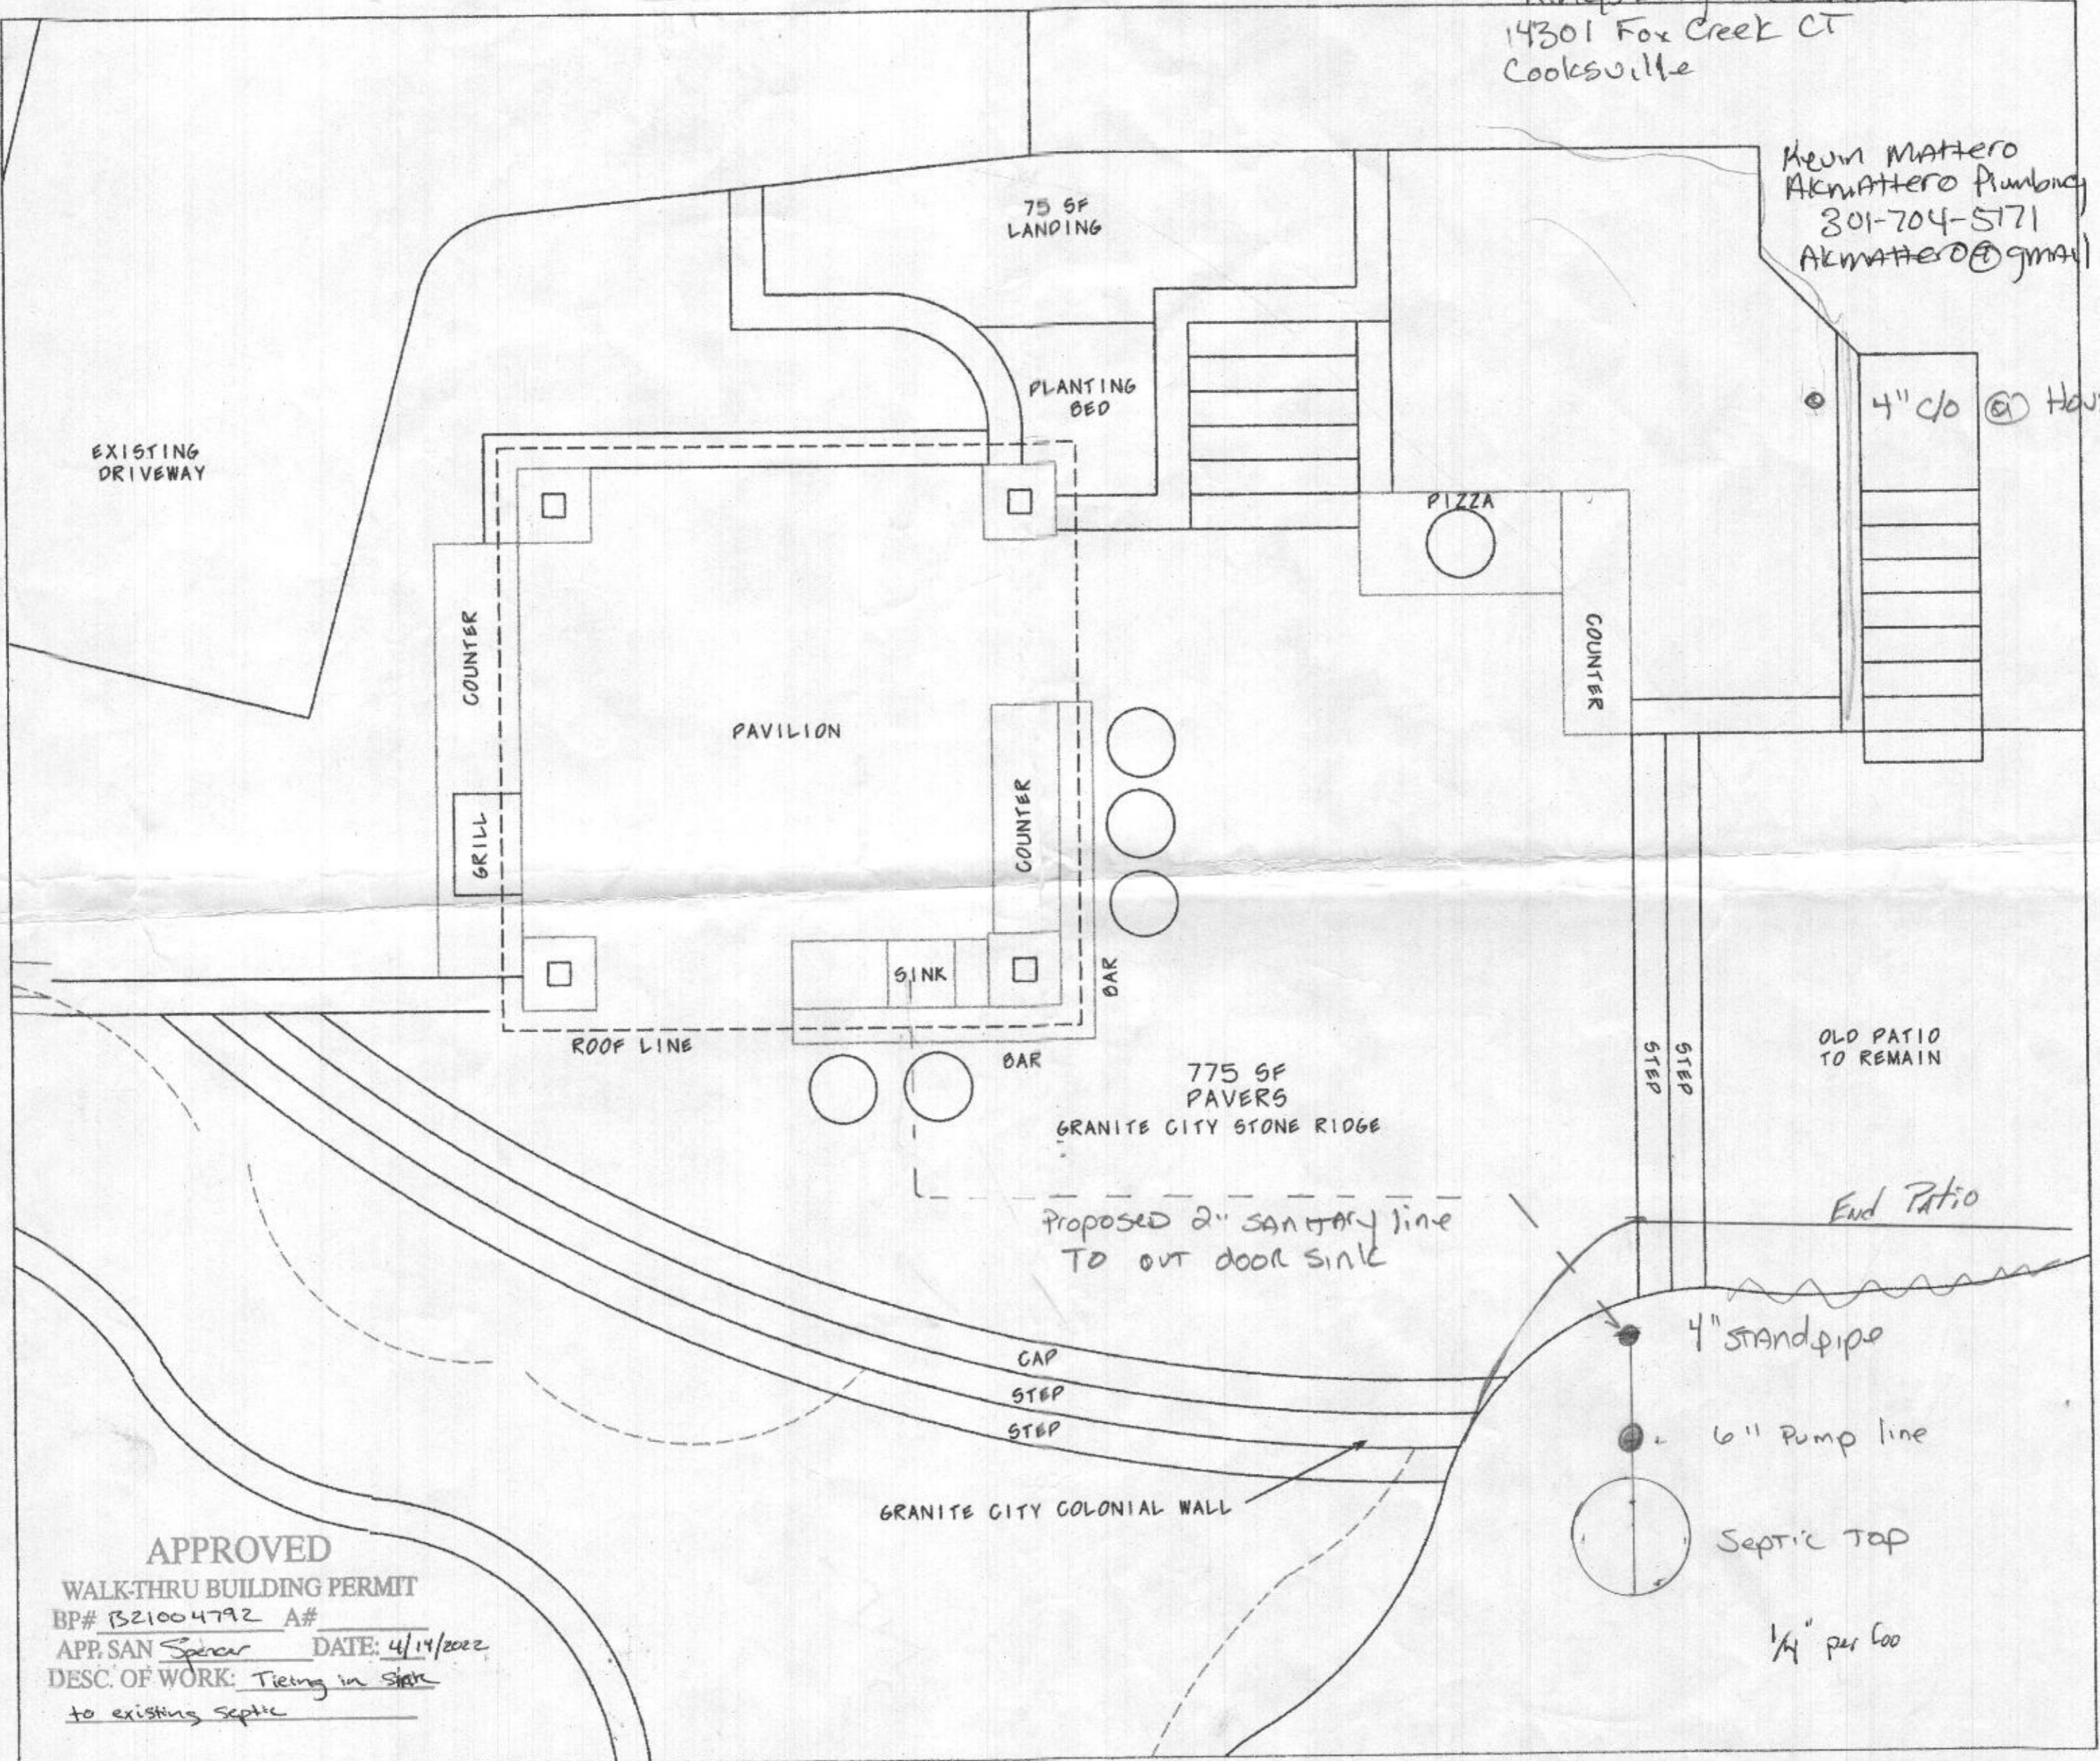