

APPLICATION

PERCOLATION TESTING

A _____

P _____

HOWARD COUNTY HEALTH DEPARTMENT
BUREAU OF ENVIRONMENTAL HEALTH
3525-H ELLICOTT MILLS DRIVE/ELLICOTT CITY, MARYLAND 21043
TELEPHONE: 410-313-2640

DISTRICT _____

DATE _____

TO: THE COUNTY HEALTH OFFICER
ELLICOTT CITY, MARYLAND

I HEREBY APPLY FOR THE NECESSARY TEST PRIOR TO APPLICATION FOR PERMIT TO CONSTRUCT (OR RECONSTRUCT) A SEWAGE DISPOSAL SYSTEM.

PROPERTY OWNER Clifford and Betty Harrison

ADDRESS 3155 Route 32, West Friendship, MD 21794 PHONE 410-442-2196

AGENT OR PROSPECTIVE BUYER Heritage Land Development

ADDRESS 3060 Washington Rd., Suite 220, Glenwood, MD 21738 PHONE 410-489-7900

PROPERTY LOCATION:

SUBDIVISION _____ LOT NO. 6

ROAD AND DESCRIPTION Off of Route 32, South of Rosemary Lane 3/4 of a mile

TAX MAP NO. 22 PARCEL # 17

SIZE OF LOT 1 Acre TYPE OF BLDG. SFD
(SINGLE FAMILY DWELLING OR COMMERCIAL)

THE SYSTEM INSTALLED UNDER THIS APPLICATION IS ACCEPTABLE ONLY UNTIL PUBLIC FACILITIES BECOME AVAILABLE. I FULLY UNDERSTAND THE FEE CONNECTED WITH THE FILING OF THIS PERC TEST APPLICATION IS NON-REFUNDABLE UNDER ANY CIRCUMSTANCES. I ALSO AGREE TO COMPLY WITH ALL M.O.S.H.A. REQUIREMENTS IN TESTING THIS LOT.

[Signature]
(SIGNATURE OF APPLICANT)

APPROVED BY _____ FOR _____ DATE _____

DISAPPROVED BY _____ FOR _____ DATE _____

HOLD PENDING FURTHER TESTS _____

REASONS FOR REJECTION OR HOLDING _____

PERCOLATION TEST PLAT/PRELIMINARY PLAT - TITLE OR I.D. # _____ DATE _____

SITE DEVELOPMENT PLAN/FINAL PLAT - TITLE OR I.D. # _____ DATE _____

THIS IS NOT A PERMIT


COUNTY #

SOIL PROFILE

0' 113
 6" topsoil
 org brn cl loam
 2.5' pale org brn sil mica loam
 25%+ sapr sh
 14'

0' 112
 6" topsoil
 red org brn cl loam
 3.5' pale org brn sil mica loam
 20%+ sapr sh
 13.4'

0' 114
 6" topsoil
 org brn cl loam
 tan sil mica loam
 15-20%+ sapr sh
 13.1'

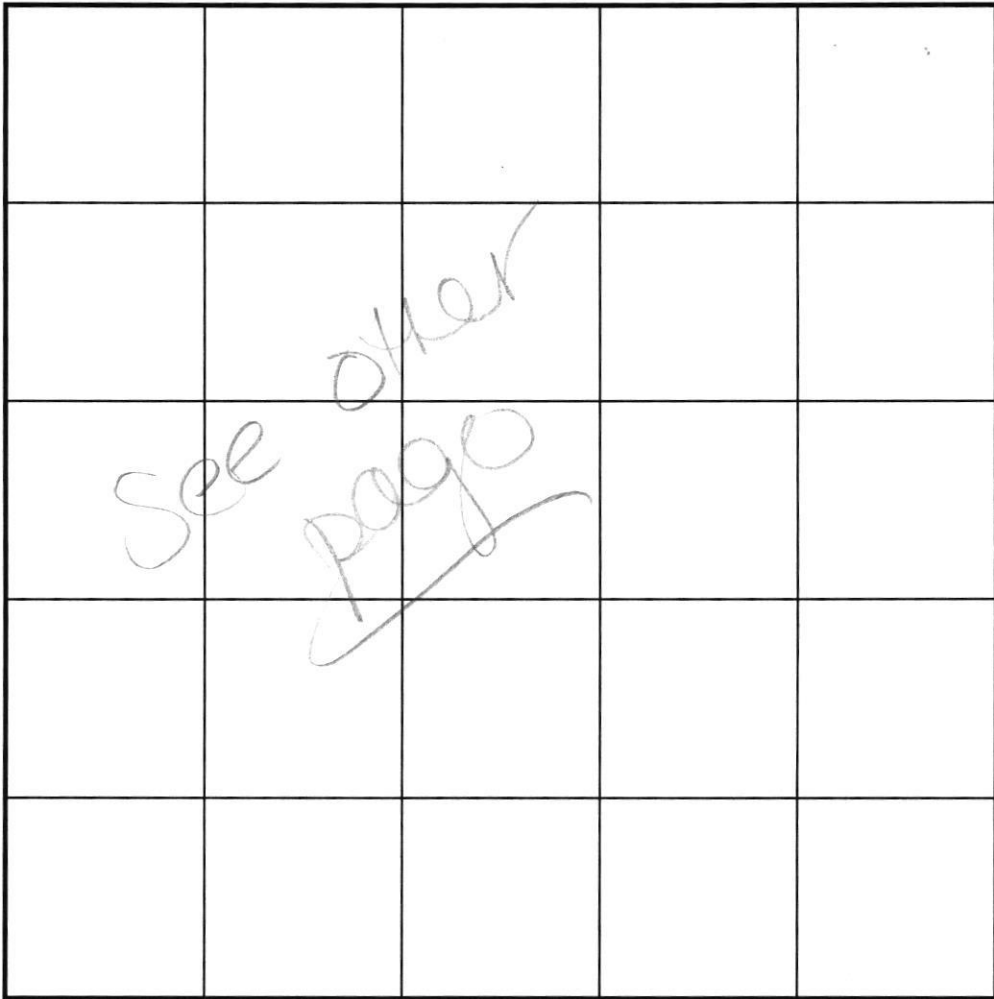

SOIL PROFILE

0' 108
 6" topsoil
 red brn cl loam
 3' pale org tan sil mica loam
 15%+ sapr sh
 13.5'

INDICATE NORTH - NAME ADJOINING ROADWAY AS BASE LINE.

DATE	TEST NO.	DEPTH	PRE-WET		TEST - 1" DROP		TIME
			START	STOP	START	STOP	
6-21-01	113	3.0' S	2:01	2:03	2:03	2:06	3
		14.0' D	Visual -	See profile			OK
	112	13.4" D	Visual	- See profile			OK
	114	13.0' D	Visual	- See profile			OK
	108	3.0' S	2:21	2:24	2:24	2:29	5
		13.5' D	Visual	- See profile			OK

REMARKS _____
 TYPE OF SOIL _____
 TESTED BY DJC ALSO PRESENT C. Zepp, T. Feaga
 TRENCH DESIGN DATA: AVG. PERCOLATION TIME _____ TRENCH WIDTH _____
 INLET DEPTH _____ MAXIMUM BOTTOM DEPTH _____ SQ. FT./BEDROOM _____

COUNTY #

SOIL PROFILE
0' 115/116

6" topsoil

org brn
clm

3' pale
org brn
si mica
lm

15%+
sapr
sh

12.5'

0' 117/111

6" topsoil

red brn
clm

4' pale
red brn
si mica

10-15%
sh

13'10"

0' 118


6" topsoil

red org
brn
clm

4' tan
si mica
lm

15%+
sh

13.5'

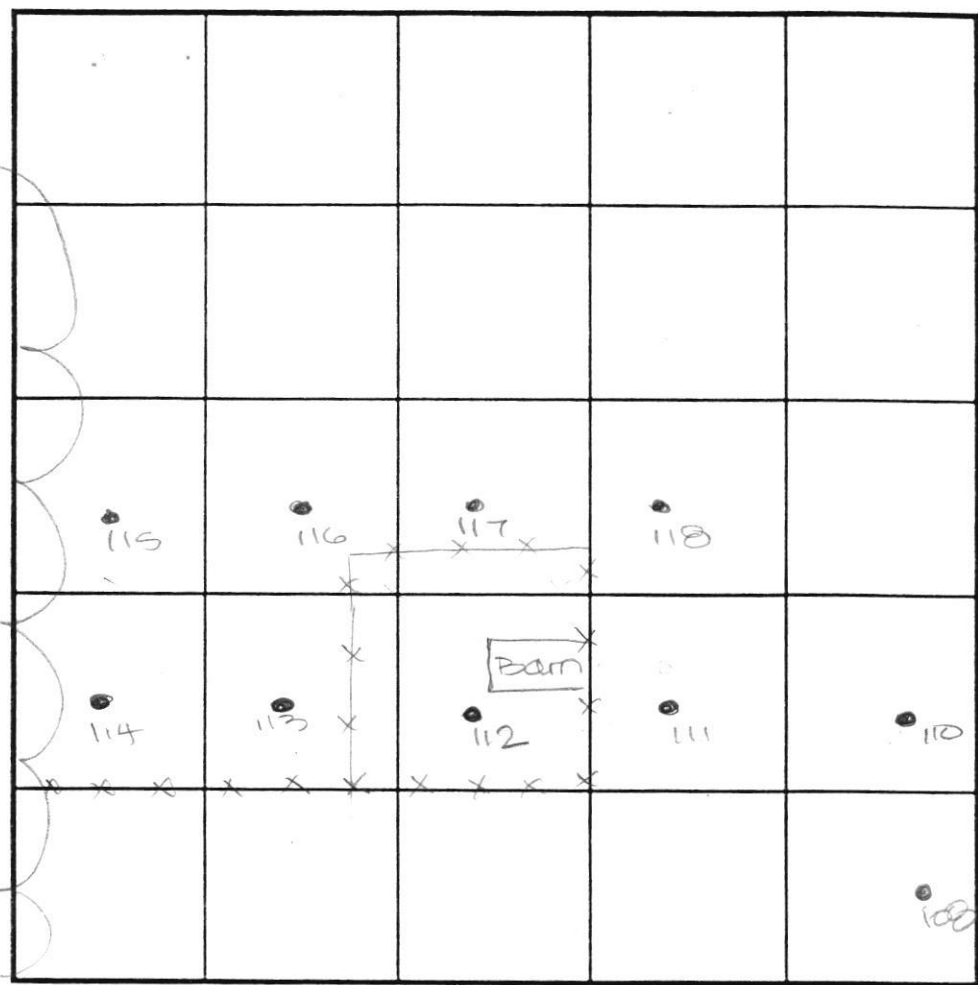

SOIL PROFILE
0' 110

like
117

W/20%+
sapr
sh

14'

DATE	TEST NO.	DEPTH	PRE-WET		TEST - 1" DROP		TIME
			START	STOP	START	STOP	
6-21-01	115	3.5' S	11:57 ₃	11:58	11:58	12:00 ₂	3
		12.5' D	visual	-see	profile		OK
	117	4.5' S	12:03 ₂	12:05 ₂	12:05 ₂	12:09 ₃	4
		13'10" D	visual	-see	profile		OK
	116	13.5' D	visual	-see	profile		OK
	118	13.5' D	visual	-see	profile		OK
	111	4.0' S	11:56 ₃	11:57 ₃	11:57 ₃	11:59 ₃	2
		13'10" D	visual	-see	profile		OK
	110	14.0' D	visual	-see	profile		OK

REMARKS _____

TYPE OF SOIL _____

TESTED BY DKC ALSO PRESENT C. Zepp, T. Peaga

TRENCH DESIGN DATA: AVERAGE PERCOLATION TIME _____ TRENCH WIDTH _____

INLET DEPTH _____ MAXIMUM BOTTOM DEPTH _____ SQ FT/BEDROOM _____

APPLICATION

PERCOLATION TESTING

HOWARD COUNTY HEALTH DEPARTMENT.
BUREAU OF ENVIRONMENTAL HEALTH
3525-H ELLICOTT MILLS DRIVE/ELLICOTT CITY, MARYLAND 21043
TELEPHONE: 410-313-2640

A _____

P _____

DISTRICT _____

DATE _____

TO: THE COUNTY HEALTH OFFICER
ELLICOTT CITY, MARYLAND

I HEREBY APPLY FOR THE NECESSARY TEST PRIOR TO APPLICATION FOR PERMIT TO CONSTRUCT (OR RECONSTRUCT) A SEWAGE DISPOSAL SYSTEM.

PROPERTY OWNER Clifford and Betty Harrison

ADDRESS 3155 Route 32, West Friendship, MD 21794 PHONE 410-442-2196

AGENT OR PROSPECTIVE BUYER Heritage Land Development

ADDRESS 3060 Washington Rd., Suite 220, Glenwood, MD 21738 PHONE 410-489-7900

PROPERTY LOCATION:

SUBDIVISION _____ LOT NO. 8

ROAD AND DESCRIPTION Off of Route 32, South of Rosemary Lane 3/4 of a mile

TAX MAP NO. 22 PARCEL # 17

SIZE OF LOT 1 Acre TYPE OF BLDG. SFD
(SINGLE FAMILY DWELLING OR COMMERCIAL)

THE SYSTEM INSTALLED UNDER THIS APPLICATION IS ACCEPTABLE ONLY UNTIL PUBLIC FACILITIES BECOME AVAILABLE. I FULLY UNDERSTAND THE

FEE CONNECTED WITH THE FILING OF THIS PERC TEST APPLICATION IS NON-REFUNDABLE UNDER ANY CIRCUMSTANCES. I ALSO AGREE TO COMPLY

WITH ALL M.O.S.H.A. REQUIREMENTS IN TESTING THIS LOT.


(SIGNATURE OF APPLICANT)

APPROVED BY _____ FOR _____ DATE _____

DISAPPROVED BY _____ FOR _____ DATE _____

HOLD PENDING FURTHER TESTS _____

REASONS FOR REJECTION OR HOLDING _____

PERCOLATION TEST PLAT/PRELIMINARY PLAT - TITLE OR I.D. # _____ DATE _____


SITE DEVELOPMENT PLAN/FINAL PLAT - TITLE OR I.D. # _____ DATE _____

THIS IS NOT A PERMIT

COUNTY #

SOIL PROFILE

0' 100A
 topsoil
 dk red brn
 cl lm
 1+
 org brn
 si mica
 lm
 30%+
 sapr
 sh

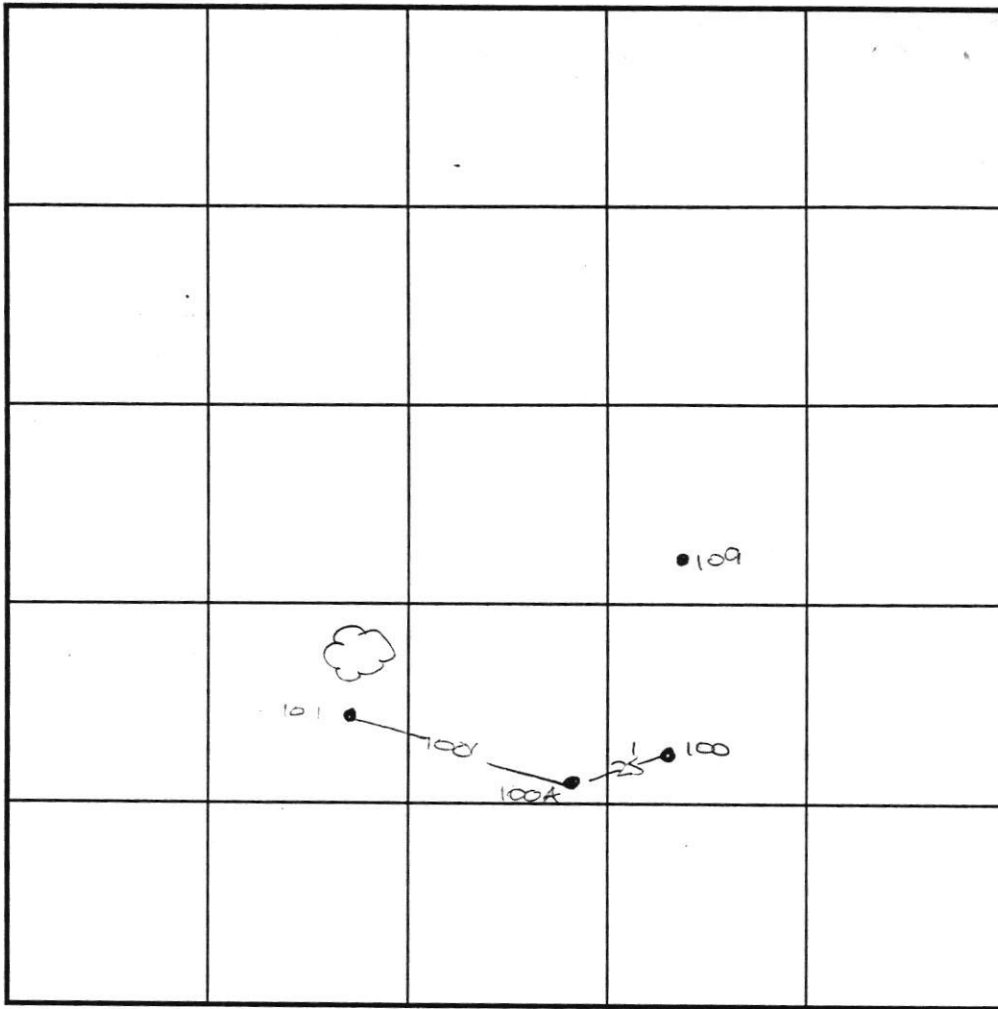

SOIL PROFILE

0'

INDICATE NORTH - NAME ADJOINING ROADWAY AS BASE LINE.

ROUTE 32

DATE	TEST NO.	DEPTH	PRE-WET		TEST - 1" DROP		TIME
			START	STOP	START	STOP	
6-22-01	100A	3.5' S	11:09	slow test stopped			-
		4.0' M	11:36	11:46	11:46	11:56	10
		13.0' D	visual	- see profile			OK
	100	5.5' D	Refusal				FAIL
	101	13.5' D	visual	- see profile			OK
	109	13.0' D	visual	- see profile			OK

REMARKS

TYPE OF SOIL

TESTED BY DRE

ALSO PRESENT C. Zepp, T. Feag

TRENCH DESIGN DATA: AVG. PERCOLATION TIME

TRENCH WIDTH

INLET DEPTH


MAXIMUM BOTTOM DEPTH

SQ. FT./BEDROOM

101
 topsoil
 red brn
 cl lm
 med
 pk brn
 si mica
 lm
 20%+
 sapr
 sh

109
 topsoil
 red org
 brn
 cl lm
 1+ brn
 si mica
 lm
 20%
 25%
 sapr
 sh

PRINCIPAL ARTERIAL ROAD (ROUTE 32)

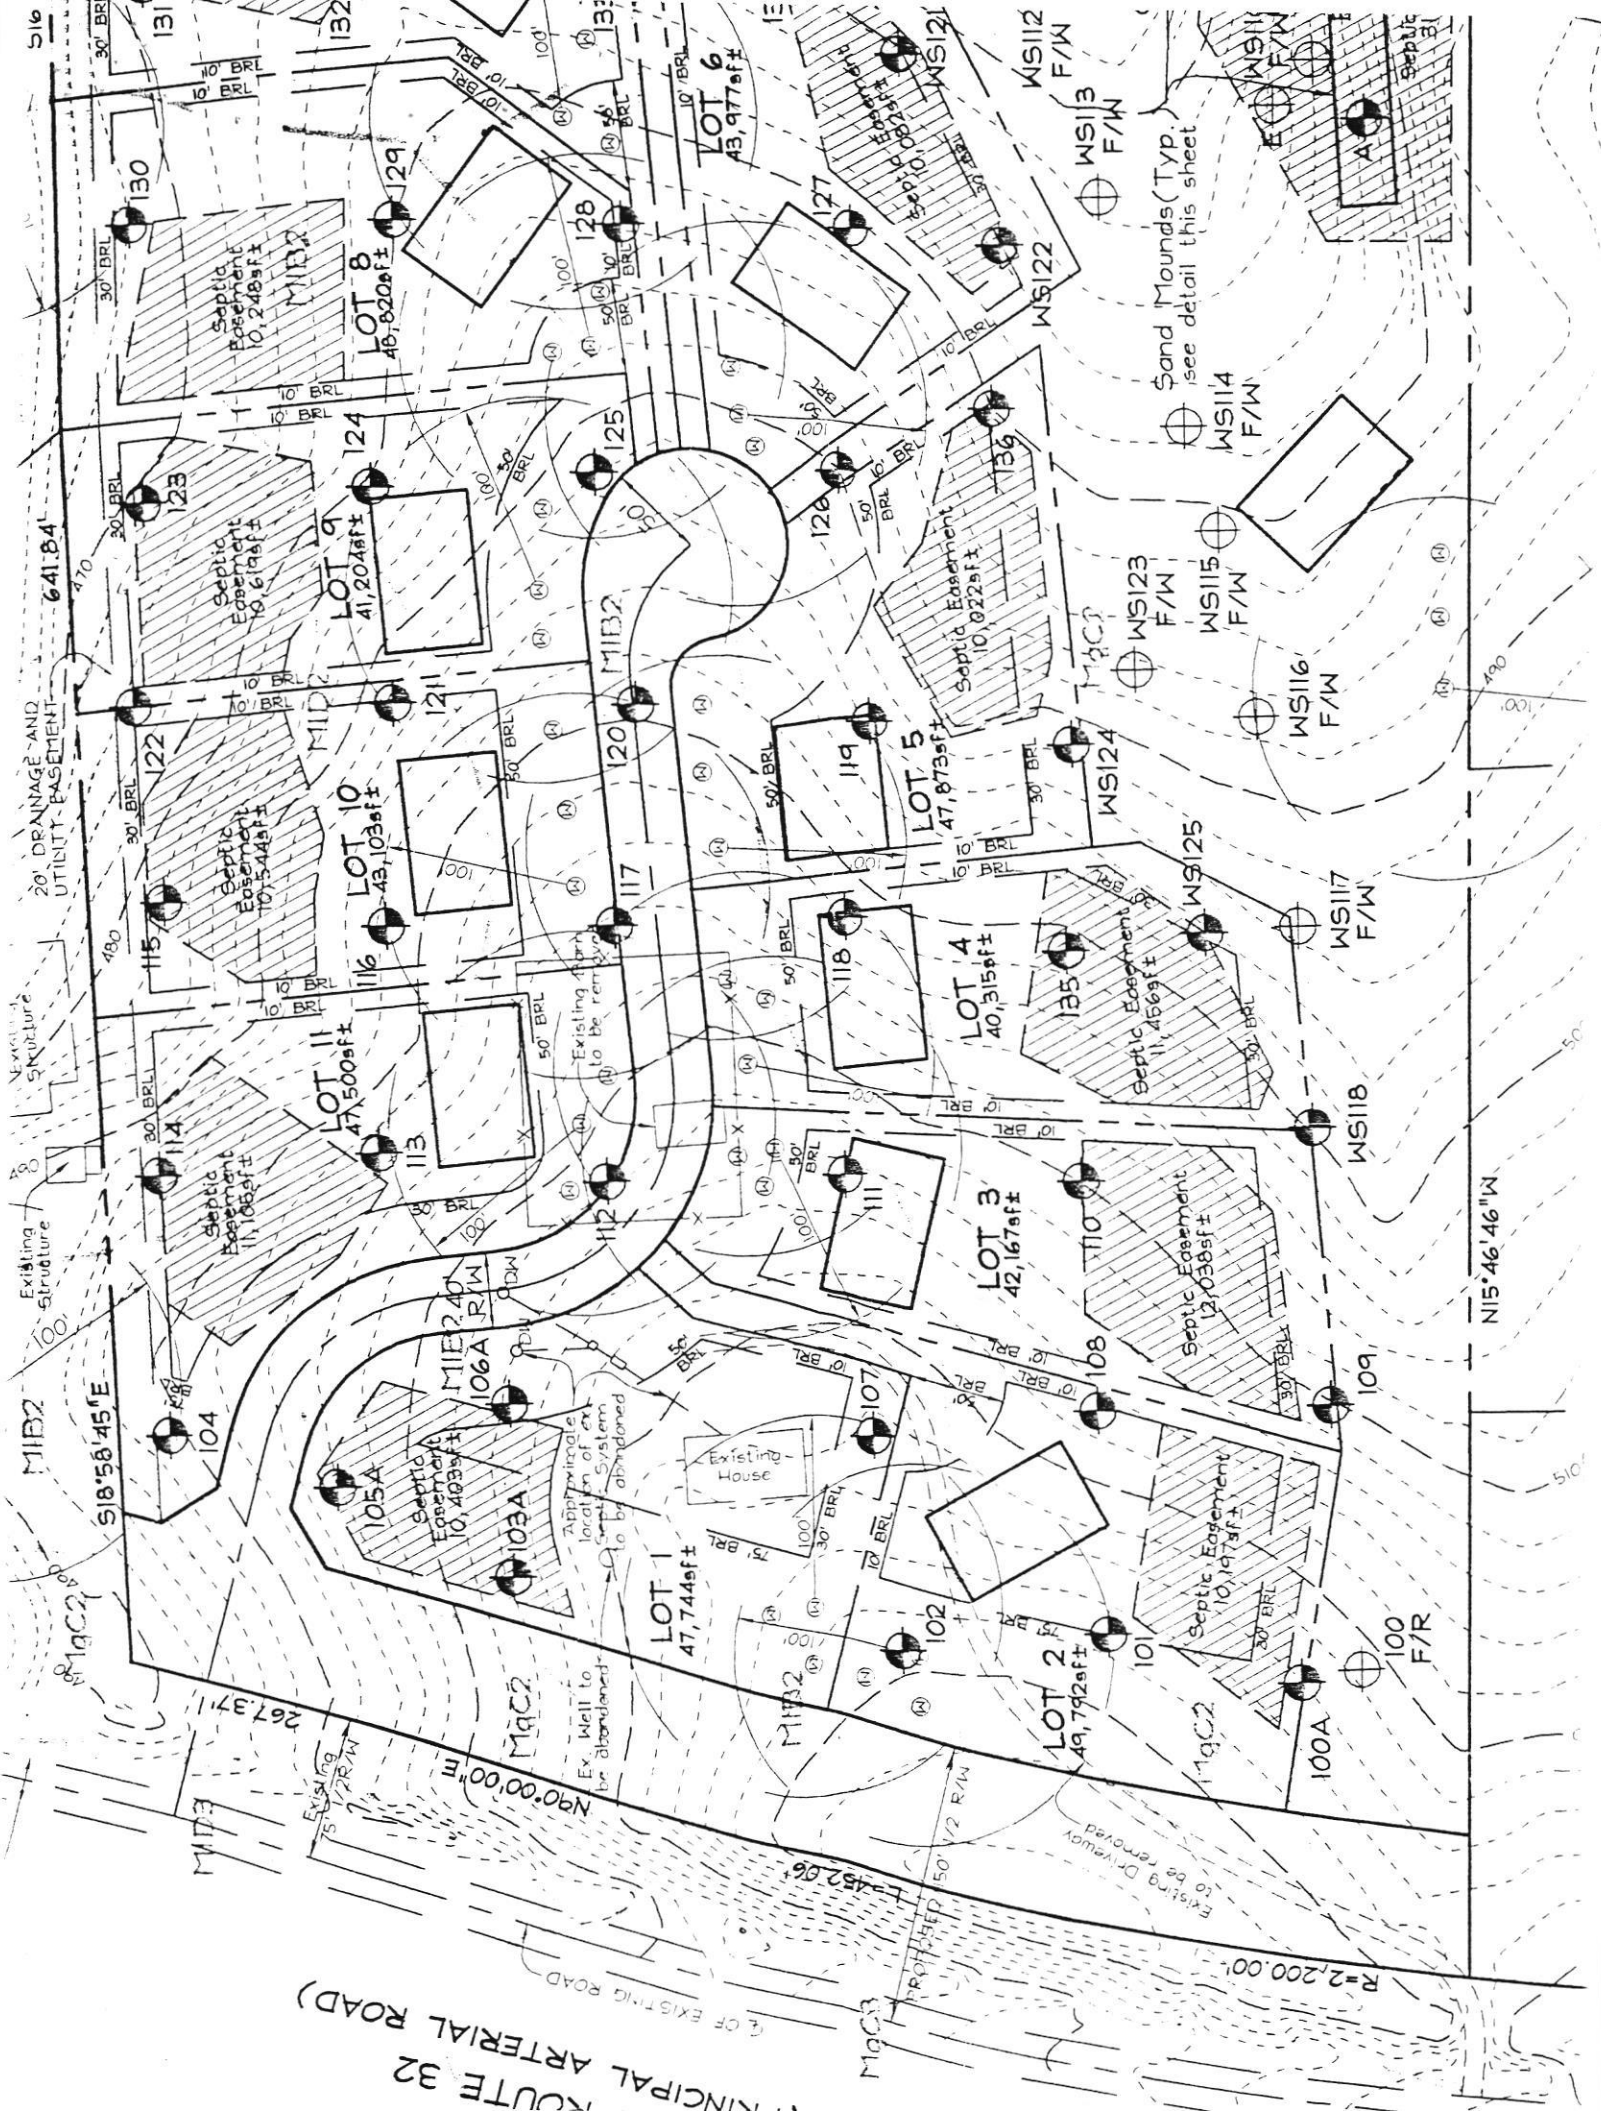

20' DRAINAGE AND UTILITY EASEMENT 641.84'

Existing Structure

MIB2

MIB2

MIB2

MIB2

516

130

131

132

SEPTIC SPECIFICATIONS WORKSHEET

SUBDIVISION: Twin Pines A 514944C

STREET NAME: _____ LOT NUMBER: 3

AVERAGE PERCOLATION RATE: _____ SQUARE FEET PER BEDROOM: 180 (x.62)

NUMBER OF BEDROOMS: _____ LINEAR FEET OF TRENCH PER BEDROOM: _____

TOTAL LINEAR FEET OF TRENCH: _____ SEPTIC TANK CAPACITY: _____

TOP SEAMED TANK REQUIRED? YES OR NO COMPARTMENTED TANK REQUIRED? YES OR NO

TRENCH DIMENSIONS: Trench to be 3.0 feet wide. Inlet 4.0 feet below original grade. Bottom maximum depth 6.0 feet below original grade. Effective area begins at 4.0 feet below original grade. 2.0 feet of stone below distribution pipe.

PUMPED SYSTEM PROPOSED: YES OR NO

Pumped Septic System Detail: _____ gallon(s) pump chamber.

Top Seamed Pump Chamber Required? YES OR NO

Note 1: Septic pump detail to be provided by installer prior to issuance of septic permit.

Note 2: Pump performance test is necessary prior to Health Department approval of pump septic system.

LOCATION: _____

ADDITIONAL NOTES: _____

Reviewer: _____

Date: _____