



Gloria Ching <gloriaching@gmail.com>

4842 Bonnie View Ct_B21004070

1 message

Bricker, Robert <RBricker@howardcountymd.gov>
To: "calvinko@gmail.com" <calvinko@gmail.com>
Cc: "gloriaching@gmail.com" <gloriaching@gmail.com>

Wed, Dec 15, 2021 at 10:40 AM

Good morning Calvin: I am sending a list of Licensed Well Drillers for you to reach out to them. They do have times that become available that they may be able to fit an abandonment into their schedule.

The Health Department now has an active role in the review of the proposal at 4842 Bonnie View. We will condition the permit that no inspections occur until we approve the permit, i.e. until the well is properly sealed. That should allow you to pour footers and work on the foundation.

Robert Bricker, REHS/RS, L.E.H.S.

Environmental Sanitarian II

Bureau of Environmental Health, Well and Septic Program

8930 Stanford Blvd., Columbia, MD 21045

Phone: (410)313-2691

Email: rbricker@howardcountymd.gov

**CONFIDENTIALITY NOTICE**

This message and the accompanying documents are intended only for the use of the individual or entity to which they are addressed and may contain information that is privileged, confidential, or exempt from disclosure under applicable law. If the reader of this email is not the intended recipient, you are hereby notified that you are strictly prohibited from reading, disseminating, distributing, or copying this communication. If you have received this email in error, please notify the sender immediately and destroy the original transmission.

WELL DRILLERS.pdf
36K

 WATER WELL ABANDONMENT-SEALING REPORT FORM

SUBMIT COPIES OF COMPLETED FORM TO:

- * COUNTY ENVIRONMENTAL AGENCY (contact MDE, WMA if address needed)
- * WELL OWNER
- * MDE, WATER MANAGEMENT ADMINISTRATION, WELL PROGRAM

DATE WELL ABANDONED: 12-16-21 (month/day/year)

* PERMIT NUMBER OF ABANDONED WELL (if any)

Not a g
N/A

* PERMIT NUMBER OF REPLACEMENT WELL:


* PERSON ABANDONING WELL: Andrew Houseman WELL DRILLER'S LICENSE NUMBER: 224

CIRCLE: MWD / MSD / MGD

* OWNER'S NAME: Ching Wingshan

SITE LOCATION MAP

* WELL LOCATION:
 COUNTY: Howard
 NEAREST TOWN: Ellicott City
 TAX MAP 0031 BLOCK 0009 PARCEL 0540
 SUBDIVISION: Worthington Add
 SECTION: _____ LOT: 11
 STREET ADDRESS: 4842 Bonnie View Ct

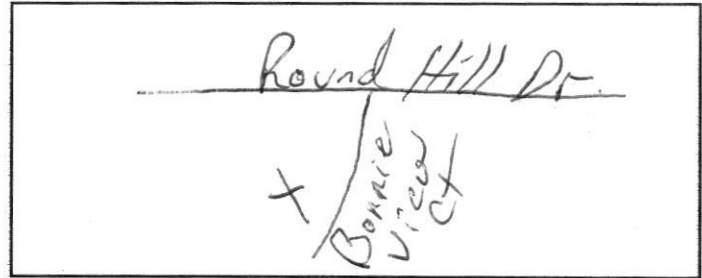

LATITUDE 39.236015

LONGITUDE 76.785668

LOG OF SEALING MATERIAL

* TYPE OF WELL BEING ABANDONED:
 DRILLED _____ JETTED
 _____ BORED _____ HAND DUG
 _____ OTHER (specify) _____

MATERIAL	FEET	
	FROM	TO
Bentonite	195	0
VOLUME OF MATERIAL USED		
Bentonite	1250	165

* USE CODE:
 DOMESTIC _____ MUNICIPAL/PUBLIC
 _____ IRRIGATION _____ INDUSTRIAL
 _____ TEST/OBSERVATION _____ GEOTHERMAL

* TYPE OF CASING:
 STEEL _____ PLASTIC
 _____ CONCRETE _____ OTHER (specify) _____

SIZE OF CASING: 6 INCHES IN DIAMETER

DEPTH OF WELL: 195 FEET DEEP

WAS ANY CASING REMOVED? YES NO
 If yes, length removed, in feet: _____

WAS CASING RIPPED OR PERFORATED? YES NO

SIGNATURE-MASTER WELL DRILLER OR SUPERVISING SANITARIAN LICENSE#

Andrew Houseman 224 MWD / MSD / MGS 12-16-21

CIRCLE ONE

DATE

Pursuant to § 10-624 of the State Govt. Article of the Maryland Code, personal info requested on this form is used in processing this form pursuant to COMAR 26.04.04. Failure to provide the info may result in this form not being processed. You have the right to inspect, amend, or correct this form. The Maryland Department of the Environment is subject to the Maryland Public Information Act. This form may be made available on the Internet via MDE's website and is subject to inspection or copying, in whole or in part, by the public and other governmental agencies, if not protected by federal or State Law.