


- Castle bar -

- Cal bridge -

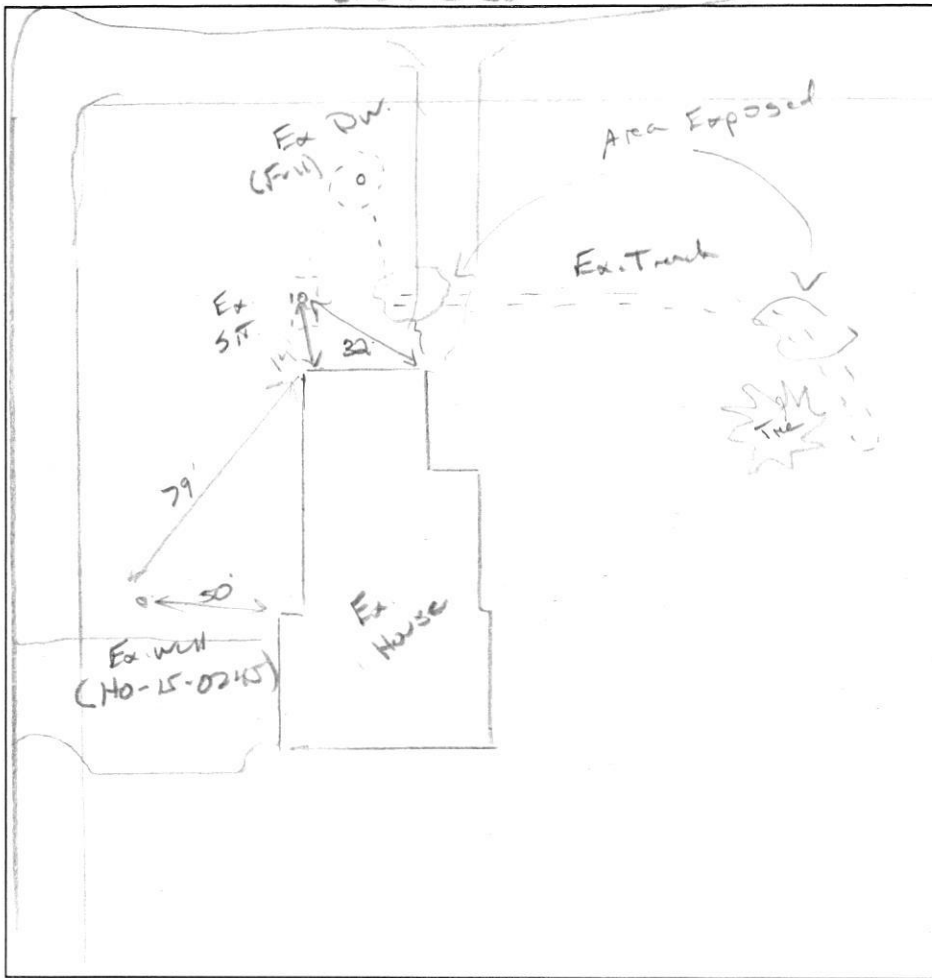

DATE	TEST #	DEPTH	START	BREAK 1" DROP	STOP 2" DROP	TIME OF 2ND INCH	P/F/H
1/4/21		No	Perce	Needed			
				(see memo)			

REMARKS Ex. DW. full to back off. new used.  
 SANITARIAN K. Wolf BACKHOE mike = Taylor OTHERS owner  
 TEST HOLES USED IN SDA 0 AVG. PERC TIME \_\_\_\_\_ SQ. FT/BR \_\_\_\_\_  
 TRENCH WIDTH \_\_\_\_\_ INLET DEPTH \_\_\_\_\_ MAX. BOT DEPTH \_\_\_\_\_ EFFECTIVE SW \_\_\_\_\_