

0113/69 approved by JWD

5/13/69

PERMIT

SEWAGE DISPOSAL SYSTEM

P 14379

A 09027

MARYLAND STATE DEPARTMENT OF HEALTH

HOWARD COUNTY

ELLICOTT CITY

INDEXED

DISTRICT 3

DATE 4/1/69

Paul O. Gregor IS PERMITTED TO INSTALL ALTER

ADDRESS Rt. 2, Box 47, Hanover, Md. PHONE 796-0962

A SEWAGE DISPOSAL SYSTEM LOCATED AT _____

SUBDIVISION Burnt Wood ROAD Celbridge Drive & Castlebar Drive LOT 12, Blk. D, Sec. 3, Pt. 1

PROPERTY OWNER Burnt Woods Development Co.

ADDRESS _____

SPECIFICATIONS - 3 bedrooms

DRAIN FIELD _____ DEPTH _____ FEET, BOTTOM AREA _____ SQ. FT.

SEEPAGE PITS _____ ABSORBENT SIDE-WALL AREA _____ SQ. FT.

SEPTIC TANK CAPACITY 750 GALLONS

FOR GARBAGE GRINDER, INCREASE DISPOSAL AREA 22% & TANK CAPACITY 50%.

OTHER Dry well - 100 sq. ft. sidewall area below inlet pipe per bedroom.

Place dry well about 65 ft. from left rear lot line and about 25 ft. from

front lot line. Lot lines determined as you face lot from Street "B".

ALL PIPE FROM HOUSE TO SEPTIC TANK MUST BE CAST IRON.

NOTE: PERMIT VOID AFTER THREE YEARS.


PLANS APPROVED BY R. D. Fletcher DATE 9/28/64

FILL SEPTIC TANK AND DISTRIBUTION BOX WITH WATER BEFORE CALLING FOR AN INSPECTION. COVER NO WORK UNTIL INSPECTED AND APPROVED.

NEITHER THE HOWARD COUNTY COMMISSIONERS NOR THE HEALTH DEPARTMENT IS RESPONSIBLE FOR THE SUCCESSFUL OPERATION OF ANY SYSTEM.

NOTIFY THE HEALTH DEPARTMENT 48 HOURS BEFORE EXCAVATIONS ARE TO BE BACK FILLED.

A 09027

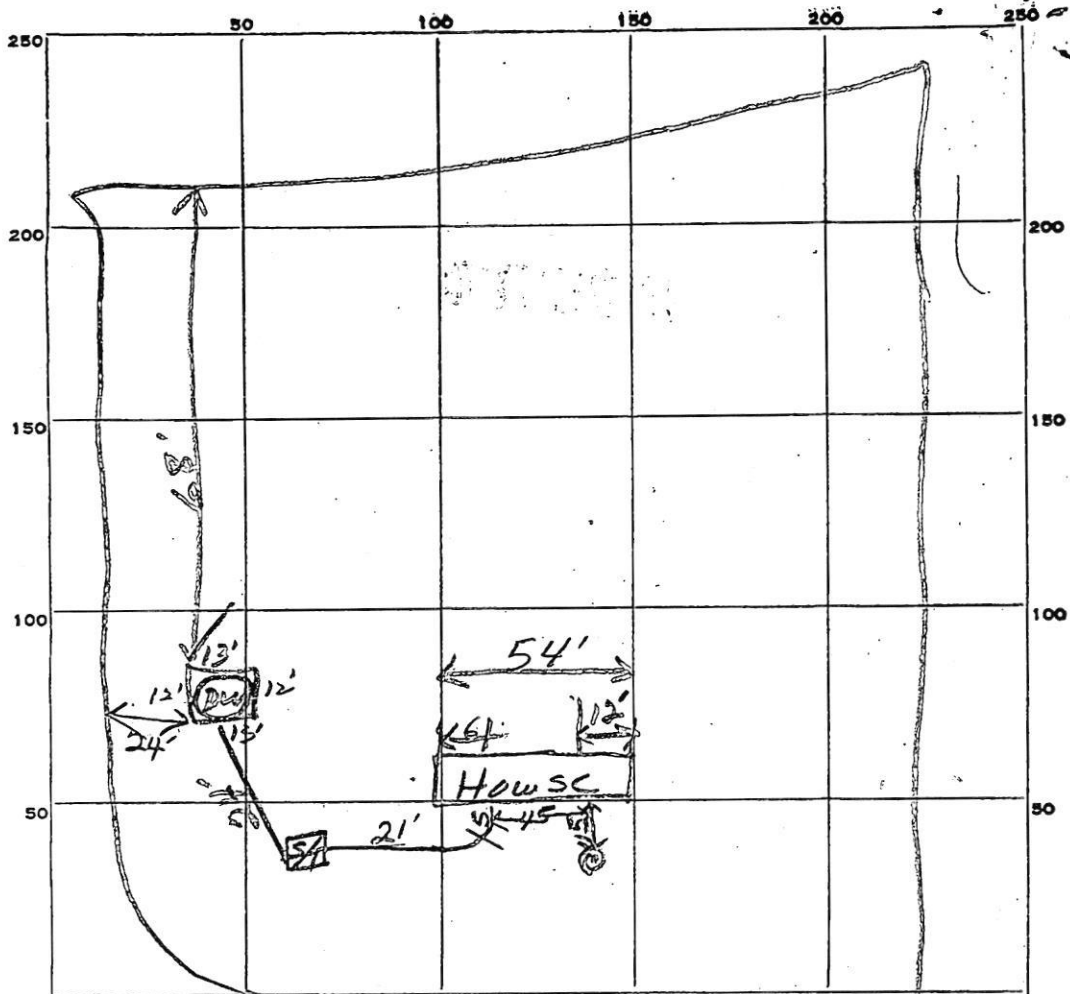

51
 34
 45
 90

INDICATE NORTH - NAME ADJOINING ROADWAY AS BASE LINE.

Celebridge Dr

PERMIT CARD OK

SEPTIC TANK, LEVEL OK 750 Cement

CLEANOUTS OK

DISTRIBUTION BOX, LEVEL _____

TILE FIELD, DEPTH _____ FT. TRENCH WIDTH _____ FT.

GRAVEL DEPTH _____ IN. TOTAL LENGTH _____ FT.

NUMBER OF TRENCHES _____ TOTAL BOTTOM AREA _____

SEEPAGE PITS, INSIDE DIAMETER 13 X 13 X 12 X 12 8 FT. DEPTH BELOW INLET 7 1/2 FT.

ABSORBENT AREA 450 SQ. FT.

REMARKS _____

DATE SYSTEM APPROVED 5/13/69

INSPECTOR [Signature]