
WATER WELL ABANDONMENT-SEALING REPORT FORM

SUBMIT COPIES OF COMPLETED FORM TO:

- * COUNTY ENVIRONMENTAL AGENCY (contact MDE, WMA if address needed)
- * WELL OWNER
- * MDE, WATER MANAGEMENT ADMINISTRATION, WELL PROGRAM

APPROVED
04/27/2020
(R)

DATE WELL ABANDONED: 10/31/2019 (month/day/year)

* PERMIT NUMBER OF ABANDONED WELL (if any) _____

* PERMIT NUMBER OF REPLACEMENT WELL: _____


* PERSON ABANDONING WELL: Edward Gross WELL DRILLER'S LICENSE NUMBER: MWD580

CIRCLE MWD / MSD / MGD

* OWNER'S NAME: Tracy Kukuselis

SITE LOCATION MAP

* WELL LOCATION:
 COUNTY: Howard County
 NEAREST TOWN: Mount Airy
 TAX MAP 7 BLOCK 3 PARCEL 473
 SUBDIVISION: 1002
 SECTION: _____ LOT: _____
 STREET ADDRESS: 116942 Frederick Road

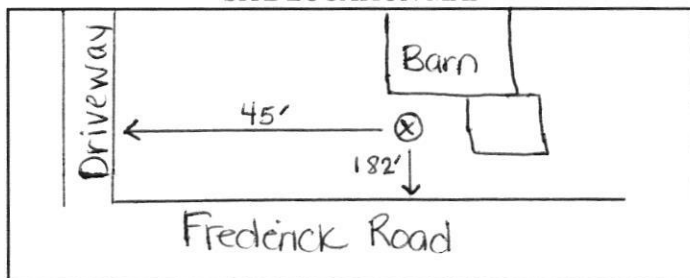

LATITUDE 39.345829

LONGITUDE 77.103155

LOG OF SEALING MATERIAL

* TYPE OF WELL BEING ABANDONED:
 DRILLED _____ JETTED
 _____ BORED _____ HAND DUG
 _____ OTHER (specify) _____

MATERIAL	FEET	
	FROM	TO
Bentonite	0'	60'

* USE CODE:
 DOMESTIC _____ MUNICIPAL/PUBLIC
 _____ IRRIGATION _____ INDUSTRIAL
 _____ TEST/OBSERVATION _____ GEOTHERMAL

VOLUME OF MATERIAL USED
7 bags - 350 lbs / 168 gallons

* TYPE OF CASING:
 STEEL _____ PLASTIC
 _____ CONCRETE _____ OTHER (specify) _____

SIZE OF CASING: 6 INCHES IN DIAMETER

DEPTH OF WELL: 60 FEET DEEP

WAS ANY CASING REMOVED? _____ YES NO
 If yes, length removed, in feet: _____

WAS CASING RIPPED OR PERFORATED? _____ YES NO

[Signature]
 SIGNATURE-MASTER WELL DRILLER OR SUPERVISING SANITARIAN LICENSE# MWD580

MWD / MSD / MGS
 CIRCLE ONE

10/31/2019
 DATE

Pursuant to § 10-624 of the State Govt. Article of the Maryland Code, personal info requested on this form is used in processing this form pursuant to COMAR 26.04.04. Failure to provide the info may result in this form not being processed. You have the right to inspect, amend, or correct this form. The Maryland Department of the Environment is subject to the Maryland Public Information Act. This form may be made available on the Internet via MDE's website and is subject to inspection or copying, in whole or in part, by the public and other governmental agencies, if not protected by federal or State Law.

Burgan, Inc.

640 Klee Mill Road
Westminster, MD 21157

Phone... 410-259-8924
Fax # 410-795-2225
burganinc@comcast.net

Invoice

Bill To

Date	Invoice #
1/2/2020	3651

Description	Amount
Pull well pump to replace pitless adaptor. Dig down to pitless and replace pitless adaptor, new male adaptor, and coupling back together. Set well pump back in place. Sanitize well. replace dirt back over pipe	800.00
Total	\$800.00