



HOWARD COUNTY HEALTH DEPARTMENT

.59820

11/1/16 DATE

410 AS

Received From

Stevens Builders LLC

PHONE #

531-2100

For

Peric App / 13942 Hallowell Ct.

CASH

CHECK

NO.

1158

Five hundred six


Dollars

\$

506 | 00

Received By

J King

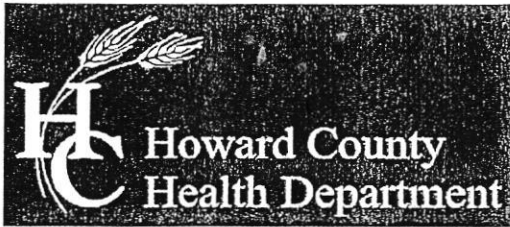

Bureau of Environmental Health

8930 Stanford Boulevard, Columbia, MD 21045

Main: 410-313-2640 | Fax: 410-313-2648

TDD 410-313-2323 | Toll Free 1-866-313-6300

www.hchealth.org

Facebook: www.facebook.com/hocohealth

Twitter: HowardCoHealthDep

Maura J. Rossman, M.D., Health Officer

APPLICATION

FOR PERCOLATION TESTING AND SITE EVALUATION

A559820

PROPERTY LOCATION

SUBDIVISION/PROPERTY NAME

PROPERTY ADDRESS

13942 Hallowell Court Dsyke MD 21036

TAX ACCOUNT #

TAX MAP

GRID

PARCEL

LOT NO.

PROPOSED LOT SIZE (ACRES)

ZONING CATEGORY

TIER

PROPERTY OWNER(S)

Sarah Eichhorn

DAYTIME PHONE

CELL 301-741-2852

EMAIL

SKEICHORN2@verizon.net

MAILING ADDRESS

same as above

APPLICANT

Stevens Builders

RELATIONSHIP TO OWNER:

Builder

DAYTIME PHONE

410-531-0575

CELL

EMAIL

ronswecker3411@comcast.net

MAILING ADDRESS

4829 Ten Oaks Rd Dsyke MD

21035

I HEREBY APPLY FOR THE NECESSARY TESTING/EVALUATION PRIOR TO ISSUANCE OF SEWAGE DISPOSAL SYSTEM PERMIT(S):

PROPERTY:

- Subdivision: Number of lots including residue:
Subdivision classification (per dept. of planning and zoning)
Construct new OSDS on undeveloped lot
Repair or replace failing OSDS
Upgrade existing OSDS

confirm soil buffer

BUILDING:

- Residential with 3 existing or proposed bedrooms in the completed structure
Commercial (provide detail of type of use and numbers of employees/customers on accompanying plan)

IS THE PROPERTY WITHIN 2500 FEET OF ANY RESERVOIR?

- Yes
No

AS APPLICANT, I UNDERSTAND THE FOLLOWING:

- This application is valid for two(2) years from date of fee payment and approval is based upon health officer signature of a perc certification plan prior to expiration of this permit.
The application fee is non-refundable
This application must be accompanied by all applicable fees and a suitable site plan in order to be processed
This is a public document

I declare and affirm that to the best of my knowledge, the information contained herein is correct. I declare that I am the owner of the property or duly authorized to make this application on behalf of the owner. I agree to comply with all applicable state and county regulations.

By signature of this application, I hereby grant Howard County Health Department officials the right to enter onto the property for the purpose of inspecting the property as directly related to the requested permit/service.

Signature of applicant

11-1-15

SIGNATURE OF APPLICANT

DATE

A559820

A/P _____

TEST HOLE

2.5' — Br cl

Tan fsl w/ mica

14' — dry



13942 Hollowell Ct

DATE	TEST #	DEPTH	START	BREAK 1" DROP	STOP 2" DROP	TIME OF 2ND INCH	P/F/H

HOLLOWELL CT

REMARKS Conduct test to establish 4' buffer

SANITARIAN H. Oswald BACKHOE Hatfields OTHERS _____

TEST HOLES USED IN SDA _____ AVG. PERC TIME _____ SQ. FT/BR _____

TRENCH WIDTH _____ INLET DEPTH _____ MAX. BOT DEPTH _____ EFFECTIVE SW _____

B16004447

Oswald, Hank

From: Oswald, Hank
Sent: Monday, October 24, 2016 11:53 AM
To: PHILIP@STEVENSBUILDERS.COM
Subject: B16004447_Addition
Attachments: Percolation Test Application.pdf

Philip Steven:

Based on the floor plans submitted for this project, this office has concluded that the septic system is adequately sized for the existing plus proposed # of bedrooms. However, the septic record does not contain sufficient percolation data to prove that each trench has a 4 foot buffer of good soil underneath them.

In order to determine this buffer requirement, a perc test hole will need to be excavated near the system using a backhoe capable of digging a hole to 13.5 feet (Trench Depth 9 - 9.5 Feet). Once this has been verified, this office can sign-off on the building permit.

Next step, submit a perc test application (attached) plus fee and schedule a time to dig the hole.

Should you have any questions, please don't hesitate to ask.

Respectfully,

Hank

Hank Oswald, L.E.H.S.
Howard County Health Department
Bureau of Environmental Health
Well & Septic Program
8930 Stanford Boulevard
Columbia, MD 21045
410.313.1786 (Office)
410.313.2648 (Fax)