

\*\*\*\*\*  
 WATER WELL ABANDONMENT-SEALING REPORT FORM  
 \*\*\*\*\*

SUBMIT COPIES OF COMPLETED FORM TO:

- \* COUNTY ENVIRONMENT AGENCY (contact MDE, WMA if address needed)
- \* WELL OWNER
- \* MDE, WATER MANAGEMENT ADMINISTRATION, WELL PROGRAM

DATE WELL ABANDONED: 3/25/08 (month/day/year)

\* PERMIT NUMBER OF ABANDONED WELL (if any) N/A

\* PERMIT NUMBER OF REPLACEMENT WELL \_\_\_\_\_


\* PERSON ABANDONING WELL: Self

WELL DRILLERS LICENSE NUMBER: \_\_\_\_\_

CIRCLE: MWD/MSD/MGD

\* OWNER'S NAME: Marcia Lopez

\* WELL LOCATION:  
 COUNTY: Howard  
 NEAREST TOWN: North  
 TAX MAP \_\_\_\_\_ BLOCK 11036 PARCEL 143  
 SUBDIVISION: \_\_\_\_\_  
 SECTION: \_\_\_\_\_ LOT: 6  
 NEAREST ROAD: Harding Rd

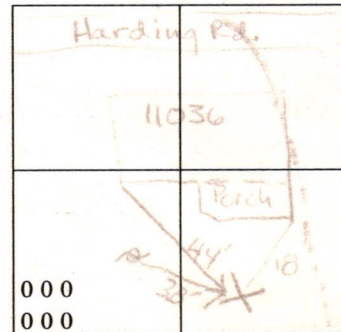

SHOW WELL LOCATION BY X WITHIN BOX

MARYLAND GRID COORDINATES

BOX NUMBER E \_\_\_\_\_  
 N \_\_\_\_\_

\* TYPE OF WELL BEING ABANDONED:

- DRILLED
- BORED/AUGURED
- OTHER (specify) \_\_\_\_\_
- JETTED
- HAND DUG

LOG OF SEALING MATERIAL

MATERIAL	FEET	
	FROM	TO
Sand/gravel	5	60
concrete	2	5
SOIL	0	2

\* USE CODE:

- DOMESTIC
- IRRIGATION
- TEST/OBSERVATION
- MUNICIPAL/PUBLIC
- INDUSTRIAL

\* TYPE OF CASING:

- STEEL
- CONCRETE
- PLASTIC
- OTHER (specify) soil

\* SIZE OF CASING: 30 INCHES IN DIAMETER

\* DEPTH OF WELL: 60 FEET DEEP

\* WAS ANY CASING REMOVED?  YES  NO  
 if yes, length removed, in feet: \_\_\_\_\_

WAS CASING RIPPED OR PERFORATED?  YES  NO

IGNATURE-MASTER WELL DRILLER OR SUPERVISING SANITARIAN Robert Bueler R.S.

LICENSE # 001409

MWD/MSD/MGD CIRCLE ONE

DATE 3/25/08



March 25, 2008

To Whom It May Concern,

Acting as the contractor for the abandonment of my previous well, I contracted the labor to redig and seal with cement and soil five feet deep.

A handwritten signature in cursive script, appearing to read "Marsha Engel".

Marsha Engel

11036 Harding Road

Laurel, MD 20723

301-776-9044