

Record Detail * (This section is required.)

Permit Type	Permit Number	Opened Date
Building/Residential/Misc/Deck	B21003778	10/05/2021

Description of Work
 SFD/ REMOVE EXISTING DECK AND CONSTRUCT A 30' X 16' DECK WITH 5' X 4' LANDING WITH STEPS TO GRADE

[check spelling](#)

Address * (This section is required.)

Search Reset Clear Get Parcel & Owner

Street #	Street Name	Street Type
14613	MUSTANG	PATH
Unit Type	Unit #	X Coordinate
--Select--		-77.01464
		Y Coordinate
		39.27744
City	State	Zip Code
GLENWOOD	MD	21738
	Primary	
	Yes	

Parcel * (This section is required.)

Search Reset Clear Get Address & Owner

GIS ID *	Parcel	Parcel Area	Land Value	Improved Value	Exemption Value	Plan Area
898089	179	2.8	248000	0	268400	RURAL
Legal Description						
IMPVLOT 30 2.8031 AR S 1[]14613 MUSTANG PATH[]GLENWOOD ESTATES						

[check spelling](#)

Block	Lot	Census Tract	Council Dist	Inspection Dist	Supervisor Dist	Map #	DAP Zone
	30	605601	5				
Plan Area	State Tax Id	Subdivision Name					
	1404335643	GLENWOOD ESTATES					
Section	Area	Tax Map					
		21					
Grid	Zoning District	ADC Map					
21-5	RR-DEO	4812-H6					
SDP No.	Final Plan No.	WP File No.					
Record Plat No.	WS Contract No.	FDP No.	Primary				
3496			Yes				
Owner Occupied	Year Built	Historic District					
<input type="radio"/> Yes <input checked="" type="radio"/> No	1986	<input type="radio"/> Yes <input checked="" type="radio"/> No					
Historic District Registry No.	Stat Area	Flood Plain					
	4-09	<input type="radio"/> Yes <input checked="" type="radio"/> No					
Building No							

Owner * (This section is required.)

Search Reset Clear

Name *

ROSS BETTY L

Address Line 1

14613 Mustang

Address Line 2

Address Line 3

Mail City	Mail State	Mail Zip Code
GLENWOOD	MD	21738
Phone	Primary	
4109694444	Yes	
E-mail		
PERMITS@FENCEDECKCONNECT.COM		
Cell Number	Fax Number	

Professionals (This section is not required.)

Search Reset Clear

License # * 08050045780
 License Type * MHIC Co
 Primary Yes

Business Name FENCE & DECK CONNECTION

First Name JAMES Middle Name W Last Name RUBUSH

Address Line 1 8057 VETERANS HIGHWAY
 Address Line 2

City MILLERSVILLE State MD ZIP Code 21108 000

Phone 1 4109694444 Phone 2 Fax 4109694448

E-mail PERMITS@FENCEDECKCONNECT.COM

Applicant (This section is not required.)

Search As Owner As Lic. Prof As Contact

Type * Applicant

Relationship Applicant

Primary Yes

First Name JOSH MI Last Name SIMPSON

Full Name JOSH SIMPSON

Organization Name FENCE & DECK CONNECTION

Street Address 8057 VETERANS HIGHWAY
 Address Line 2

City MILLERSVILLE State MD Zip Code 21108

Phone 410-969-4444 Cell Fax

E-mail * permits@fencedeckconnect.com

Addtl Info

Est Construction Cost * 41000

Housing Units * 0

Number of Buildings * 0

Public Owned No

Construction Type -Select-

MISC PERMIT INFO

MISCELLANEOUS PERMIT INFORMATION

Capital Project-No Fee * Yes No

Capital Project Number

Fee Exempt * Yes No

Roadside Tree Project Permit * Yes No

Roadside Tree Project Permit #

Existing Use * SFD

Water Private Sewage Private Expiration Date 4/3/2022

PAYMENT INFORMATION

Check 1 Payee 1 Check 2 Payee 2 SAP Doc No SAP Entered


Submit Cancel

CONSUMER INFORMATION NOTES:

1. This plan is a benefit to a consumer insofar as it is required by a lender or a title insurance company or its agent in connection with contemplated transfer, financing or re-financing.
2. This plan is not to be relied upon for the establishment or location of fences, garages, buildings, or other existing or future improvements.
3. This plan does not provide for the accurate identification of property boundary lines, but such identification may not be required for the transfer of title or securing financing or re-financing.
4. Building line and/or Flood Zone information is taken from available sources and is subject to interpretation of originator.
5. No Title Report furnished.


Notes:

1. Setback distances as shown to the principal structure from property lines are approximate. the level of accuracy for this drawing should be taken to be no greater than plus or minus 2 feet.
2. Fences have been located by approximate methods.

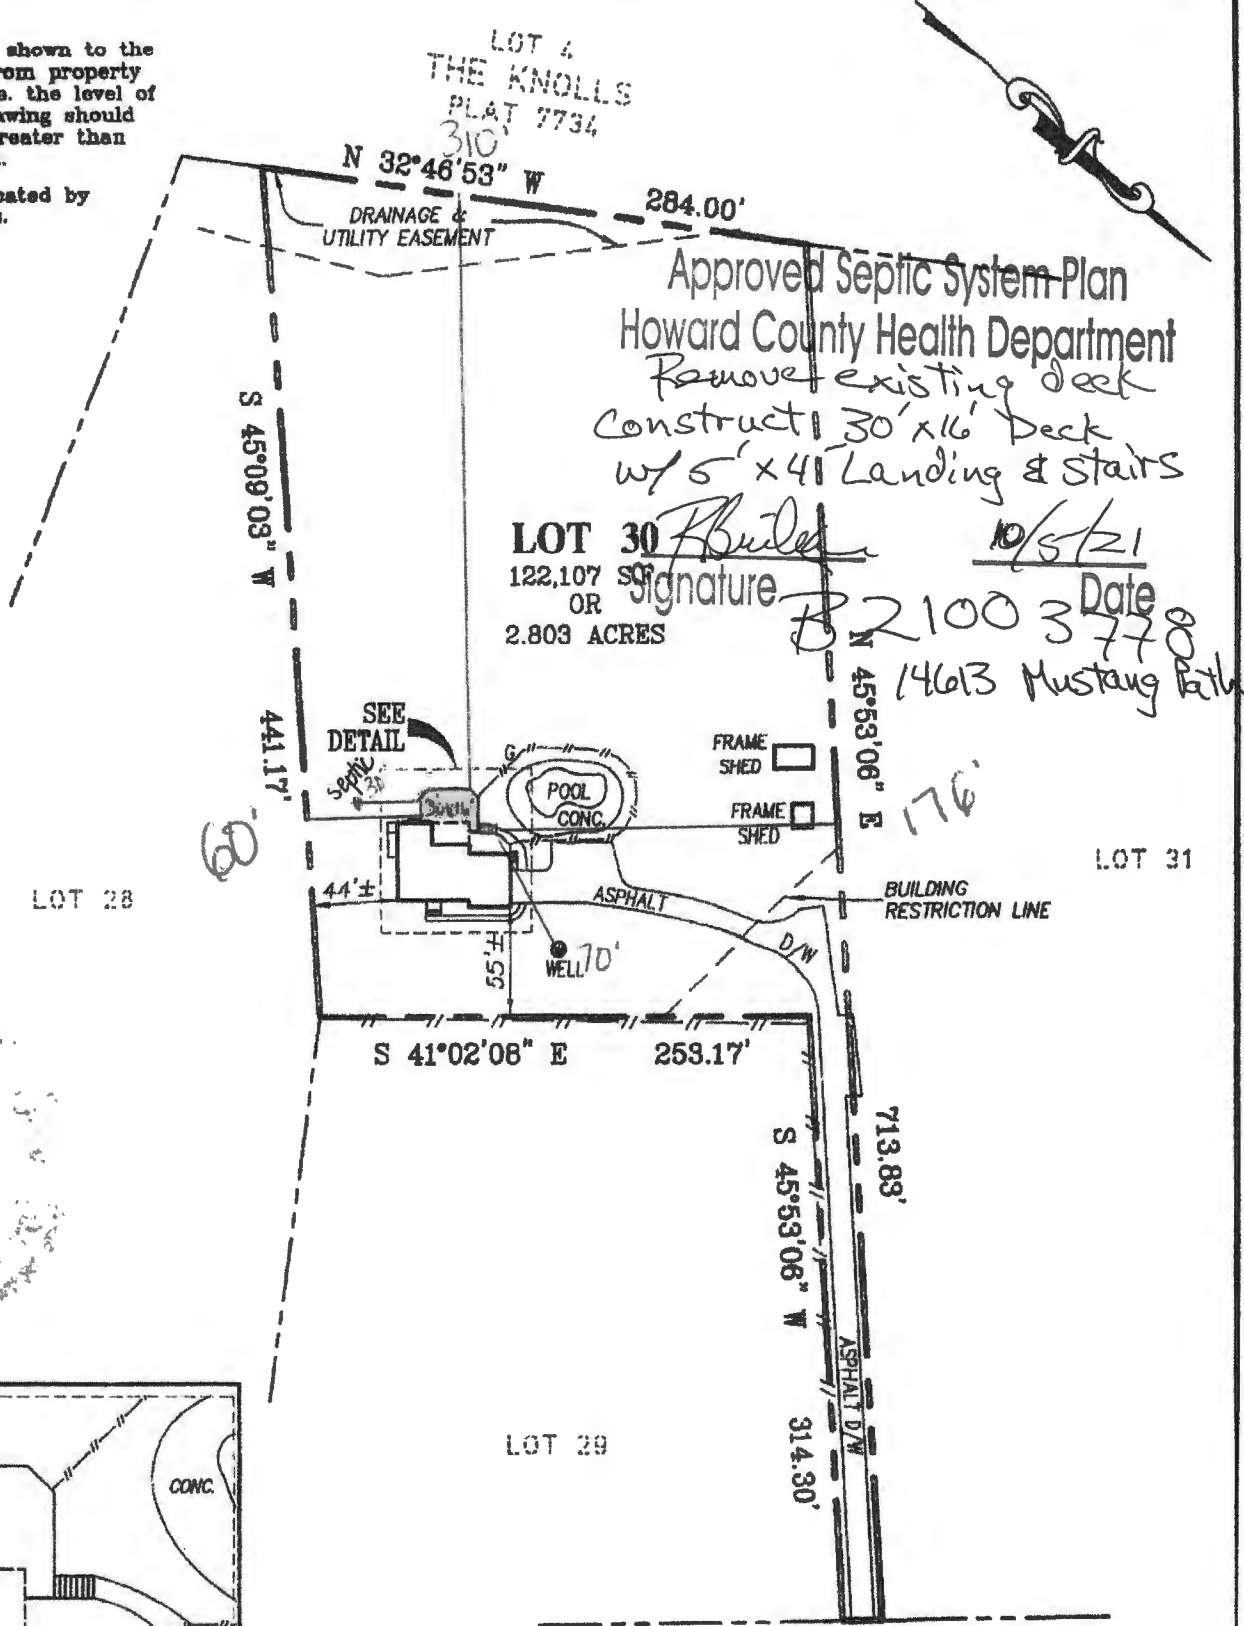

Approved Septic System Plan
 Howard County Health Department
 Remove existing deck
 Construct 30' x 16' Deck
 w/ 5' x 4' Landing & stairs

LOT 30 *Butler* 10/5/21
 122,107 SQ FT
 OR Signature *[Signature]* Date 10/5/21
 2.803 ACRES *B 21003778*
14613 Mustang Path

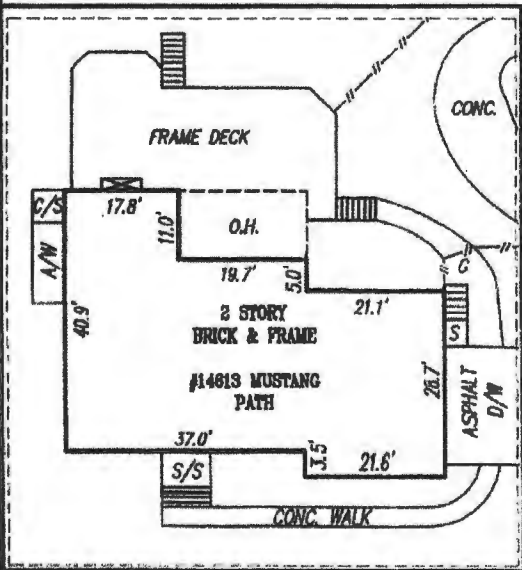

DETAIL SCALE: 1" = 30'

S 42°07'12" E 20.0'
MUSTANG PATH
 (50' R/W)
 LOCATION DRAWING
 LOT 30
 SECTION ONE
GLENWOOD ESTATES
 HOWARD COUNTY, MARYLAND

<p>SURVEYOR'S CERTIFICATE</p> <p>THE INFORMATION SHOWN HEREON HAS BEEN BASED UPON THE RESULTS OF A FIELD INSPECTION PURSUANT TO THE DEED OR PLAT OF RECORD. EXISTING STRUCTURES SHOWN HAVE BEEN FIELD LOCATED BASED UPON MEASUREMENTS FROM PROPERTY MARKERS FOUND OR FROM EVIDENCE OF LINES OF APPARENT OCCUPATION.</p> <p><i>Kathleen Butler</i></p> <p>MARYLAND PROPERTY LINE SURVEYOR REG. NO. 592 Expires: 04-07-2021</p>	<p>REFERENCES</p> <p>PLAT BK. PLAT NO. 3498</p>	<p>SNIDER & ASSOCIATES LAND SURVEYORS 19544 Amaranth Drive Germantown, Maryland 20874 301/948-5100 Fax 301/948-1298 WWW.SNIDERSURVEYS.COM</p>
	<p>LIBER FOLIO</p>	