

Record Detail * (This section is required.)

Permit Type	Permit Number	Opened Date
Building/Residential/Misc/Porch	B21003744	10/03/2021

Description of Work
 SFD/ CONSTRUCT A 41' X 14' OPEN DECK WITH A 20' X 14' SCREEN ROOM WITH A GABLE STYLE ROOF INSIDE THAT FOOTPRINT. THERE IS ALSO A 9 X 10 OPEN WOOD DECK ADJOINING THE 41 X 14 OPEN DECK WITH STEPS TO GRADE. REMOVE EXISTING DECK.

[check spelling](#)

Address * (This section is required.)

Search Reset Clear Get Parcel & Owner

Street #	Street Name	Street Type
11322	BARLEY FIELD	WAY
Unit Type	Unit #	X Coordinate Y Coordinate
--Select--		-76.90639 39.33015
City	State	Zip Code Primary
MARRIOTTSVILLE	MD	21104 Yes

Parcel * (This section is required.)

Search Reset Clear Get Address & Owner

GIS ID *	Parcel	Parcel Area	Land Value	Improved Value	Exemption Value	Plan Area
908052	27	1.15	246900	658200	411300	RURAL

Legal Description
 IMPSLOT 40 1.15 A[]11322 BARLEY FIELD WAY[]WOODFORDS GRANT RSB LOTS

[check spelling](#)

Block	Lot	Census Tract	Council Dist	Inspection Dist	Supervisor Dist	Map #	DAP Zone
9999	40	603000	5				
Plan Area	State Tax Id	Subdivision Name					
	1403322475						
Section	Area	Tax Map					
		10					
Grid	Zoning District	ADC Map					
10-15	RC-DEO	4694-E8					
SDP No.	Final Plan No.	WP File No.					
Record Plat No.	WS Contract No.	FDP No.	Primary				
13113			Yes				
Owner Occupied	Year Built	Historic District					
<input type="radio"/> Yes <input type="radio"/> No	1999	<input type="radio"/> Yes <input checked="" type="radio"/> No					
Historic District Registry No.	Stat Area	Flood Plain					
	3-02A	<input type="radio"/> Yes <input checked="" type="radio"/> No					
Building No							

Owner * (This section is required.)

Search Reset Clear

Name *
 LINDQUIST MARY

Address Line 1
 11322 BARLEY FIELD WAY

Address Line 2

Address Line 3

Mail City	Mail State	Mail Zip Code
MARRIOTTSVILLE	MD	21104
Phone	Primary	
443-896-4724	Yes	
E-mail		

Cell Number _____ Fax Number _____

Professionals (This section is not required.)

Search Reset Clear

License # * Business Name
08050009615-01 LONG FENCE COMPANY INCORPORATED

License Type * First Name Middle Name Last Name
MHIC Co ✓ MICHAEL J RITTER

Primary Address Line 1
Yes ✓ 1910 BETSON COURT
Address Line 2

City State ZIP Code
ODENTON MD 21113-1124

Phone 1 Phone 2 Fax
3013502400 3013360743

E-mail
BLRITTER@LONGFENCE.COM

Applicant (This section is not required.)

Search As Owner As Lic. Prof As Contact

Type * First Name MI Last Name
Applicant ✓ STEVE BOWERS

Relationship Full Name
Applicant ✓ STEVE BOWERS

Primary Organization Name
Yes ✓ APPLICANT

Street Address
7 HAYMARKET CRT
Address Line 2

City State Zip Code
BALTIMORE MD 21236

Phone Cell Fax
410-227-9843 410-227-9843

E-mail *
MRDECKSM@HOTMAIL.COM

Addtl Info

Est Construction Cost * Housing Units * Number of Buildings * Public Owned
81000 0 0 No ✓

Construction Type
434 - Additions, Alterations and Conversions - Residential ✓

PORCH INFORMATION

PORCH INFORMATION

Capital Project-No Fee * Capital Project Number Fee Exempt * Roadside Tree Project Permit * Roadside Tree Project Permit #
 Yes No _____ Yes No Yes No _____

Existing Use * Type of Porch * Type of Porch Foundation * Total Square Footage *
SFD ✓ Open and Screened Por ✓ New Deck ✓ 280 SQFT

Water Supply Sewage Disposal Expiration Date
Private ✓ Private ✓ 4/2/2022

PAYMENT INFORMATION

Check 1 Payee 1 Check 2 Payee 2 SAP Doc No SAP Entered


Submit Cancel

Date: August 20, 2021 at 3:00 PM
To: Steve Pyne hedgeleigh@comcast.net

11322 BARLEY FIELD WAY
MARRIOTTSVILLE MD
21104


1" = 40'

Approved Septic System Plan
Howard County Health Department
w/ 41" x 14" deck
4 steps and 79" x 10" deck
20" x 14" screen room

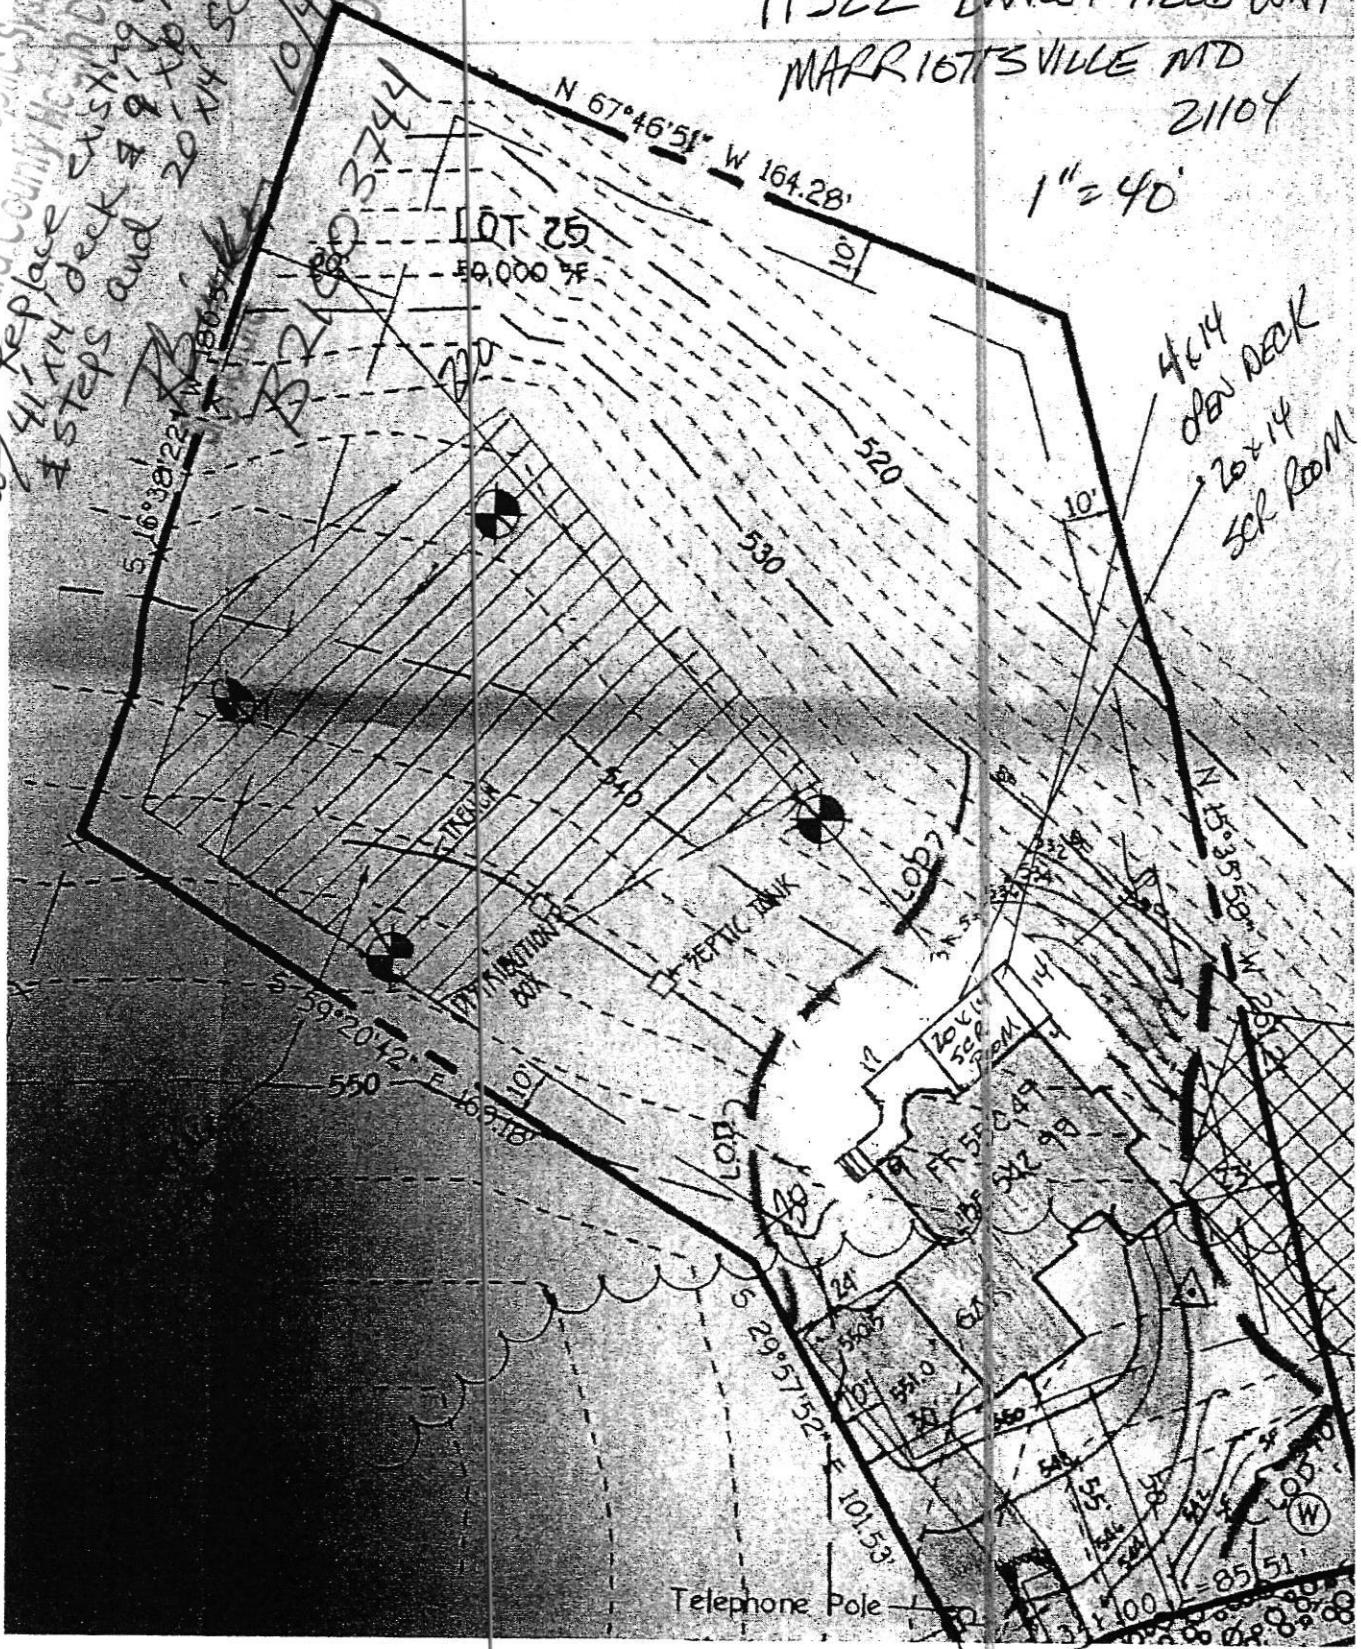

B21003744
1322 Barley Field Way
proposed deck
sheet 1 of 2

WORK ORDER

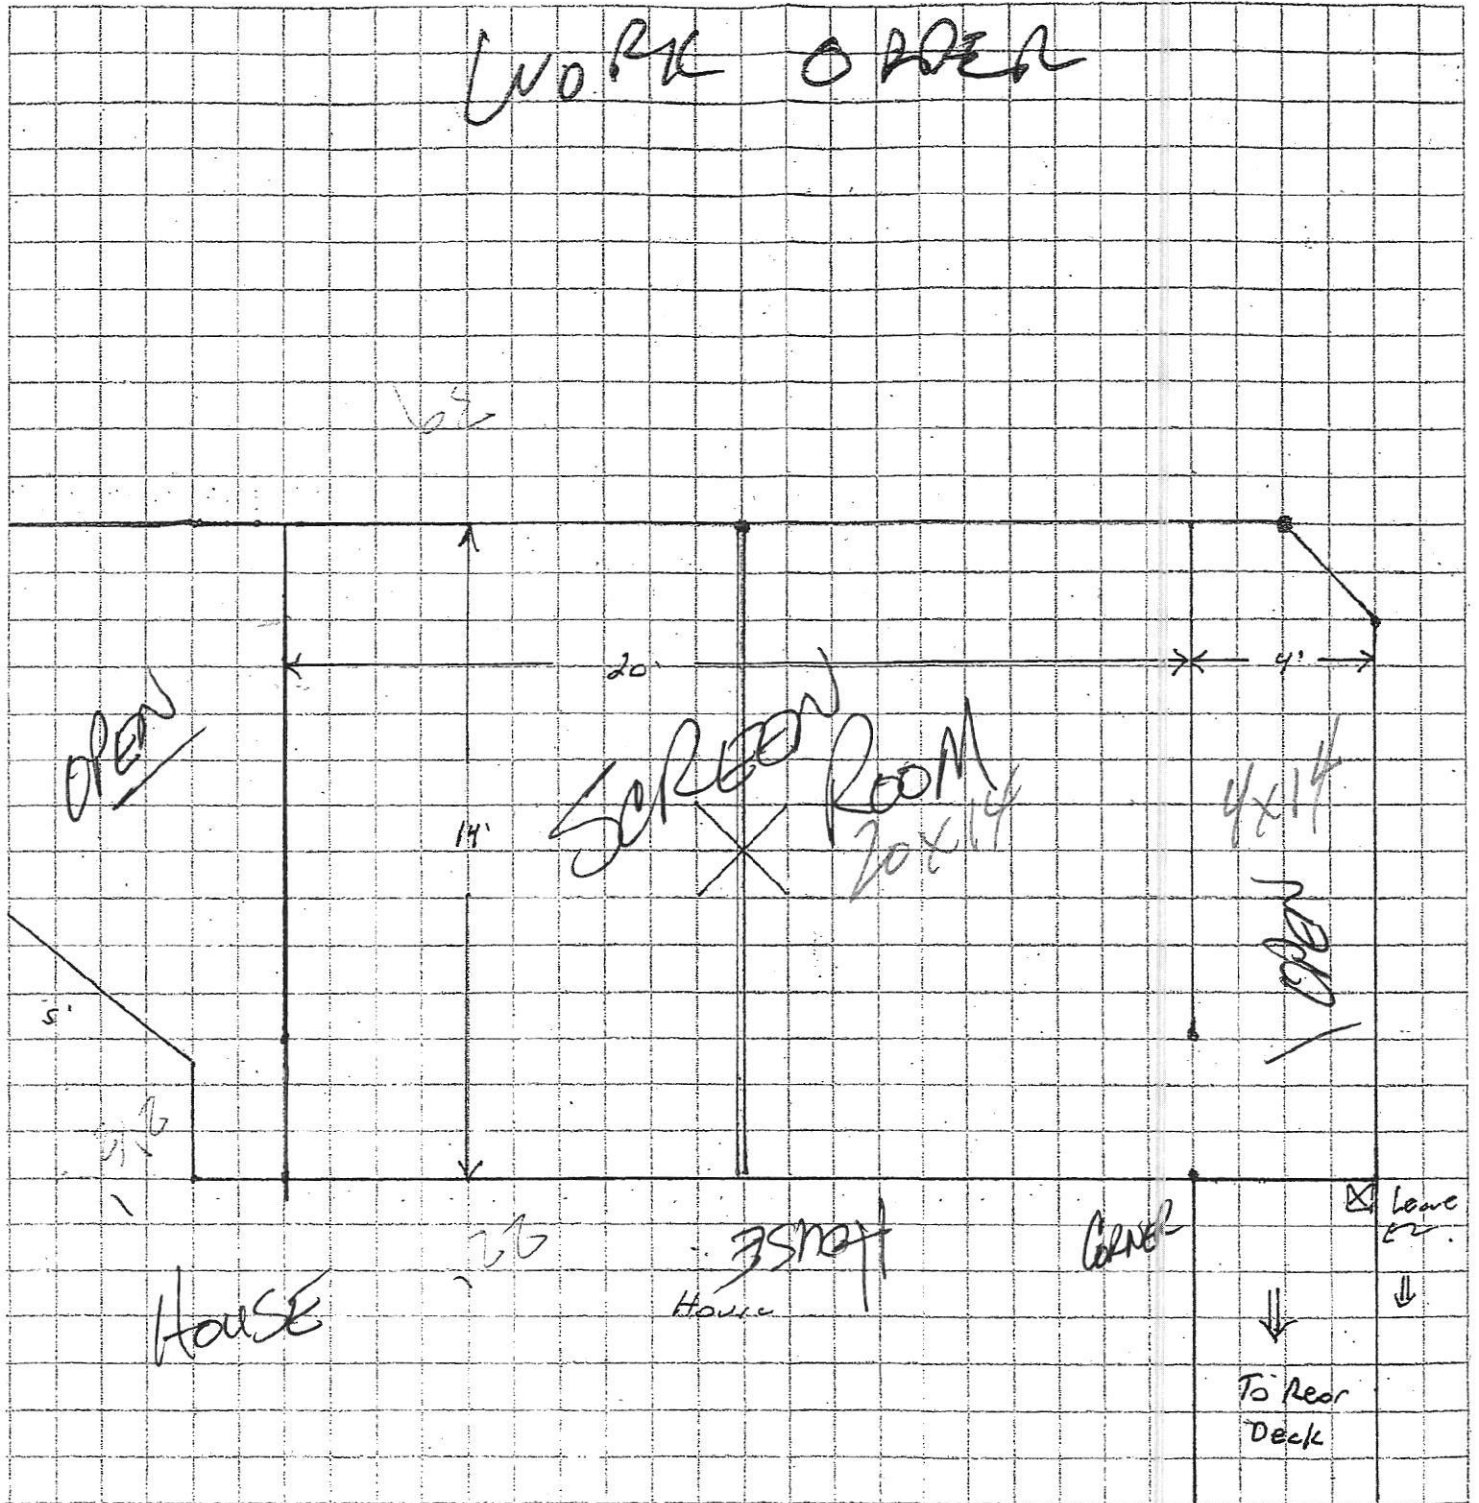

B 21003744
11322 Barley Field Way
proposed deck
Sheet 2 of 2

