

COMPLETE THIS FORM WHEN DROPPING OFF ANY CORRESPONDENCE AND/OR PLANS TO THE HOWARD COUNTY DEPARTMENT OF INSPECTIONS, LICENSES AND PERMITS COUNTER:

Date: 0/14/2021

To: DAN SWINDER, PLAN REVIEW
(Person's Name and Division) **Health**

From: _____
(Your Name, Company Name and Telephone Number)

Subject: Project name WINE BRENNAR RESIDENCE
Project site address 2891 ORDWAY DR
Permit # B21001757 SDP # _____
Other information pertinent to this project _____

- Please check the attachments below that you are submitting with this transmittal:
- Letter of response to address plan review comment letter
 - Revised plans and/or revised details: When submitting for a complete re-review, duplicate sets shall be submitted.
 - Letter Summarizing Changes
 - Energy conservation calculations
 - Copies of _____ (be specific).
 - _____ Health Department Request _____ DPZ/ DED Request _____ Applicant's Request
 - Two sets of single family dwelling model plans to be placed on permanent file: Model name and/or # _____
 - Other PERMIT APP W/ PORCH INFO

Contact Person Information: (Required)

Please Print Name


Telephone No:

E-Mail Address:


PLEASE ASSURE ALL DOCUMENTS AND/OR REVISIONS ARE APPROPRIATELY SIGNED AND SEALED, IF NECESSARY, BY A LICENSED ARCHITECT OR ENGINEER. PLEASE BE ADVISED THAT INSUFFICIENT INFORMATION MAY RESULT IN THE DELAY OF REVIEW BY THE PLANS EXAMINER. THE DEPARTMENT OF INSPECTIONS, LICENSES AND PERMITS WILL CONTACT YOU IF THERE IS A PROBLEM. IN ADDITION, ONCE THE BUILDING PERMIT IS APPROVED BY THE PLAN REVIEW DIVISION AND ALL OTHER REQUIRED SIGNATORY AGENCIES, AND THE BUILDING PERMIT IS READY FOR ISSUANCE, THE PERMIT DIVISION WILL NOTIFY THE APPROPRIATE CONTACT PERSON FOR PERMIT PICK UP. ALL PERMIT STATUS INQUIRIES SHALL BE DIRECTED TO THE PERMIT DIVISION AT 410-313-2455. CODE RELATED QUESTIONS AND PLAN REVIEW INQUIRIES SHALL BE DIRECTED TO THE PLAN REVIEW DIVISION AT 410-313-2436. PLEASE ALLOW A MINIMUM OF FIVE (5) WORKING DAYS FOR ANY PLAN SUBMITTALS TO BE REVIEWED. THANK YOU.

Received by DROPPOT INV # 009544 RECEIVED
CK# 1193 JUN 14 2021
White-Plan Review / Yellow-Applicant / Pink-Permit Division
t:\Operations\Updated forms\transmit.frm - Rev. 04/2014
copy to Health LICENSES & PERMITS DIVISION

HOUSE DETAIL
SCALE 1"=30'

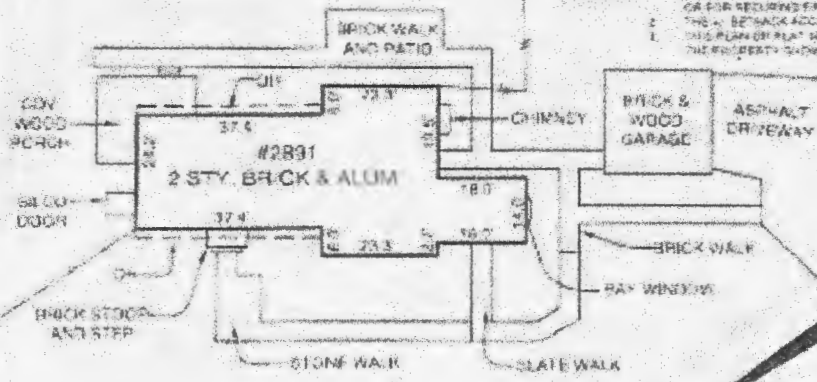

NOTES:
1. THIS PLAN IS A SERVICE TO THE CONSUMER ONLY INsofar as it is required by a LENDER OR A TITLE INSURANCE COMPANY OR ITS AGENTS IN CONNECTION WITH A CONTEMPLATED TRANSFER, FINANCING OR REFINANCING PURPOSES. THIS PLAN IS NOT TO BE RELIED UPON FOR THE ESTABLISHMENT OF LOCATION OF FENCES, GARAGES, BUILDINGS OR OTHER EXISTING OR FUTURE STRUCTURES. THIS PLAN DOES NOT PROVIDE FOR THE ACCURATE IDENTIFICATION OF PROPERTY BOUNDARY LINES BUT SUCH IDENTIFICATION MAY NOT BE REQUIRED FOR THE TRANSFER OF TITLE OR FOR RECORDING FINANCING OR REFINANCING.
2. THIS IS A "BEST PRACTICE" ACCURACY IS 1/8" FOOT.
3. THIS PLAN OR PLAT IS NOT INTENDED TO SHOW ALL MATERIALS RELATED TO THE PROPERTY SHOWN HEREON.

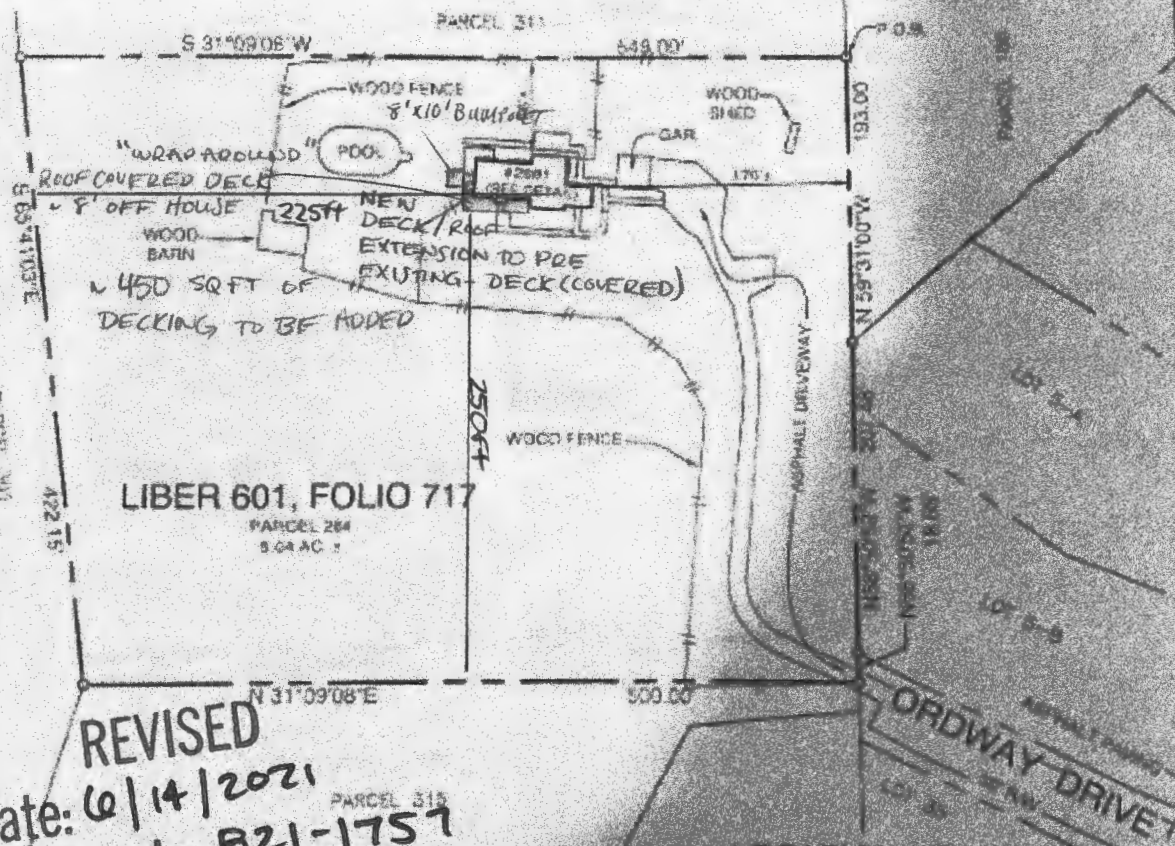

REVISED
Date: 6/14/2021
Comments: **B21-1757**

LOCATION DRAWING
2891 ORDWAY DRIVE
TAX MAP 16, PARCEL 284
LIBER 601, FOLIO 717
ELECTION DISTRICT NO. 3
HOWARD COUNTY, MARYLAND

NOTES CONTINUED:
1. CEDS PLOTTING ONLY.
2. A BOUNDARY SURVEY IS REQUIRED TO DETERMINE AN ACCURATE LOCATION OF FENCES AND DRIVEWAY.

THIS LOT DOES NOT APPEAR TO BE WITHIN THE 100 YEAR FLOOD PLAIN AS SHOWN ON THE F.E.M.A. FLOOD HAZARD MAP 24027C-0079-D AS REVISED NOVEMBER 6, 2013.

CERTIFICATION
I HEREBY CERTIFY THAT I AM A LICENSED PROFESSIONAL SURVEYOR AND THAT I HAVE PERSONALLY CONDUCTED THE SURVEY WORK AND THAT THE SURVEY WORK IS IN ACCORDANCE WITH THE REQUIREMENTS SET FORTH IN THE MARYLAND PROFESSIONAL SURVEYING ACT AND REGULATIONS. THE POSITION OF EACH POINT SHOWN ON THIS PLAN IS CORRECT TO THE BEST OF MY KNOWLEDGE AND BELIEF.

Michael D. Adcock
MICHAEL D. ADCOCK
PROFESSIONAL LAND SURVEYOR
NO. 21257 EXPIRATION DATE 12/31/2025

Sill · Adcock & Associates · LLC
Engineers · Surveyors · Planners
2301 North Ridge Road, Suite 200
Silver Spring, Maryland 20910
Phone: 443.225.7652 Fax: 443.225.7653
Email: info@adcock.com

REFERENCE	L 101, F 717
DATE	NOVEMBER 18, 2013
SCALE	1"=30'
FILE NO.	13-001-245