

Menu Save Reset Cancel Help

Record Detail (This section is required.)

Permit Type	Permit Number	Opened Date
Building/Residential/Misc/Tanks	B21002949	08/09/2021
Description of Work		
SFD/ INSTALL (1) 500GAL UNDERGROUND PROPANE TANK W/ LINE TO POOL HEATER.		

check spelling

Address (This section is required.)

Search Reset Clear Get Parcel & Owner

Street #	Street Name	Street Type	
15700	FREDERICK	RD	
Unit Type	Unit #	X Coordinate	Y Coordinate
--Select--		-77.05876	39.33685
City	State	Zip Code	Primary
WOODBINE	MD	21797	Yes

Approved 8/10/21


Parcel (This section is required.)

Search Reset Clear Get Address & Owner

GIS ID	Parcel	Parcel Area	Land Value	Improved Value	Exemption Value	Plan Area
832092	345	125.72	259200	808100	548900	RURAL
Legal Description						
IMPS125.7766 AR[]15700 FREDERICK RD[]LISBON						

check spelling

Block	Lot	Census Tract	Council Dist	Inspection Dist	Supervisor Dist	Map #	DAP Zone
		804001	5				
Plan Area	State Tax Id	Subdivision Name					
	1404315456						
Section	Area	Tax Map					
		8					
Grid	Zoning District	ADC Map					
8-7	RC-DEO	4691-K7					
SDP No.	Final Plan No.	WP File No.					
Record Plat No.	WS Contract No.	FDP No.	Primary				
			Yes				
Owner Occupied	Year Built	Historic District					
<input type="radio"/> Yes <input type="radio"/> No	1984	<input checked="" type="radio"/> Yes <input type="radio"/> No					
Historic District Registry No.	Stat Area	Flood Plain					
	4-05	<input type="radio"/> Yes <input checked="" type="radio"/> No					
Building No							

Owner (This section is required.)

Search Reset Clear

Name	HILL BLAIR G	
Address Line 1	15700 FREDERICK ROAD	
Address Line 2		
Address Line 3		
Mail City	Mail State	Mail Zip Code
WOODBINE	MD	21797
Phone	Primary	
301-725-3232	Yes	
E-mail		
Cell Number	Fax Number	

Professionals (This section is not required.)

Search Reset Clear

License # *	Business Name		
20100103851	THE H. J. POIST GAS COMPANY, INC		
License Type *	First Name	Middle Name	Last Name
Propane Gs	SEAN	MICHAEL	UNDERWOOD
Primary	Address Line 1		
No	360 MAIN STREET		
	Address Line 2		
	City	State	ZIP Code
	LAUREL	MD	20707-0000
	Phone 1	Phone 2	Fax
	4434149582		
	E-mail		

Applicant (This section is not required.)

Search As Owner As Lic. Prof As Contact

Type *	First Name	MI	Last Name
Applicant	MICHELLE		CLANCY
Relationship	Full Name		
Applicant	MICHELLE CLANCY		
Primary	Organization Name		
Yes	APPLIED & APPROVED PERMITS LLC		
	Street Address		
	P.O. BOX 310		
	Address Line 2		
	City	State	Zip Code
	PERRY HALL	MD	21128
	Phone	Cell	Fax
	443-340-1229		
	E-mail *		
	MICHELLE@APPLIEDANDAPPROVED.COM		

Addtl info

Est Construction Cost *	Housing Units *	Number of Buildings *	Public Owned
3000	0	0	No
Construction Type			
--Select--			

TANK INFORMATION

RESIDENTIAL TANK INFORMATION

Capital Project-No Fee *	Capital Project Number	Fee Exempt *	Roadside Tree Project Permit *	Roadside Tree Permit #
<input type="radio"/> Yes <input checked="" type="radio"/> No		<input type="radio"/> Yes <input checked="" type="radio"/> No	<input type="radio"/> Yes <input checked="" type="radio"/> No	
Existing Use	Number of Tanks Installed *	Number of Tanks Removed *		
SFD	1	0		
Water Supply	Sewage Disposal	Expiration Date	Relocate Existing Tank *	
Private	Private	2/6/2022	0	

PAYMENT INFORMATION

Check 1	Payee 1	Check 2	Payee 2	SAP Doc No	SAP Entered

Submit Cancel

THE HILL RESIDENCE

15700 FREDERICK ROAD
WOODBINE, MARYLAND

Scale: 1" = 30'-0"

CONSTRUCTION ACCESS
VIA DRIVEWAY

EX. DRIVEWAY

EX. PIT WELL LOCATION

PLACE PROTECTIVE FENCING
AROUND WELL


768'-0" TO NORTH
PROPERTY LINE

135'


67'-3"

HOUSE

PORCH

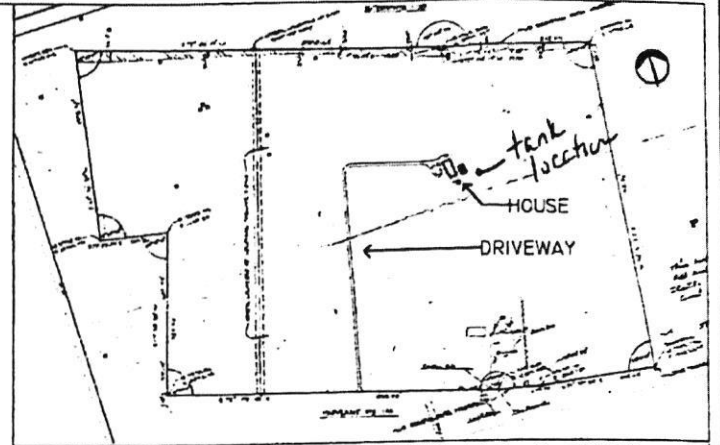

125 ACRE PROPERTY PLAN ABOVE Scale: 1" = 1000'-0"

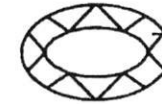

POOL EQUIPMENT

20'x40' (800SF)
IN-GROUND POOL

880'-0" TO EAST
PROPERTY LINE

875 to prop line

AUTOMATIC COVER

500 gal U9 propane tank

43'

SEPTIC TANK LOCATION

1360'-0" TO SOUTH
PROPERTY LINE

SEPTIC TRENCHES CURRENT
LOCATION AS SHOWN ON AS-BUILTS
4 TRENCHES @ 90' LENGTH

Approved for LP tank
B21002949
Rmtt 8/10/21

