

Approved 7/22/21

Menu Save Reset Cancel Help

Record Detail * (This section is required.)

Permit Type Building/Residential/Garage/Attached Permit Number B21002404 Opened Date 07/01/2021

Description of Work
SFD/ REMOVE EXISTING FIRE DAMAGED GARAGE & REPLACE (SEE CB210001)/, 1 STORY, Existing, OR, 0FB, 0HB, 0FP, OTHER STRUCTURE = None, 0BR, PORCH/DECK = N/A, ENERGY METHOD = N/A,

check spelling

Address * (This section is required.)

Search Reset Clear Get Parcel & Owner

Street # 14225 Street Name DAY FARM Street Type RD

Unit Type Unit # X Coordinate Y Coordinate
--Select-- 184 -77.00549 39.25929

City GLENELG State MD Zip Code 21737 Primary Yes

Parcel * (This section is required.)

Search Reset Clear Get Address & Owner

GIS ID *	Parcel	Parcel Area	Land Value	Improved Value	Exemption Value	Plan Area
891773	184	1.24	277400	431900	154500	RURAL

Legal Description
IMPSLOT 37 1.243 A.[]14225 DAY FARM RD[]THE HERITAGE

check spelling

Block 37 Lot 184 Census Tract 605101 Council Dist 5 Inspection Dist Supervisor Dist Map # DAP Zone

Plan Area State Tax Id 1405380685 Subdivision Name THE HERITAGE

Section Area Tax Map 21

Grid 21-18 Zoning District RR-DEO ADC Map 4812-K9

SDP No. Final Plan No. WP File No.

Record Plat No. 3778 WS Contract No. FDP No. Primary Yes

Owner Occupied Year Built 1979 Historic District Yes No

Historic District Registry No. Stat Area 5-01 Flood Plain Yes No

Building No

Owner (This section is not required.)

Search Reset Clear

Name * HUGHES PAUL W JR

Address Line 1 14225 DAY FARM RD

Address Line 2

Address Line 3

Mail City GLENELG Mail State MD Mail Zip Code 21737

Phone 301-346-9300 Primary Yes

E-mail

Cell Number Fax Number

Professionals (This section is not required.)

Search Reset Clear

License # *	Business Name		
08010012578	CRIMCO INC		
License Type *	First Name	Middle Name	Last Name
MHIC Ind <input type="checkbox"/>	WALTER		DUSTIN
Primary	Address Line 1		
Yes <input type="checkbox"/>	3813 IVORY ROAD		
	Address Line 2		
	City	State	ZIP Code
	GENELG	MD	21737-0000
	Phone 1	Phone 2	Fax
	3013469300		4104896991
	E-mail		
	CRIMCO3@GMAIL.COM		

Applicant (This section is not required.)

Search As Owner As Lic. Prof As Contact

Type *	First Name	MI	Last Name
Applicant <input type="checkbox"/>	WALTER		DUSTIN
Relationship	Full Name		
Applicant <input type="checkbox"/>	WALTER DUSTIN		
Primary	Organization Name		
No <input type="checkbox"/>	CRIMCO INC		
	Street Address		
	3813 IVORY ROAD		
	Address Line 2		
	City	State	Zip Code
	GENELG	MD	21737-0000
	Phone	Cell	Fax
	3013469300		4104896991
	E-mail *		
	CRIMCO3@GMAIL.COM		

Contact (This section is not required.)

Search As Owner As Lic. Prof As Contact

Type	First Name	MI	Last Name
Contact <input type="checkbox"/>	WALTER		DUSTIN
Relationship	Full Name		
Applicant <input type="checkbox"/>	WALTER DUSTIN		
Primary	Organization Name		
Yes <input type="checkbox"/>	CRIMCO INC		
	Street Address		
	3813 IVORY ROAD		
	Address Line 2		
	City	State	Zip Code
	GENELG	MD	21737
	Phone	Cell	Fax
	301-346-9300	301-346-9300	410-489-6991
	E-mail		
	crimco3@gmail.com		

Addtl Info

Est Construction Cost *	Housing Units *	Number of Buildings *	Public Owned
45000	0	0	No <input type="checkbox"/>
Construction Type			
43B - Additions of Residential Garages and Carports			

RESIDENTIAL ADDITION INFORMATION

RESIDENTIAL ADDITION INFORMATION

Capital Project-No Fee *	Capital Project Number	Fee Exempt *	Roadside Tree Project Permit	Roadside Tree Project Permit #
<input type="radio"/> Yes <input checked="" type="radio"/> No		<input type="radio"/> Yes <input checked="" type="radio"/> No	<input type="radio"/> Yes <input checked="" type="radio"/> No	
No of Stories *	Foundation *	Basement *	No of Rooms *	Full Baths *
Model *	Existing <input type="checkbox"/>	N/A <input type="checkbox"/>	0	0
				Half Baths *
				0
				Existing Use
				Other - See Description of Wor: <input type="checkbox"/>

SFD/ REMOVE EXISTING FIRE DAMAGED GARAGE & REPLACE (SEE CB210001/)

check spelling

Other Structure *	Bedrooms *	Porch Deck *	No of Fireplaces *	Type of Fireplace	Energy Code *
None <input type="checkbox"/>	0	N/A <input type="checkbox"/>	0	--Select-- <input type="checkbox"/>	N/A <input type="checkbox"/>
W & S Fees Paid	Water *	Sewage *	Utilities *	Heating System *	Sprinkler System *
<input type="radio"/> Yes <input checked="" type="radio"/> No	Private <input type="checkbox"/>	Private <input type="checkbox"/>	Electric <input type="checkbox"/>	Electric <input type="checkbox"/>	None <input type="checkbox"/>
1st Floor Width	1st Floor Depth	2nd Floor Width	2nd Floor Depth	Basement Width	Basement Depth
					Height
					Road Frontage
					--Select-- <input type="checkbox"/>

FT FT FT FT FT FT FT
 Total Square Footage * Occupiable Square Footage * Affordable Housing Funding Foundation Measurement Footings
 SQFT SQFT EX EX
 Walls Roof Change In Use Yes No Grading Permit No
 Expiration Date

[check spelling](#)

PAYMENT INFORMATION

Check 1 Payee 1 Check 2 Payee 2 SAP Doc No SAP Entered

Related Records

Showing 1-2 of 2

Permit Number	Record Type Alias	Status	Number	Street Name	Opened Date	Description
CB210001	Building Complaint	Investigation Opened	14225	DAY FARM	01/04/2021	HCFR Incident Report - Structural damage to the garage and hou
B21002404	Residential Attached Garage Permit	Review In Process	14225	DAY FARM	07/01/2021	SFD/ REMOVE EXISTING FIRE DAMAGED GARAGE & REPLA

Page 1 of 1




Submit Cancel



DAY FARM ROAD

R=1475.00'
A=232.27'

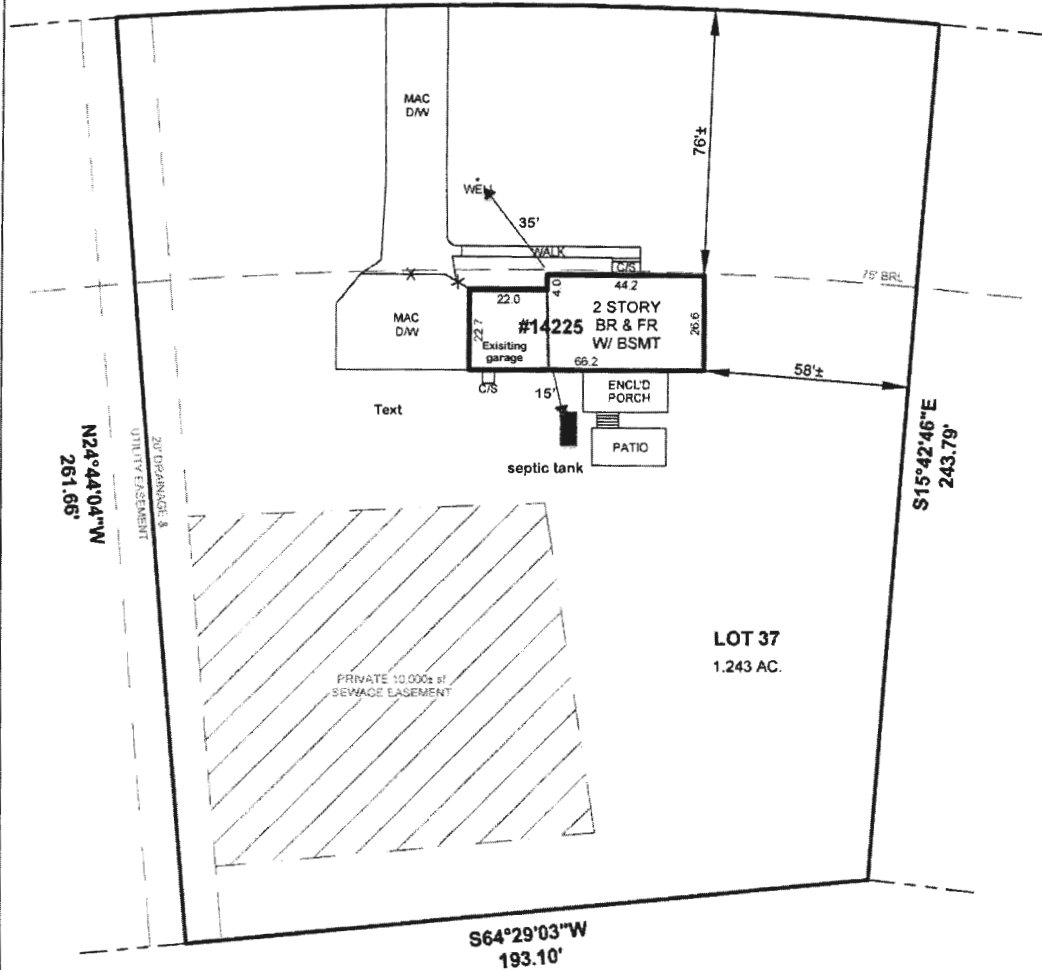

THE LEVEL OF ACCURACY OF DISTANCES TO APPARENT PROPERTY LINES IS: **1"**

LOCATION DRAWING OF:

**#14225 DAY FARM ROAD
LOT 37**

SECTION 1 AREA 2
THE HERITAGE
PLAT NO. 3778

HOWARD COUNTY, MARYLAND

SCALE: 1"=40' DATE: 07-14-2021

DRAWN BY: SM FILE #: 218169-200

LEGEND:

- FENCE
 - B/E - BASEMENT ENTRANCE
 - B/W - BAY WINDOW
 - BR - BRICK
 - BR/L - BLDG. RESTRICTION LINE
 - BSMT - BASEMENT
 - CS - CONCRETE STOOP
 - CONC - CONCRETE
 - D/W - DRIVEWAY
 - EX - EXISTING
 - FR - FRAME
 - MAC - MACADAM
 - G - GATE
 - OH - OVER-HANG
 - PUE - PUBLIC UTILITY ESMT.
 - PIE - PUBLIC IMPROVEMENT ESMT.
- COLOR KEY:
 (RED) - RECORD INFORMATION
 (BLUE) - IMPROVEMENTS
 (GREEN) - ESMTS & RESTRICTION LINES

A Land Surveying Company



DULEY
and
Associates, Inc.

Serving D.C. and MD.

14604 Elm Street, Upper Marlboro, MD 20772

Phone: 301-888-1111

Fax: 301-888-1114

Email: orders@duley.biz

On the web: www.duley.biz



SURVEYOR'S CERTIFICATE

I HEREBY STATE THAT I WAS IN RESPONSIBLE CHARGE OVER THE PREPARATION OF THIS DRAWING AND THE SURVEY WORK REFLECTED HEREIN AND IT IS IN COMPLIANCE WITH THE REQUIREMENTS SET FORTH IN REGULATION 12 CHAPTER 06 13.08 OF THE CODE OF MARYLAND ANNOTATED REGULATIONS. THIS SURVEY IS NOT TO BE USED OR RELIED UPON FOR THE ESTABLISHMENT OF FENCES, BUILDING, OR OTHER IMPROVEMENTS. THIS PLAT DOES NOT PROVIDE FOR THE ACCURATE IDENTIFICATION OF PROPERTY BOUNDARY LINES, BUT SUCH IDENTIFICATION MAY NOT BE REQUIRED FOR THE TRANSFER OF TITLE OR SECURING FINANCING OR REFINANCING. THIS PLAT IS OF BENEFIT TO A CONSUMER ONLY INsofar AS IT IS REQUIRED BY A LENDER OR A TITLE INSURANCE COMPANY OR ITS AGENTS IN CONNECTION WITH THE CONTEMPLATED TRANSFER, FINANCING OR REFINANCING. NO TITLE REPORT WAS FURNISHED TO NOR DONE BY THIS COMPANY. SAID PROPERTY SUBJECT TO ALL NOTES, RESTRICTIONS AND EASEMENTS OF RECORD. BUILDING RESTRICTION LINES AND EASEMENTS MAY NOT BE SHOWN ON THIS SURVEY. IMPROVEMENTS WHICH IN THE SURVEYOR'S OPINION APPEAR TO BE IN A STATE OF DISREPAIR OR MAY BE CONSIDERED "TEMPORARY" MAY NOT BE SHOWN. IF IT APPEARS ENCROACHMENTS MAY EXIST, A BOUNDARY SURVEY IS RECOMMENDED.

DULEY & ASSOC.

WILL GIVE YOU A 100% FULL CREDIT TOWARDS UPGRADING THIS SURVEY TO A "BOUNDARY/STAKE" SURVEY FOR ONE YEAR FROM THE DATE OF THIS SURVEY.

(EXCLUDING D.C. & BALT. CITY)