

Menu Save Reset Cancel Help

Record Detail (This section is required.)

Permit Type	Permit Number	Opened Date
Building/Residential/Misc/Tanks	B21002503	07/12/2021
Description of Work		
SFD/ INSTALL (1) 500 UG LP ASME TANK		

check spelling

Address (This section is required.)

Search Reset Clear Get Parcel & Owner

Street #	Street Name	Street Type	
17045	HARDY	RD	
Unit Type	Unit #	X Coordinate	Y Coordinate
--Select--		-77.11256	39.33854
City	State	Zip Code	Primary
MOUNT AIRY	MD	21771	Yes

Approved 7/14/21  
[Signature]

Parcel (This section is required.)

Search Reset Clear Get Address & Owner

GIS ID *	Parcel	Parcel Area	Land Value	Improved Value	Exemption Value	Plan Area
831231	528	1.27	202700	561400	358700	RURAL
Legal Description						
IMPSLOT 16 1.27 A [17045 HARDY RD] SPRING HOLLOW RSB LOT 2						

check spelling

Block	Lot	Census Tract	Council Dist	Inspection Dist	Supervisor Dist	Map #	DAP Zone
	16	604001	5				
Plan Area	State Tax Id	Subdivision Name					
	1404362896	SPRING HOLLOW					
Section	Area	Tax Map					
		7					
Grid	Zoning District	ADC Map					
7-8	RC-DEO	4691-B6					
SDP No.	Final Plan No.	WP File No.					
	S-98-001						
Record Plat No.	WS Contract No.	FDP No.					
13772							
Owner Occupied	Year Built	Historic District					
<input type="radio"/> Yes <input type="radio"/> No	2000	<input type="radio"/> Yes <input checked="" type="radio"/> No					
Historic District Registry No.	Stat Area	Flood Plain					
	4-04	<input type="radio"/> Yes <input checked="" type="radio"/> No					
Building No							

Owner (This section is required.)

Search Reset Clear

Name *	RENEHAN JILL M T/E		
Address Line 1	17045 HARDY ROAD		
Address Line 2			
Address Line 3			
Mail City	Mail State	Mail Zip Code	
MT AIRY	MD	21771	
Phone	Primary		
301-251-0606	Yes		
E-mail			
Cell Number	Fax Number		


Professionals (This section is not required.)

\* Tank to well 397'  
 \*\* Tank to closest property line 110'  
 \*\*\* Tank to house 12' Well

LOT 15

FOREST  
 CONSERVATION  
 EASEMENT AREA \*4  
 AREA = 1.006 AC.\*  
 AFFORESTATION

Approved for LP tank  
 B21002503  
 Ret 7/14/21

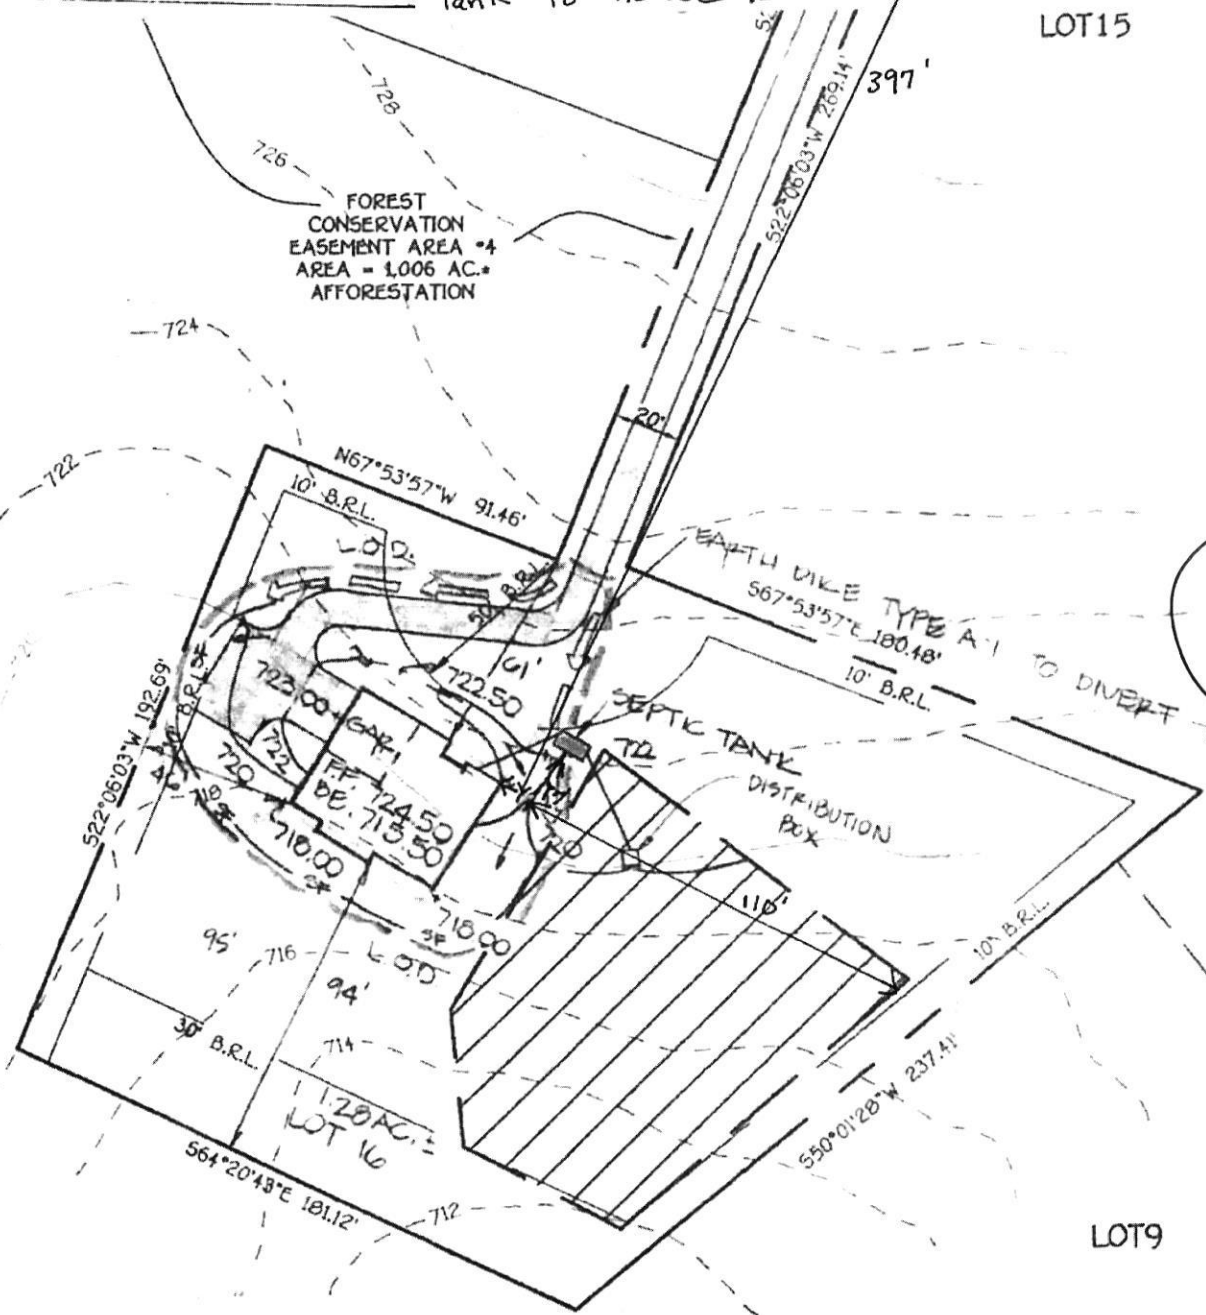

GP 00 117

PLAN TO ACCOMPANY APPLICATION  
 FOR BUILDING PERMIT  
**LOT 16**  
**SPRING HOLLOW**

LOTS 1 THRU 30 AND  
 BUILDABLE PRESERVATION PARCEL 'A'  
 ZONED: RC-DEO  
 Tax Map No. 7 Parcel Nos. 30, 144, 341, 394 And 522  
 Fourth Election District Howard County, Maryland  
 SCALE: 1"=50' DATE: NOVEMBER, 1999

LOT 9