


Menu Refine Search GIS Help Data Filter: Filter TMP's My Filters

Showing 1 of 1

<input type="checkbox"/> <u>Permit #</u>	<u>Status</u>	<u>Record Type Alias</u>	<u>Street #</u>	<u>Street Name</u>	<u>Type</u>	<u>Unit Type</u>	<u>Unit #</u>	<u>City</u>
<input type="checkbox"/> B21003065	Review In Process	Residential Deck Permit	7425	HAVEN	CT			HIGHLA

Page of 1 


1425 AVENUE CRT

DECK

Proposed Deck 27x54'

1" = 50'

NON-BUILDABLE PRESERVATION PARCEL B

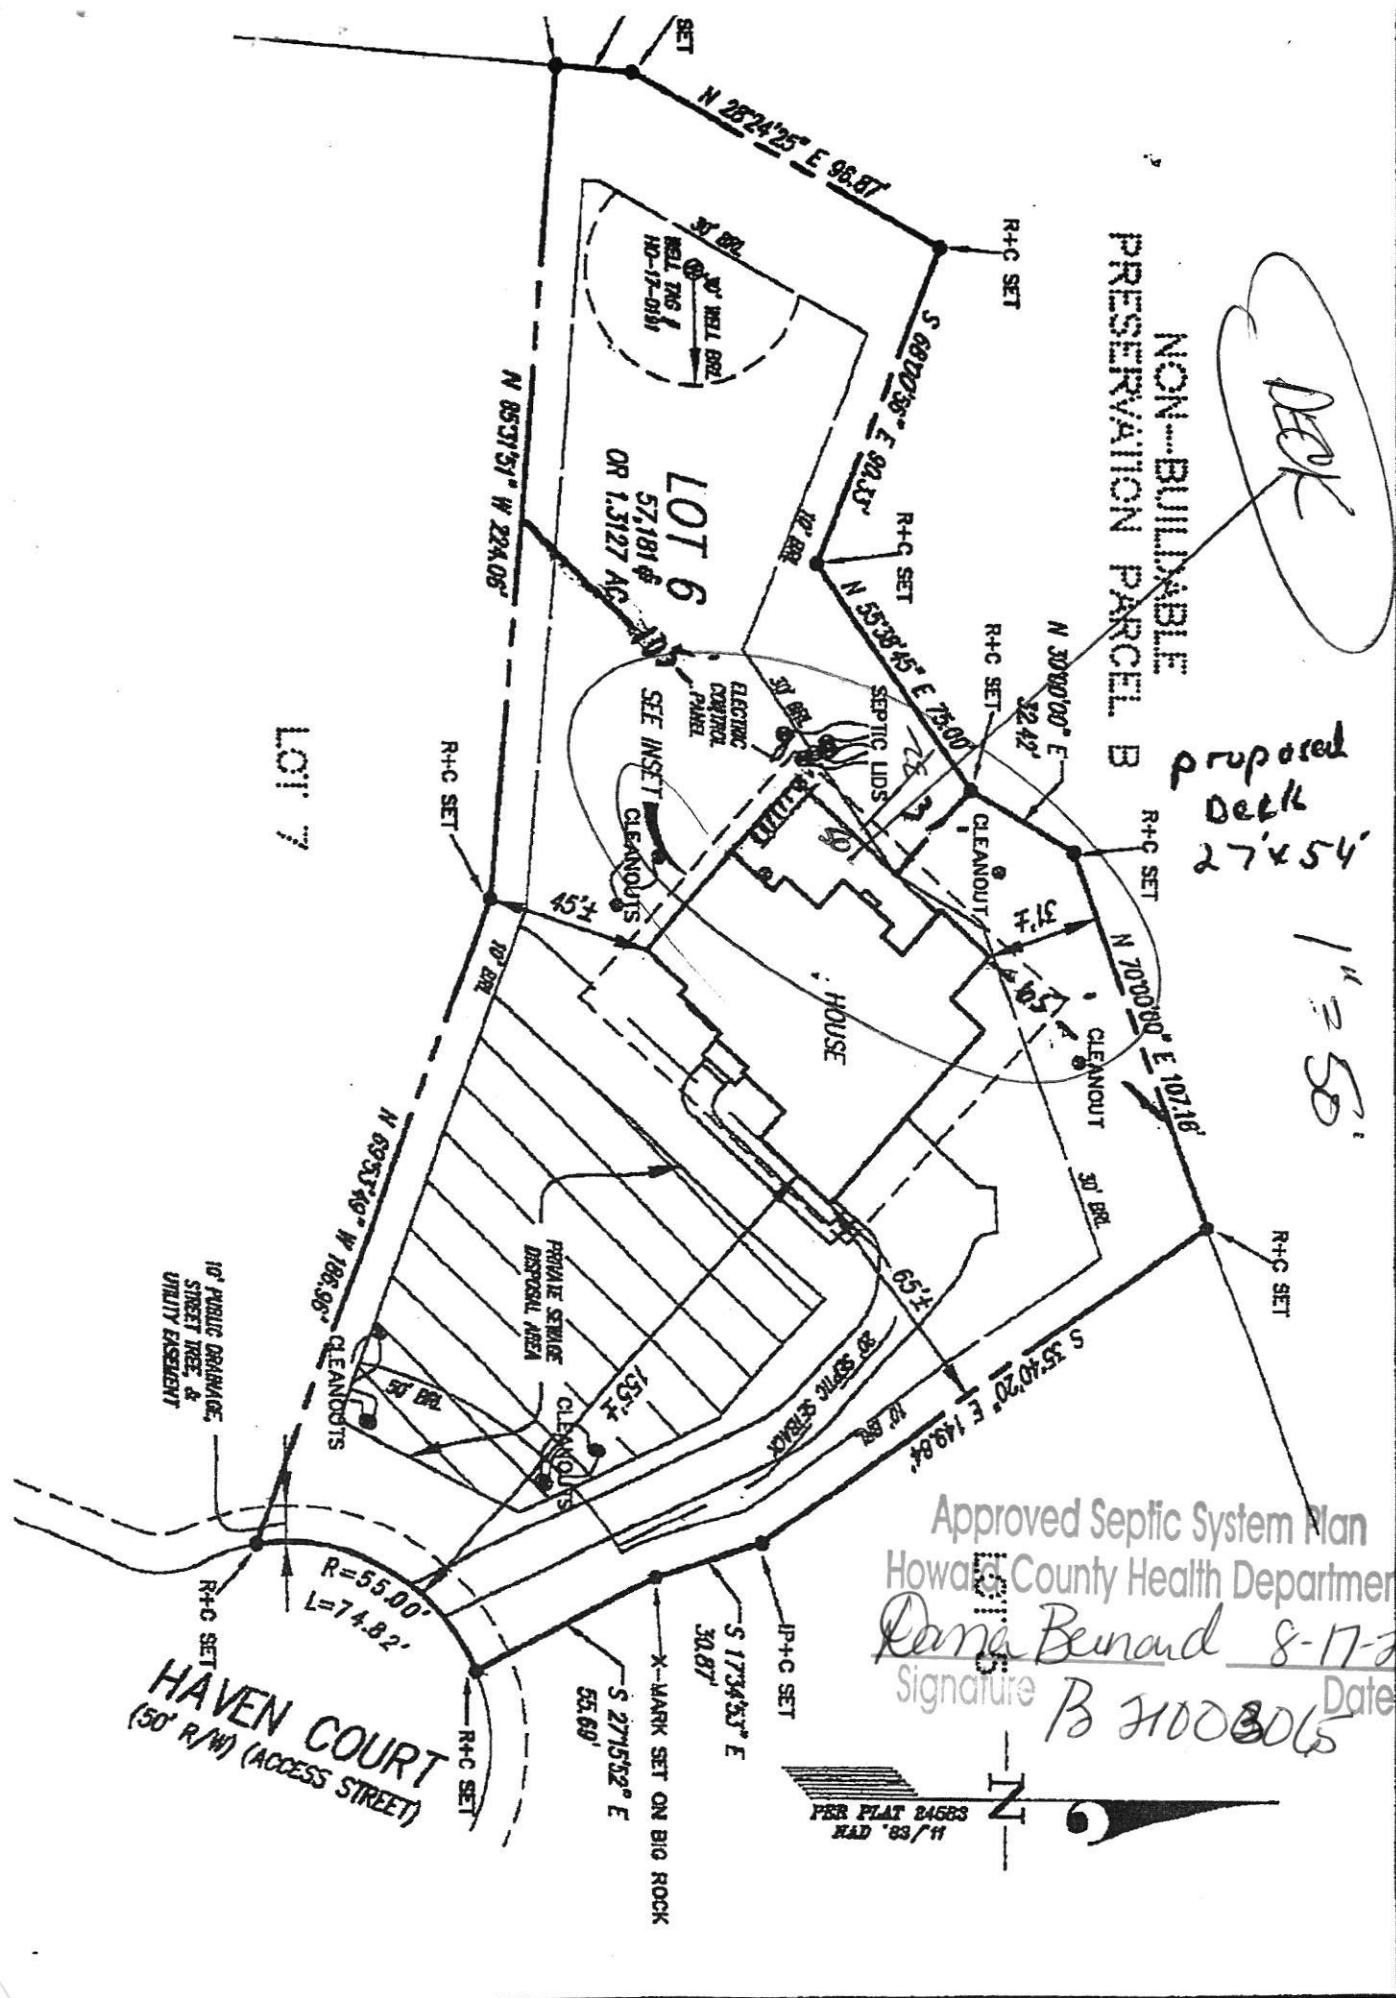

Approved Septic System Plan
 Howard County Health Department
 Dana Beard 8-17-21
 Signature B 7100306 Date