

Approved 8/10/21

-H.O.

Menu Save Reset Cancel Help

Record Detail (This section is required.)

Permit Type	Permit Number	Opened Date
Building/Residential/Misc/Deck	B21002832	08/03/2021
Description of Work		
SFD/ CONSTRUCT A 32' X 22' OPEN DECK, 5' X 5' LANDING, & STEPS TO GRADE		

check spelling

Address (This section is required.)

Search Reset Clear Get Parcel & Owner

Street #	Street Name	Street Type	
4341	BUCKSKIN WOOD	DR	
Unit Type	Unit #	X Coordinate	Y Coordinate
--Select--		-76.97968	39.25623
City	State	Zip Code	Primary
ELLCOTT CITY	MD	21042	Yes

Parcel (This section is required.)

Search Reset Clear Get Address & Owner

GIS ID *	Parcel	Parcel Area	Land Value	Improved Value	Exemption Value	Plan Area
890523	77	1.02	175200	0	703500	RURAL
Legal Description						
IMPVLOT 5 1.027 A[]4341 BUCKSKIN WOOD DR[]BUCKSKIN RIDGE						

check spelling

Block	Lot	Census Tract	Council Dist	Inspection Dist	Supervisor Dist	Map #	DAP Zone
	5	605101	5				
Plan Area	State Tax Id	Subdivision Name					
	1405437121						
Section	Area	Tax Map					
		22					
Grid	Zoning District	ADC Map					
22-20	RR-DEO	4813-D10					
SDP No.	Final Plan No.	WP File No.					
	F-01-191						
Record Plat No.	WS Contract No.	FDP No.	Primary				
15523			Yes				
Owner Occupied	Year Built	Historic District					
<input type="radio"/> Yes <input type="radio"/> No	2007	<input type="radio"/> Yes <input checked="" type="radio"/> No					
Historic District Registry No.	Stat Area	Flood Plain					
	5-02A	<input type="radio"/> Yes <input checked="" type="radio"/> No					
Building No							

Owner (This section is required.)

Search Reset Clear

Name *	AMBARKAR SIDDESWAR	
Address Line 1	4341 buckskin wood dr	
Address Line 2		
Address Line 3		
Mail City	Mail State	Mail Zip Code
ellicott city	MD	21042
Phone	Primary	
301-263-4845	Yes	
E-mail		
Cell Number	Fax Number	

Professionals (This section is not required.)

Search Reset Clear

License # *	Business Name		
08010118302	SCUTRO PROPERTIES LLC		
License Type *	First Name	Middle Name	Last Name
MHIC Ind <input type="checkbox"/>	JEFFREY		LANDOW
Primary <input type="checkbox"/>	Address Line 1		
Yes <input type="checkbox"/>	8249 HICKOY HOLLOW DRIVE		
	Address Line 2		
	City	State	ZIP Code
	GLEN BURNIE	MD	21060-0000
	Phone 1	Phone 2	Fax
	4106963324		0000000000
	E-mail		
	SCUTRO2@GMAIL.COM		

Applicant (This section is not required.)

Search As Owner As Lic. Prof As Contact

Type *	First Name	MI	Last Name
Applicant <input type="checkbox"/>	JEFFREY		LANDOW
Relationship	Full Name		
Applicant <input type="checkbox"/>			
Primary <input type="checkbox"/>	Organization Name		
Yes <input type="checkbox"/>	SCUTRO PROPERTIES LLC		
	Street Address		
	8249 HICKOY HOLLOW DRIVE		
	Address Line 2		
	City	State	Zip Code
	GLEN BURNIE	MD	21060-0000
	Phone	Cell	Fax
	4106963324		0000000000
	E-mail *		
	SCUTRO2@GMAIL.COM		

Addtl Info

Est Construction Cost *	Housing Units *	Number of Buildings *	Public Owned
31000	0	0	No <input type="checkbox"/>
Construction Type			
434 - Additions, Alterations and Conversions - Residential <input type="checkbox"/>			

MISC PERMIT INFO

MISCELLANEOUS PERMIT INFORMATION

Capital Project-No Fee *	Capital Project Number	Fee Exempt *	Roadside Tree Project Permit *	Roadside Tree Project Permit #
<input type="radio"/> Yes <input checked="" type="radio"/> No		<input type="radio"/> Yes <input checked="" type="radio"/> No	<input type="radio"/> Yes <input checked="" type="radio"/> No	
Existing Use *	Water	Sewage	Expiration Date	
SFD <input type="checkbox"/>	Private <input type="checkbox"/>	Private <input type="checkbox"/>	1/31/2022 <input type="checkbox"/>	

PAYMENT INFORMATION

Check 1	Payee 1	Check 2	Payee 2	SAP Doc No	SAP Entered

Submit Cancel

Oswald, Hank

From: Oswald, Hank
Sent: Wednesday, August 4, 2021 1:30 PM
To: 'SCUTRO2@GMAIL.COM'
Subject: B21002832_4341 Buckskin Wood Drive
Attachments: WS_BuckskinWoodDrive_4341_SepticPermit_2006.pdf; Well and Septic Setback Distances.pdf


Hello Mr. Landow:

Please revise the site plan (for 4341 Buckskin Court) to include the well and septic components. I've attached the septic record for your convenience. Please see as-built drawing on page 2. You will need to submit the revision to DILP.

Thanks,

Hank

Hank Oswald, L.E.H.S.
Howard County Health Department
Bureau of Environmental Health
Well & Septic Program
8930 Stanford Boulevard
Columbia, MD 21045
(410) 313 - 1786
hoswald@howardcountymd.gov

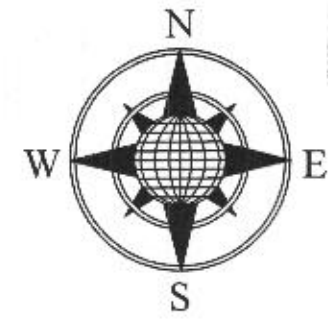

Property Line

Buckskin Wood Dr

HO-94-3203

4341 House

Septic

Proposed Deck

Wall line

Wall line

Setback 50'

Property Line

Setback 10'

Setback 10'

Property Line

Property Line



4341 Buckskin Wood Dr
Ellicott City, MD 21042
1":30'

