

Bureau of Environmental Health
 8930 Stanford Boulevard, Columbia, MD 21045
 Main: 410-313-2640 | Fax: 410-313-2648
 TDD 410-313-2323 | Toll Free 1-866-313-6300
www.hchealth.org
 Facebook: www.facebook.com/hocohealth

Maura J. Rossman, M.D., Health Officer

RECEIPT DATE: 8/2/22 **ONSITE SEWAGE DISPOSAL SYSTEM** P 572117

APPROVAL DATE: 08/17/2022 **PERMIT:** REPAIR A _____

PROPERTY ADDRESS: 12237 Mount Albert Court

SUBDIVISION: _____ LOT: _____ TAX ID: _____

CONTRACTOR: Hatfields Equipment EMAIL: ken@hatfieldsequipment.com

CONTRACTOR ADDRESS: P.O. Box 519, Annapolis Junction, MD 20701 PHONE: 301-490-4289

PROPERTY OWNER: Michael and Grazina McClure EMAIL: _____

OWNER ADDRESS: 12237 Mount Albert Court, Ellicott City, MD 21042 PHONE: _____

SEPTIC TANK SIZE (GALLONS): Earthlog TANK MANUFACTURER: _____

PUMP MODEL: n/a PUMP SIZE: n/a PUMP TANK CAPACITY: n/a

DISTRIBUTION SYSTEM: GRAVITY PRESSURE DOSED BEDROOMS: 3 APPLICATION RATE: _____


TRENCHES:	LINEAR FEET REQUIRED: <u>94'</u>	INLET DEPTH: <u>3.5'</u>
	TRENCH WIDTH: <u>2'</u>	MAXIMUM BOTTOM DEPTH: <u>8'</u>
	MINIMUM SPACE BETWEEN TRENCHES: <u>n/a</u>	EFFECTIVE AREA BEGINNING DEPTH: <u>5'</u>
LOCATION:	PER APPROVED SITE PLAN. SEWAGE DISPOSAL AREA AND TANK LOCATIONS MUST BE STAKED BY LICENSED SURVEYOR PRIOR TO PRE-CONSTRUCTION INSPECTION.	
NOTES:	<u>Install per approved design. Pump and collapse ex. DW,</u>	

ISSUED BY: K. Wolf ISSUE DATE: 8/10/22 EXPIRATION DATE: 8/10/22

- NOTE: CONTRACTOR MUST SCHEDULE A PRE-CONSTRUCTION INSPECTION PRIOR TO BEGINNING ANY INSTALLATION
- NOTE: CONTRACTOR MUST SCHEDULE AN INSPECTION AND GAIN APPROVAL OF ALL COMPONENTS PRIOR TO COVERING
- NOTE: STONE MUST BE APPROVED BY HEALTH DEPARTMENT AND GRAVEL TICKET MUST BE AVAILABLE FOR REVIEW.
- NOTE: WATERTIGHT TANKS REQUIRED
- NOTE: ALL PARTS OF SEPTIC SYSTEM SHALL BE AT LEAST 100 FEET DOWNGRADIENT FROM ANY WATER WELL
- NOTE: MANHOLE RISERS REQUIRED ON ALL SEPTIC TANKS AND PUMP CHAMBERS
- NOTE: AN ELECTRICAL PERMIT IS REQUIRED FOR INSTALLATION OF ANY ELECTRICAL COMPONENTS OF THE SYSTEM
- ELECTRICAL PERMIT ISSUED E n/a
- NOTE: MDE RECOMMENDS SEPTIC TANKS, BAT, AND OTHER PRETREATMENT UNITS BE PUMPED AT A FREQUENCY ADEQUATE TO ENSURE THAT SOLIDS ARE NOT DISCHARGED TO THE DISPOSAL AREA

NEITHER THE HOWARD COUNTY COUNCIL NOR THE HEALTH DEPARTMENT IS RESPONSIBLE FOR THE SUCCESSFUL OPERATION OF ANY SYSTEM. PERMITTEE RESPONSIBLE FOR OBTAINING FINAL APPROVAL ON THIS PERMIT. CALL 410-313-1771 TO SCHEDULE INSPECTIONS.

NOT TO SCALE.

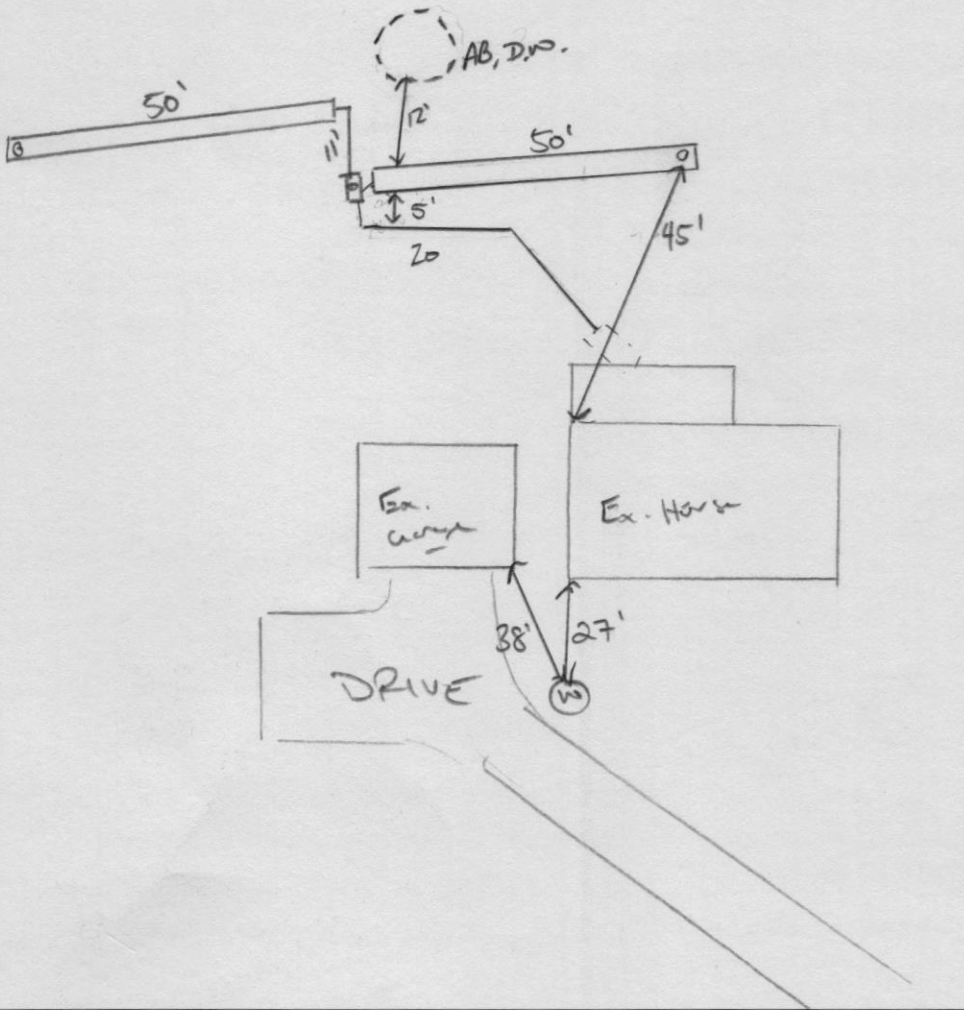

ROAD NAME
MOUNT ALBERT COURT

TRENCH/DRAINFIELD DATA

WIDTH	INLET	BOTTOM
3'	3.5'	8'
NUMBER OF TRENCHES		2
TOTAL LENGTH		100 F
ABSORPTION AREA		300 SF + 3' SIDE WALL
DISTRIBUTION BOX LEVEL		SPEED
DISTRIBUTION BOX BAFFLE		Conce
DISTRIBUTION BOX PORT		YES

SEPTIC TANK DATA

SEPTIC TANK 1 LEVEL _____

MANUFACTURER _____

CAPACITY _____ GAL

SEAM LOC _____

TANK LID DEPTH _____

BAFFLES _____

BAFFLE FILTER _____

MANHOLE LOC _____

6" PORT LOC _____

WATERTIGHT TEST _____

SLOTTED no

DATE ON LID _____

PUMP/SEPTIC TANK LEVEL _____

MANUFACTURER _____

CAPACITY _____ GAL

SEAM LOC _____

TANK LID DEPTH _____

BAFFLES _____

BAFFLE FILTER _____

MANHOLE LOC _____

6" PORT LOC _____

WATERTIGHT TEST _____

SLOTTED _____

DATE ON LID _____

PRE-CONSTRUCTION:

7/27/22 Based on soil perc today, contractor field located an area acceptable by health to install the new pump. Existing tank to be re-used. (circled)

8/9/22 Design plan received. looks good. ok to proceed w/ install. (circled)

INSTALLATION: 8/16/22 EX DW PUMPED AND FILLED W/ STONE (ABANDONED) D BOX SET, 4 TRENCH COMPLETE. (circled) 08/17/2022 TRENCHES COMPLETE; D BOX LEVELLED W/ SPEED LEVELS. (circled)

FINAL INSPECTOR Joseph Caban DATE OF APPROVAL 08/17/2022

10/22/76

File
23704
A.P.
10/22/76

PERMIT

SEWAGE DISPOSAL SYSTEM

A 15826

MARYLAND STATE DEPARTMENT OF HEALTH

HOWARD COUNTY

ELLCOTT CITY

DISTRICT 3rd

INDEXED

DATE 8/11/76

H. Edwards Construction, Inc. IS PERMITTED TO INSTALL ALTER

ADDRESS 6645 Mink Hollow Road, Highland, Md. 20777 PHONE 596-6309

A SEWAGE DISPOSAL SYSTEM LOCATED AT

SUBDIVISION Woodmark ROAD Mt. Albert Road LOT 70, Blk. C, Sec. 7

PROPERTY OWNER Howard Edwards

ADDRESS same as above

SPECIFICATIONS 4 bedrooms

DRAIN FIELD DEPTH FEET, BOTTOM AREA SQ. FT.

SEEPAGE PITS ABSORBENT SIDE-WALL AREA SQ. FT.

SEPTIC TANK CAPACITY 1250 GALLONS

FOR GARBAGE GRINDER, INCREASE DISPOSAL AREA 22% & TANK CAPACITY 50%.

OTHER DRY WELL - 480 sq. ft. effective sidewall area below inlet. Dry well inlet to be no deeper than 3 ft. and dry well bottom to be no deeper than 11 ft. Place the dry well 185 ft. from the front lot line and 75 ft. from the left side of the lot as seen when facing the lot from Mt. Albert Road.

NOTE: ALL PIPE FROM HOUSE TO DISPOSAL AREA MUST BE CAST IRON. PERMIT VOID AFTER THREE YEARS.

NOTE: INSTALL STAND PIPE ON SEPTIC TANK AND DRY WELL. STAND PIPES MUST BE 6 INCHES IN DIAMETER. CAST IRON, CONCRETE OR TERRA COTTA ACCEPTED.


PLANS APPROVED BY Raymond Hodges & Robert V. Torre DATE 6/25/73 & 8/14/73

FILL SEPTIC TANK AND DISTRIBUTION BOX WITH WATER BEFORE CALLING FOR AN INSPECTION. COVER NO WORK UNTIL INSPECTED AND APPROVED.

NEITHER THE HOWARD COUNTY COMMISSIONERS NOR THE HEALTH DEPARTMENT IS RESPONSIBLE FOR THE SUCCESSFUL OPERATION OF ANY SYSTEM.

BLDG. PERMIT SIGNED AND RETURNED 8/30/76

15826


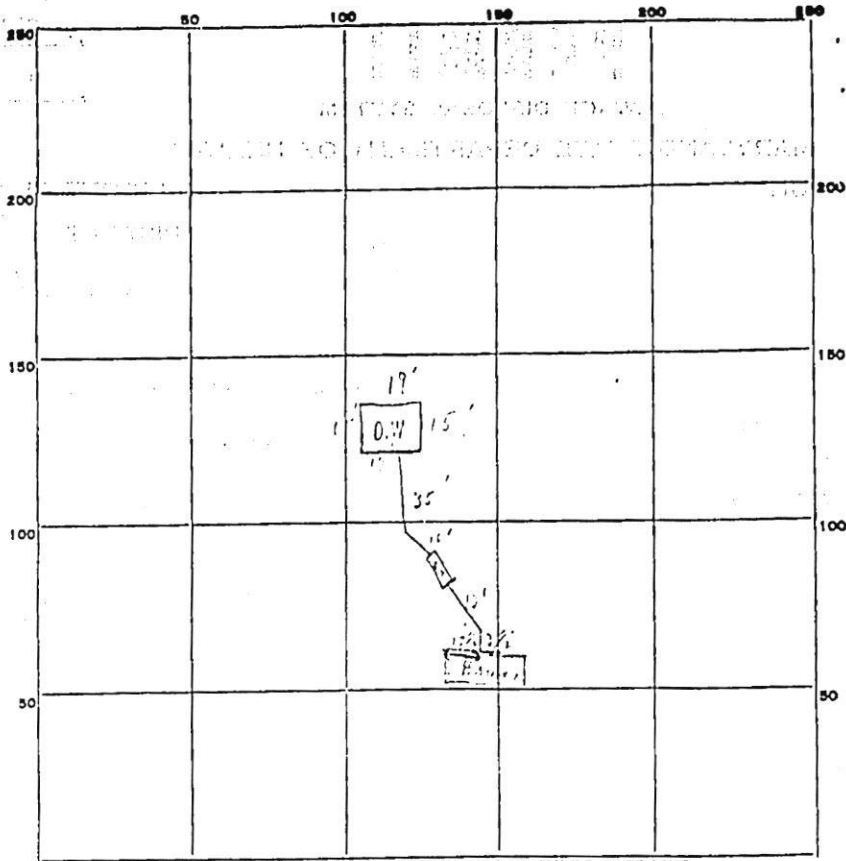


INDICATE NORTH. - NAME ADJOINING ROADWAY AS BASE LINE.


PERMIT CARD [Yes, tentative] S.T. D.W.
 SEPTIC TANK, LEVEL k CLEANOUTS ok / ok
 DISTRIBUTION BOX, LEVEL _____
 TILE FIELD, DEPTH _____ FT. TRENCH WIDTH _____ FT.
 GRAVEL DEPTH _____ IN. TOTAL LENGTH _____ FT.
 NUMBER OF TRENCHES _____ TOTAL BOTTOM AREA _____
 SEEPAGE PITS, INSIDE DIAMETER outside perimeter 66 FT. DEPTH BELOW INLET 7.5 FT.
 ABSORBENT AREA 475 ± SQ. FT.

REMARKS 10/21/76 checked - while in subdivision case (without
paper.) Less attached. Observed with P.W.M. C.B.S. at its cover
system (rain yesterday) 9" in bottom of dry well

DATE SYSTEM APPROVED 12/25/76 INSPECTOR DAO Hunt
- per inspection data here shown -

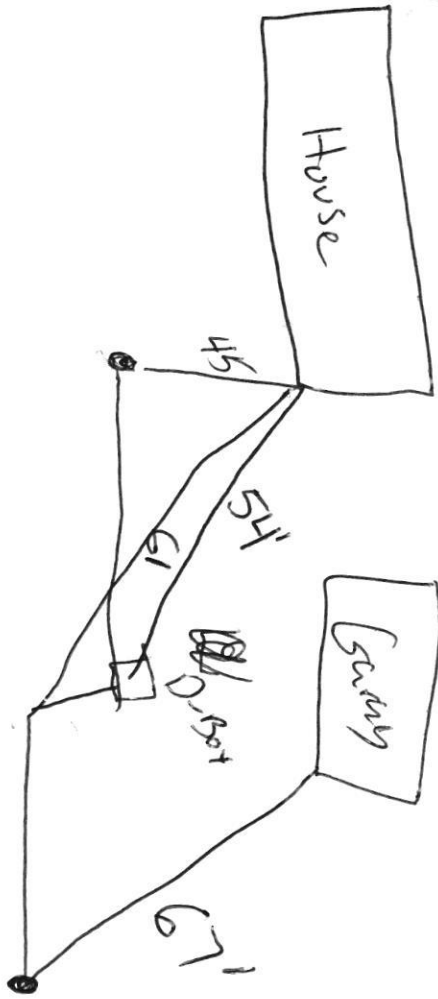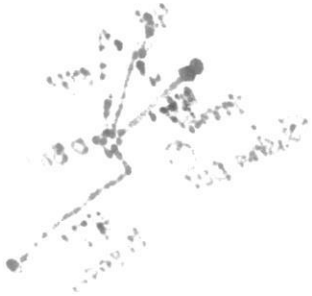

HOCO Health Depart
AUG 02 2022
Environmental Health

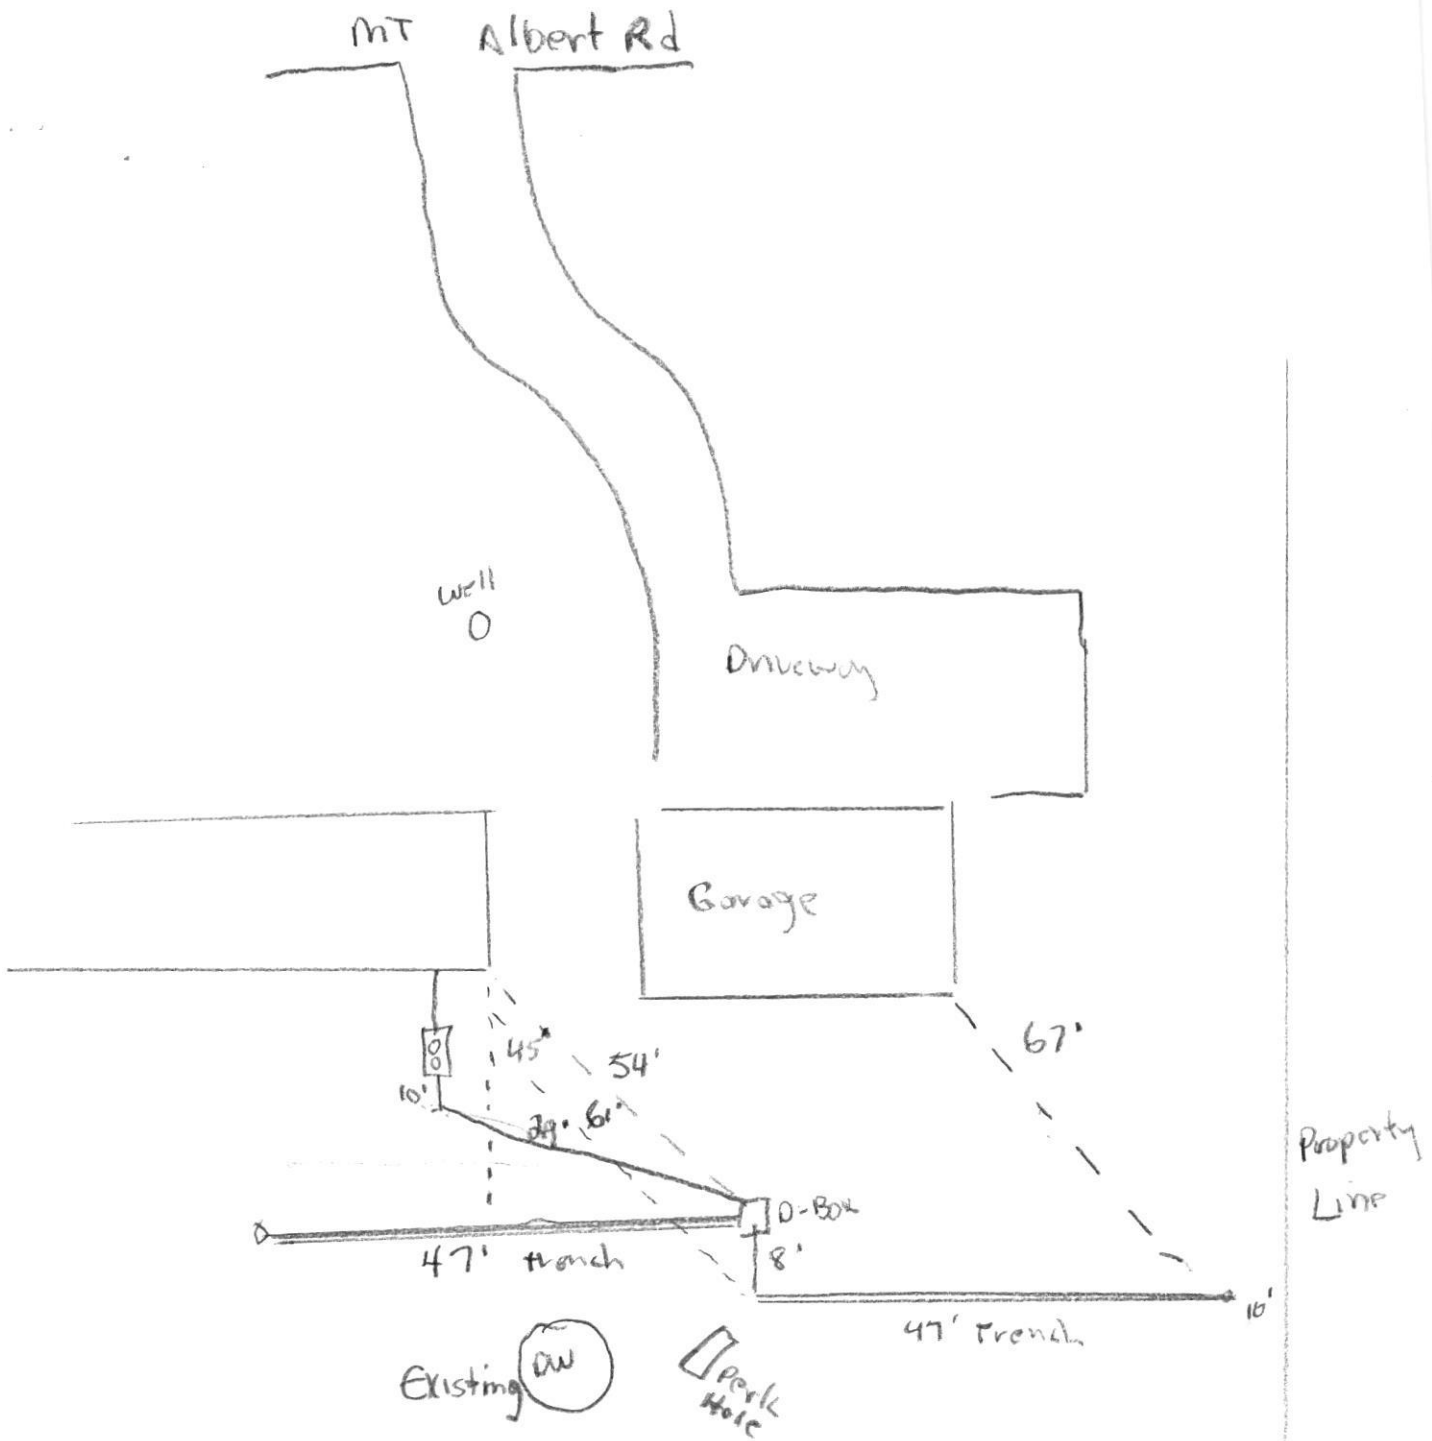

Approved Septic System Plan ** Repair*
 Howard County Health Department

R. King
 Signature Date 3/5/22