


138  
 dk brn L to brn L, 2 fsk  
 1.5' brn L, 1 msbk  
 1' yel-red & brn eosl, 0 in, ss dense  
 3.5' yel-red & pale brn sl medium phty slightly sticky  
 5' pale brn & yel-red ls cementation increases w/depth  
 7.5' - R-water -

136  
 dk brn chl 2v fsk  
 0.6' brn L thin platy  
 1.6' yel-red sl thin platy common mica  
 2.8' brn sl, dm dense common mica  
 3.6' yellow-red  
 4' blk sil  
 9.7' pale brn ls, dm many mica  
 12.3' water

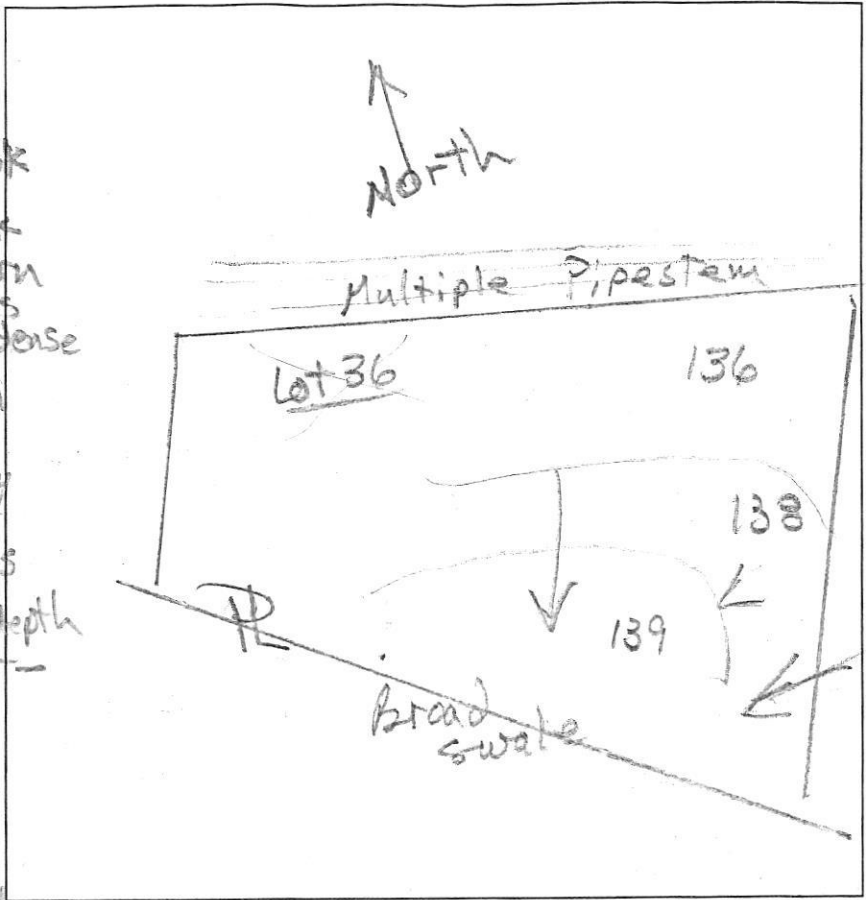

DATE	TEST #	DEPTH	START	BREAK 1" DROP	STOP 2" DROP	TIME OF 2ND INCH	P/F/H
11/6/14	138	5'	Visual			Fails on top and depth	F
11/6/14	136	6' / 23'	1:22	1:54			F

REMARKS \_\_\_\_\_  
 SANITARIAN R. Bricker BACKHOE Hatfields OTHERS Art Leonard  
 TEST HOLES USED IN SDA \_\_\_\_\_ AVG. PERC TIME \_\_\_\_\_ SQ. FT/BR \_\_\_\_\_  
 TRENCH WIDTH \_\_\_\_\_ INLET DEPTH \_\_\_\_\_ MAX. BOT DEPTH \_\_\_\_\_ EFFECTIVE S/W \_\_\_\_\_


Lot 36

STANDARD DRAWING LEGEND		
FOR ENTIRE PLAN SET (NOT TO SCALE)		
EXISTING NOTE	TYPICAL NOTE TEXT	PROPOSED NOTE
---	ONSITE PROPERTY LINE / R.O.W. LINE	---
---	"NEIGHBORING" PROPERTY LINE / INTERIOR PARCEL LINE	---
---	EASEMENT LINE	---
---	SETBACK LINE	---
---	UNDERGROUND FORCE MAIN	---
S	SANITARY SEWER MAIN	---
⊙	SANITARY MANHOLE	•
○	TERMINAL SANITARY MANHOLE	•
---	STREAM BUFFER	---
---	FLOODPLAIN	---
---	LIMIT OF DISTURBANCE	---
---	UTILITY TEST PIT LOCATION	⊕
WB	WETLAND BUFFER	---
---	PERCOLATION HOLE (PASSED)	•
---	PERCOLATION HOLE (FAILED)	⊗
---	PERENNIAL STREAM	---
---	INTERMITTENT STREAM	---
---	SEWAGE DISPOSAL AREA	PRIVATE SHARED
---	PROPOSED SEWER HOUSE CONNECTION	---
---	WETLAND BUFFER	---
---	STREAM BUFFER	---
---	TREELINE	---
---	SEWER CLEANOUT	•

QUANTITIES TABLE				
ITEMS	QUANTITIES ESTIMATED	QUANTITIES	AS-BUILT TYPE	MANUFACTURER / SUPPLIER
GRINDER PUMP (DUPLEX)	2	2	DUPLEX	ZOLLER
CLEANOUTS	7	7	CONCRETE	HORME CONCRETE
GATE VALVES	1	1	MJ RS O/R	MUELLER CO.
4" S.H.C.	65 L.F.	75 L.F.	PVC-SDR 35	JM - MFG.
1 1/2" SDR 11 HDPE (LPS)	830 L.F.	830 L.F.	HDPE	FLYING W PLASTICS
8" SDR 35 PVC	591 L.F.	590 L.F.	PVC	JM - MFG.
TERMINAL FLUSHING CONNECTION MANHOLE	2	2	PRECAST CONC.	ATLANTIC CONCRETE
SANITARY MANHOLE	2	2	PRECAST CONC.	ATLANTIC CONCRETE
3" WIDE DRAINFIELD TRENCH	750 L.F.	750 L.F.	TYPE 2-A WASHED STONE	HYDRO-TERRA
2" PVC LATERALS	744 L.F.	744 L.F.	2" PVC HDPE	FLYING W PLASTICS
3" PVC PVC FORCE MAINS	180 L.F.	180 L.F.	3" PVC HDPE	FLYING W PLASTICS
2,000 GALLON SETTLING TANKS	1	1	PRECAST CONC.	GILLESPIE
4.5 BAT UNIT (MICROFAST)	1	1	PRECAST CONC.	GILLESPIE
6,000 GALLON DOSING TANK	1	1	PRECAST CONC.	GILLESPIE
DOSING PUMPS	3	3	CAST IRON	GOULDS WESTBHF
8" X 12" CONTROL SHED	1	1	CONCRETE A-FRAME	RIDGE CABINET CO.
TRANSITION MANHOLE	2	2	PRECAST CONC.	ATLANTIC CONCRETE
NAME OF UTILITY CONTRACTOR				HIGHLAND TURF, INC.
CHECK-BOX				
AS-BUILT DATE			11-4-2021	
SURVEY AND DRAFTING DIVISION				

SHEET INDEX		
SHEET TITLE	SHEET NUMBER	
WATER AND SEWER PLAN - TITLE SHEET	1	
WATER AND SEWER PLAN - PUBLIC SEWER & FORCE MAIN PLAN & PROFILES	2	
WATER AND SEWER PLAN - DRAINFIELD PLAN	3	
WATER AND SEWER PLAN - TREATMENT SYSTEM DETAIL	4	
WATER AND SEWER PLAN - DISTRIBUTION DETAILS	5	

SANITARY STRUCTURE SCHEDULE						
NAME	TYPE	RM ELEV. (FT.)	INVERTS	NORTHING	EASTING	
CO1	CLEANOUT	489.88	INV OUT = 487.05 (4')	N 570,883.819	E 1,311,128.892	
CO2	CLEANOUT	499.22	INV OUT = 497.05 (4')	N 570,294.416	E 1,312,238.621	
CO5	CLEANOUT	490.48	INV OUT = 487.50 (1 1/2')	N 570,902.426	E 1,311,127.816	
CO6	CLEANOUT	499.96	INV OUT = 487.50 (1 1/2')	N 570,304.023	E 1,312,238.362	
GR1	GRINDER PUMP	500.00	INV IN = 487.50 (1 1/2') INV OUT = 487.00 (4')	N 570,299.204	E 1,312,238.092	
GR2	GRINDER PUMP	490.00	INV IN = 487.50 (1 1/2') INV OUT = 487.00 (4')	N 570,897.891	E 1,311,125.783	
SM4	TERMINAL FLUSHING CONNECTION	499.88	INV OUT = 494.84 (1 1/2')	N 570,332.476	E 1,312,262.708	
SM3	TERMINAL FLUSHING CONNECTION	481.82	INV OUT = 485.00 (1 1/2')	N 570,912.943	E 1,311,127.139	
SM1	STANDARD MANHOLE	486.77	INV IN = 482.10 (8') INV OUT = 481.80 (8')	N 570,584.874	E 1,311,377.182	
SM2	STANDARD MANHOLE	500.00	INV IN = 494.04 (8') INV OUT = 494.14 (8')	N 570,538.398	E 1,311,525.964	
TSM1	TRANSITION MANHOLE	497.17	INV IN = 493.00 (1 1/2') INV OUT = 492.50 (1 1/2')	N 570,599.042	E 1,311,372.847	
TSM2	TRANSITION MANHOLE	511.97	INV IN = 506.65 (1 1/2') INV OUT = 506.15 (8')	N 570,427.819	E 1,311,922.336	
VALVE BOX	ISOLATION VALVE BOX	497.19	INV IN = 491.86 (8') INV OUT = 491.86 (8')	N 570,579.878	E 1,311,375.705	

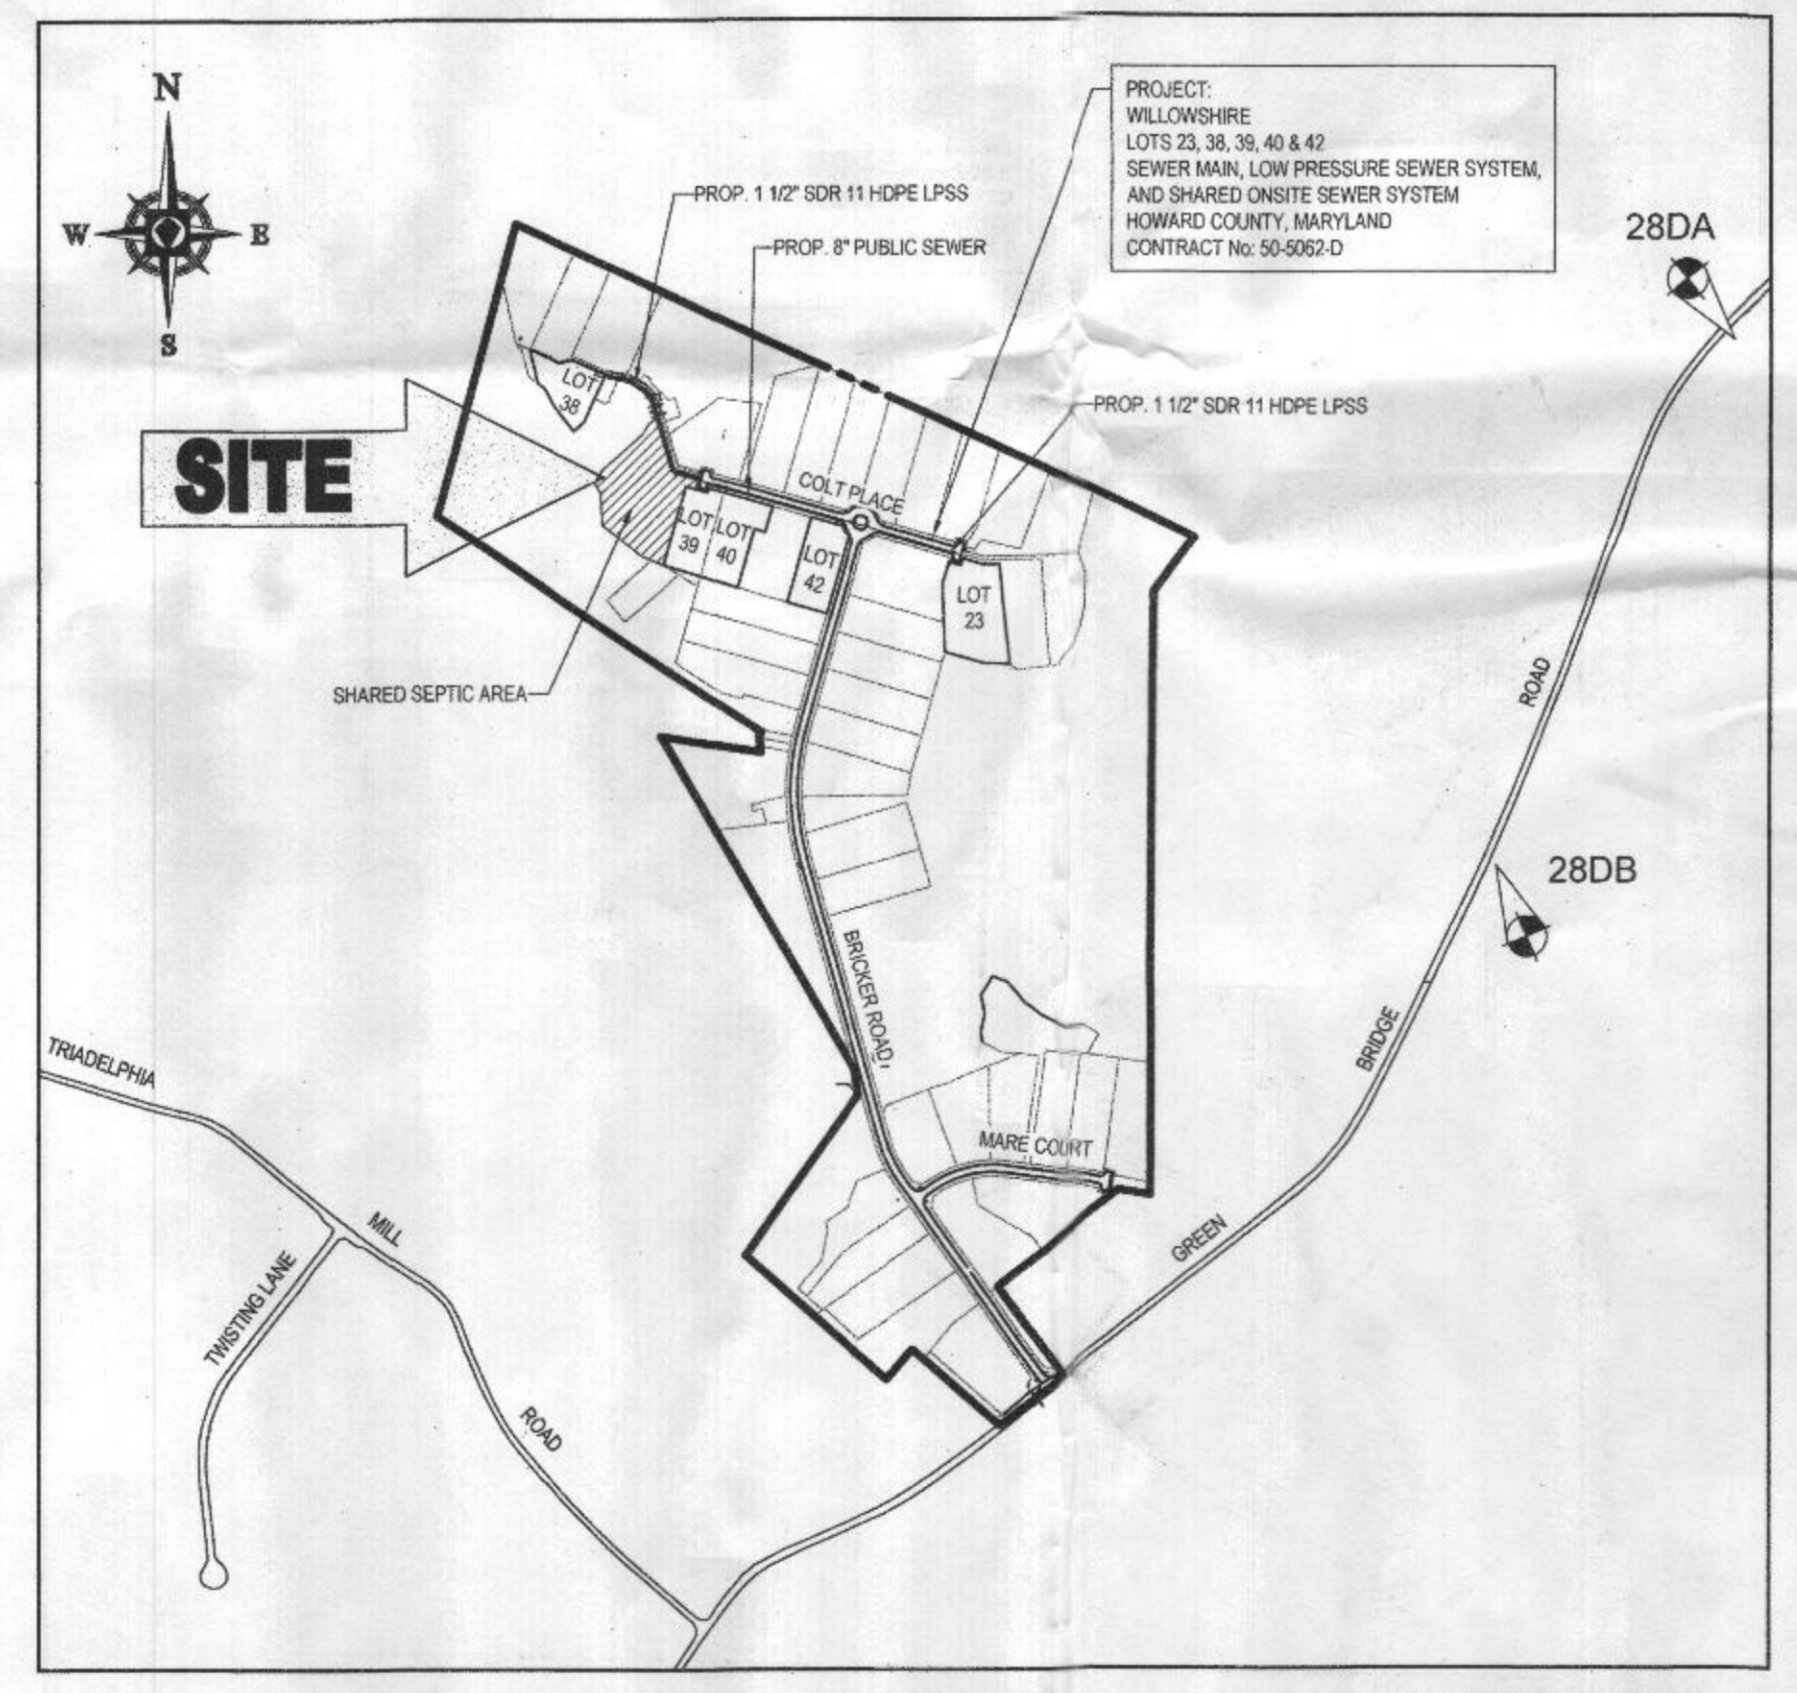

USE PROJECTION	
HOUSES SERVED BY ON-SITE SYSTEM	5
BEDROOMS PER HOUSE	5
FLOW PER BEDROOM (GPD)	150
TOTAL DESIGN FLOW AT 150 GPD/BEDROOM (GAL)	3,750
ADF (GPD)	1,875

BENCHMARK	
GEODETIC SURVEY CONTROL - 28DA	ELEV. 564.389 N 570,824.997 E 1,314,434.228
GEODETIC SURVEY CONTROL - 28DB	ELEV. 537.361 N 569,055.561 E 1,313,795.348

THIS DEVELOPMENT PLAN IS APPROVED FOR SOIL EROSION AND SEDIMENT CONTROL BY THE HOWARD SOIL CONSERVATION DISTRICT. (F-19-C80)

*John P. White* 1/28/22 DATE  
HOWARD SCD

DEPARTMENT OF PUBLIC WORKS HOWARD COUNTY, MARYLAND

*Chris Stapp* 1-15-2020 DATE  
CHIEF, BUREAU OF UTILITIES

APPROVED: FOR PRIVATE WATER, AND SHARED SEWER SYSTEM FOR LOTS 23, 38, 39, 40 & 42.

*Bridget Lee Moore-Rossman* 2/12/2020 DATE  
COUNTY HEALTH OFFICER  
HOWARD COUNTY HEALTH DEPARTMENT

DEPARTMENT OF PLANNING & ZONING HOWARD COUNTY, MARYLAND

*John M. ...* 2-19-20 DATE  
CHIEF, DEVELOPMENT ENGINEERING DIVISION

OWNERS:

PARCEL 34: TOLL MID ATLANTIC LP COMPANY INC. 250 GIBBS TAY ROAD HORSHAM PA, 19044 TEL: ...

PARCEL 112: TOLL MID ATLANTIC LP COMPANY INC. 250 GIBBS TAY ROAD HORSHAM PA, 19044 TEL: ...

PARCEL 98: JERRY MALICK JANET BURKE JT 5234 GREEN BRIDGE ROAD DAYTON, MD 21036 TEL: ...

**BOHLER ENGINEERING**

901 DULANEY VALLEY ROAD, SUITE 801 TOWSON, MARYLAND 21284

Phone: (410) 821-7900  
Fax: (410) 821-7987  
www.BohlerEngineering.com

**B.R. ROWE**

PROFESSIONAL ENGINEER

11/23/21 AS-BUILT

DATE: 01/03/20

DES.	DRN.	CK.	DATE	DESCRIPTION
AVG	AVG	TG	11/23/21	AS-BUILT

SEE SHEET 4 FOR SHARED SEPTIC TREATMENT SYSTEM NOTES.

WATER AND SEWER PLAN	
TITLE SHEET	
PARCEL NO.	34, 38, 39, 111 & 112
800' SCALE MAP NO.	27 & 28 BLOCKNO

**WILLOWSHIRE**

LOTS 1-45, BUILDABLE PRESERVATION PARCEL C, NON-BUILDABLE PRESERVATION PARCEL A, B, D, E-G, L, & NON-BUILDABLE BULK PARCEL H-K

5232 GREEN BRIDGE ROAD  
TAX MAP 27, GRID 18, PARCELS 34, 38, 98, 111 & 112  
5TH ELECTION DISTRICT, ZONED RR-DE0  
HOWARD COUNTY MARYLAND  
CONTRACT NO. 50-5062-D


SCALE AS SHOWN  
SHEET 1 of 5

# FINAL PUBLIC SEWER, FORCE MAIN AND SHARED ONSITE SEWER SYSTEM PLANS FOR WILLOWSHIRE LOTS 23, 38, 39, 40 & 42

## CONTRACT NO.: 50-5062-D

### LOCATION OF SITE


5232 GREEN BRIDGE ROAD  
TAX MAP 27, GRID 18, PARCELS 34, 36, 98, 111 & 112  
5TH ELECTION DISTRICT, ZONED RR-DE0  
HOWARD COUNTY MARYLAND

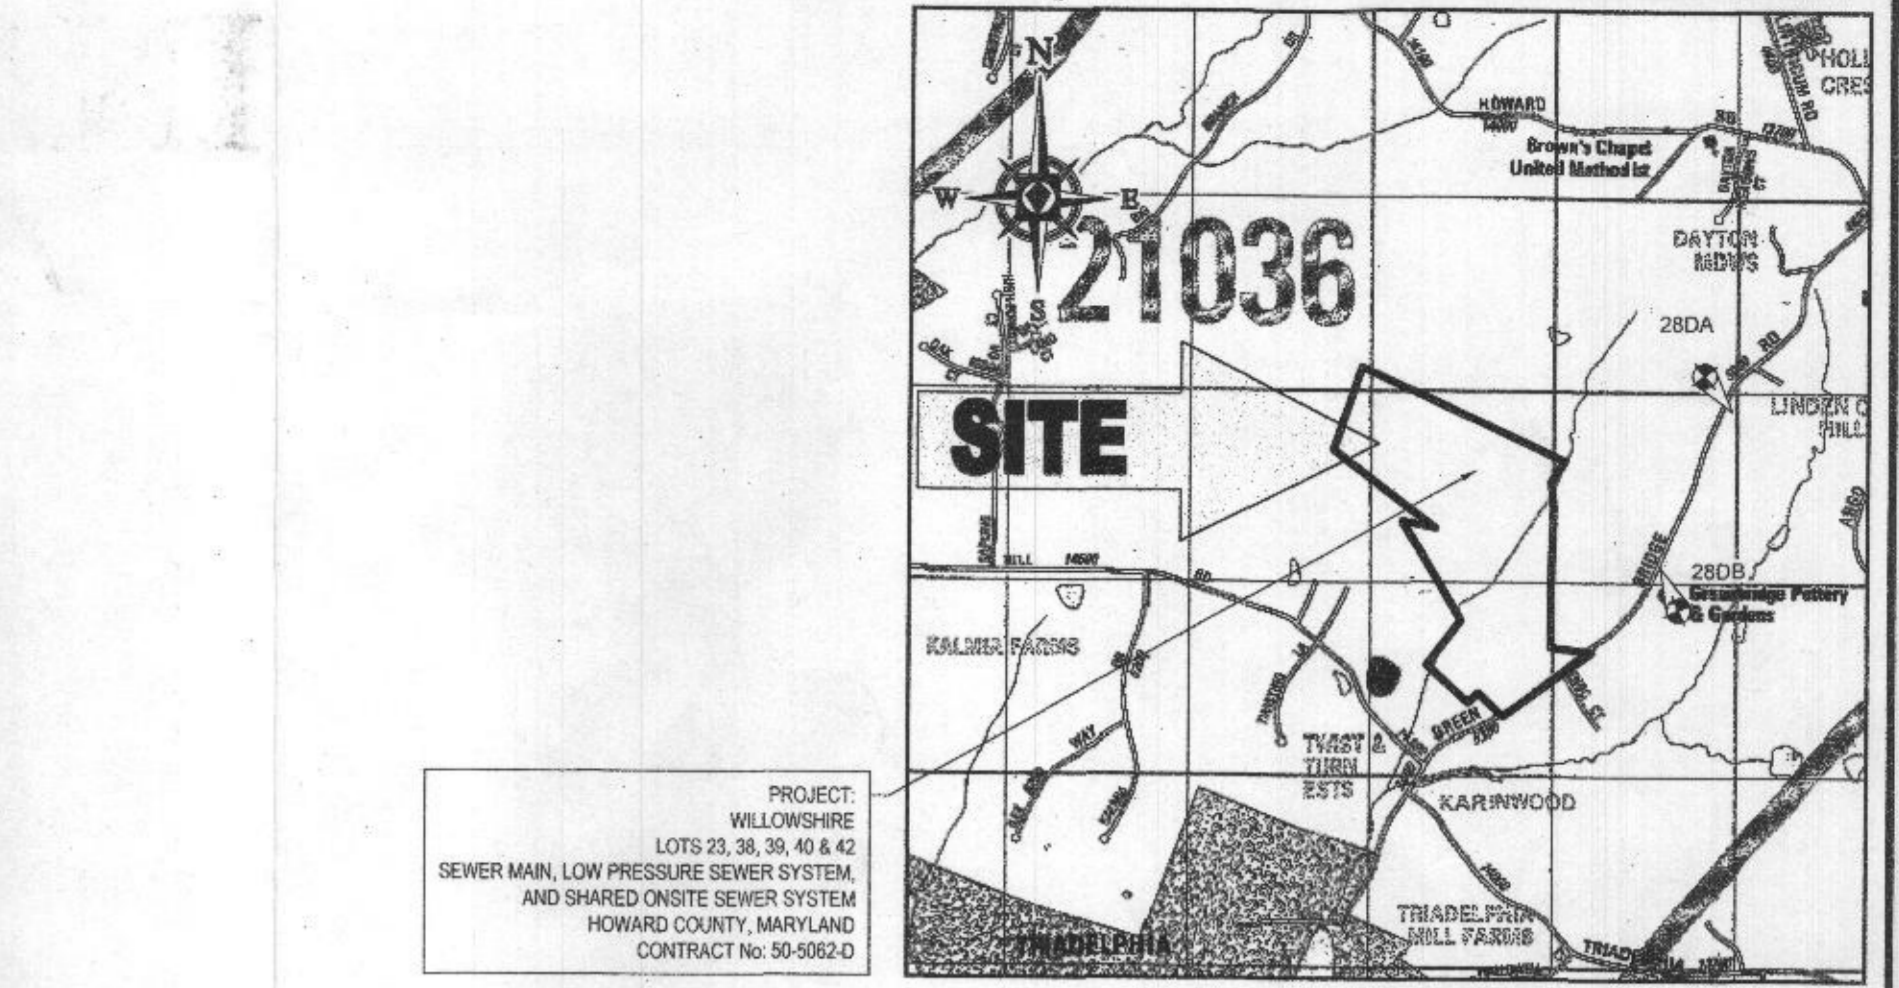

- ### GENERAL NOTES
- APPROXIMATE LOCATIONS OF EXISTING MAINS ARE SHOWN. THE CONTRACTOR SHALL TAKE ALL NECESSARY PRECAUTIONS TO PROTECT EXISTING MAINS AND SERVICES AND MAINTAIN UNINTERRUPTED SERVICE. ANY DAMAGE INCURRED SHALL BE REPAIRED IMMEDIATELY TO THE SATISFACTION OF THE ENGINEER AT THE CONTRACTOR'S EXPENSE.
  - TOPOGRAPHIC FIELD SURVEYS WERE PERFORMED ON APRIL 28, 2015 BY BOHLER ENGINEERING.
  - THE COORDINATES SHOWN HEREON ARE BASED UPON THE HOWARD COUNTY GEODETIC CONTROL WHICH IS BASED UPON THE MARYLAND STATE PLAN COORDINATE SYSTEM. HORIZONTAL AND VERTICAL CONTROL DATUM ARE BASED ON HOWARD COUNTY MONUMENT NOS. 28DA AND 28DB WHICH WERE USED FOR THIS PROJECT.  
HOWARD COUNTY MONUMENT NO. 28DA ELEV. = 564.389'  
HOWARD COUNTY MONUMENT NO. 28DB ELEV. = 537.361'
  - ALL PIPE ELEVATIONS SHOWN ARE INVERT ELEVATIONS UNLESS OTHERWISE NOTED ON THE PLANS.
  - CLEAR ALL UTILITIES BY A MINIMUM OF 12 INCHES. CLEAR ALL POLES BY 5'-0" MINIMUM OR TUNNEL AS REQUIRED UNLESS OTHERWISE NOTED. THE OWNER HAS CONTACTED THE UTILITY COMPANIES AND HAS MADE ARRANGEMENTS FOR BRACING OF POLES AS SHOWN ON THE DRAWINGS. IN THE EVENT THE CONTRACTOR'S WORK REQUIRES THE BRACING OF ADDITIONAL POLES, ANY COST INCURRED BY THE OWNER FOR THE BRACING OF ADDITIONAL POLES OR DAMAGES SHALL BE DEDUCTED FROM MONIES OWED BY THE CONTRACTOR. THE CONTRACTOR SHALL COORDINATE WITH THE UTILITY COMPANIES TO SCHEDULE THE BRACING OF THE POLES.
  - FOR DETAILS NOT SHOWN ON THE DRAWING, AND FOR MATERIALS AND CONSTRUCTION METHODS, USE HOWARD COUNTY DESIGN MANUAL, VOLUME IV, STANDARD SPECIFICATIONS AND DETAILS FOR CONSTRUCTION (LATEST EDITION). THE CONTRACTOR SHALL HAVE A COPY OF VOLUME IV ON THE JOB.
  - WHERE TEST PITS HAVE BEEN MADE ON EXISTING UTILITIES, THEY ARE NOTED BY THE SYMBOL ⊕ AT THE LOCATIONS OF THE TEST PITS. A NOTE OR NOTES CONTAINING THE RESULTS OF THE TEST PIT OR PITS IS INCLUDED ON THE DRAWINGS. EXISTING UTILITIES IN THE VICINITY OF THE PROPOSED WORK FOR WHICH TEST PITS HAVE NOT BEEN DUG SHALL BE LOCATED BY THE CONTRACTOR TWO WEEKS IN ADVANCE OF CONSTRUCTION OPERATIONS AT HIS OWN EXPENSE.
  - THE CONTRACTOR SHALL NOTIFY THE FOLLOWING UTILITY COMPANIES OR AGENCIES AT LEAST FIVE WORKING DAYS BEFORE STARTING WORK SHOWN ON THESE PLANS:  
AT & T 1-800-252-1133  
BOE (CONSTRUCTION SERVICES) 410-637-8713  
BOE (EMERGENCY) 410-685-0123  
BUREAU OF UTILITIES 410-313-4900  
COLONIAL PIPELINE COMPANY 410-795-1390  
MSS UTILITY 1-800-237-7777  
STATE HIGHWAY ADMINISTRATION 410-531-5533  
VEBLEN 1-800-743-0033  
HOWARD COUNTY HEALTH DEPARTMENT OFFICE 410-313-8300
  - TREES AND SHRUBS ARE TO BE PROTECTED FROM DAMAGE TO THE MAXIMUM EXTENT. TREES AND SHRUBS LOCATED WITHIN THE CONSTRUCTION STRIP ARE NOT TO BE REMOVED OR DAMAGED BY THE CONTRACTOR.
  - THE CONTRACTOR SHALL REMOVE TREES, STUMPS, AND ROOTS ALONG THE LINE OF EXCAVATION. PAYMENT FOR SUCH REMOVAL SHALL BE INCLUDED IN THE UNIT PRICE BID FOR CONSTRUCTION OF THE MAIN.
  - THE CONTRACTOR SHALL NOTIFY THE BUREAU OF HIGHWAYS, HOWARD COUNTY, AT (410)313-7450 AT LEAST FIVE WORKING DAYS BEFORE OPEN CUTTING OR BACKFILLING OF ANY COUNTY ROAD FOR LAYING WATERSEWER MAINS OR HOUSE CONNECTIONS. THE APPROVAL OF THESE DRAWINGS WILL CONSTITUTE COMPLIANCE WITH DPW REQUIREMENTS PER SECTION 18.114(A) OF THE HOWARD COUNTY CODE.
  - WAIVER (DMV2-19-09) FROM THE HOWARD COUNTY DESIGN MANUAL VOL. II, WATER AND SEWER SECTION 4.3.8.3.B AND 4.5.E FOR LOTS 23, 38-40 AND 42 (NO BASEMENT GRAVITY SERVICE) HAS BEEN APPROVED BY HOWARD COUNTY DEPARTMENT OF PUBLIC WORKS ON DEC. 14, 2018. AS A RESULT OF TOPOGRAPHY CAUSING DEPTHS OF SEWER IN EXCESS OF 20 FEET, BASEMENT SEWER SERVICE CANNOT BE PROVIDED TO THESE LOT PROPOSED LOTS. FOR THESE LOTS, GRAVITY SEWER SERVICE TO BE PROVIDED TO FIRST FLOOR ONLY. BASEMENT SERVICE TO BE PROVIDED BY PRIVATE ON-SITE PUMP TO BE LOCATED INSIDE THE HOUSE. THE APPROVAL AND INSPECTION OF ON-SITE PUMPING UNITS INCLUDES THE DEPARTMENT OF INSPECTION, LICENSE AND PERMIT (DILP).
  - CONSTRUCTION SHALL CONFORM TO ALL LOCAL, COUNTY AND STATE GUIDELINES, INCLUDING HOWARD COUNTY BUILDING CODES AND RECOMMEND STANDARD FOR WASTEWATER SYSTEMS (2004). DISCREPANCIES SHALL BE REFERRED TO ENGINEER.
  - REFER TO SEPTIC PERMIT APPROVAL FOR SAMPLING PROTOCOLS AND FREQUENCY FOR THE RESPECTIVE SITES. COPY OF THE SEPTIC PERMIT APPROVAL SHALL BE KEPT WITH THE O&M MANUAL.
  - A PRE-CONSTRUCTION MEETING SHALL BE HELD WITH THE MDE (410-537-3680), HOWARD COUNTY HEALTH DEPARTMENT AND BUREAU OF UTILITIES & CONSTRUCTION INSPECTIONS REPRESENTATIVES PRIOR TO STARTING WORK TO REVIEW DESIGN DOCUMENTS AND CONSTRUCTION REQUIREMENTS.
  - AN OPEN TRENCH INSPECTION SHALL BE CONDUCTED PRIOR TO FILLING WITH GRAVEL.
  - THIS AREA DESIGNATES A SEWAGE DISPOSAL AREA OF AT LEAST 10,000 SQ FT PER LOT ON SHARED-SYSTEM AS REQUIRED BY THE MARYLAND DEPARTMENT OF ENVIRONMENT FOR INDIVIDUAL SEWAGE DISPOSAL. IMPROVEMENTS OF ANY NATURE IN THIS AREA ARE RESTRICTED UNTIL PUBLIC SEWERAGE IS AVAILABLE. THESE AREAS SHALL BECOME NULL AND VOID UPON CONNECTION TO A PUBLIC SEWER SYSTEM. THE COUNTY HEALTH OFFICER SHALL HAVE AUTHORITY TO GRANT ADJUSTMENTS TO THE PRIVATE SEWAGE AREA. RECORDATION OF A REVISED SEWAGE EASEMENT SHALL NOT BE NECESSARY.
  - WAIVER (DMV2-20-05) FROM THE HOWARD COUNTY DESIGN MANUAL VOL. II, WATER AND SEWER, SECTION 8.1.E.9.C WHICH REQUIRES "SEPTIC TANKS SIZED (TOTAL CAPACITY) FOR A MINIMUM VOLUME EQUAL TO 1250 GALLONS PER 4-BEDROOM HOUSE, WITH AN ADDITIONAL 250 GALLONS FOR EACH ADDITIONAL BEDROOM. HAS BEEN APPROVED BY HOWARD COUNTY DEPARTMENT OF PUBLIC WORKS ON AUGUST 16, 2019.
  - THE DEVELOPER SHALL CONDUCT QUARTERLY MONITORING OF THE TREATED EFFLUENT DURING THE 12-MONTH PERIOD FOLLOWING 80% OCCUPANCY OF THE LOTS CONNECTED TO THE SHARED SYSTEM. THE SAMPLING AND ANALYSES SHALL BE IN ACCORDANCE WITH MDE GUIDANCE FOR PRE-TREATMENT SYSTEMS WITH GREATER THAN 1000GPD CAPACITY. THIS INCLUDES GRAB SAMPLING EFFLUENT IN THE PUMP TANK WITH LABORATORY ANALYSES OF BOD, TSS, TOTAL NITROGEN (TKN, NITRATE, NITRITE), ALKALINITY, AND FOG. DO, PH, AND TEMPERATURE SHOULD BE FIELD TESTED AS CLOSE TO THE TREATMENT PLANT EFFLUENT PIPE AS POSSIBLE. IF THE EFFLUENT CONSISTENTLY EXCEEDS THE APPROVED DESIGN CRITERIA OR APPLICABLE REGULATORY LIMITS, THE DEVELOPER WILL NOTIFY HCHD, MDE, AND HOBU AND WILL MAKE THE NECESSARY ADJUSTMENTS OR REPAIRS TO THE SYSTEM WITH AGENCY OVERSIGHT PRIOR TO DEDICATION OF THE SYSTEM TO HOWARD COUNTY DEPARTMENT OF PUBLIC WORKS. IF A TREATMENT REDUCTION IN PERCENT IS SPECIFIED, CONCURRENT INFLUENT MONITORING IS REQUIRED.

- ### WATER NOTES:
- WATER SERVICE TO ALL BUILDABLE LOTS SHALL BE PRIVATE AND PROVIDED BY INDIVIDUAL PRIVATE WELLS.
- ### SEWER NOTES:
- ALL SEWER MAINS SHALL BE DIP OR PVC UNLESS OTHERWISE NOTED.
  - ALL MANHOLES SHALL BE 4'-0" INSIDE DIAMETER UNLESS OTHERWISE NOTED.
  - FORCE MAINS SHALL BE D.I.P. ONLY.
  - MANHOLES SHOWN WITH 12" AND 16" WALLS ARE FOR BRICK MANHOLES ONLY.
  - MANHOLES DESIGNATED W.T. IN PLAN AND PROFILE SHALL HAVE WATER-TIGHT FRAME AND COVERS, STANDARD DETAIL 05.52. WHERE WATER-TIGHT FRAME AND COVER IS USED, SET ABOVE FINISHED GRADE UNLESS OTHERWISE NOTED ON THE DRAWINGS.
  - HOUSES WITH THIS SYMBOL, "C.N.S." INDICATES THAT CELLAR CANNOT BE SERVED.
  - LOTS 1 THRU 22, 24 THRU 37, 41, AND 43 THRU 45 SHALL HAVE PRIVATE ON-SITE DISPOSAL SYSTEMS.
  - LOW PRESSURE SEWER PORTION OF THE COLLECTION SYSTEM MUST BE HDPE SDR-11 OR BETTER WITH THERMALLY WELDED JOINTS.
  - A SPARE PUMP WILL BE PROVIDED TO THE COUNTY AT DEDICATION OF THE PUBLIC SANITARY SEWER IMPROVEMENTS.
  - THE FORCE MAIN ELEMENT OF THE SHARED-SEPTIC SYSTEM MUST BE CONSTRUCTED OF FUSIBLE HDPE WHEN PASSING WITHIN 50 FEET OF THE WELL ZONES ON LOTS 22, 23 AND 30.



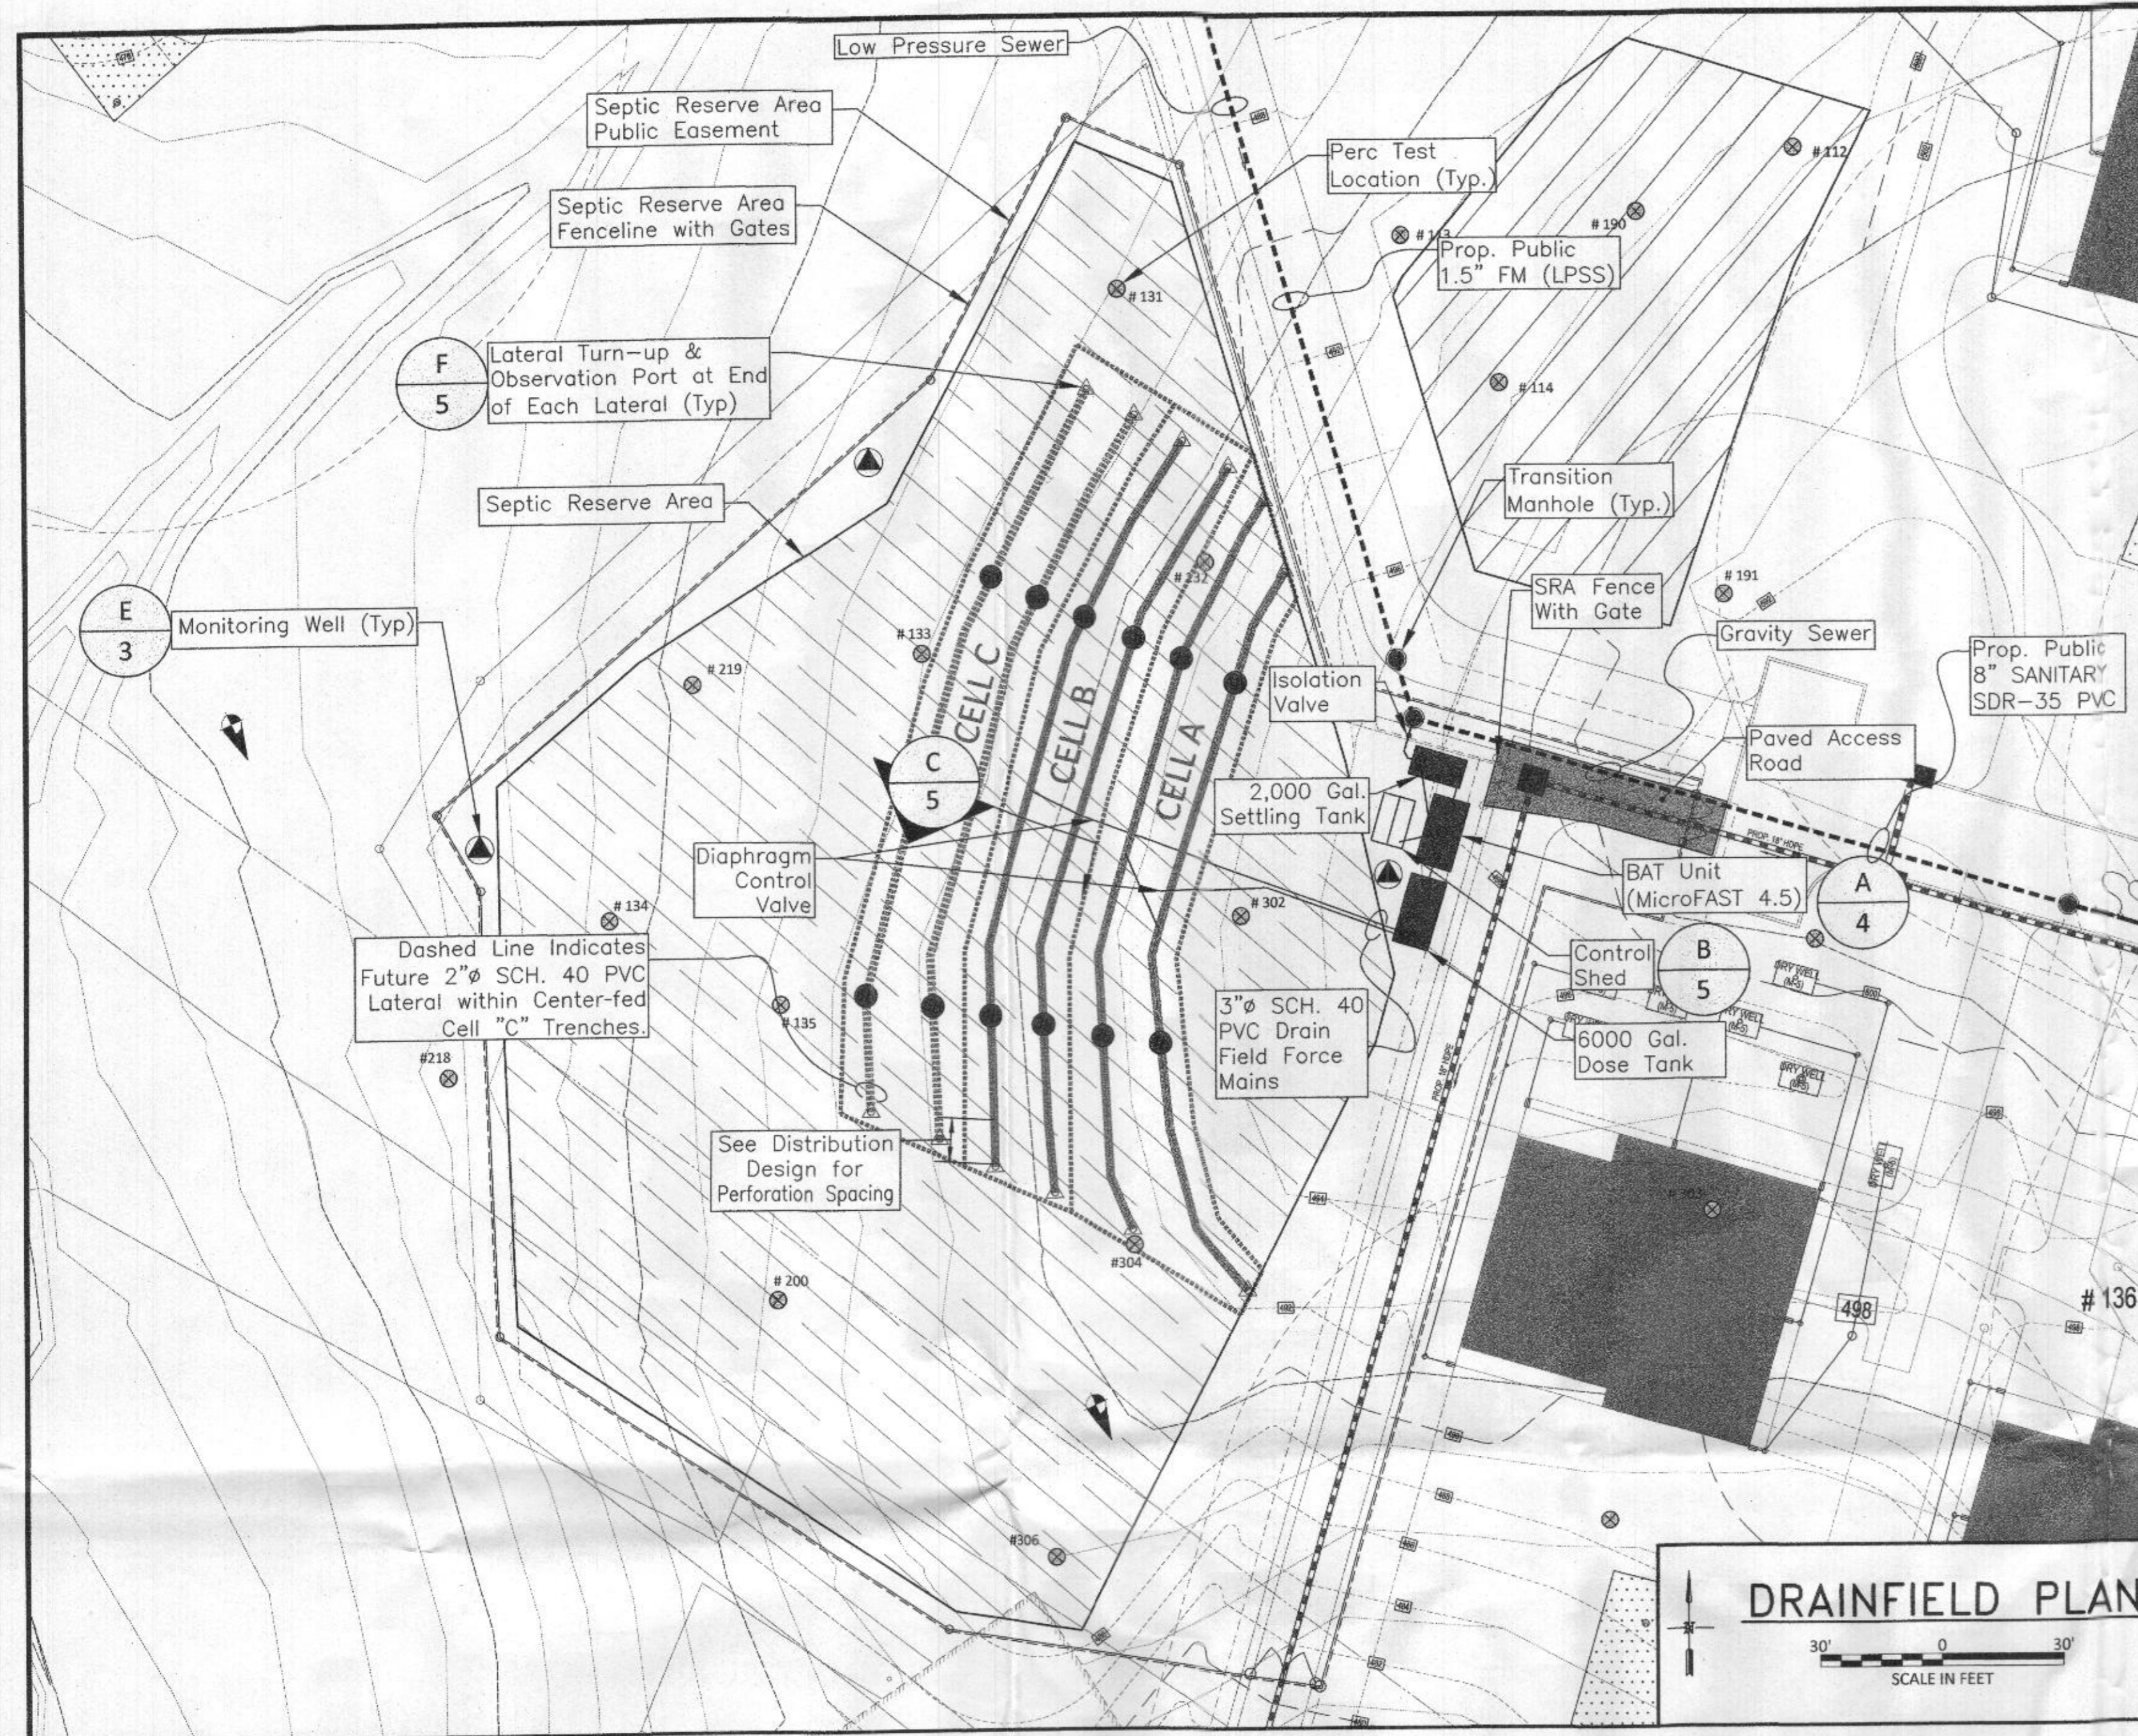

**USE PROJECTIONS**

properties served	5
bedrooms per property	5
flow per bedroom (gpd)	150
ADF (gpd)	3,750
ADF (gpd)	1,875

<b>Design Wastewater Strength</b>	Influent	Effluent
BOD (mg/L)	220	30
TSS (mg/L)	220	30
Total Nitrogen (mg/L as N)	60	30


**Notes**  
*calculated values in italics*  
 ADF = average daily flow  
 MDF = maximum daily flow  
 unit rates from Howard County Well and Septic memo Nov 2014

**USE PROJECTIONS**

**\*All results recorded here are for passed perc testing locations within the septic reserve area**

Test #	Perc Test Depth (feet)	Test Pit Depth (feet)	Limiting Zone Depth (ft)	Perc Rates (min/inch)	Max sidewall height (feet)	Max gravel depth (feet)	Approx. Ground Surface Elevation (feet msl)	Perc Test Depth Elevation (feet msl)	Sidewall Bottom Elevation (feet msl)	Application Rate (gpd/ft <sup>2</sup> )
131	3.5	10.0	2.5	<5	3.5	6.0	486.10	482.6	480.1	1.2
132	4.3	13.5	3	5.0	6.5	9.5	490.82	486.5	481.3	1.2
133	4.3	14.7	2.5	3.3	8.2	10.7	485.96	481.7	475.3	1.2
134	4.1	11.5	3.8	6.0	3.7	7.5	478.74	474.6	471.2	0.8
135	4.2	12.5	2.5	3.1	6.0	8.5	484.75	480.6	476.3	1.2
200	4.0	12.5	2	4.0	6.5	8.5	484.43	480.4	475.9	1.2
218	3.5	8.0	2.8	5.0	1.2	4.0	474.69	471.2	470.7	1.2
219	4.0	9.5	2.2	4.0	3.3	5.5	480.83	476.8	475.3	1.2
302	3.5	13.0	1.8	3.0	7.2	9.0	494.34	490.8	485.3	1.2
304	4.5	13.0	2.2	4.0	6.8	9.0	491.42	486.9	482.4	1.2
306	4.5	12.0	3.3	5.0	4.7	8.0	487.98	483.5	480.0	1.2
112	3.0	11.0	1.7	<5	5.3	7.0	497.19	494.2	490.2	1.2
113	4.3	12.0	2.8	7.0	5.2	8.0	491.09	486.8	483.1	0.8
114	3.7	14.0	2.2	3.0	7.8	10.0	495.87	492.2	485.9	1.2
190	4.0	9.0	1.5	4.0	3.5	5.0	495.40	491.4	490.4	1.2

**PERC TEST RESULTS**

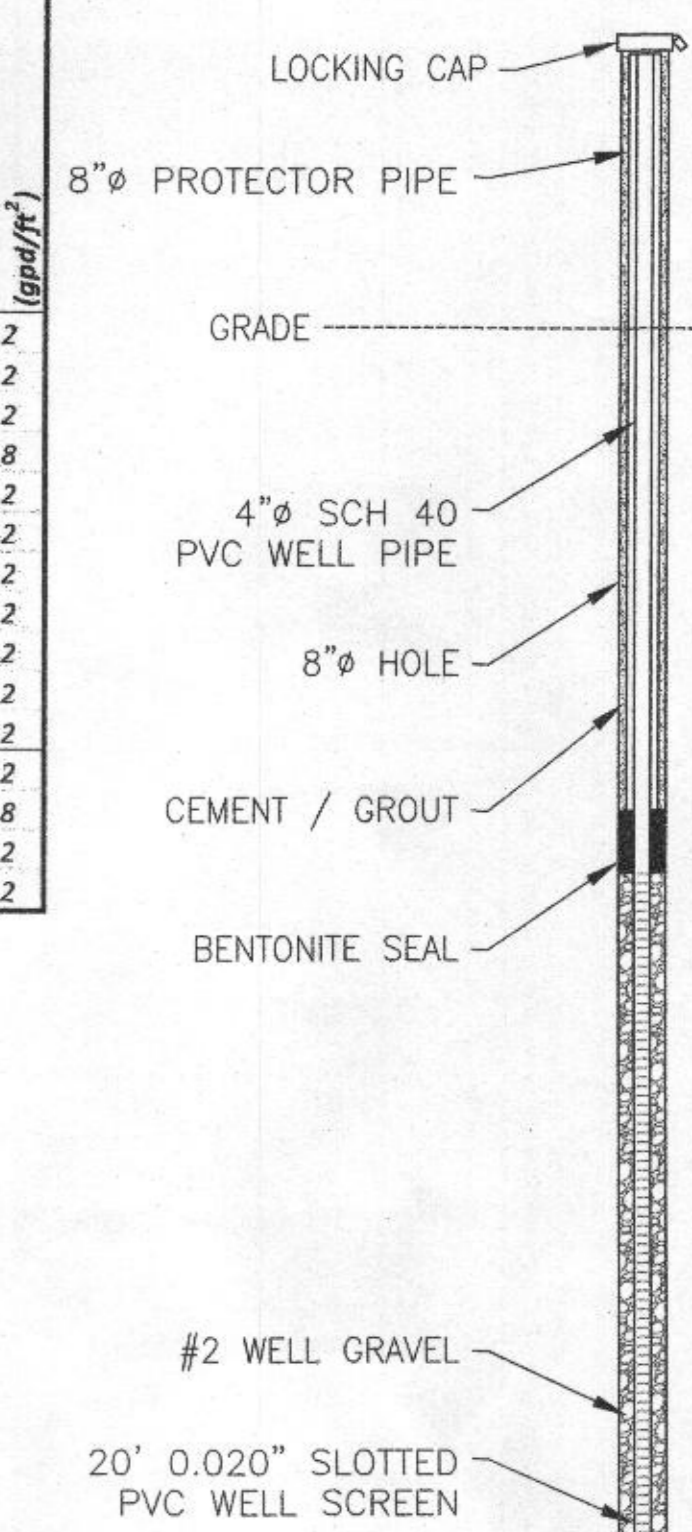

**MONITORING WELL NOTE:**

MONITORING WELLS SHALL BE DRILLED TO A MINIMUM DEPTH OF 15 FEET BELOW THE FIRST ENCOUNTER WITH GROUNDWATER.

**MONITORING WELL**  
NOT TO SCALE

**200% capacity build-out with low pressure distribution system**

Cell	Trench	Existing Ground Elevation (feet msl)	perc ID's	Sidewall Top Elevation (feet msl)	Perc Rate (min/inch)	Sidewall Height (feet)	Sidewall Bottom Elevation (feet msl)	Trench Bottom Depth (feet)	Trench Length (feet)	Trench Width (feet)	Application Rate (gpd/ft <sup>2</sup> )	Capacity (gpd, L*W*AppR/ft <sup>2</sup> )
A	1	492.5	304, 132, 302	489.50	<5	5	484.5	8.0	186	3	1.2	1,875
A	2	491.5	304, 132	488.50	<5	5	483.5	8.0	186	3	1.2	1,875
B	3	490.5	304, 132	487.50	<5	5	482.5	8.0	186	3	1.2	1,875
B	4	489.5	132, 131	486.50	<5	5	481.5	8.0	186	3	1.2	1,875
C	5	488.0	133, 135	485.00	<5	5	480.0	8.0	186	3	1.2	1,875
C	6	487.0	133, 135	484.00	<5	5	479.0	8.0	186	3	1.2	1,875

300% total capacity (gpd) 11,250  
 100% capacity (gpd) 3,750  
 primary capacity, 200% (gpd) 7,500  
 reserve capacity, 100% (gpd) 3,750

*calculated values in italics*  
 gpd = gallons per day  
 NA = not available

msl = mean sea level in feet  
 laterals in each trench are at same elevation


**TRENCHFIELD DESIGN**

**Center feed with 50/50 design**

Cell	Trench	Lateral	Sidewall Top Elevation (feet msl)	Lateral Elevation (feet msl)	Trench Length (feet)	# Holes - Each Lateral	Perf Spacing (feet)	Lateral Length (feet)	Perf Dia (inches)	Perf Flow (gpm)	Lateral Flow (gpm)	Dose Rate (gpm/foot of trench)	Max. Lateral Friction Loss (feet)	Lateral Velocity (feet/second)	Cell Flow (gpm)
A	1	a	489.5	489.5	186	15	6.20	89.9	5/16	2.00	30.0	0.33	0.7	2.9	120
A	1	b	489.5	489.5	186	15	6.20	89.9	5/16	2.00	30.0	0.33	0.7	2.9	120
A	2	a	488.5	489.5	186	15	6.20	89.9	5/16	2.00	30.0	0.33	0.7	2.9	120
A	2	b	488.5	489.5	186	15	6.20	89.9	5/16	2.00	30.0	0.33	0.7	2.9	120
B	3	a	487.5	487.5	186	15	6.20	89.9	5/16	2.00	30.0	0.33	0.7	2.9	120
B	3	b	487.5	487.5	186	15	6.20	89.9	5/16	2.00	30.0	0.33	0.7	2.9	120
B	4	a	486.5	487.5	186	15	6.20	89.9	5/16	2.00	30.0	0.33	0.7	2.9	120
B	4	b	486.5	487.5	186	15	6.20	89.9	5/16	2.00	30.0	0.33	0.7	2.9	120

**Notes**  
*calculated values in italics*  
 gpm = gallons per minute  
 msl = mean sea level in feet  
 Minimum cover over laterals shall be 24".  
 design distal head (feet) = 3.0  
 friction C factor for plastic pipe = 130  
 lateral inside diameter (2" dia sch 40 PVC, in) = 2.067  
 All laterals within a cell shall be at the same elevation.

**DISTRIBUTION DESIGN**

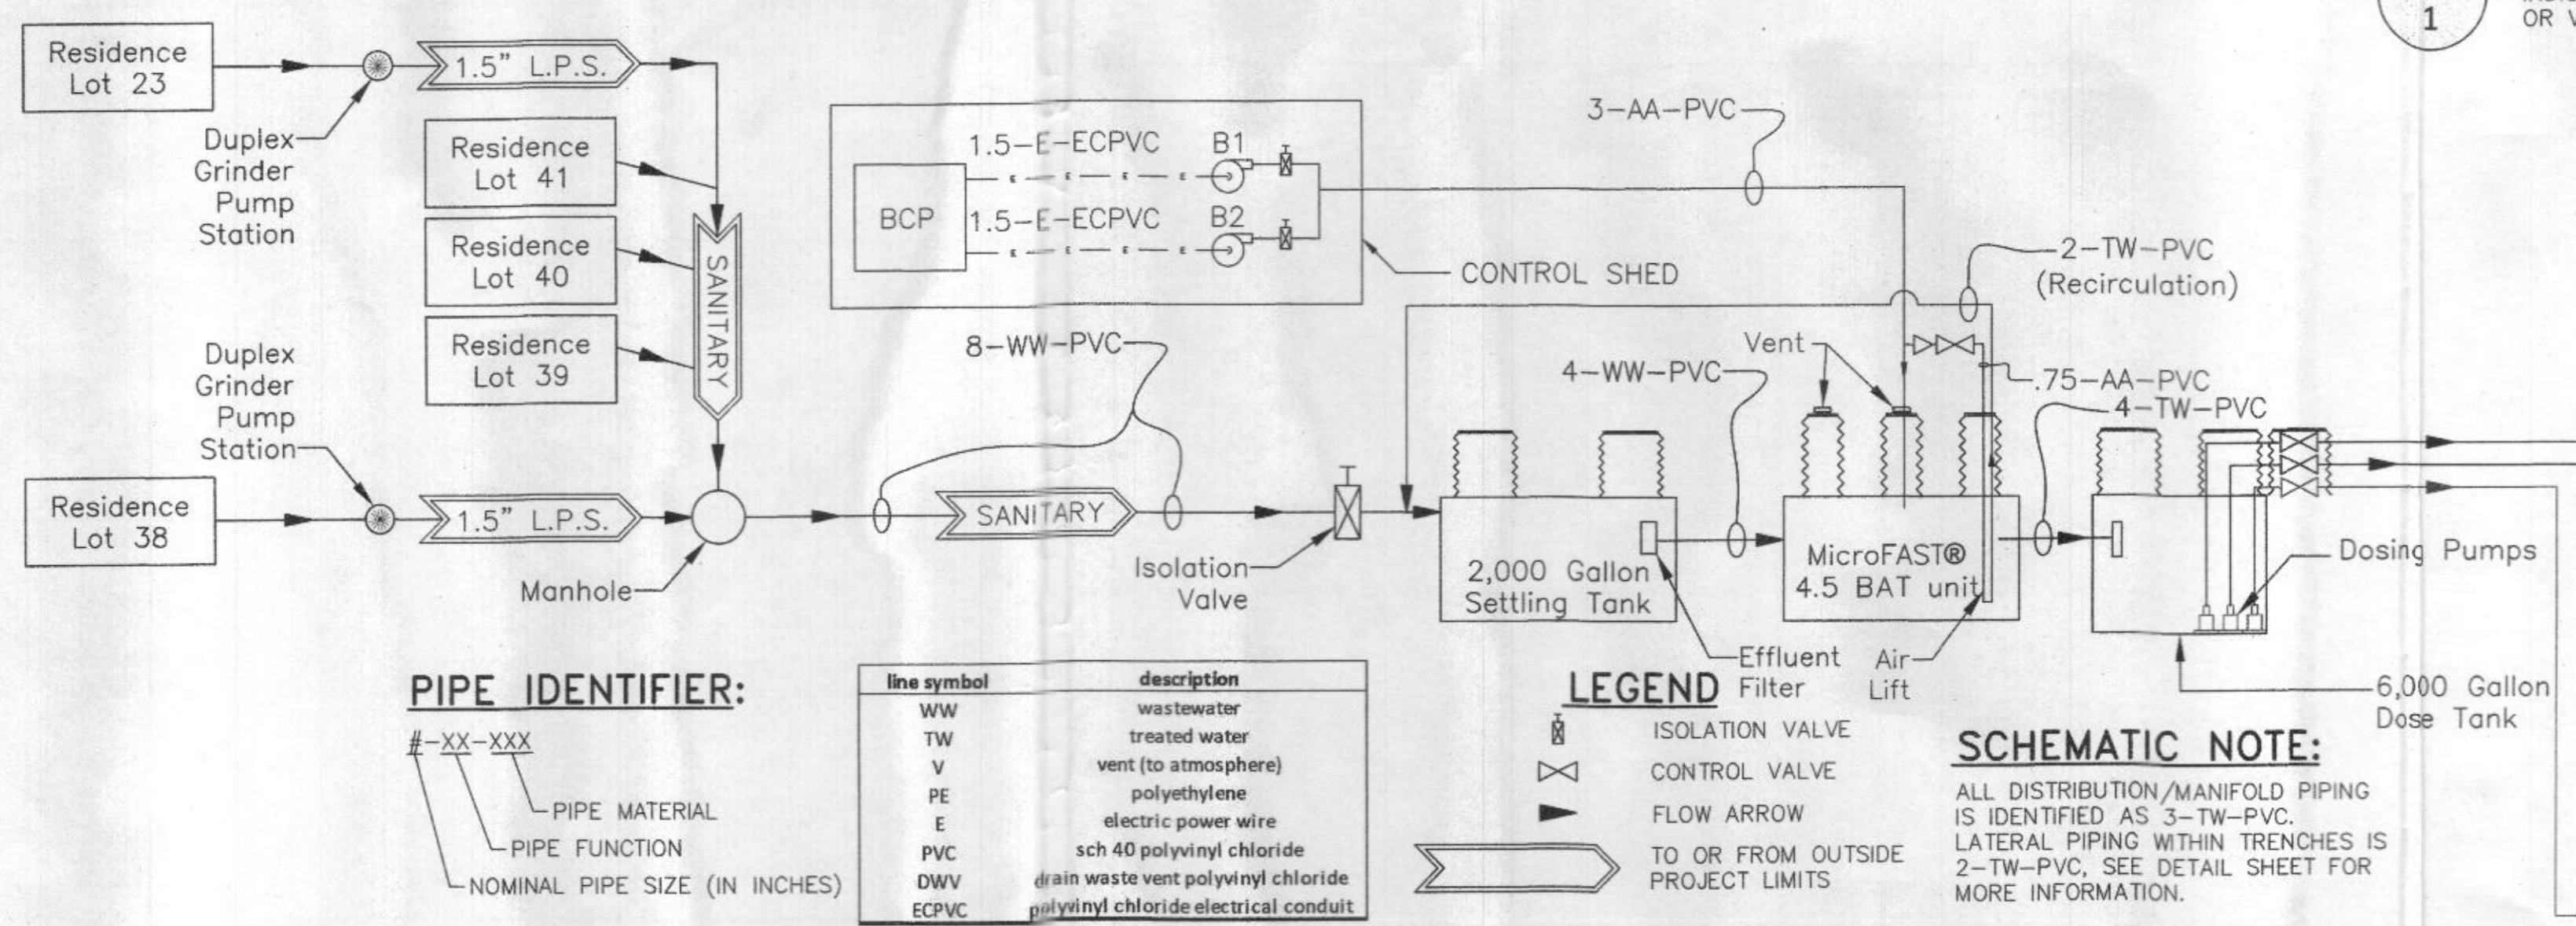

**PIPE IDENTIFIER:**

##-XX-XXX  
 PIPE MATERIAL  
 PIPE FUNCTION  
 NOMINAL PIPE SIZE (IN INCHES)

line symbol	description
WW	wastewater
TW	treated water
V	vent (to atmosphere)
PE	polyethylene
E	electric power wire
PVC	sch 40 polyvinyl chloride
DWV	drain waste vent polyvinyl chloride
ECPCV	polyvinyl chloride electrical conduit

**LEGEND**


ISOLATION VALVE  
 CONTROL VALVE  
 FLOW ARROW  
 TO OR FROM OUTSIDE PROJECT LIMITS

**SCHEMATIC NOTE:**  
 ALL DISTRIBUTION/MANIFOLD PIPING IS IDENTIFIED AS 3-TW-PVC. LATERAL PIPING WITHIN TRENCHES IS 2-TW-PVC. SEE DETAIL SHEET FOR MORE INFORMATION.

**P&ID Key Notes**

part symbol	component	size	notes	material	#
ST	settling tank	2000 gal	(2) 30" dia PE manholes	concrete	1
TT	treatment tank	4240 gal	Biomicrobics MicroFAST 4.5	concrete	1
DT	dose tank	6000 gal	(2) 30" dia PE manholes	concrete	1
B1-2	blower	2" disch.	Spencer Turbine (1 duty, 1 spare)	var.	2
P1-3	dose pump	2" disch.	Goulds W507BHF (2 duty, 1 spare)	cast iron	3
T1-T6	trenches per plan	3' wide	8' total depth, 5' sidewall, 186' long each		6

**P&ID KEY NOTES**

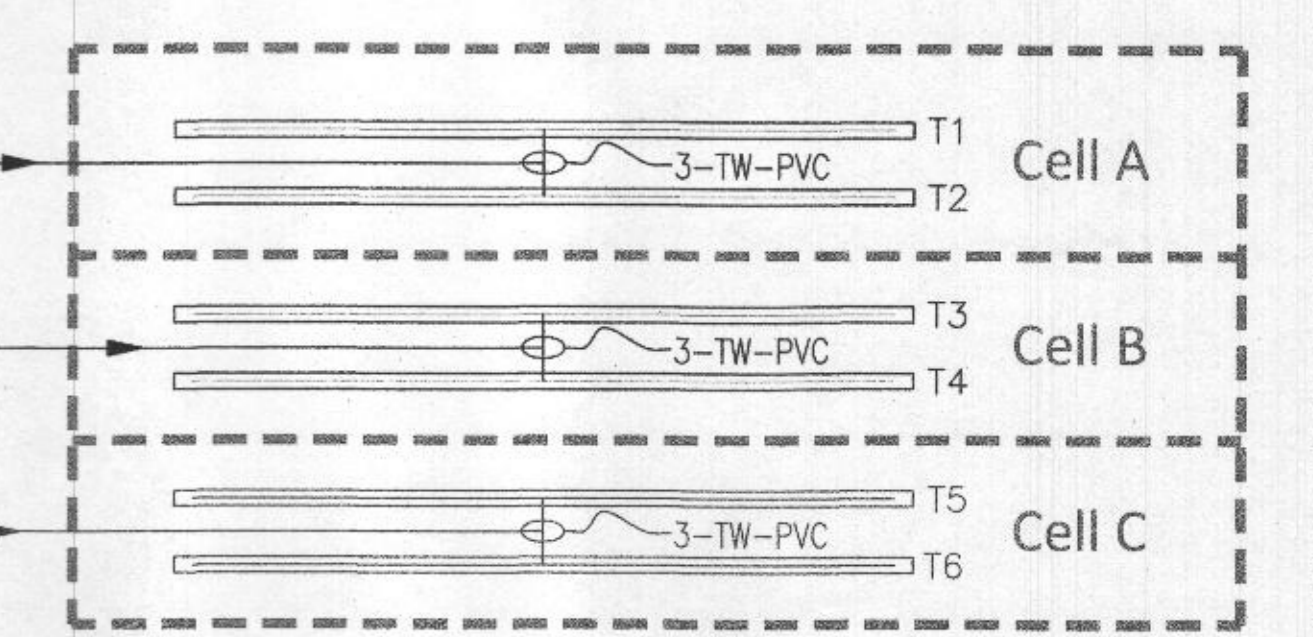

**WASTEWATER TREATMENT SYSTEM SCHEMATIC**  
NO SCALE

APPROVED FOR PRIVATE WATER AND SHARED SEWER SYSTEM FOR LOTS 23, 38, 39, 40 & 42

APPROVED FOR MAURA ROSSMAN 2/12/2020  
 HOWARD COUNTY HEALTH OFFICER DATE

DEPARTMENT OF PUBLIC WORKS HOWARD COUNTY, MARYLAND  
 CHIEF, BUREAU OF UTILITIES DATE 1-15-2020

DEPARTMENT OF PLANNING & ZONING HOWARD COUNTY, MARYLAND  
 CHIEF, DEVELOPMENT ENGINEERING DIVISION DATE 2-19-20

THE FOLLOWING STATES REQUIRE NOTIFICATION BY EXCAVATORS, DESIGNERS, OR ANY PERSON PREPARING TO DISTURB THE EARTH'S SURFACE: ARIZONA, ARKANSAS, CALIFORNIA, DELAWARE, FLORIDA, GEORGIA, ILLINOIS, INDIANA, IOWA, KANSAS, KENTUCKY, LOUISIANA, MARYLAND, MASSACHUSETTS, MICHIGAN, MINNESOTA, MISSISSIPPI, MISSOURI, MONTANA, NEBRASKA, NEVADA, NEW HAMPSHIRE, NEW JERSEY, NEW YORK, NORTH CAROLINA, NORTH DAKOTA, OHIO, OKLAHOMA, PENNSYLVANIA, RHODE ISLAND, SOUTH CAROLINA, SOUTH DAKOTA, TEXAS, UTAH, VERMONT, VIRGINIA, WISCONSIN, WYOMING.

Hydro-Terra Group  
 1105 Business Parkway South  
 Suite E  
 Westminster, Maryland 21157  
 (410) 861-5376 (phone)  
 (410) 861-9467 (fax)

PROFESSIONAL ENGINEER  
 MARYLAND LICENSE NO. 6020  
 PROFESSIONAL CERTIFICATION  
 I, MARK J. MAZZOCCHETTI, HEREBY CERTIFY THAT THESE DOCUMENTS WERE PREPARED OR APPROVED BY ME, AND THAT I AM A DAILY LICENSED PROFESSIONAL ENGINEER UNDER THE LAWS OF THE STATE OF MARYLAND. LICENSE NO. 6020, EXPIRATION DATE: 12/31/21

DES: MJM	DATE: 1/2/2020
DRN: MDS	REV. DATE DESCRIPTION
CK: MDH	BY

Water and Sewer Plans	PARCEL NO. 34, 36, 98, 111 & 112
DRAINFIELD PLAN	800' SCALE MAP NO. 27 & 28 BLOCK NO.

**WILLOWSHIRE**  
 LOTS 1-45, BUILDABLE PRESERVATION PARCEL C, NON-BUILDABLE PRESERVATION PARCEL A, B, E-G & L, NON-BUILDABLE BULK PARCEL D & H-K

5232 GREEN BRIDGE ROAD  
 TAX MAP 27, GRID 18, PARCELS 34, 36, 98, 111 & 112  
 5TH ELECTION DISTRICT  
 HOWARD COUNTY MARYLAND  
 CONTRACT NO.: 50-5062-D

SCALE: As Noted  
 SHEET: 3 OF 5

**SHARED SEPTIC TREATMENT SYSTEM NOTES**

- ALL INSPECTION, VIEWING AND PUMP OUT PORTS MUST BE SECURED TO PREVENT ACCIDENTAL OR UNAUTHORIZED ACCESS.
- CONCRETE SHALL BE 5,000 P.S.I.
- NO MORE THAN 3' OF FILL SHALL BE PLACED OVER ANY TANK LID. ALL TANKS SHALL BE SET UPON 6" TO 8" OF GRAVEL BEDDING.
- TANK MEASUREMENTS AND ELEVATIONS ARE BASED ON SEPTIC TANKS AND PUMP CHAMBERS AS MANUFACTURED BY GILLESPIE PRECAST, LLC (1-800-638-6884). TANKS FROM ALTERNATIVE MANUFACTURERS MAY BE USED. ALL TANK SHOP DRAWINGS SHALL BE SUBMITTED FOR ENGINEER'S APPROVAL PRIOR TO FABRICATION.
- ALL NEW TANKS SHALL BE TESTED FOR WATER TIGHTNESS PRIOR TO BACKFILLING. A VACUUM AIR TEST IS AN ACCEPTABLE METHOD.
- BLOWER PIPING TO FAST MAY NOT EXCEED 100 FT TOTAL LENGTH AND USE 45° ELBOWS MAXIMUM. BLOWER MUST BE LOCATED ABOVE FLOOD/STANDING WATER LEVELS ON A CONCRETE BASE 28" X 42" X 2" MINIMUM OR WITHIN CONTROL SHED.
- VENT TO BE LOCATED ABOVE FINISHED GRADE TO AVOID INFILTRATION. VENTILATION AREA SHALL BE PROVIDED PER MANUFACTURER'S SPECIFICATION. SECURE WITH STAINLESS STEEL SCREWS.
- ALL APPURTENANCES TO FAST UNIT SHALL CONFORM TO ALL PLUMBING AND ELECTRICAL CODES.
- ALL VALVES AND QUICK CONNECTS WITHIN PORTS SHALL BE ACCESSIBLE FROM FINISHED GRADE AND SHALL NOT REQUIRE TANK ENTRY FOR SERVICE. ALL PUMPS SHALL HAVE SAFETY ROPES.
- REMOTE MONITORING SYSTEM (RMS) SHALL AUTOMATICALLY NOTIFY THE COUNTY IN THE EVENT OF A PUMP FAILURE OR HIGH WATER ALARM. REMOTE NOTIFICATION SHALL BE ROUTINELY TESTED AS PART OF REGULAR O&M.
- TWO BLOWERS SHALL BE PROVIDED BY THE TREATMENT SYSTEM MANUFACTURER AND SHALL EACH BE CAPABLE OF CONTINUOUS DUTY AT THE DESIGN VALUES, WITH ONE BLOWER SERVING AS AN INSTALLED SPARE. BLOWER SHALL BE BY SPENCER TURBINE, INC.
- ONE CONTROL PANEL SHALL BE PROVIDED FOR BLOWER CONTROL. BLOWER CONTROL PANEL SHALL HAVE A GASKETED, HINGED, LOCKABLE DOOR; DOOR-MOUNTED BLOWER ON-OFF SWITCHES; AND ALARM LIGHTS/SILENCERS. CONTROL PANEL SHALL BE BY SJE RHOMBUS OR APPROVED EQUAL.

Design Input		Calculations	
<b>Primary and Secondary Treatment and Equalization</b>			
settling tank capacity (gallons per inch)	44.9	maximum daily flow (MDF) (gpd)	3,750
normal settling tank fluid level (inches)	45	average daily flow (ADF) (gpd)	1,875
		recommended minimum settling tank volume (gal)	1,875
		normal settling tank volume (gal)	2,020
<b>Static Hydraulic Profile (with invert elevations)</b>			
influent invert elev. (feet msl)	491.80	From Bohler	
dose tank influent invert elev. (feet msl)	490.88		
dose tank floor elev. (feet msl)	484.88		
dose pump elev. (feet msl)	485.38		
Cell A lateral elev. (feet msl)	489.50	Cell A in-service lift (feet)	4.1
Cell B lateral elev. (feet msl)	487.50	Cell B in-service lift (feet)	2.1
<b>Drainfield Dosing</b>			
cell A flow (gpm)	120	force main velocity (feet/second)	5.2
Cell A force main length (feet)	78	Cell A force main friction loss (feet)	4.7
Cell A minor loss equivalent lengths (feet)	44.4	Cell A max. total dynamic head (feet)	12.5
		Cell A main volume (gal)	30
		Cell A total lateral volume (gal)	63
		Cell A dose vol. @ main + 5x lateral (gal)	343
cell B flow (gpm)	120	force main velocity (feet/second)	5.2
Cell B force main length (feet)	100	Cell B force main friction loss (feet)	5.5
Cell B minor loss equivalent lengths (feet)	44.4	Cell B max. total dynamic head (feet)	11.4
		Cell B main volume (gal)	38
		Cell B total lateral volume (gal)	63
		Cell B dose vol. @ main + 5x lateral (gal)	352
dose tank length (inches)	192	dose tank capacity (gal)	5,745
dose tank width (inches)	96	dose tank capacity (gals per inch)	79.8
dose tank height to invert (inches)	72	design dose volume (gals)(Cell B)	352
# cells in service	2	effective dose volume (gals)	399
lag pump on (inches)	27	min # daily doses @ ADF	5.3
high water alarm height (inches)	25	average dose time (minutes)	2.9
lead pump on (inches)	23	dose off time setting (hours)	4.5
low water cutoff (inches)	18	residual settling volume (gal)	1,436
Pump model (Goulds)	WS07BHF	volume above high water alarm (gal)	3,750
min. tank height above invert (inches)	9		
dose pump control panel model (SJE Rhombus)	IFS 41W-4H-4A 8AC 10E 19F		
Notes gpd = gallons per day gpm = gallons per minute msl = mean sea level in feet calculated values in italics wet floats based on weight +/- 3" one cell is always in service, with the other resting design distal head (feet)= 3.0 friction C factor for plastic pipe= 130 force main ID (3" dia sch40PVC, in)= 3.069 lateral inside diameter (2" dia sch40PVC, in)= 2.067			

**DESIGN INPUT**

APPROVED FOR PRIVATE WATER AND SHARED SEWER SYSTEM FOR LOTS 23, 38, 39, 40 & 42

Howard County Health Officer  
 1-15-2020  
 DATE

DEPARTMENT OF PUBLIC WORKS HOWARD COUNTY, MARYLAND  
 CHIEF, BUREAU OF UTILITIES  
 DATE




DEPARTMENT OF PLANNING & ZONING HOWARD COUNTY, MARYLAND  
 CHIEF, DEVELOPMENT ENGINEERING DIVISION  
 DATE

Elevation I.D.	Elevation (Feet; MSL)
A	Varies (497'-498')
B	491.80
C	486.22
D	491.55
E	491.30
F	486.22
G	491.13
H	490.88
I	484.88
J	484.38

Elevations for Pipes refer to invert.

DOSE PUMP TANK FLOAT	SETTING (Inches from Tank Bottom)
LAG PUMP ON	27
HIGH WATER	25
LEAD PUMP ON	23
LOW WATER CUT-OFF	18

Float settings are based upon tank dimensions indicated. If different tanks are used, float settings shall be adjusted accordingly.

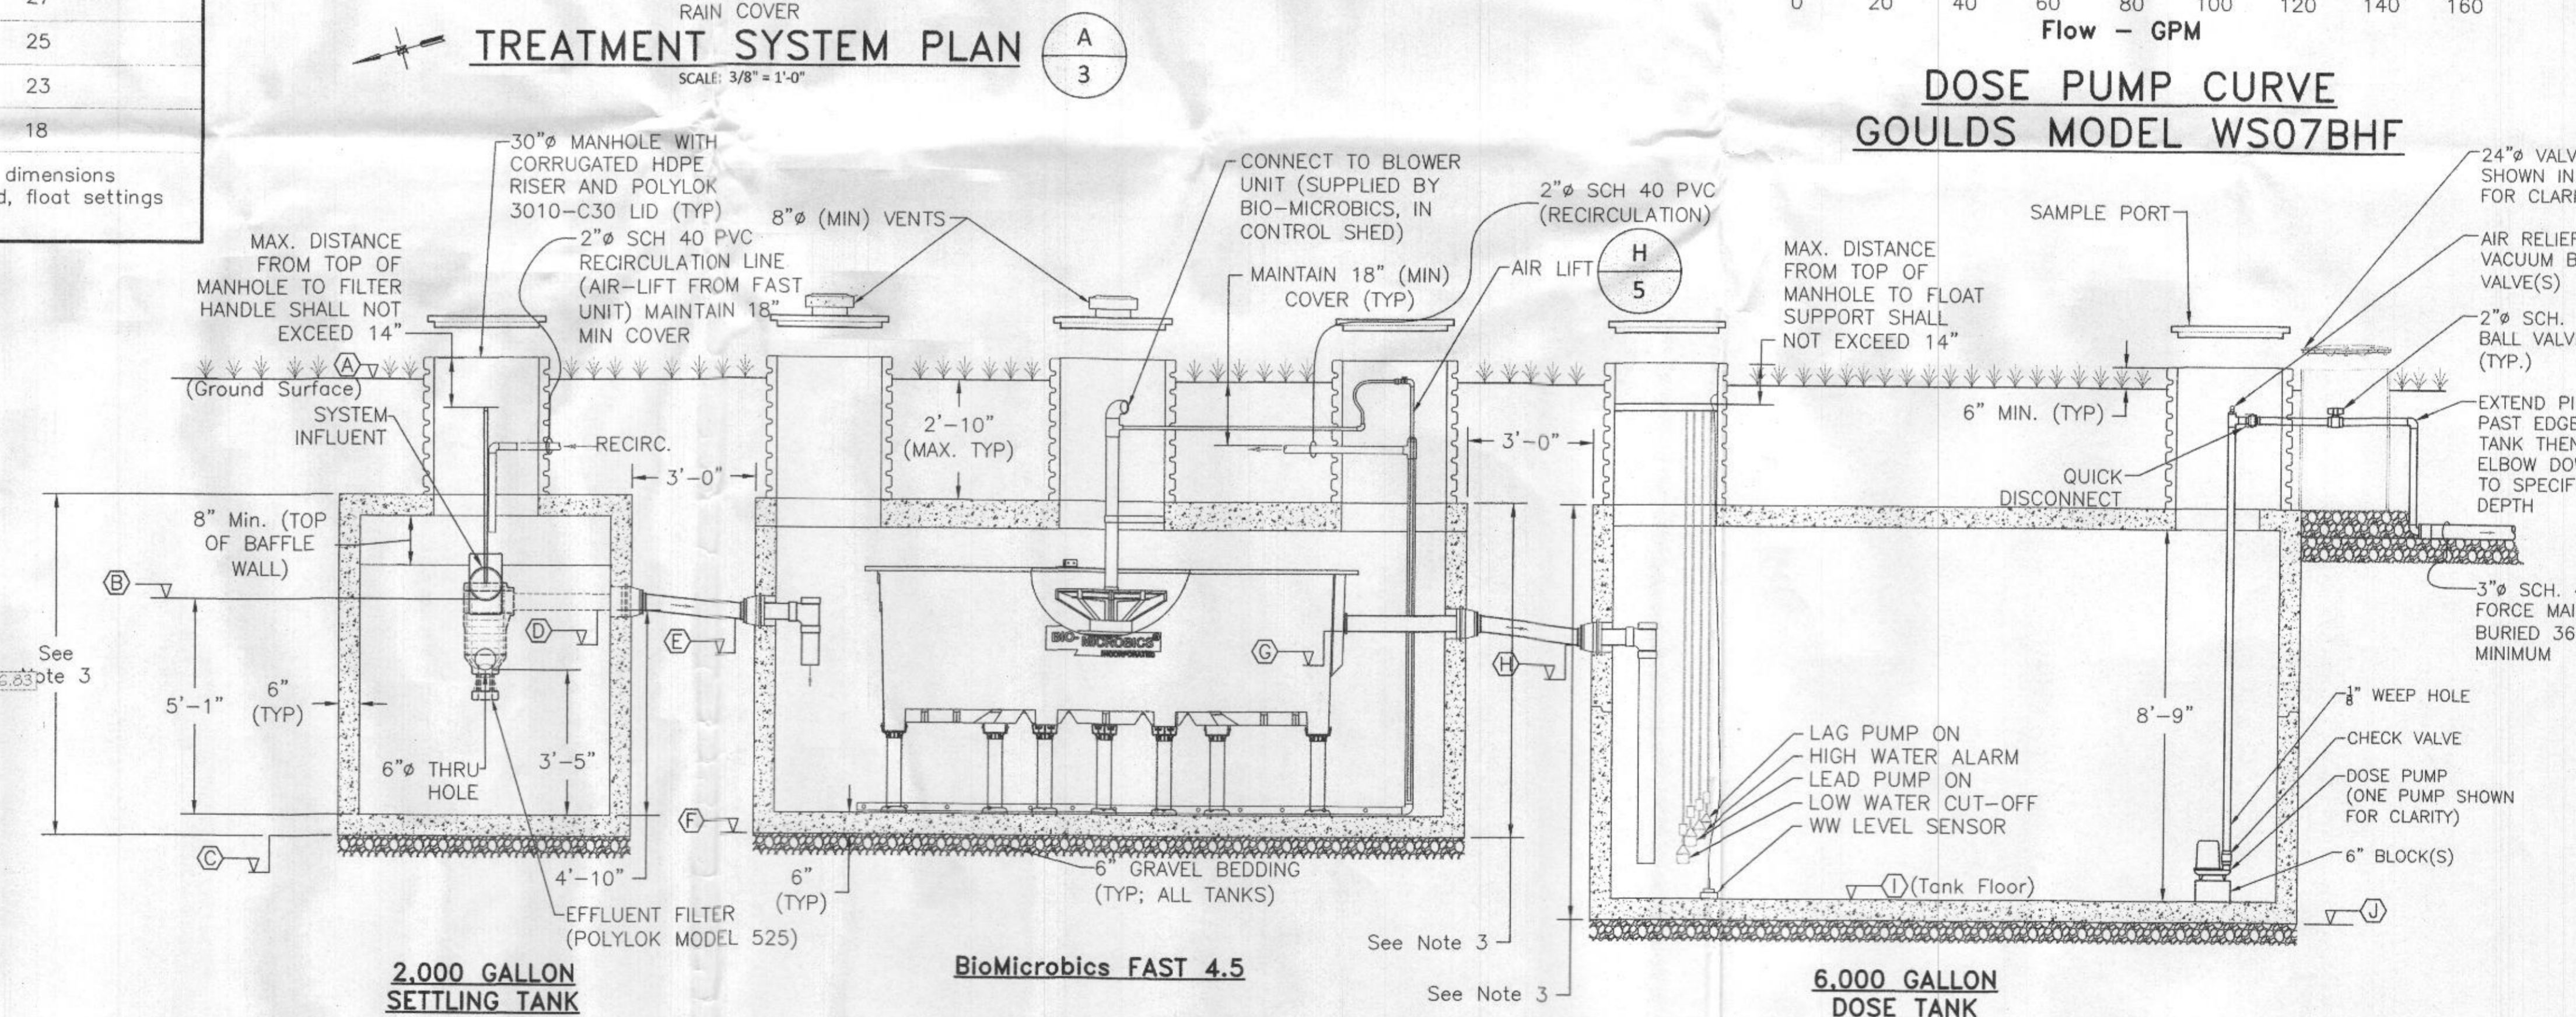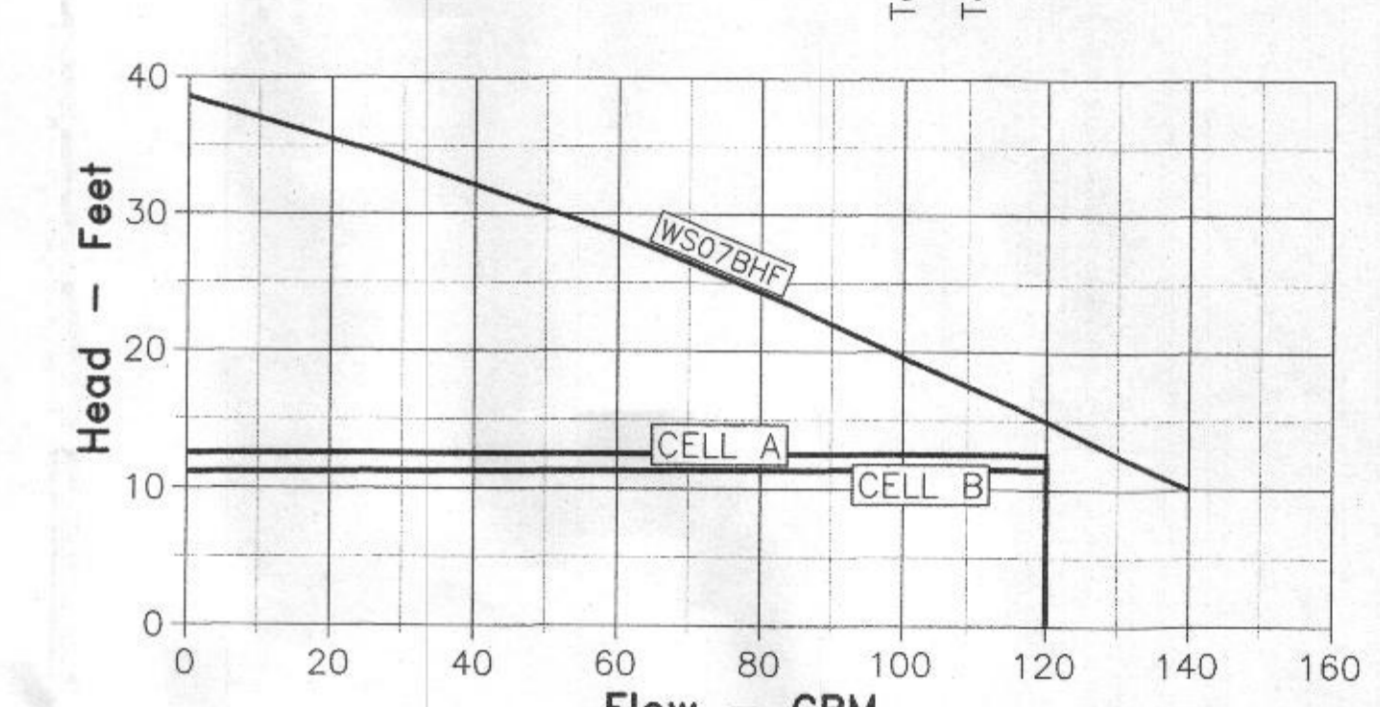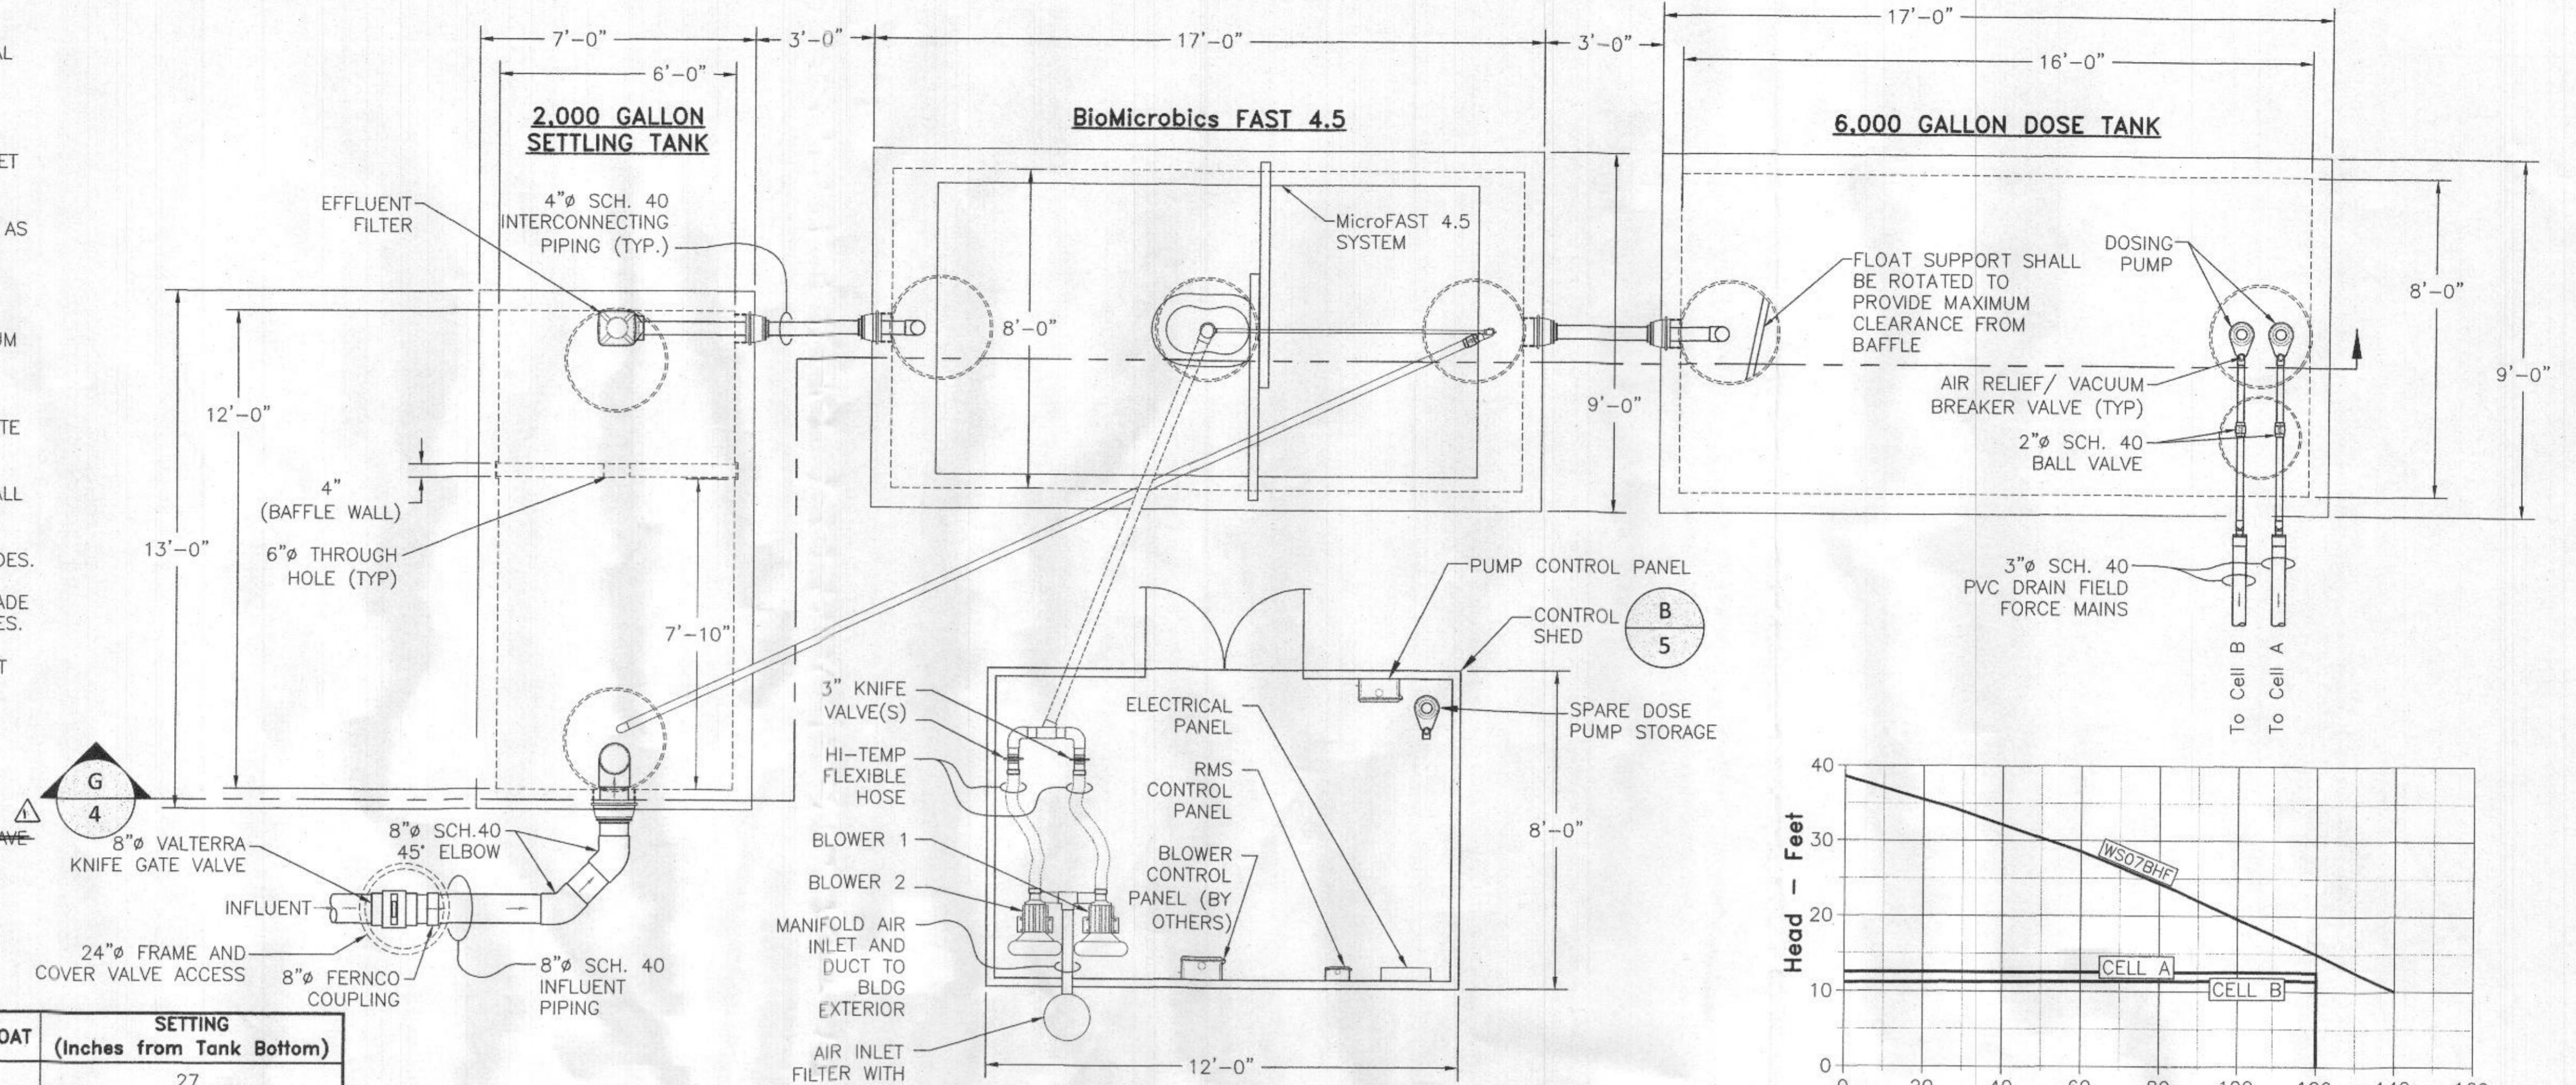

DEPARTMENT OF PUBLIC WORKS HOWARD COUNTY, MARYLAND  
 CHIEF, BUREAU OF UTILITIES  
 DATE

DEPARTMENT OF PLANNING & ZONING HOWARD COUNTY, MARYLAND  
 CHIEF, DEVELOPMENT ENGINEERING DIVISION  
 DATE

Hydro-Terra Group  
 1106 Business Parkway South  
 Suite E  
 Westminster, Maryland 21157  
 (410) 861-5376 (phone)  
 (410) 861-5467 (fax)

PROFESSIONAL ENGINEER  
 MARYLAND LICENSE NO. 8020  
 PROFESSIONAL CERTIFICATION  
 I AM A LICENSED PROFESSIONAL ENGINEER  
 WHOSE DESIGN AND CONSTRUCTION OF THESE  
 DOCUMENTS WERE PREPARED OR APPROVED BY ME, AND  
 THAT I AM A DULY LICENSED PROFESSIONAL ENGINEER  
 UNDER THE LAWS OF THE STATE OF MARYLAND.  
 LICENSE NO. 8020 EXPIRATION DATE: 12/31/2025


DES: MUM  
 DRN: MDS  
 CK: MDH  
 DATE: 1/3/2020

REV	DATE	DESCRIPTION	BY
2	1/24/22	A5-BUILT	S4L
1	1/23/21	A5-BUILT	W/RA

Water and Sewer Plans  
**TREATMENT SYSTEM DETAIL**  
 PARCEL NO. 34, 38, 98, 111 & 112  
 600' SCALE MAP NO. 27 & 28 BLOCK NO.

**WILLOWSHIRE**  
 LOTS 1-45, BUILDABLE PRESERVATION PARCEL C, NON-BUILDABLE PRESERVATION PARCEL A, B, E-G & L, NON-BUILDABLE BULK PARCEL D & H-K  
 5232 GREEN BRIDGE ROAD  
 TAX MAP 27, GRID 18, PARCELS 34, 38, 98, 111 & 112  
 5TH ELECTION DISTRICT  
 HOWARD COUNTY MARYLAND  
 CONTRACT NO. 50-5062-D


SCALE  
 As Noted  
 SHEET  
**4 of 5**

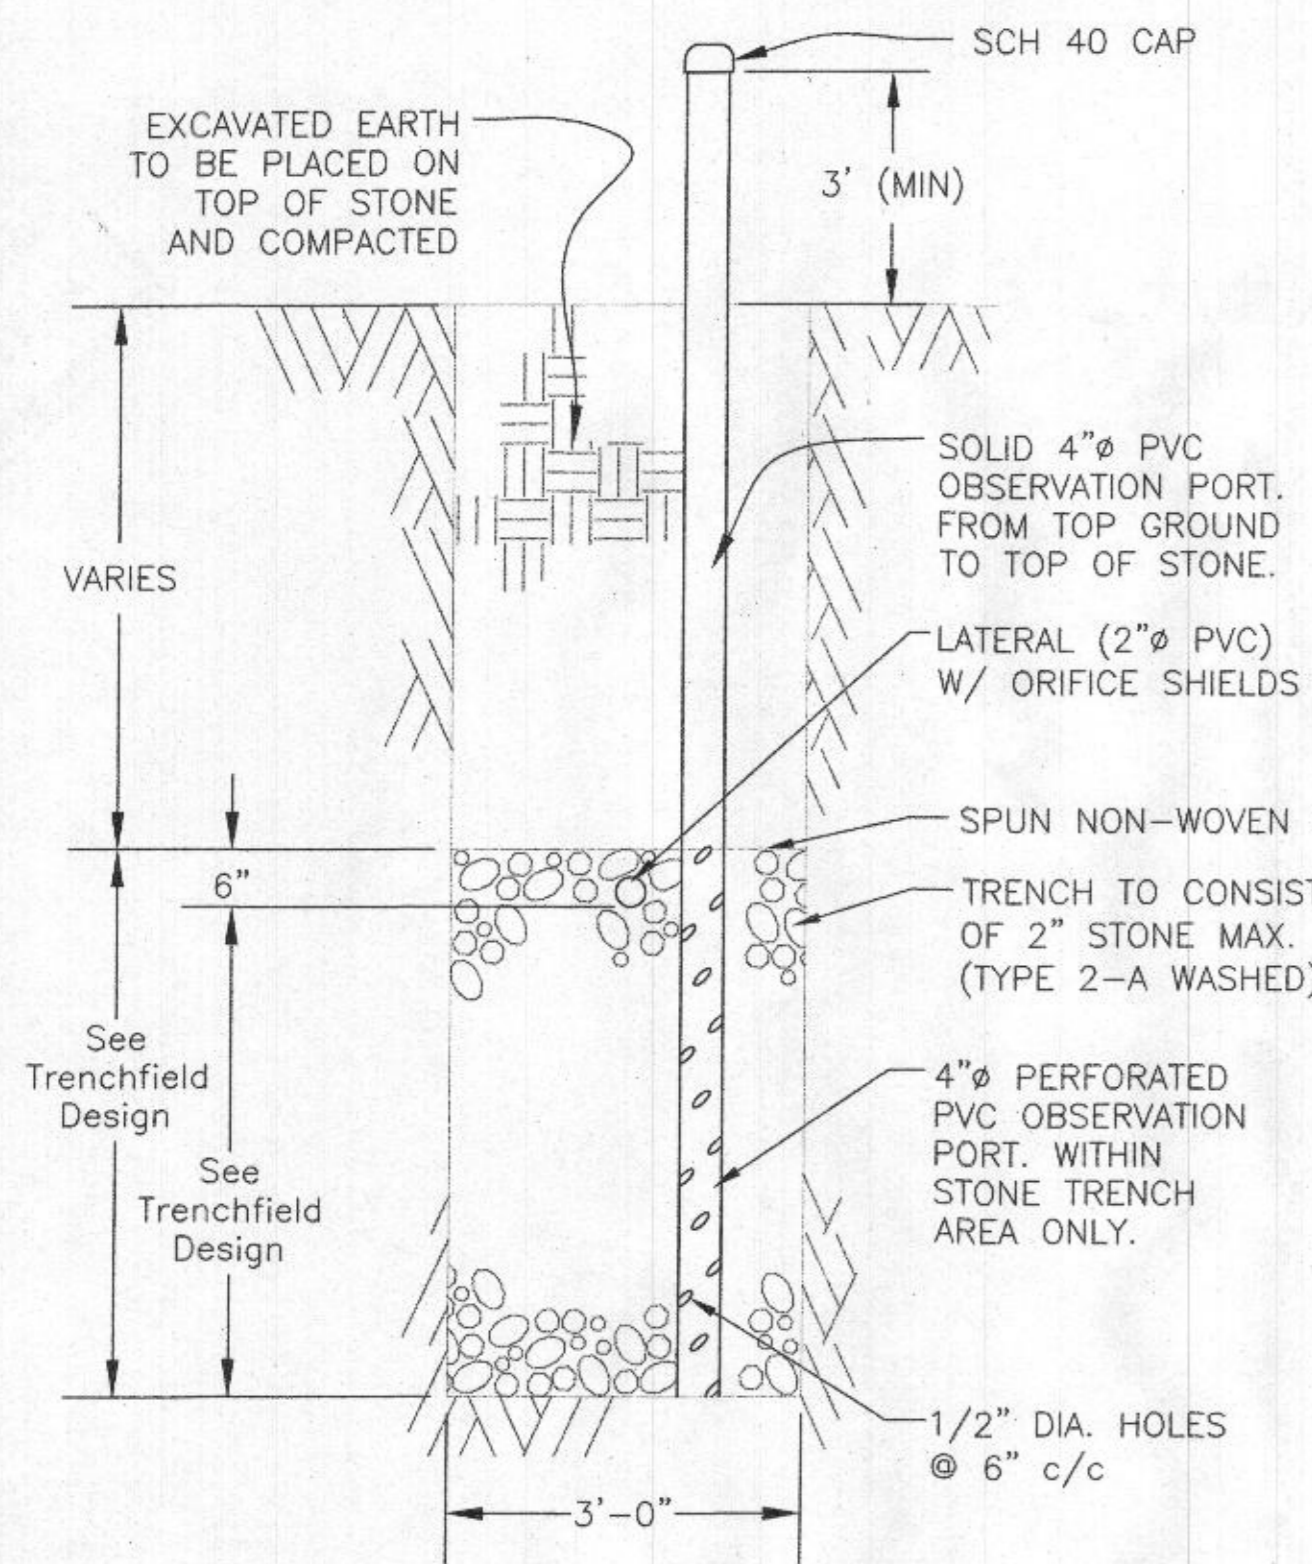


**TYPICAL OBSERVATION PORT** (F 3)  
NOT TO SCALE

**FEED LINE NOTES:**


- ALL HOLES (EXCEPT LAST) ARE FACE DOWN AND PROTECTED WITH ORIFICE DIFFUSER (SEE DETAIL THIS SHEET)
- SEE DRAINFIELD CONSTRUCTION TABLE FOR TRENCH DIMENSIONS AND LATERAL PERFORATIONS NOT SHOWN.
- DRAINFIELD FORCE MAINS AND MANIFOLDS SHALL BE CONSTRUCTED WITH NO "LOW POINTS" AND SHALL DRAIN COMPLETELY TO LATERALS AT PUMP CYCLE TERMINATION.

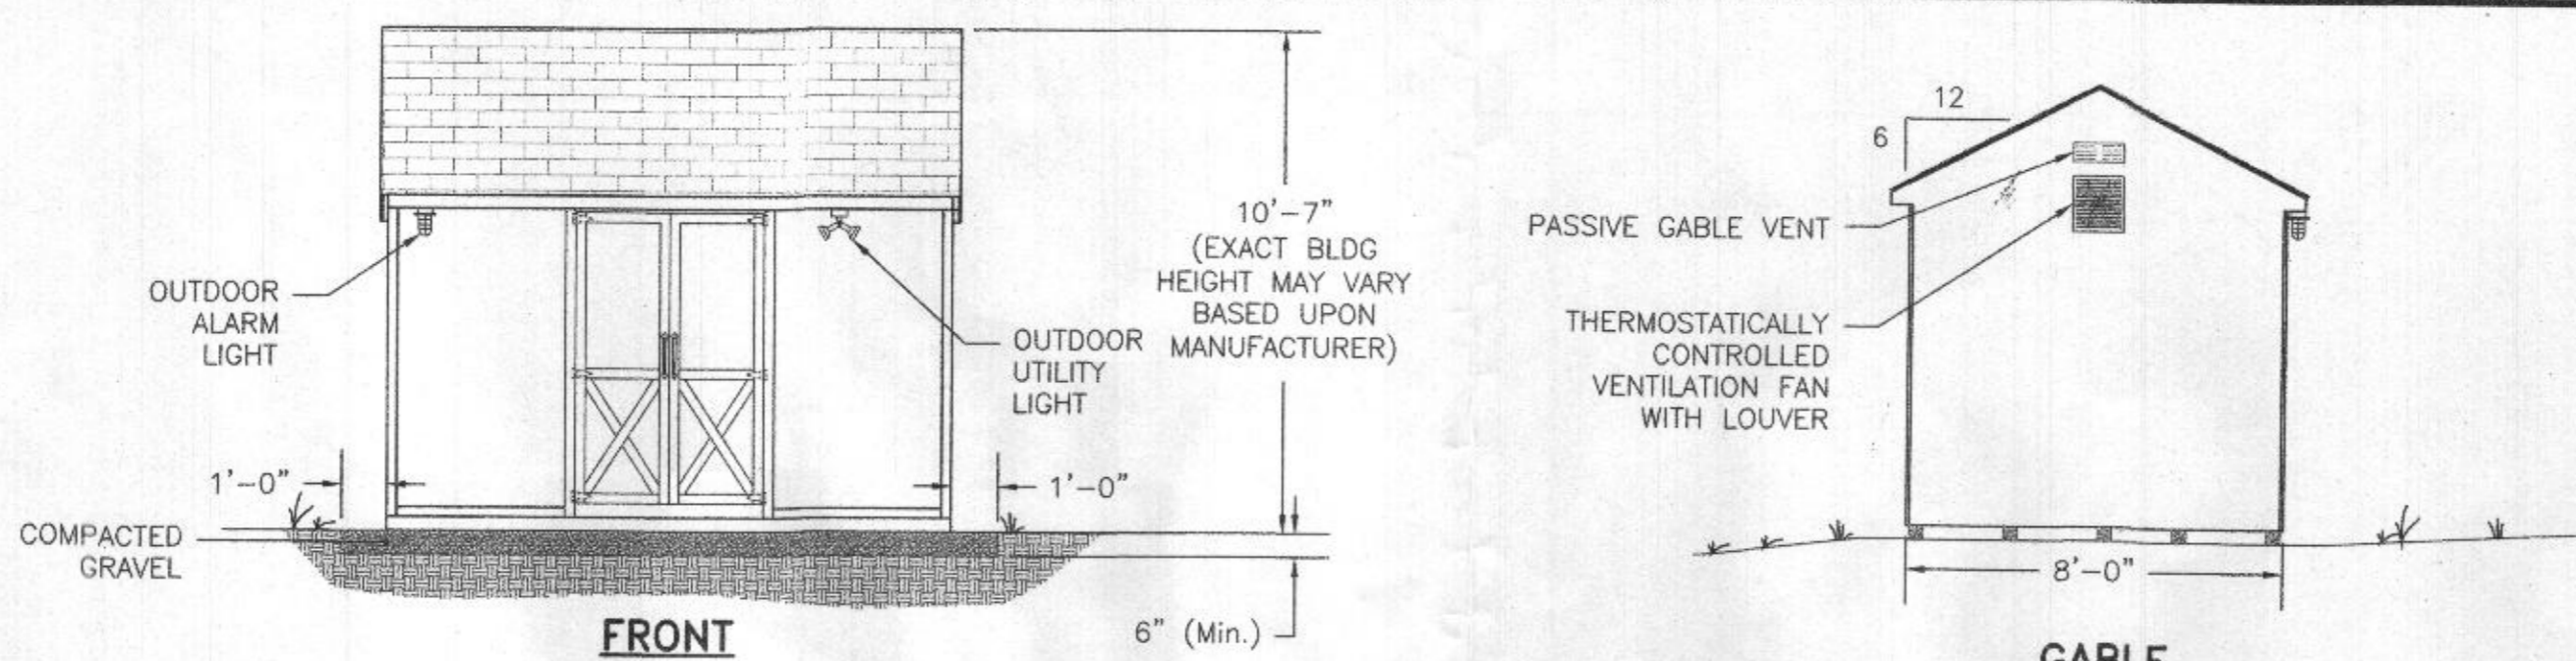

**CONTROL SHED ELEVATION** (B 3, B 4)  
NOT TO SCALE

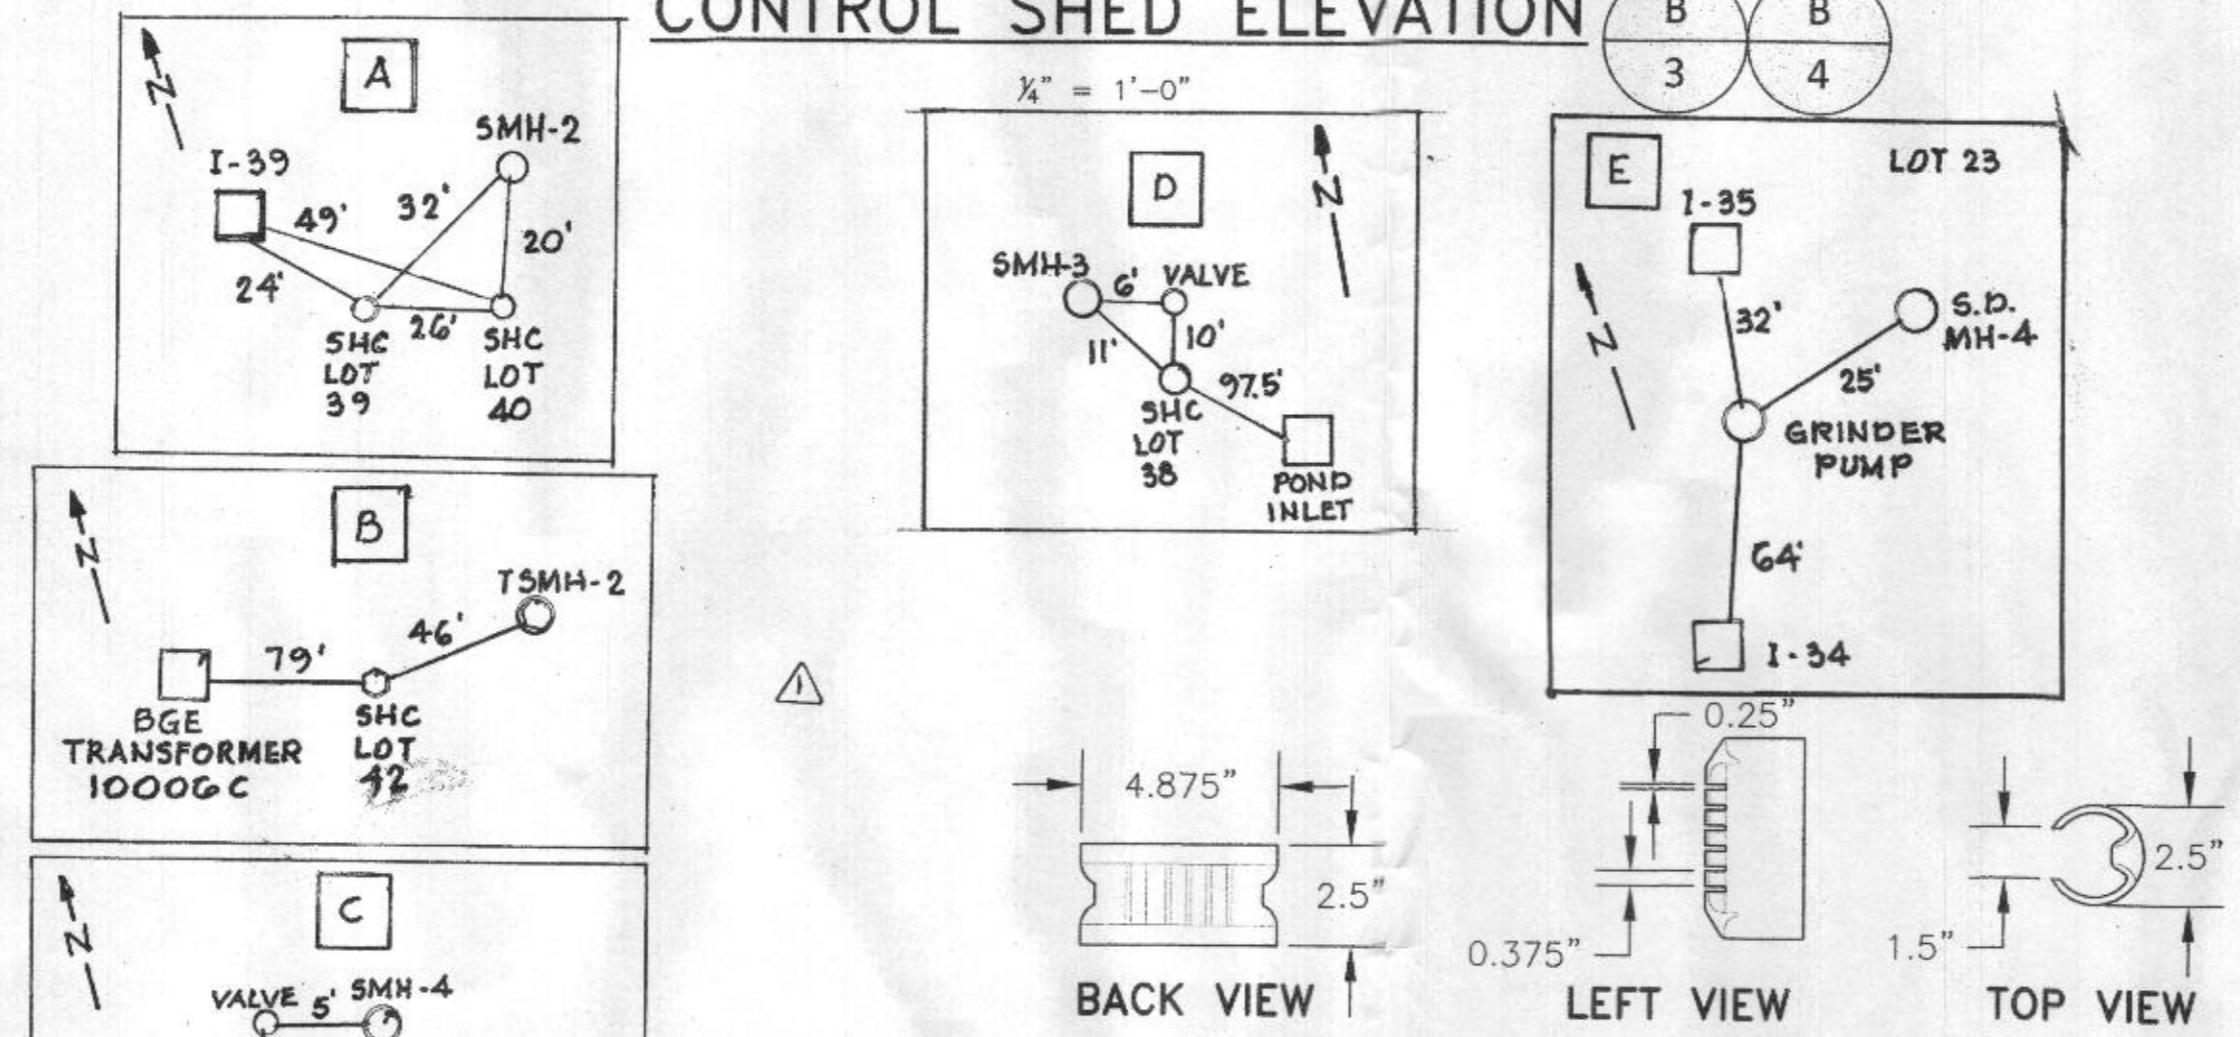


**SIM TECH ORIFICE SHIELD 2\"/>**

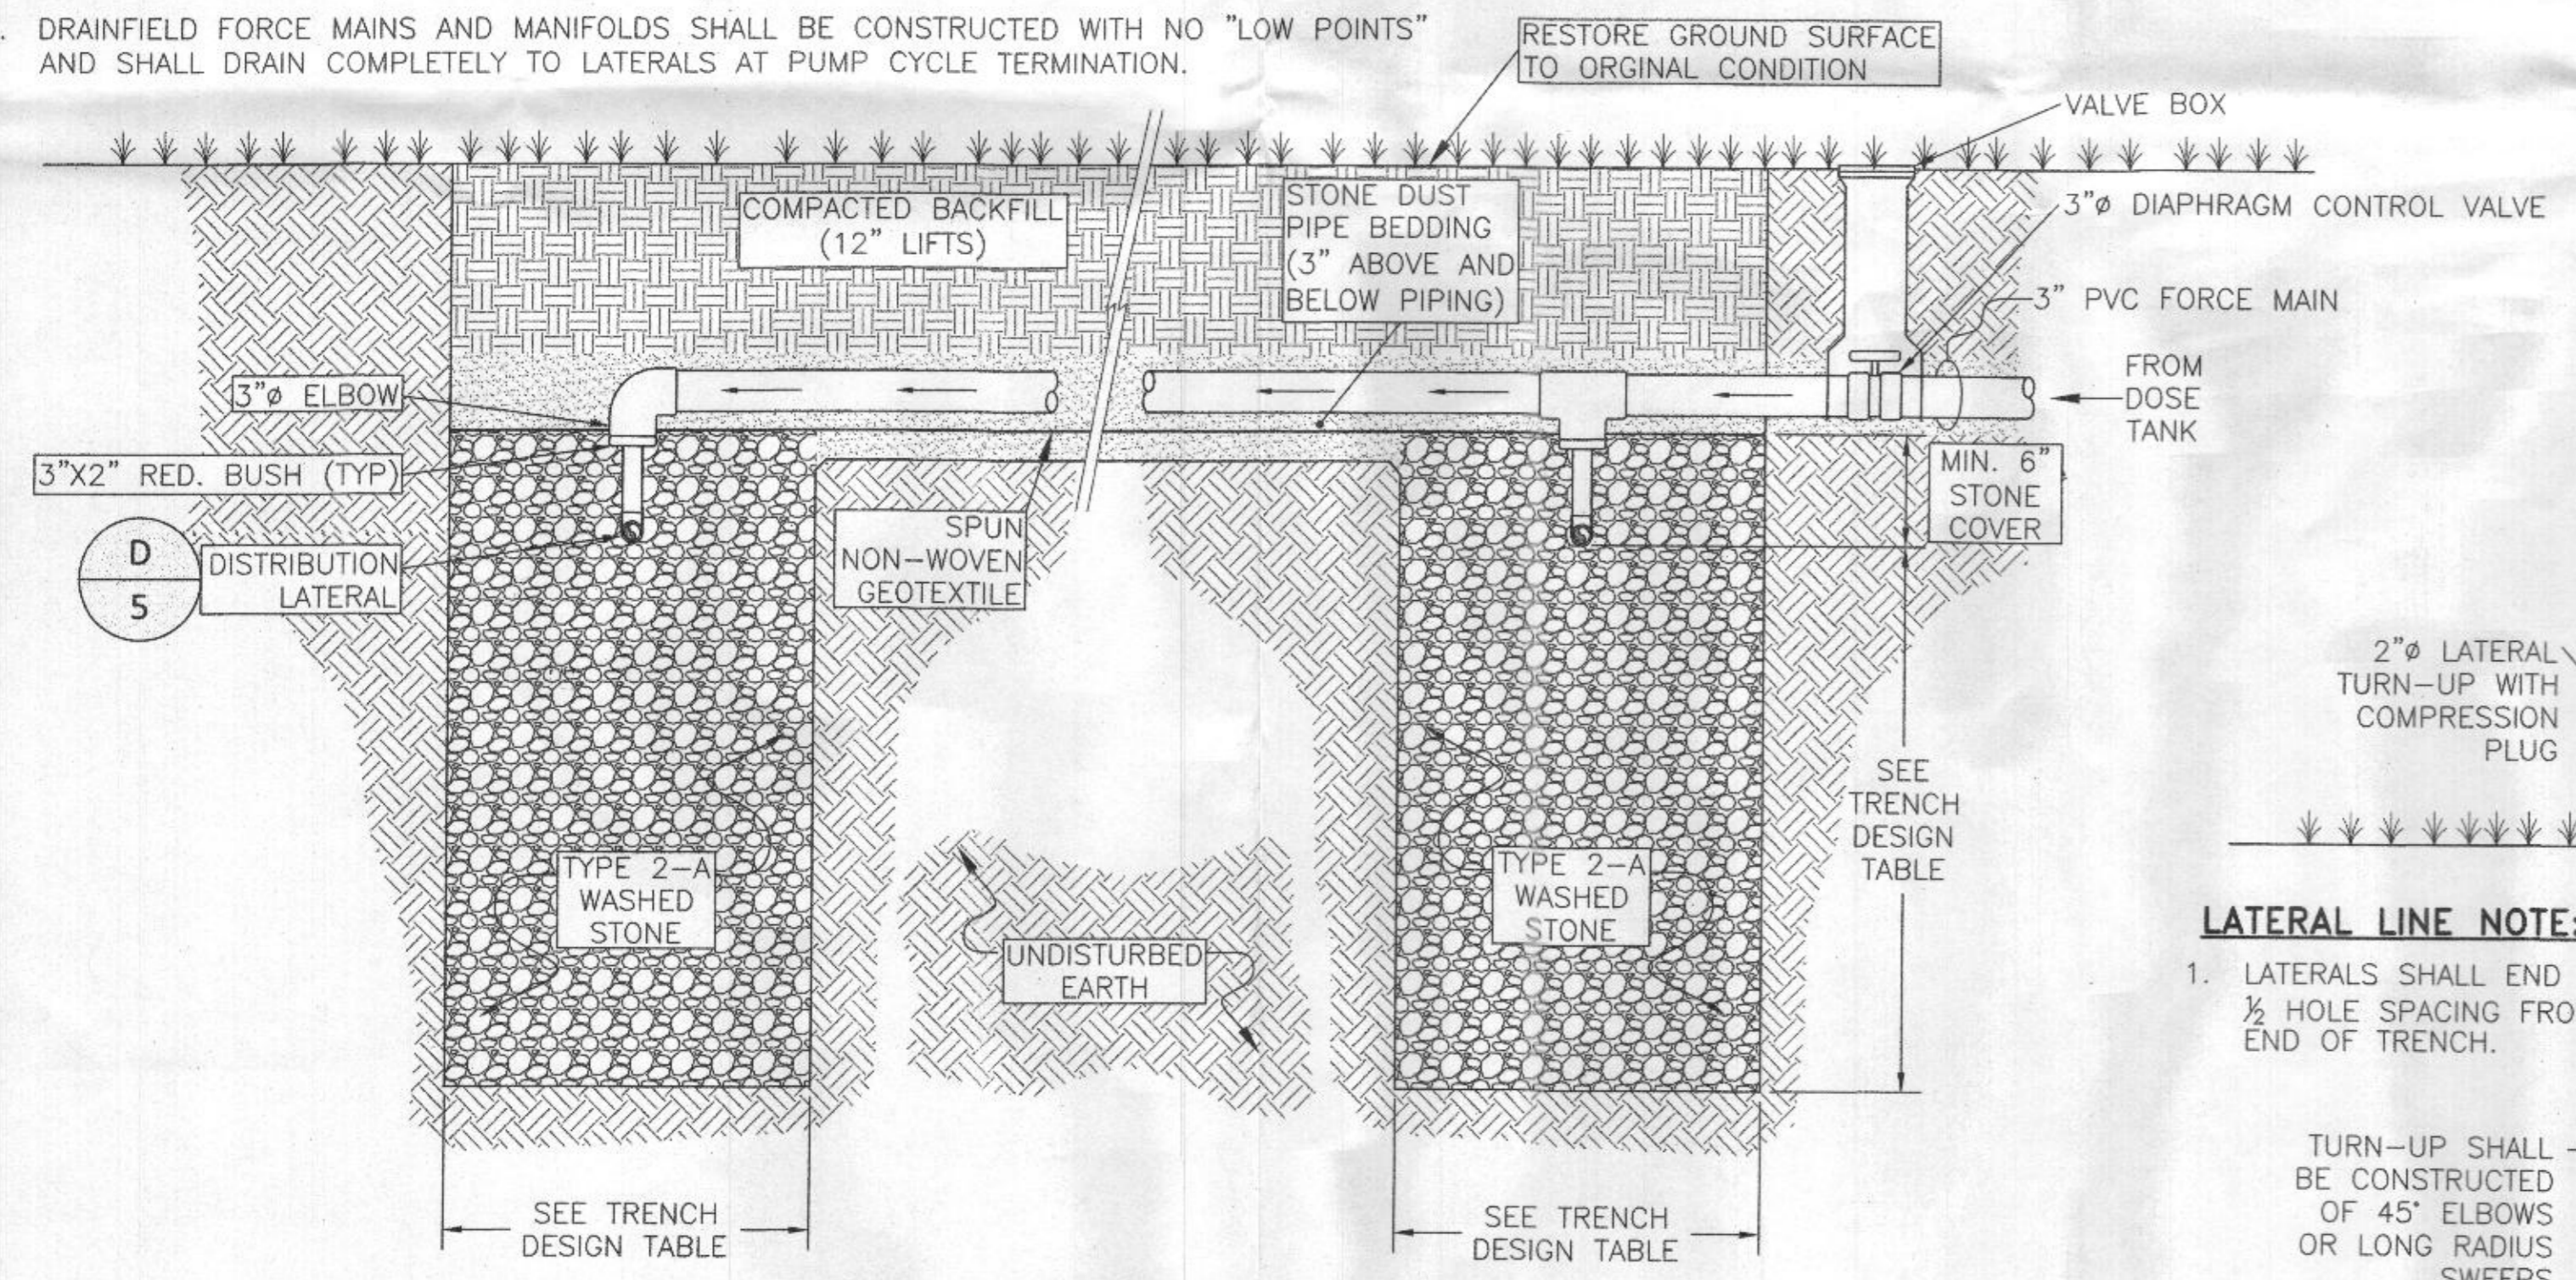


**FEED LINE/DEEP TRENCH DETAIL (TYP)** (C 3)  
NOT TO SCALE

**LATERAL LINE NOTE:**

- LATERALS SHALL END 1/2 HOLE SPACING FROM END OF TRENCH.

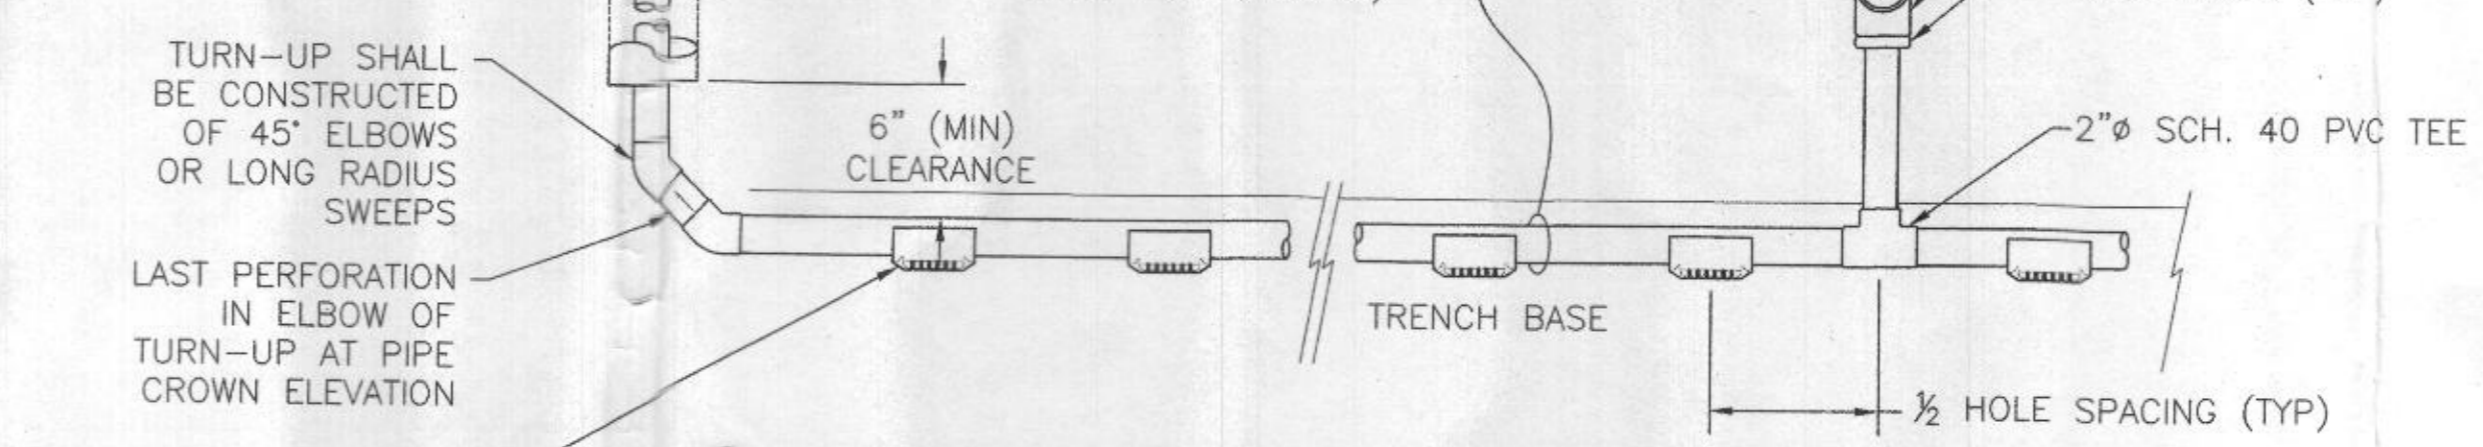

**DISTRIBUTION LATERAL DETAIL** (D 5)  
NOT TO SCALE

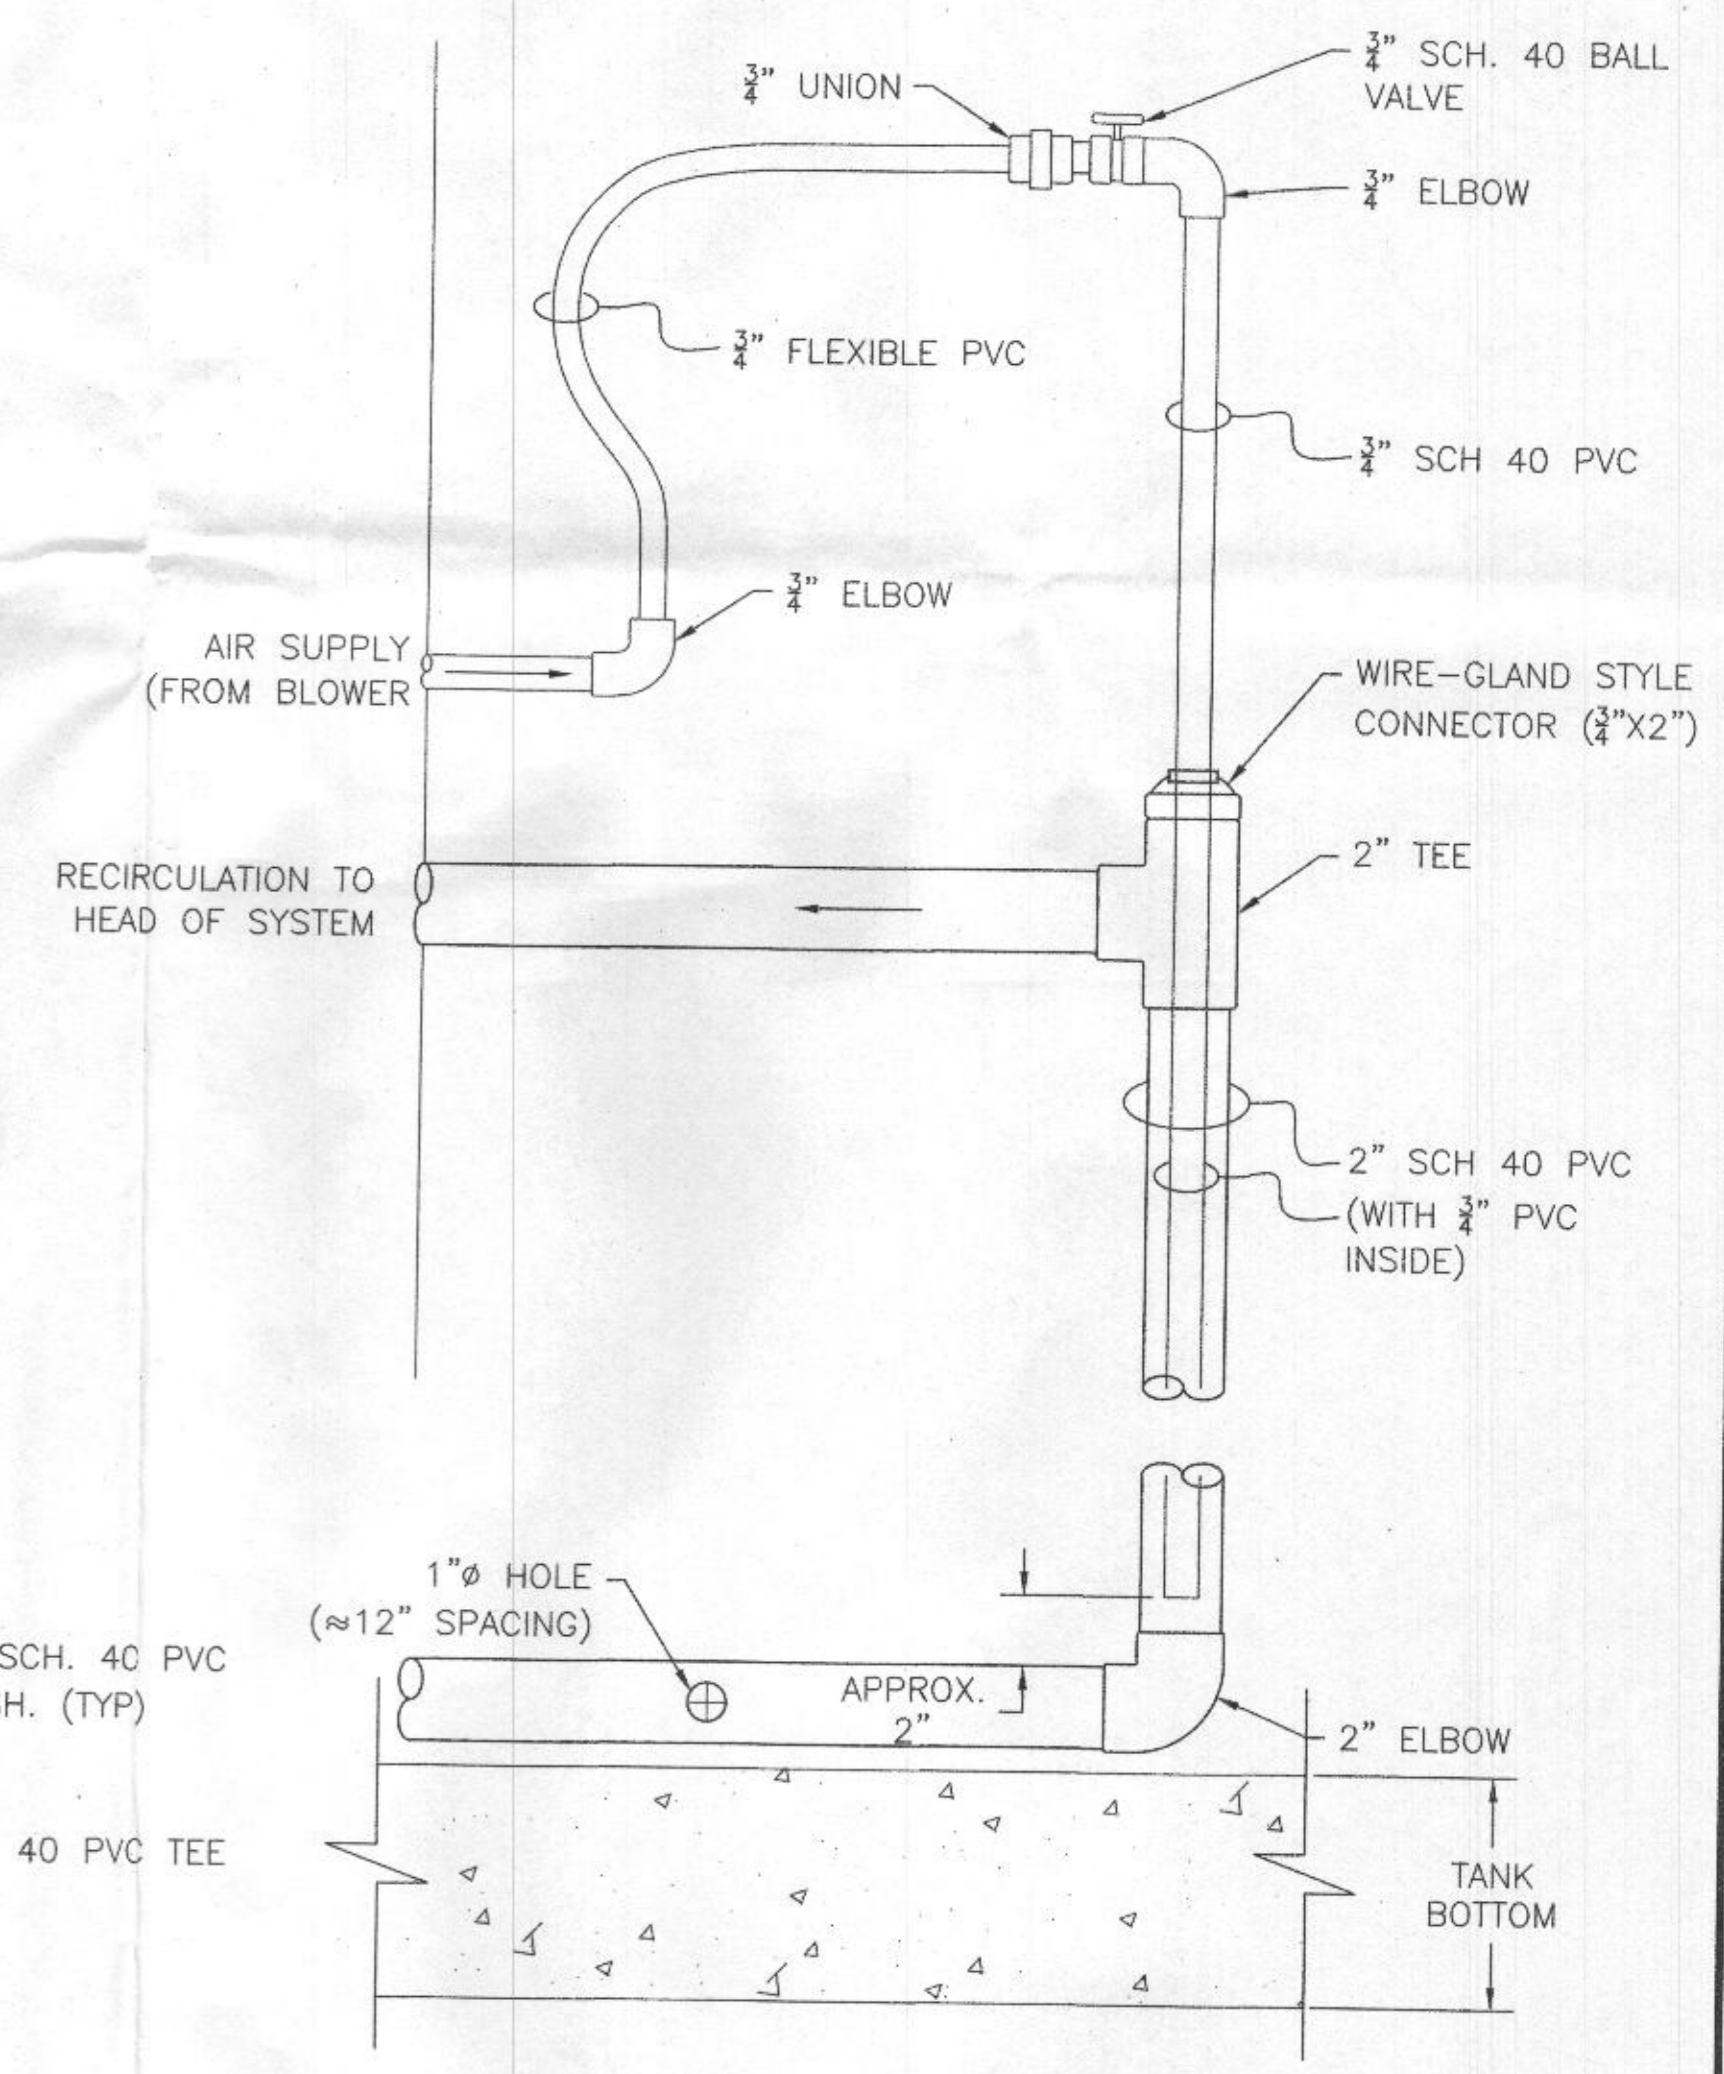

**AIR LIFT RECIRCULATION PUMP** (H 4)  
NOT TO SCALE

APPROVED FOR PRIVATE WATER AND SHARED SEWER SYSTEM FOR LOTS 23, 38, 39, 40 & 42

Howard County Health Officer  
DATE: 2/12/2020

DEPARTMENT OF PUBLIC WORKS HOWARD COUNTY, MARYLAND  
CHIEF, BUREAU OF UTILITIES  
DATE: 1-15-2020

DEPARTMENT OF PLANNING & ZONING HOWARD COUNTY, MARYLAND  
CHIEF, DEVELOPMENT ENGINEERING DIVISION  
DATE: 2-19-20

THE FOLLOWING STATES REQUIRE NOTIFICATION BY EXCAVATORS, DESIGNERS, OR ANY PERSON PREPARING TO DISTURB THE EARTH'S SURFACE ANYWHERE IN THE STATE OF MARYLAND, THE DISTRICT OF COLUMBIA, AND DELAWARE CALL 811 (WWW.1-800-246-4848) (PA 1-800-242-7777) (DC 1-800-251-7777) (VA 1-800-552-7991) (MD 1-800-552-7777) (DC 1-800-246-6555)

Hydro-Terra Group  
1106 Business Parkway South Suite E Westminster, Maryland 21157  
(410) 861-5376 (phone) (410) 861-5467 (fax)

PROFESSIONAL ENGINEER  
I MAKE A SOLE AND EXCLUSIVE CERTIFICATION THAT THESE DOCUMENTS WERE PREPARED OR APPROVED BY ME, AND THAT I AM A FULLY LICENSED PROFESSIONAL ENGINEER UNDER THE LAWS OF THE STATE OF MARYLAND. LICENSE NO. 20021 EXP. DATE 12/31/2020

DES: NJM	
DRN: MDS	
CK: MDH	
DATE: 1/3/2020	
REV: 11/25/21	A5 BUILT
DATE	DESCRIPTION
BY: WRA	PARCEL NO. 34, 36, 98, 111 & 112
600' SCALE MAP NO. 27 & 28	BLOCK NO.

Water and Sewer Plans  
**DISTRIBUTION DETAILS**

**WILLOWSHIRE**  
LOTS 1-45, BUILDABLE PRESERVATION PARCEL C, NON-BUILDABLE PRESERVATION PARCEL A, B, E-G & L, NON-BUILDABLE BULK PARCEL D & H-K  
5232 GREEN BRIDGE ROAD  
TAX MAP 27, GRID 18, PARCELS 34, 36, 98, 111 & 112  
5TH ELECTION DISTRICT  
HOWARD COUNTY MARYLAND  
CONTRACT NO.: 50-5062-D

SCALE: As Noted  
SHEET: 5 OF 5