



# APPLICATION

## FOR PERCOLATION TESTING AND SITE EVALUATION

TEST DATE(S) 10/7/03 TEST TIME \_\_\_\_\_ APP 517963  
 AGENCY REVIEW: \_\_\_\_\_ DATE \_\_\_\_\_

DO NOT WRITE ABOVE THIS LINE

I HEREBY APPLY FOR THE NECESSARY TESTING/EVALUATION PRIOR TO ISSUANCE OF SEWAGE DISPOSAL SYSTEM PERMIT(S) TO:

CHECK AS NEEDED:

- CONSTRUCT NEW SEPTIC SYSTEM(S)
- REPAIR/ADD TO AN EXISTING SEPTIC SYSTEM
- REPLACE AN EXISTING SEPTIC SYSTEM

CHECK AS NEEDED:

- NEW STRUCTURE(S)
- ADDITION TO AN EXISTING STRUCTURE
- REPLACE AN EXISTING STRUCTURE

CHECK ONE:

- CREATE NEW LOT(S)
- BUILD ON AN EXISTING LOT IN A SUBDIVISION
- BUILD ON AN EXISTING PARCEL OF RECORD

IS THE PROPERTY WITHIN 2500' OF ANY RESERVOIR?

- YES
- NO

THE TYPE OF STRUCTURE IS:

- RESIDENTIAL WITH \_\_\_\_\_ PROPOSED BEDROOMS IN THE COMPLETED STRUCTURE (NOTE **UNKNOWN** IF APPROPRIATE)
- COMMERCIAL (PROVIDE DETAIL OF NUMBERS AND TYPES OF EMPLOYEES/ CUSTOMERS ON ACCOMPANYING PLAN)
- INSTITUTIONAL/GOVERNMENT (PROVIDE DETAIL OF NUMBERS AND TYPES OF EMPLOYEES/USERS ON ACCOMPANYING PLAN)

PROPERTY OWNER(S) Herald & Shirley Baker

DAYTIME PHONE 301-829-2403 CELL \_\_\_\_\_ FAX \_\_\_\_\_

MAILING ADDRESS 1730 Florence Road  
STREET CITY/TOWN STATE ZIP

APPLICANT Jeff McAlister

DAYTIME PHONE 301-831-7197 CELL \_\_\_\_\_ FAX \_\_\_\_\_

MAILING ADDRESS 2610 Mullinix Mill Road  
STREET CITY/TOWN STATE ZIP

APPLICANT'S ROLE: DEVELOPER BUILDER BUYER RELATIVE/FRIEND REALTOR CONSULTANT

PROPERTY LOCATION  
SUBDIVISION/PROPERTY NAME Baker Property LOT NO. PROPOSED LOT 1

PROPERTY ADDRESS Florence Rd  
STREET TOWN/POST OFFICE

TAX MAP PAGE(S) 6 GRID \_\_\_\_\_ PARCEL(S) 151 PROPOSED LOT SIZE 3acres



AS APPLICANT, I UNDERSTAND THE FOLLOWING: THE SYSTEM INSTALLED SUBSEQUENT TO THIS APPLICATION IS ACCEPTABLE ONLY UNTIL PUBLIC SEWERAGE IS AVAILABLE. THIS APPLICATION IS COMPLETE WHEN ALL APPLICABLE FEES AND A SUITABLE SITE PLAN HAVE BEEN RECEIVED. I ACCEPT THE RESPONSIBILITY FOR COMPLIANCE WITH ALL M.O.S.H.A. AND "MISS UTILITY" REQUIREMENTS. APPROVAL IS BASED UPON SATISFACTORY REVIEW OF A PERC CERTIFICATION PLAN.

TEST RESULTS WILL BE MAILED TO APPLICANT. \_\_\_\_\_ SIGNATURE OF APPLICANT

HOWARD COUNTY HEALTH DEPARTMENT, BUREAU OF ENVIRONMENTAL HEALTH, WELL AND SEPTIC PROGRAM  
 3525-H ELLICOTT MILLS DRIVE, ELLICOTT CITY, MARYLAND 21043-4544 (410) 313-1771 FAX (410) 313-2648  
 TDD (410) 313-2323 TOLL FREE 1-877-4MD-DHMH

AP 517963  
20

Org brn  
Si Lm  
tightly  
packed  
  
pink  
yellow  
Si L  
  
Trace  
Rock  
  
V.V. WL  
sap. 10-15%  
Bottom 14'

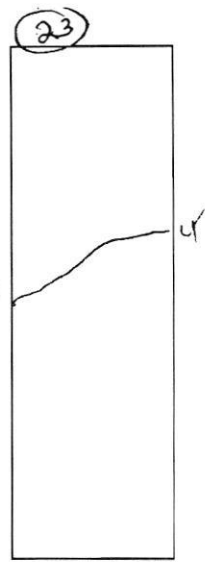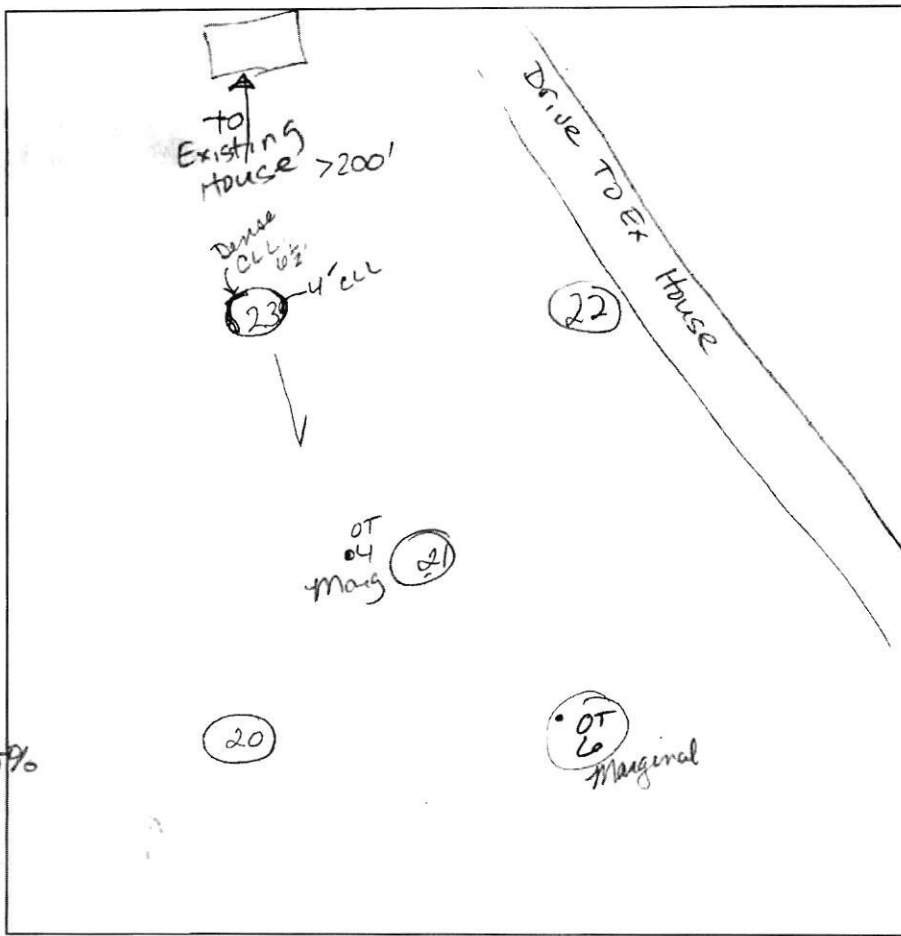

20  
Str org brn  
CL (hvy) Frag 5%  
transition  
layer  
yellow  
Si  
Cobbles  
& stones  
to 20%  
Bottom 14'

21  
Densley  
packed  
CL Lm  
w/ packets  
Si Lm  
Trace Rk  
tan  
yellow  
Si  
WL platy  
structure  
V.V. weak  
sap. 5-10%  
Bottom 14'

DATE	TEST #	DEPTH	START	BREAK 1" DROP	STOP 2" DROP	TIME OF 2nd INCH	P/F/H
10/7/23	20	5'8" / 14'V	11:31 <sup>10</sup>	11:39	11:52	13	P
	20	4'5" / 14'V	11:36 <sup>24</sup>	11:38	11:43	5	P
	21	5 1/2' / 14'V	11:46 <sup>30</sup>	11:58 <sup>00</sup>	12:13	15	P
	23	5 1/2' / 14'V	11:57	12:06	12:18	12	P
All holes pass perc test and soil descrip. OK SDA.							



REMARKS Holes Dug on Stake Holes staked per plan  
 SANITARIAN Kacie BACKHOE Fyock OTHERS McA/Cister (Lot 1)  
 TEST HOLES USED IN SDA \_\_\_\_\_ AVG. PERC TIME \_\_\_\_\_ SQ. FT/BR \_\_\_\_\_  
 TRENCH WIDTH \_\_\_\_\_ INLET DEPTH \_\_\_\_\_ MAX. BOT DEPTH \_\_\_\_\_ EFFECTIVE SW \_\_\_\_\_

# APPLICATION

PERCOLATION TESTING

A 517963

P \_\_\_\_\_

HOWARD COUNTY HEALTH DEPARTMENT  
BUREAU OF ENVIRONMENTAL HEALTH  
3525-H ELLICOTT MILLS DRIVE/ELLICOTT CITY, MARYLAND 21043  
TELEPHONE: 313-2640

DISTRICT \_\_\_\_\_

DATE 10/18/2002

TO: THE COUNTY HEALTH OFFICER  
ELLICOTT CITY, MARYLAND

I HEREBY APPLY FOR THE NECESSARY TEST PRIOR TO APPLICATION FOR PERMIT TO CONSTRUCT (OR RECONSTRUCT) A SEWAGE DISPOSAL SYSTEM.

PROPERTY OWNER Gerald R. Baker and Shirley A. Baker

ADDRESS 1730 Florence Road Mt. Airy, MD PHONE 301-829-2403

AGENT OR PROSPECTIVE BUYER Jeffrey McAlister

ADDRESS 2610 Mullinix Mill Rd. Mt. Airy, MD PHONE 301-831-7197

PROPERTY LOCATION:

SUBDIVISION BAKER PROPERTY LOT NO. 1

ROAD AND DESCRIPTION Florence Road (Front Lot - Right)

TAX MAP 6 PARCEL # 151

SIZE OF LOT 3.09 Ac ± TYPE BLDG. Single Family  
(SINGLE FAMILY DWELLING OR COMMERCIAL)

THE SYSTEM INSTALLED UNDER THIS APPLICATION IS ACCEPTABLE ONLY UNTIL PUBLIC FACILITIES BECOME AVAILABLE. I FULLY UNDERSTAND THE FEE CONNECTED WITH THE FILING OF THIS PERC TEST APPLICATION IS NON-REFUNDABLE UNDER ANY CIRCUMSTANCES. I ALSO AGREE TO COMPLY WITH ALL M.O.S.H.A. REQUIREMENTS IN TESTING THIS LOT.

[Signature]  
(SIGNATURE OF APPLICANT)

APPROVED BY \_\_\_\_\_ FOR \_\_\_\_\_ DATE \_\_\_\_\_

DISAPPROVED BY \_\_\_\_\_ FOR \_\_\_\_\_ DATE \_\_\_\_\_

HOLD PENDING FURTHER TESTS \_\_\_\_\_


REASONS FOR REJECTION OR HOLDING \_\_\_\_\_

PERCOLATION TEST PLAT/PRELIMINARY PLAT - TITLE OR I.D. # \_\_\_\_\_ DATE \_\_\_\_\_

SITE DEVELOPMENT PLAN/FINAL PLAT - TITLE OR I.D. # \_\_\_\_\_ DATE \_\_\_\_\_

## THIS IS NOT A PERMIT

# Florence ROAD

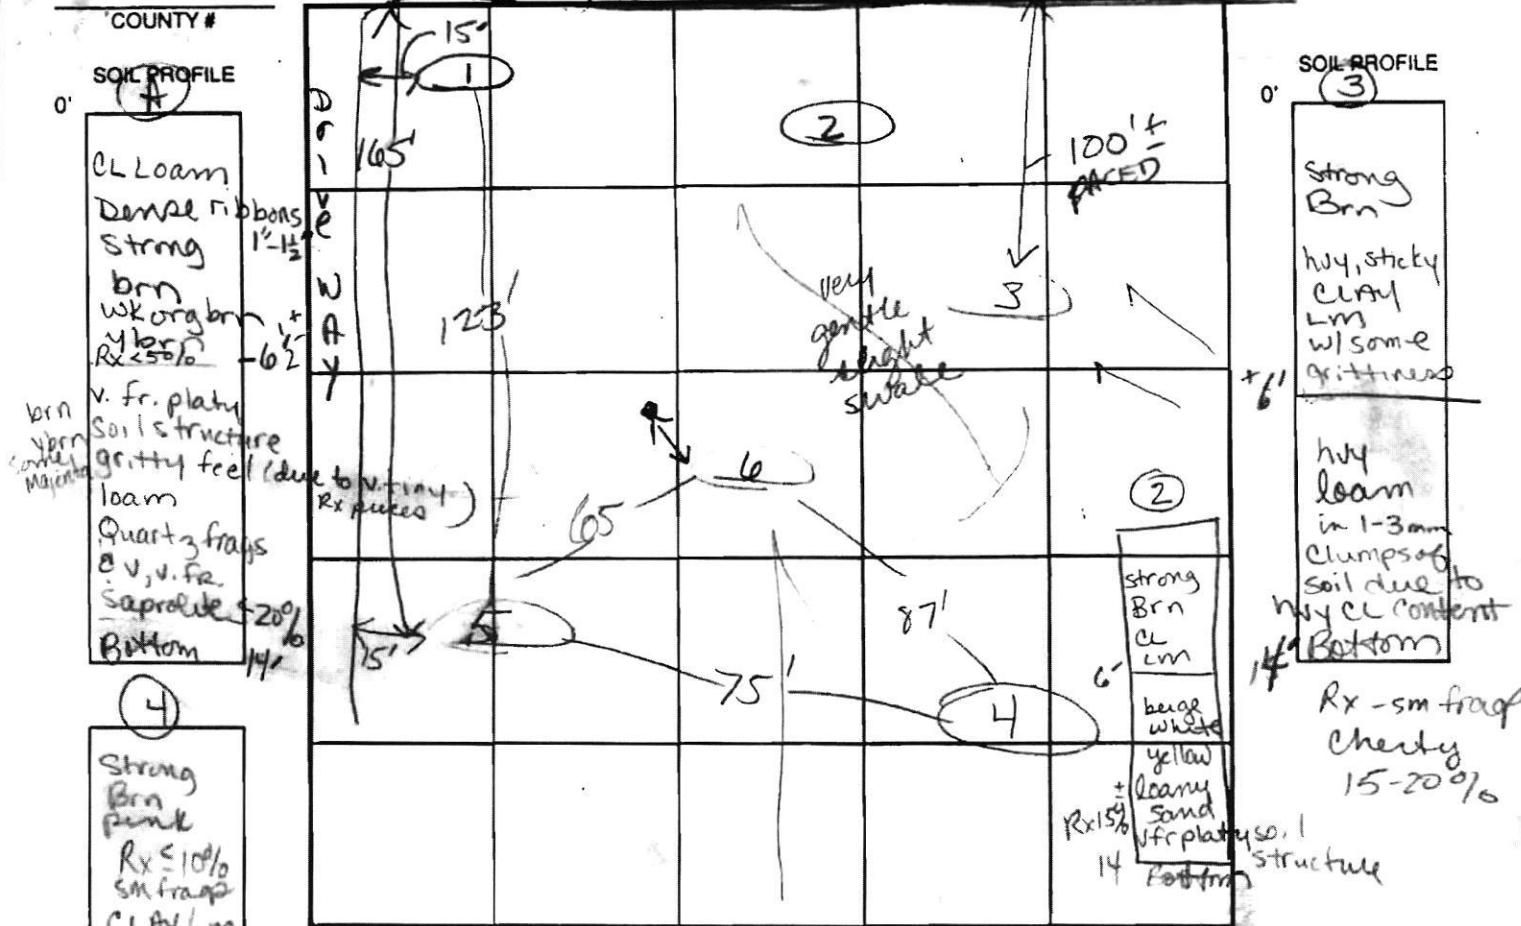

INDICATE NORTH - NAME ADJOINING ROADWAY AS BASE LINE.

DATE	TEST NO.	DEPTH	PRE-WET		TEST - 1" DROP		TIME
			START	STOP	START	STOP	
12-12-02	5	6'8" / 14"	10:07	TOO SLOW - Re pour			
	4	6'10" / 13 1/2"	Stake fell reset	10:32	10:33	11:08	st 1 1/8" to go SLOW
	6	7'S'	10:21:19	ANOTHER 1/2" to go pulled @ 10:51			SLOW (F)
	6	perc in Rock	9' m / 15	10:15 <sup>52</sup>	10:16 <sup>58</sup>	10:19 <sup>30</sup>	2" OK
	5	7 1/2'S	10:30 <sup>48</sup>				SLOW (F)
	3	SOIL - DENSE		IN PERC			(F)
	1	Stopped DIGGING DUE TO NO FEASIBILITY					
	2	SEE SOIL PROFILE NOT FEASIBLE DUE TO LOCATION, GOOD SOIL BELOW					

REMARKS: Holes dug per plan except hole #1

TYPE OF SOIL: \_\_\_\_\_

TESTED BY: Kacie ALSO PRESENT: Hatfields

TRENCH DESIGN DATA: AVERAGE PERCOLATION TIME \_\_\_\_\_ TRENCH WIDTH \_\_\_\_\_

INLET DEPTH \_\_\_\_\_ MAXIMUM BOTTOM DEPTH \_\_\_\_\_ SQ. FT./BEDROOM \_\_\_\_\_

6 1/2'

13 1/2'

4'

15'

Bottom

TAN CLAY

CLAY Loam

Si CL LM

Cherty Frag 20%

Min boulders

Quartz

Aggy frags

35-45%

Bottom



**SCALE**  
**1" = 30'**

LOT-1  
 MOCKINGBIRD FOREST  
 PLAT No. 18776  
 134,088 SQ. FT.  
 3.0782 AC.±

TEST PIT  
 LOCATION  
 FOREBAY/ 35 SF  
 B. 729.5  
 RIP-RAP  
 5' X 3'

LA WELL  
 HO 95-0516

ALT. WELL

60' B.R.L.

N 61°25'45" W 492.66'

LOD

LOD

LOD

84'±

752

758

760

ALT. WELL

+751.0

752.0

63'±

61'±

751.0+

ALT. WELL

PROP. HSE  
 FF 754.0  
 B 744.0

751.0

30' B.R.L.

748.0

750.0

752.06

751.73

751.6

PROP. DRIVEWAY  
 2.0%

SCE

750

ROOF DRAIN

C/O

C/O

TEMPORARY STOCKPILE

70'-4" PVC @ 2.0%

N-2 NON-ROOFTOP  
 DISCONNECTION

750

748

748

744

**SCALE**  
**1" = 30'**

LOT-1  
 MOCKINGBIRD FOREST  
 PLAT No. 18776  
 134,088 SQ. FT.  
 3.0782 AC.±

TEST PIT  
 LOCATION  
 FOREBAY/ 35 SF  
 B. 729.5  
 RIP-RAP  
 5' X 3'

SEPTIC TANK

DIST. BOX

23

740 11-1 70'

INITIAL TRENCH

T1-2 70'

22

T2-1 78'

1st REPLACEMENT

T2-2 78'

T3-1 78'


T3-2 78'

2nd REPLACEMENT

21

5'-4" PVC @ 2.0%

318'±

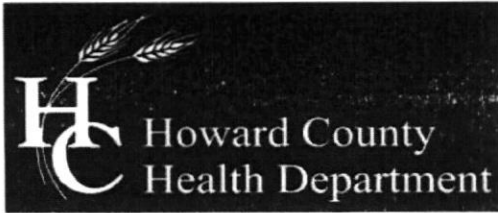

Bureau of Environmental Health

8930 Stanford Boulevard, Columbia, MD 21045

Main: 410-313-2640 | Fax: 410-313-2648

TDD 410-313-2323 | Toll Free 1-866-313-6300

www.hchealth.org

Facebook: www.facebook.com/hocohealth

Twitter: HowardCoHealthDep

Maura J. Rossman, M.D., Health Officer

SEWAGE DISPOSAL SYSTEM SPECIFICATIONS WORKSHEET

Address: Florence Road

Subdivision: Morningbird Forest Lot: 1

Initial system: Application rate: 0.8 Effective area beginning depth: 5.5' Bottom maximum depth: 3'
1st Replacement: Application rate: 0.8 Effective area beginning depth: 6' Bottom maximum depth: 8'
2nd Replacement: Application rate: 0.8 Effective area beginning depth: 7.5' Bottom maximum depth: 3'

Design Flow = 150 gallons per day per bedroom

Design flow ÷ application rate = square footage of drainfield required

Linear length of trench required = drainfield square footage x sidewall reduction percentage ÷ trench width

Sidewall reduction credit formula:

(W + 2) / (W + 1 + 2D) x 100 = Percent of length of standard trench where W=trench width and D= depth between effective area beginning depth and trench bottom.


Standard design requirements:

- All trenches must be equal length unless low pressure dosed
All trenches must be on contour
Minimum trench spacing: 10' for all trenches utilizing sidewall reduction credit. Additional spacing may be necessary for any trench using over 3.5' of effective sidewall. In those cases, the spacing formula is 2D +W up to a maximum spacing of 18'.
Minimum trench spacing for trenches with no sidewall credit (bottom area only) is 6' for a 2' wide trench and 9' for a 3' wide trench (spacing is measured edge to edge)
Maximum trench length is 100'
Maximum pipe depth is 4'

Additional requirements:

Stay off hole #6. Any eq. located below hole #21 is subject to 2nd repl. design specs.

Approved: Hank Oswald Date: 3/18/21

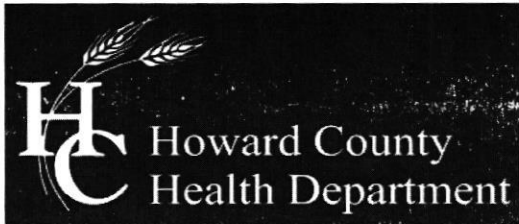

Bureau of Environmental Health

8930 Stanford Boulevard, Columbia, MD 21045

Main: 410-313-2640 | Fax: 410-313-2648

TDD 410-313-2323 | Toll Free 1-866-313-6300

www.hchealth.org

Facebook: www.facebook.com/hocohealth

Twitter: HowardCoHealthDep

Maura J. Rossman, M.D., Health Officer

SEWAGE DISPOSAL SYSTEM SPECIFICATIONS WORKSHEET

Address: Florence Road

Subdivision: Morningbird Forest Lot: 1

Initial system: Application rate: 0.8 Effective area beginning depth: 5.5' Bottom maximum depth: 8'
1st Replacement: Application rate: 0.8 Effective area beginning depth: 6' Bottom maximum depth: 8'
2nd Replacement: Application rate: 0.8 Effective area beginning depth: 7.5' Bottom maximum depth: 8'

Design Flow = 150 gallons per day per bedroom

Design flow ÷ application rate = square footage of drainfield required

Linear length of trench required = drainfield square footage x sidewall reduction percentage ÷ trench width

Sidewall reduction credit formula:

(W + 2) / (W + 1 + 2D) x 100 = Percent of length of standard trench where W=trench width and D= depth between effective area beginning depth and trench bottom.

Standard design requirements:

- All trenches must be equal length unless low pressure dosed
All trenches must be on contour
Minimum trench spacing: 10' for all trenches utilizing sidewall reduction credit. Additional spacing may be necessary for any trench using over 3.5' of effective sidewall. In those cases, the spacing formula is 2D +W up to a maximum spacing of 18'.
Minimum trench spacing for trenches with no sidewall credit (bottom area only) is 6' for a 2' wide trench and 9' for a 3' wide trench (spacing is measured edge to edge)
Maximum trench length is 100'
Maximum pipe depth is 4'

Additional requirements:

Stay off hole #6. Any sys. located below hole #21 is subject to 2nd repl. design specs.

Approved: Hank Oswald Date: 8/18/21

**CURVE DATA**

NUMBER	RADIUS	ARC LENGTH	DELTA ANGLE	TANGENT	CHORD DIRECTION	CH. LENGTH
C1	175.00	138.88	44°48'32"	72.16	N 175°47' E	133.42

**COORDINATES**

PT. #	NORTH	EAST
46	60314.389897	1270708.7434
47	603036.0605	1270709.4189
48	602933.2588	1270925.9520
49	603174.5480	1271145.4205
50	603091.5477	1271105.8921
51	603408.9149	1271346.3365
52	603307.8408	1271287.5435
53	603380.4806	1271356.9820
54	603041.0490	1271381.0691
55	602871.8896	1271081.4391
56	602888.9758	1271607.9690
57	602779.1225	1271514.9595
58	602774.3040	1271538.5107
59	603154.8991	1271821.7823
60	603182.2176	1271789.6119
61	603158.2519	1271790.1660
62	603154.8692	1271789.6497
64	603121.2488	1271809.0405
65	603055.3219	1271748.7246
66	603046.0285	1271770.4758
68	602960.2850	1271700.5198
69	603757.8795	1270708.2092
155	603788.7011	1270712.6181

NOTE: COORDINATES AND GRID TICS SHOWN HEREON ARE IN FEET. TO CONVERT TO METERS DIVIDE BY 3.28083333.

**OWNER/DEVELOPER**

GERALD R. BAKER, GUY  
C/O JEFF McALISTER  
2610 MILLING MILL ROAD  
MT. AIRY MD. 21771

**MINIMUM LOT SIZE CHART**

LOT NO.	GROSS AREA	PIPESTEM AREA	MINIMUM LOT SIZE
1	3,2917 AC±	0.2785 AC±	3,0152 AC±
4	4,4598 AC±	0.1581 AC±	4,3217 AC±

**TABULATION OF FINAL PLAT:**

- A. Total number of lots and/or parcels to be recorded.  
Subtotal: 4
- B. Total area of lots and/or parcels.  
Subtotal: 16,5702 AC±
- C. Total area of road right-of-way to be recorded, including widening strips. 0.2612 AC±
- D. Total gross area of subdivision to be recorded. 14.6314 AC±

THE REQUIREMENTS §3-108, THE REAL PROPERTY ARTICLE, ANNOTATED CODE OF MARYLAND, 1988 REPLACEMENT VOLUME, (AS SUPPLEMENTED) AS FAR AS THEY RELATE TO THE MAKING OF THIS PLAT AND THE SETTING OF MARKERS HAVE BEEN COMPLIED WITH.

SOURASH G. MUNSRI, P.L.S. NO. 10,770 DATE 12/19/06  
Gerald R. Baker 12/20/06  
Shirley A. Baker 12/20/06  
GERALD R. BAKER, OWNER  
SHIRLEY A. BAKER, OWNER

**APPROVED**


FOR PRIVATE WATER AND PRIVATE SEWERAGE SYSTEMS, HOWARD COUNTY HEALTH DEPARTMENT

HOWARD COUNTY HEALTH OFFICER 11/1/07 DATE

**APPROVED**


HOWARD COUNTY DEPARTMENT OF PLANNING AND ZONING

CHIEF, DEVELOPMENT ENGINEERING 11/5/07 DATE

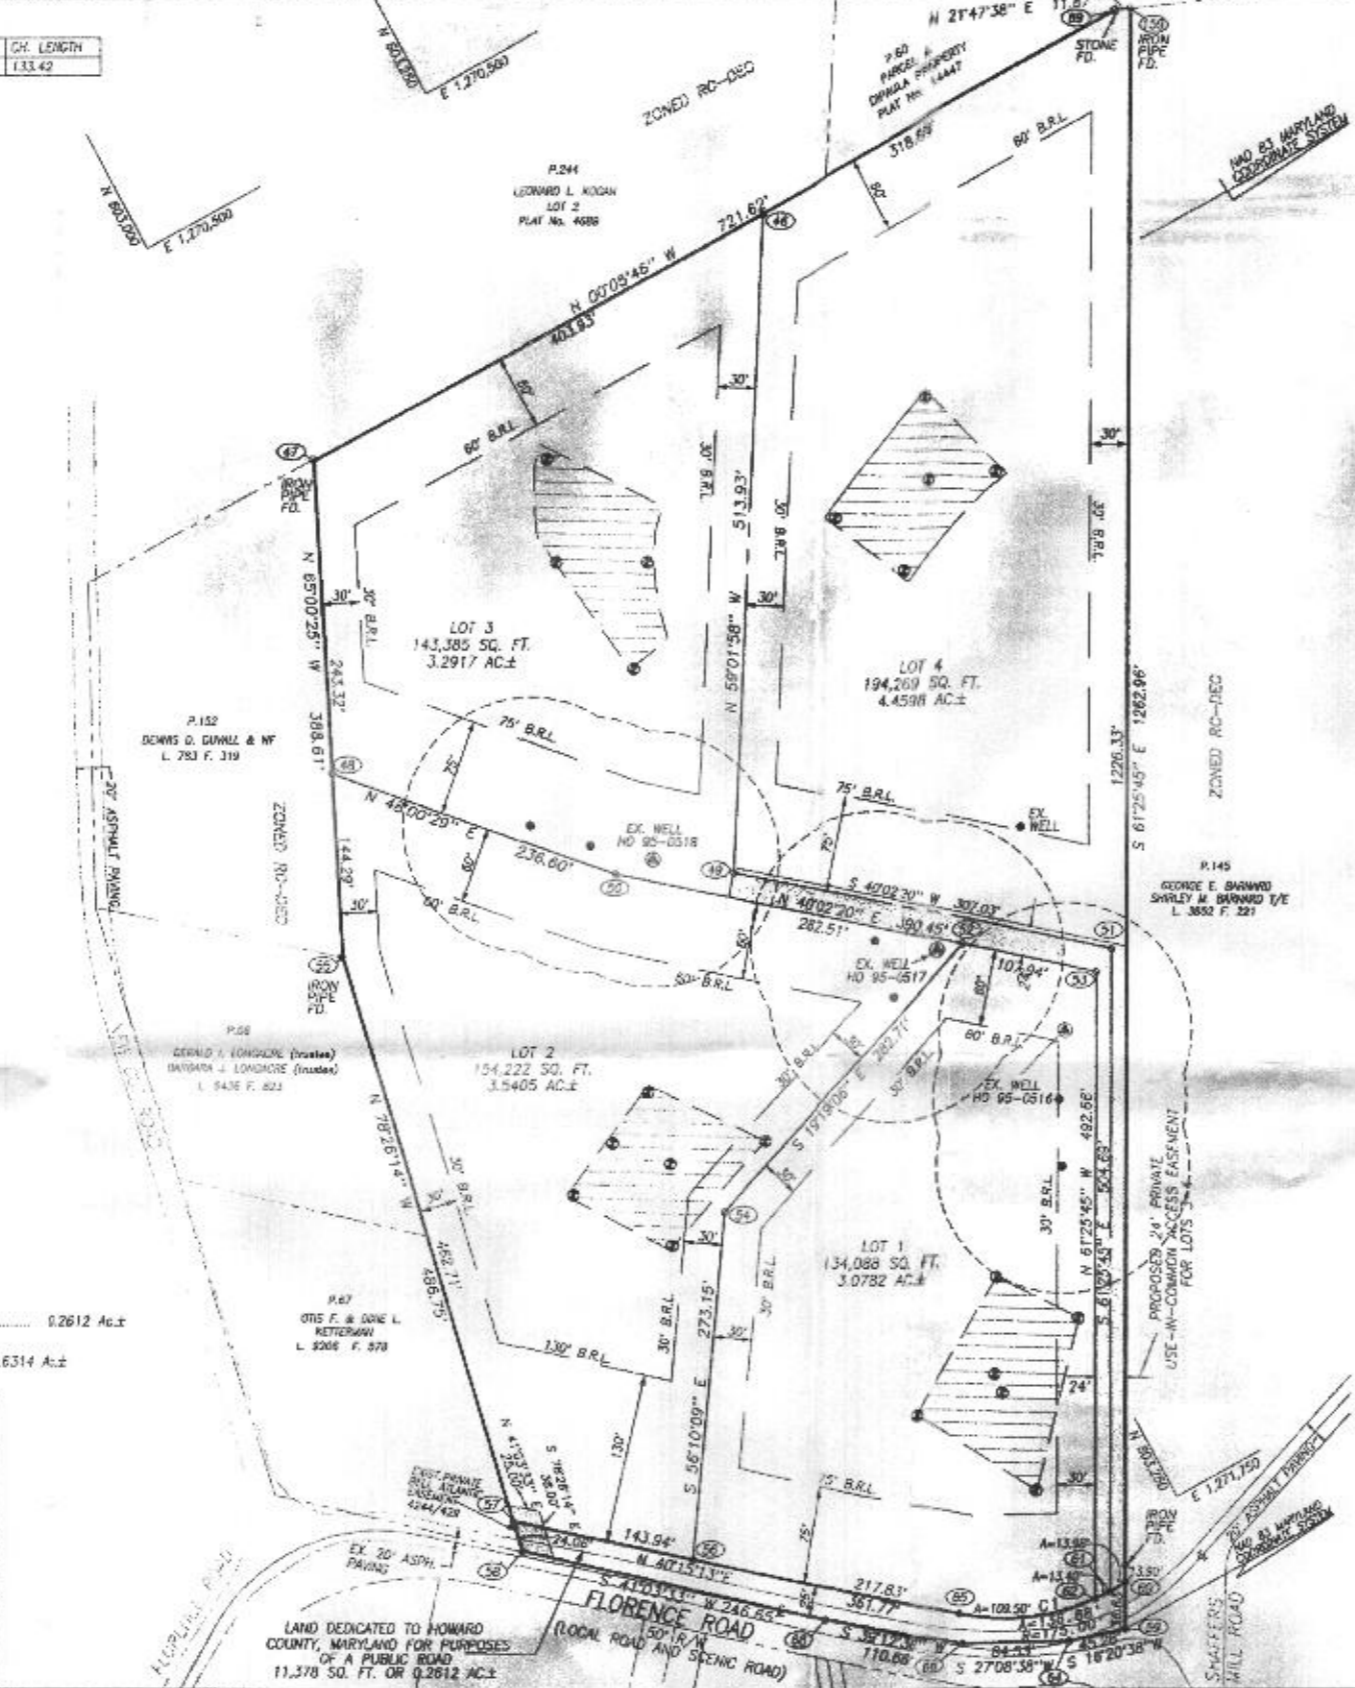

**GENERAL NOTES**

1. The lots shown hereon comply with the minimum ownership width and lot area as required by the Maryland State Department of the Environment regulations.
2. Coordinates are based on NAD 83 Maryland Coordinate System as projected by Howard County Geodetic Control Stations No. 051A & 12C2.
3. This area designates a private sewage easement of at least 10,000 square feet (10,000 square feet per lot for shared drain fields associated with a shared sewage disposal facility) as required by Maryland State Department of the Environment for individual sewage disposal (COMAR 26.04.03). Improvements in any nature in this area are restricted until public sewage is available. These easements shall become null and void upon connection to a public sewage system. The County Health Officer shall have the authority to grant adjustments into the private sewage easement. Recorrection of a modified sewage easement shall not be necessary.
4. S.R.L. - Represents building restriction line
5. □ Represents concrete monument set (unless otherwise noted)
6. ○ Represents iron rebar set (unless otherwise noted)
7. Percolation test holes shown hereon have been field located and shown thus ⊙
8. Public water and sewer are not available to this site. On-lot water and sewer will be provided until public utilities are available.
9. Subject property, zoned "RCDE" per 02/02/04 comprehensive zoning plan, and the Zoning Amendments effective 7/28/05.
10. For flag lot pipestem lots, refuse collection, snow removal and road maintenance are provided to the junction of the flag or pipestem and the road right-of-way line only and not onto the flag or pipestem lot driveway.
11. Driveway shall be provided prior to residential occupancy to insure safe access for fire and emergency vehicles per the following minimum requirements:
  - a) Width - 12' (14' serving more than one residence).
  - b) Surface - 6" of compacted crusher run base w/10' and chip sealing.
  - c) Curbs - 4" - 6" high, 15% grade, max. 10% grade change and min. 45' turning radius.
  - d) Structure (culvert/bridges) - capable of supporting 25 gross tons (+125 loading).
  - e) Drainage Elements - capable of safely passing 100-year flood with no more than 1 foot depth over driveway surface.
  - f) Structure clearances - minimum 12 feet.
  - g) Maintenance - sufficient to insure all weather use.
12. This plat is based on a field run monumented boundary survey performed on or about October 17, 2006 by Sourabh G. Munsri, Vanmar Associates, Inc.
13. Areas as stated on this plat are to be taken as more or less, unless otherwise noted.
14. No wetlands currently exist on this subdivision and the subdivision does not lie within a flood hazard area.
15. Landscaping requirements for these lots shall be provided in accordance with the provisions of Section 16.124 of the Howard County Subdivision and Land Development Regulations and the Landscape Manual. Financial surety for the required Perimeter Landscaping will be posted with the grading permit for 25 shade trees in the amount of \$7,500.
16. Stormwater Management requirement for Lots 1, 2 & 3 is provided under sections 5.3 and 5.6 of the 2000 Maryland Design Manual Non-Rooftop Disconnection Credit and Environmentally Sensitive Development Credit for Multiple Lot Development. At the building permit stage, lot grading and site of impervious areas including the location of the proposed house and driveway shall be per the approved Storm Water Management Exhibit. There is an existing dwelling on Lot 4.
17. There is an existing dwelling/structure located on Lot 4 to remain. No new buildings, extensions or additions to the existing dwelling are to be constructed at a distance less than the zoning regulations require.
18. This plat is subject to the Amended 5th Edition Subdivision and Land Development Regulations and to the zoning regulations effective January 6, 2002.
19. Lot 3 septic installation required prior to building permit signature due to random excessive rock pockets.
20. Forest Conservation requirements per Section 16.1202 of the Howard County Code and Forest Conservation Act for this Subdivision have been fulfilled through the forest retention credit of 3.75 acres of existing forest located on lots 3 and 4 in accordance with the adopted DP2 Policy date May 11, 1998, for residential lots greater than 60,000 sq.ft. A fee-in-lieu of \$4,138.20 for 0.19 acres of remaining required reforestation shall be paid to the Forest Conservation Fund.
21. A Use-in-Common Maintenance Agreement for Lots 3 and 4 shall be recorded simultaneously with this plan in the Land Records office for Howard County.

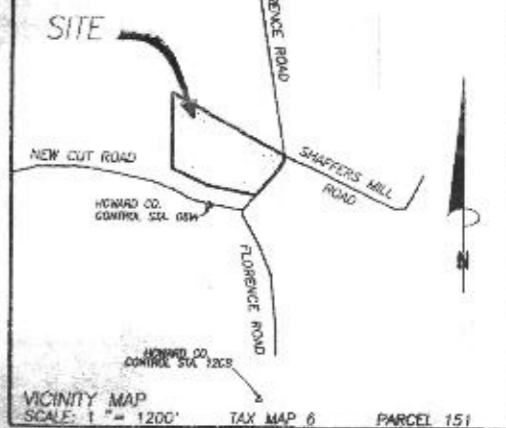

**OWNER'S CERTIFICATE**

WE, GERALD R. BAKER AND SHIRLEY A. BAKER, OWNERS OF THE PROPERTY SHOWN AND DESCRIBED HEREON, HEREBY ADOPT THIS PLAN OF SUBDIVISION AND IN CONSIDERATION OF THE APPROVAL OF THIS FINAL PLAT BY THE DEPARTMENT OF PLANNING AND ZONING, ESTABLISH THE MINIMUM BUILDING RESTRICTION LINES AND GRANT UNTO HOWARD COUNTY, MARYLAND, ITS SUCCESSORS AND ASSIGNS:

- (1) THE RIGHT TO LAY, CONSTRUCT AND MAINTAIN SEWERS, DRAINS, WATER PIPES AND OTHER MUNICIPAL UTILITIES AND SERVICES, IN AND UNDER ALL ROADS AND STREET RIGHTS-OF-WAY AND THE SPECIFIC EASEMENT AREAS SHOWN HEREON;
- (2) THE RIGHT TO REQUIRE DEDICATION FOR PUBLIC USE THE BEDS OF THE STREETS AND/OR ROADS AND FLOODPLAINS AND OPEN SPACE WHERE APPLICABLE, AND FOR GOOD AND OTHER VALUABLE CONSIDERATION, HEREBY GRANT THE RIGHT AND OPTION TO HOWARD COUNTY TO ACQUIRE THE FEE SIMPLE TITLE TO THE BEDS OF THE STREETS AND/OR ROADS AND FLOODPLAINS, STORM DRAINAGE FACILITIES AND OPEN SPACE WHERE APPLICABLE;
- (3) THE RIGHT TO REQUIRE DEDICATION OF WATERWAYS AND DRAINAGE EASEMENTS FOR THE SPECIFIC PURPOSE OF THEIR CONSTRUCTION, REPAIR AND MAINTENANCE; AND
- (4) THAT NO BUILDING OR SIMILAR STRUCTURE OF ANY KIND SHALL BE ERECTED ON OR OVER THE SAID EASEMENTS AND RIGHTS-OF-WAYS.

WITNESS MY/OUR HANDS THIS 20 DAY OF December, 2006.

Gerald R. Baker, Owner  
Shirley A. Baker, Owner

**SURVEYOR'S CERTIFICATE**

I, HEREBY CERTIFY THAT THE FINAL PLAT SHOWN HEREON IS CORRECT; THAT IT IS A SUBDIVISION OF ALL OF THE LANDS CONVEYED BY GERALD R. BAKER TO GERALD R. BAKER AND SHIRLEY A. BAKER BY DEED DATED NOVEMBER 18, 1994 AND RECORDED AMONG THE LAND RECORDS OF HOWARD COUNTY, MARYLAND IN LIBER 3399 FOLIO 296 AND THAT ALL MONUMENTS ARE IN PLACE OR WILL BE IN PLACE PRIOR TO THE ACCEPTANCE OF THE STREETS IN THE SUBDIVISION BY HOWARD COUNTY AS SHOWN IN ACCORDANCE WITH THE ANNOTATED CODE OF MARYLAND AS AMENDED.



RECORDED AS PLAT NO. 18776 ON 1-19-07 AMONG THE LAND RECORDS OF HOWARD COUNTY, MD.

**MINOR SUBDIVISION PLAT  
LOTS 1 THRU 4  
MOCKINGBIRD FOREST**

(LIBER 3399 AT FOLIO 296)

TAX MAP: 6 ELECTION DISTRICT: FOURTH SCALE: 1"=100'  
GRID NO: 24 HOWARD COUNTY, MARYLAND DATE: OCTOBER, 2006  
PARCEL NO: 151 EX. ZONING: RCDEO SHEET 1 OF 1



**VANMAR ASSOCIATES, INC.**  
Engineers Surveyors Planners  
310 South Main Street P.O. box 328