

PRELIMINARY

# APPLICATION

A 18464

SEWAGE DISPOSAL TESTING

P \_\_\_\_\_

STATE OF MARYLAND - DEPARTMENT OF HEALTH AND MENTAL HYGIENE

HOWARD COUNTY HEALTH DEPARTMENT  
ENVIRONMENTAL HEALTH SERVICES  
P. O. BOX 476, ELLICOTT CITY, MARYLAND 21043  
TELEPHONE: 465-5000, EXT. 356

DISTRICT 4th  
DATE 5/7/73

9/24/74  
9:30

*9/24/74 accept no more appointments for this lot DW*

TO: THE COUNTY HEALTH OFFICER  
ELLICOTT CITY, MARYLAND

I, HEREBY, APPLY FOR THE NECESSARY TEST IN ORDER TO CONSTRUCT (OR RECONSTRUCT) A SEWAGE DISPOSAL SYSTEM.

PROPERTY OWNER Hansen Watkins property

ADDRESS Woodbine, Maryland PHONE Any questions call Wm. Fresch 424-2900

PROPERTY LOCATION:

SUBDIVISION \_\_\_\_\_ LOT NO. Parcel 6

ROAD AND DESCRIPTION Md. Route 144 - 1200 ft. from Carr's Mill Road

SIZE OF LOT ± 8.018 acres TYPE BLDG. 3 or 4 bedrooms  
NUMBER OF BEDROOMS

IF NOT SINGLE RESIDENCE DESCRIBE \_\_\_\_\_

THE SYSTEM INSTALLED UNDER THIS APPLICATION IS ACCEPTABLE ONLY UNTIL PUBLIC FACILITIES BECOME AVAILABLE.

SIGNATURE OF APPLICANT /s/ William E. Fresch


APPROVED BY \_\_\_\_\_ FOR \_\_\_\_\_ DATE \_\_\_\_\_  
(KIND OF SYSTEM)

REJECTED BY C. Stecker FOR any sewage system DATE 6/5/73  
D. Monaghan FOR any DATE 9/25/74  
(KIND OF SYSTEM)

HOLD PENDING FURTHER TESTS \_\_\_\_\_ DATE \_\_\_\_\_

REASONS FOR REJECTION OR HOLDING 3/5/73 Water & clayish soil  
4-24-74 - poor soil - water SW

# THIS IS NOT A PERMIT

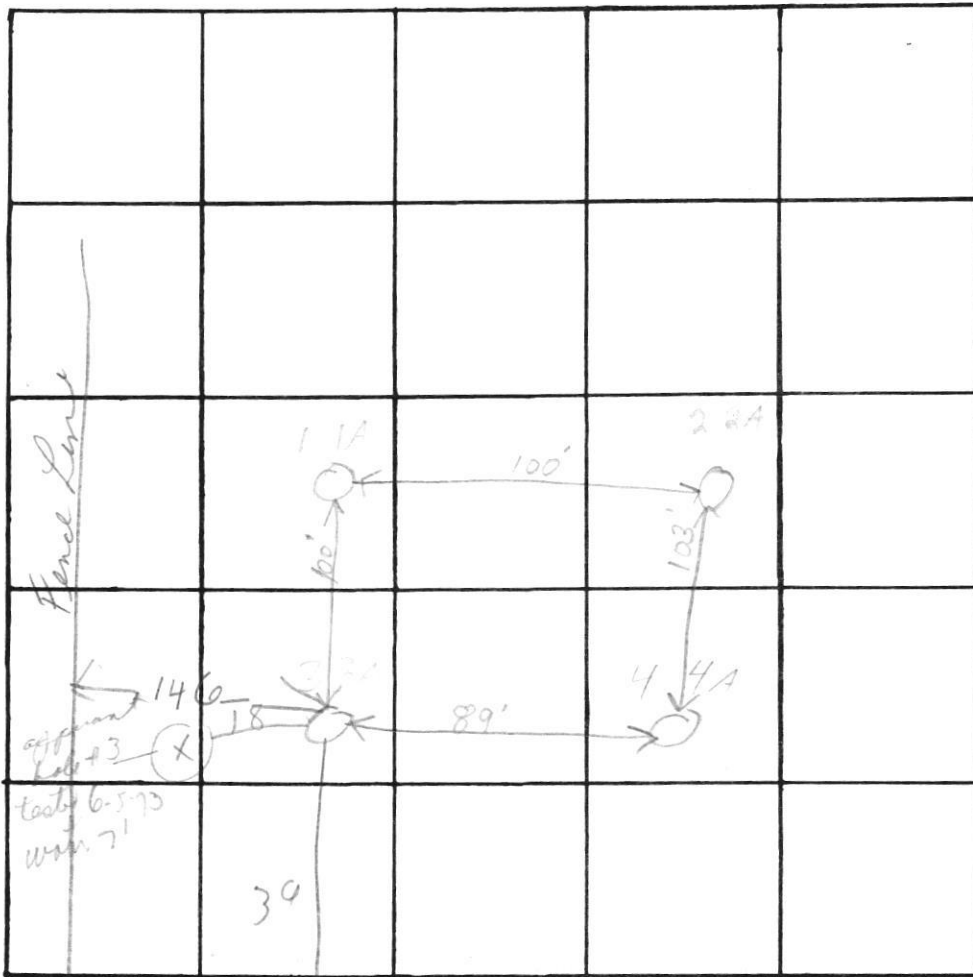

INDICATE NORTH. - NAME ADJOINING ROADWAY AS BASE LINE.

RT 144

DATE	TEST NO.	DEPTH	PRE-WET		TEST - 1" DROP		TIME
			START	STOP	START	STOP	
	1	12'	1032	NO	PERK	1103	33
	1A	5	1035	1055	1055		
	2						
	3	12'	1007	1022	1022	overtime	
	3A	4'	1004	1016	1016	1022	6
	4	12'	1015	water coming in pit needs covered			
	4A	6'	1011	1013	1013	1020	7
	2A						
	4B	6	1050	1107	NO	PERK 1107 at 1107	(17)
	3B	4'	1051	1106	NO	PERK 1106 at 1106	(15)

Soil 104A

REMARKS

hole 1A soil dry was Red + Damp | pit 4 - clay sand after 6' pit 4 (water breaking at 11 1/2')

TYPE OF SOIL

PRELIMINARY

# APPLICATION

A 18464

## SEWAGE DISPOSAL TESTING

P \_\_\_\_\_

STATE OF MARYLAND - DEPARTMENT OF HEALTH AND MENTAL HYGIENE

HOWARD COUNTY HEALTH DEPARTMENT  
ENVIRONMENTAL HEALTH SERVICES

DISTRICT 4th

P. O. BOX 476, ELLICOTT CITY, MARYLAND 21043  
TELEPHONE: 465-5000, EXT. 356

DATE 5/7/73

TO: THE COUNTY HEALTH OFFICER  
ELLICOTT CITY, MARYLAND

I, HEREBY, APPLY FOR THE NECESSARY TEST IN ORDER TO CONSTRUCT (OR RECONSTRUCT) A SEWAGE DISPOSAL SYSTEM.

PROPERTY OWNER Hansen Watkins property

ADDRESS Woodbine, Maryland Any questions call Wm. Fresch  
PHONE 424-2900

PROPERTY LOCATION:

SUBDIVISION \_\_\_\_\_ LOT NO. Parcel 6

ROAD AND DESCRIPTION Md. Route 144 - 1200 ft. from Carr's Mill Road

SIZE OF LOT 7 8.018 acres TYPE BLDG. 3 or 4 bedrooms  
NUMBER OF BEDROOMS

IF NOT SINGLE RESIDENCE DESCRIBE \_\_\_\_\_

THE SYSTEM INSTALLED UNDER THIS APPLICATION IS ACCEPTABLE ONLY UNTIL PUBLIC FACILITIES BECOME AVAILABLE.

SIGNATURE OF APPLICANT /s/ William E. Fresch


APPROVED BY \_\_\_\_\_ FOR \_\_\_\_\_ DATE \_\_\_\_\_  
(KIND OF SYSTEM)

REJECTED BY \_\_\_\_\_ FOR \_\_\_\_\_ DATE \_\_\_\_\_  
(KIND OF SYSTEM)

HOLD PENDING FURTHER TESTS \_\_\_\_\_ DATE \_\_\_\_\_

REASONS FOR REJECTION OR HOLDING \_\_\_\_\_

# THIS IS NOT A PERMIT

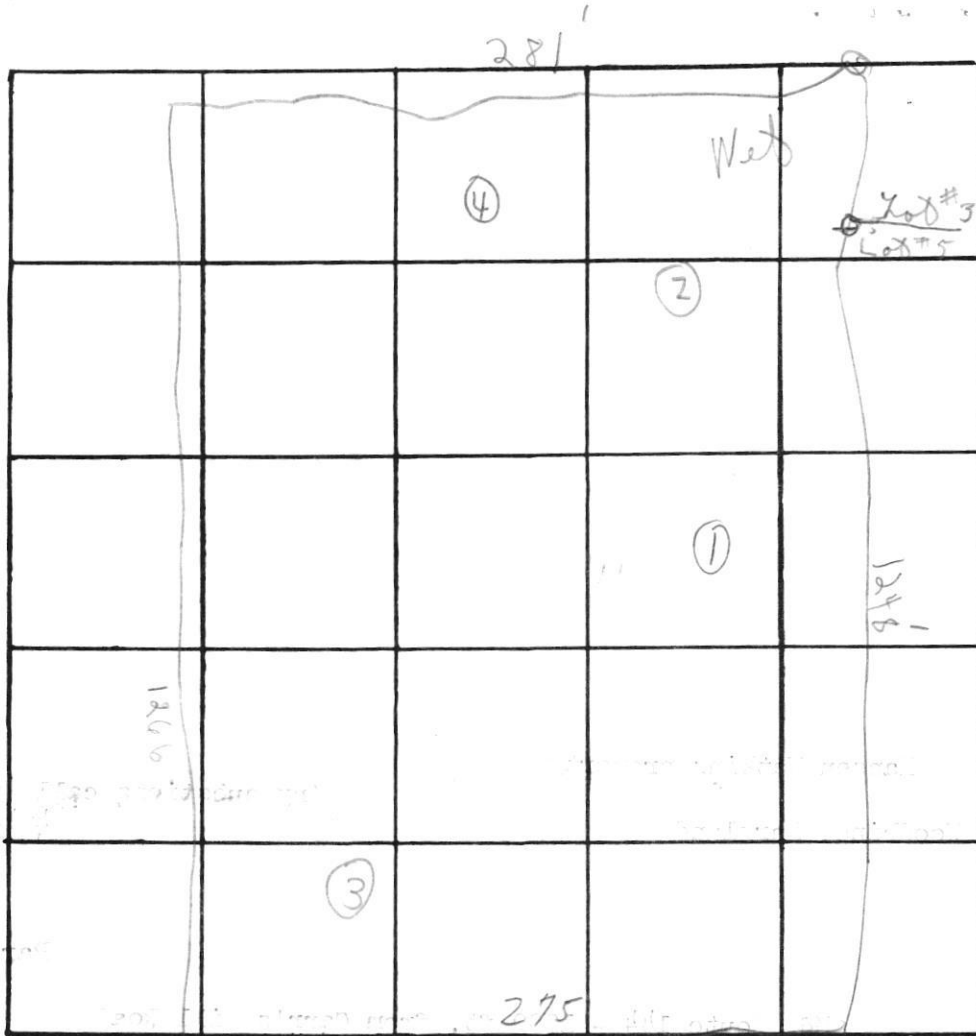

INDICATE NORTH - NAME ADJOINING ROADWAY AS BASE LINE

RD 144

Lot Fairly level

DATE	TEST NO.	DEPTH	PRE-WET		TEST - 1" DROP		TIME
			START	STOP	START	STOP	
	1	2'	Water				
	2	5'	Water				
	3	7'	Water				
	4	8'	Water				

REMARKS Hold for supervisor  
 TYPE OF SOIL White color soil & Clayish



1. This screen allows you to search the Real Property database and display property records.
2. Click **here** for a glossary of terms.
3. Deleted accounts can only be selected by Property Account Identifier.
4. The following pages are for information purpose only. The data is not to be used for legal reports or documents. While we have confidence in the accuracy of these records, the Department makes no warranties, expressed or implied, regarding the information.

January 30, 1976

Mr. Hansen Watkins  
Suite 200  
401 N. Washington Street  
Rockville, Maryland 20850

Dear Sir:

This is to certify that the 8.018 acres owned by you on Maryland Route 144 - 1200 ft. from intersection of Carr's Mill Road, Woodbine, Maryland has failed to pass the standard percolation test. Therefore, this lot is non-buildable until public sewer serves the area.

Very truly yours,

Palmer F. Wine, Director  
Environmental Health

PFW:jr