

APPLICATION

SEWAGE DISPOSAL TESTING

MARYLAND STATE DEPARTMENT OF HEALTH

HOWARD COUNTY

ELLICOTT CITY

DISTRICT 2

DATE 3/19/68

A 13457
13456
P _____

*Preliminary 3/20/68
9:30*

*3/20/68 - accept no more appointments
for this lot as it has been given a final
rejection. SLM*

TO: THE COUNTY HEALTH OFFICER
ELLICOTT CITY, MARYLAND

I, HEREBY, APPLY FOR THE NECESSARY TESTS IN ORDER TO CONSTRUCT (OR RECONSTRUCT) A SEWAGE DISPOSAL SYSTEM.

PROPERTY OWNER Alva Ramsburg

ADDRESS Balto. Nat'l. Pike PHONE _____

PROPERTY LOCATION:

SUBDIVISION _____ LOT NO. 1

ROAD AND DESCRIPTION Route 144 - near Meyers Veterinarian Hospital

OCCUPANT _____ PHONE _____

PERSON TO CONSTRUCT SYSTEM _____

ADDRESS _____ PHONE _____

SIZE OF LOT Approx. 40,000 sq. ft. TYPE BLDG. _____

NUMBER OF BEDROOMS _____

IF NOT SINGLE RESIDENCE DESCRIBE _____

SIGNATURE OF APPLICANT *Shannon A. Bessie*


APPROVED BY _____ FOR _____ DATE _____

REJECTED BY Donald W. Monaghan FOR Septic System DATE 3-20-68

HOLD PENDING FURTHER TESTS _____ DATE _____

REASONS FOR REJECTION OR HOLDING 3/20/68 - poor soil and high water table in area tested
rest of lot not tested because it is higher than building site and
city water not available. SLM

THIS IS NOT A PERMIT

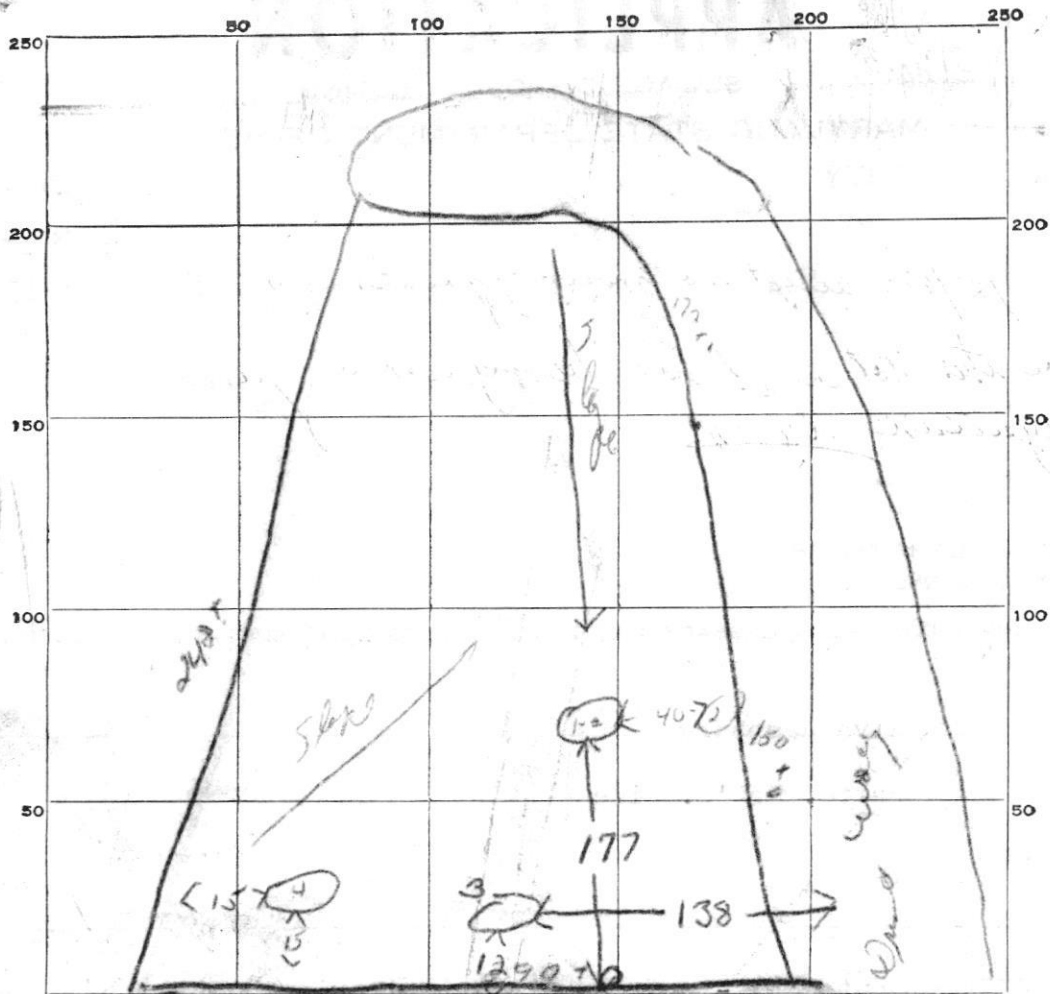

INDICATE NORTH. - NAME ADJOINING ROADWAY AS BASE LINE.

Route 144

DATE	TEST NO.	DEPTH	PRE-WET		TEST - 1" DROP		TIME
			START	STOP	START	STOP	
3/10/6	1	9 ft	first 4	4 1/2 ft clay - then water breaking in at about 7 1/2 ft			
	3		from grad - first 4 ft clay.				
	H	11 ft	poor soil - mostly clay - very damp - slight seepage of water				

SOIL AUGER FINDING

TESTED BY

REMARKS

also present → C. T. ...
 pit #14 on high on part of lot - high than bldg site - ...
 because it is higher than bldg site
 Lot 1

APPLICATION

SEWAGE DISPOSAL TESTING

MARYLAND STATE DEPARTMENT OF HEALTH

HOWARD COUNTY

ELLICOTT CITY

DISTRICT 2

DATE 3/19/68

A 13457
~~13456~~

P _____

*3/20/68 - accept no more appointments
for this lot as it has been given a final
rejection see*

TO: THE COUNTY HEALTH OFFICER
ELLICOTT CITY, MARYLAND

I, HEREBY, APPLY FOR THE NECESSARY TESTS IN ORDER TO CONSTRUCT (OR RECONSTRUCT) A SEWAGE DISPOSAL SYSTEM.

PROPERTY OWNER Alva Ramsburg

ADDRESS Balto. Nat'l. Pike PHONE _____

PROPERTY LOCATION:

SUBDIVISION _____ LOT NO. 1

ROAD AND DESCRIPTION Route 144 - near Meyers Veterinarian Hospital

OCCUPANT _____ PHONE _____

PERSON TO CONSTRUCT SYSTEM _____

ADDRESS _____ PHONE _____

SIZE OF LOT Approx. 40,000 sq. ft. TYPE BLDG. 3
NUMBER OF BEDROOMS

IF NOT SINGLE RESIDENCE DESCRIBE _____

SIGNATURE OF APPLICANT Shuman & Burt

APPROVED BY _____ FOR _____ DATE _____

REJECTED BY Donald W. Monaghan FOR Septic Sys tem DATE 3-20-68
(KIND OF SYSTEM)


HOLD PENDING FURTHER TESTS _____ DATE _____

REASONS FOR REJECTION OR HOLDING 3/20/68 - poor soil and high water table in area tested

rest of lot not tested because it is higher than building site and
city water not available. See

THIS IS NOT A PERMIT

ROUTE 144

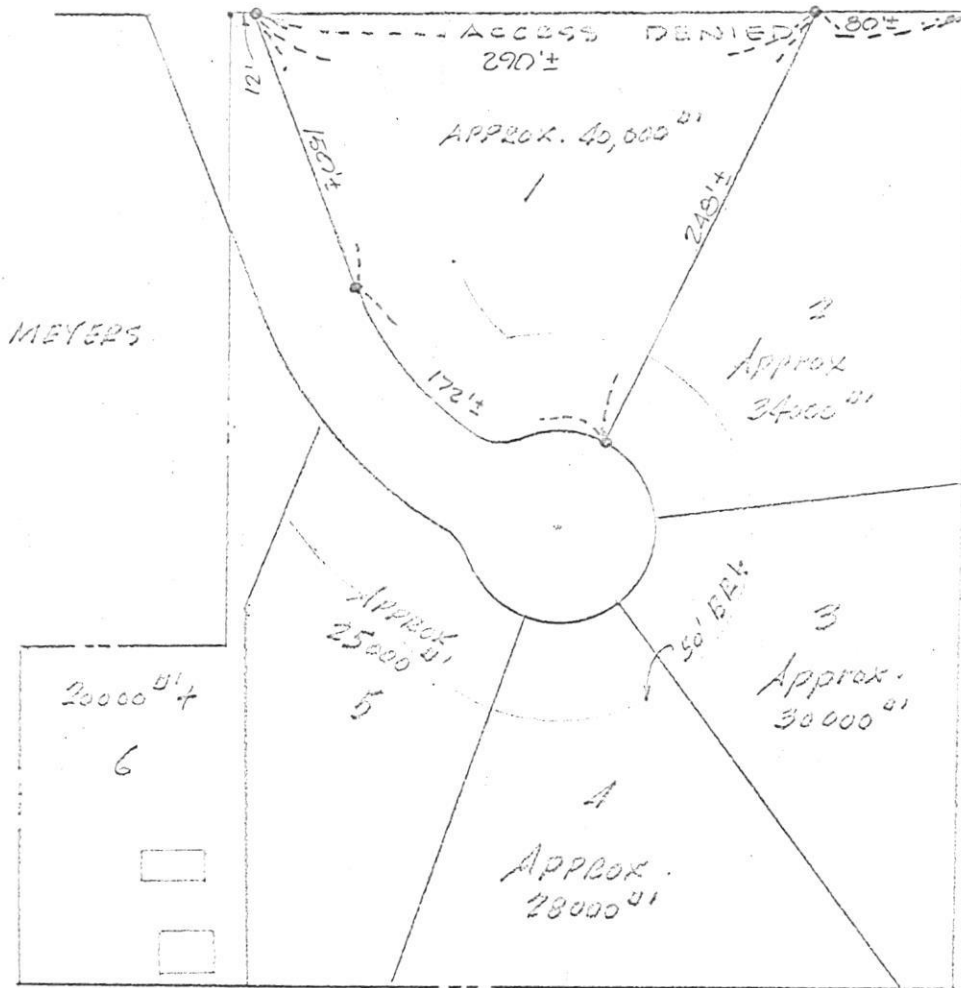

SKETCH PLAN

RAMSBURG RESIDUE

2ND. Elect. Dist.

How. Co. MD

SCALE 1" = 100'

PURDUM & JESCHKE
ENGINEERS
24 PARK AVENUE
ELLCOTT CITY, MD