



HOWARD COUNTY HEALTH DEPARTMENT

P5 28854

DATE
3 / 21 / 08

Received From

Fogles Septic Clean, Inc

PHONE # 410-795-5670

580 Oberacht Rd, Dykesville MD 21784

For

Septic Pump - Tank Replacement

12119 Sudbury Court (Ashleigh Green Lot 21)

CASH

CHECK

NO.

2591

One hundred sixty-five and 00/100 Dollars

\$

165 00

Received By

Mary L Buggs

LAYOUT _____ INSP 4 _____

INSP 2 _____ INSP 5 _____

INSP 3 _____ INSP 6 _____

ISSUE DATE: 3/21/08

APPROVAL DATE: _____

PERMIT

854
P 528~~954~~

A 528896

Minor Septic Repair TAX ID # ON-SITE SEWAGE DISPOSAL SYSTEM HOWARD COUNTY HEALTH DEPARTMENT BUREAU OF ENVIRONMENTAL HEALTH

Fogles Septic Clean IS PERMITTED TO INSTALL ALTER

ADDRESS: 580 Obrecht Rd PHONE NUMBER: 410-795-5670

SUBDIVISION: _____ LOT NUMBER: _____

ADDRESS: 12119 Sudbury Ct PROPERTY OWNER: Douglas & Barbara Shipe

SEPTIC TANK CAPACITY (GALLONS): 2000 OUTLET BAFFLE FILTER REQUIRED

PUMP CHAMBER CAPACITY (GALLONS): _____ COMPARTMENTED TANK REQUIRED

NUMBER OF BEDROOMS: _____

SQUARE FEET PER BEDROOM: _____

LINEAR FEET OF TRENCH REQUIRED: _____

TRENCHES:	Trench to be _____ feet wide. Inlet _____ feet below original grade. Bottom maximum depth _____ feet below original grade. Effective area begins at _____ feet below original grade. _____ feet of stone below distribution pipe.
LOCATION:	Keep tank 20' from proposed addition.
NOTES:	Collapse and fill existing tank. Install 2,000 gallon tank, maintain gravity flow to d-box.


PLANS APPROVED: Heidi Scott DATE: 6/2/08

- NOTE: PERMIT VOID AFTER 2 YEARS
- NOTE: CONTRACTOR RESPONSIBLE FOR SCHEDULING A PRE-CONSTRUCTION INSPECTION FOR ALL INSTALLATIONS
- NOTE: WATERTIGHT SEPTIC TANKS REQUIRED
- NOTE: ALL PARTS OF SEPTIC SYSTEM SHALL BE 100 FEET FROM ANY WATER WELL
- NOTE: MANHOLE RISERS REQUIRED ON ALL SEPTIC TANKS AND PUMP CHAMBERS UNLESS SPECIFICALLY AUTHORIZED

NEITHER THE HOWARD COUNTY COUNCIL NOR THE HEALTH DEPARTMENT IS RESPONSIBLE FOR THE SUCCESSFUL OPERATION OF ANY SYSTEM PERMITTEE RESPONSIBLE FOR OBTAINING FINAL APPROVAL ON THIS PERMIT CALL 410-313-1771 FOR INSPECTION OF SEPTIC SYSTEM

NOT TO SCALE

438852

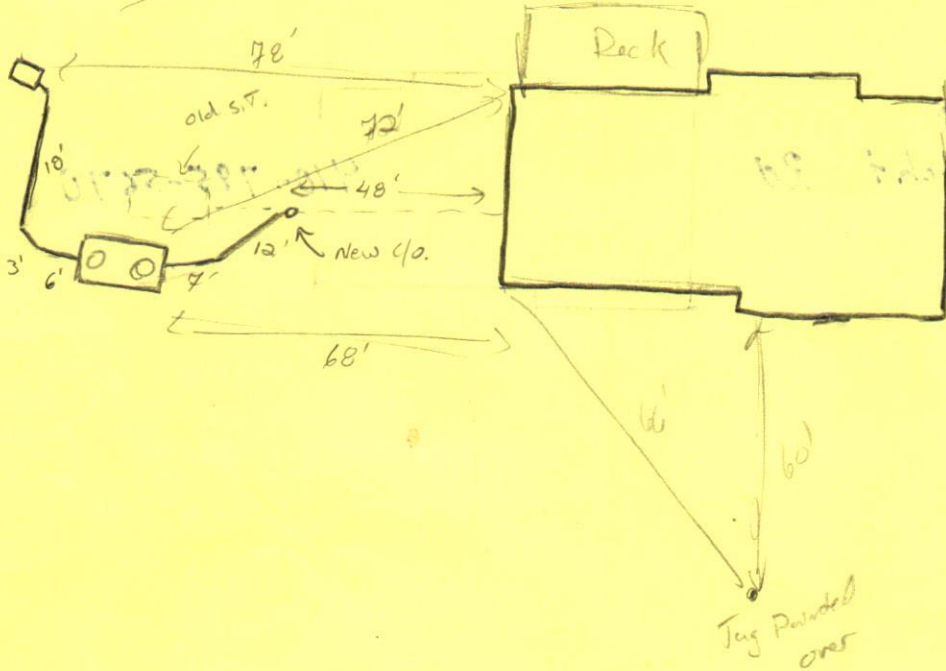

TRENCH/DRAINFIELD DATA

WIDTH	INLET	BOTTOM
_____	_____	_____
NUMBER OF TRENCHES _____		
TOTAL LENGTH _____		
ABSORPTION AREA _____		
DISTRIBUTION BOX LEVEL _____		
DISTRIBUTION BOX BAFFLE _____		
DISTRIBUTION BOX PORT _____		

SEPTIC TANK DATA

SEPTIC TANK 1 LEVEL Yes

CAPACITY 2000 GAL

SEAM LOC Top

TANK LID DEPTH 2.5-3'

BAFFLES Yes

BAFFLE FILTER _____

MANHOLE LOC Front/Rear

6" PORT LOC _____

WATERTIGHT TEST _____

SEPTIC TANK 2 LEVEL _____

CAPACITY _____ GAL

SEAM LOC _____

TANK LID DEPTH _____

BAFFLES _____

BAFFLE FILTER _____

MANHOLE LOC _____

6" PORT LOC _____

WATERTIGHT TEST _____

Babylon slotted

2nd well?

Sudbury Ct. ROAD

PRE-CONSTRUCTION _____

INSTALLATION 6/12/08 New 2000g S.T. installed next to ex. S.T. which was pumped and collapsed. Tied plumbing back in ex. plumbing coming out of tank. c/o added @ entry point of connection. OK to build Mr. [Signature]

FINAL INSPECTOR [Signature] DATE OF APPROVAL 6/12/08

SEPTIC SPECIFICATIONS WORKSHEET

Subdivision _____ A 528896

Street Name 12119 Sudbury Ct. Lot Number _____

Average Percolation Rate(min./in.) _____ Application Rate (GPD/sq. ft.) _____

Number of Bedrooms _____ Design Flow (BRx150) _____

Square Footage (of House) _____ Septic Tank Capacity (gal.) 2,000

Sidewall Credit / % Reduction _____ / _____ Total Length of Trench (ft.) _____

***All Septic/Pump tanks must be top seamed unless otherwise approved by this agency.**

***All Septic tanks must be compartmented unless otherwise approved by this agency.**

Baffle Filter Required? Yes No

TRENCH DIMENSIONS: Trench to _____ feet wide. Inlet at _____ feet below original grade. Bottom maximum depth _____ feet below original grade. Effective area begins at _____ feet below original grade. _____ feet of stone below the distribution pipe.

PUMP SYSTEM PROPOSED? YES NO

Pump system details: _____ gallon pump chamber

Note 1: Septic pump detail to be provided by installer prior to issuance of septic permit.

Note 2: Pump performance test required prior to Health Department approval of pumped septic system.

LOCATION: ^{Keep tank} ~~deep~~ 20' from proposed addition

ADDITIONAL NOTES: Collapse and fill existing tank. Install 2,000 gallon tank, maintain gravity flow to d-box

Reviewed by: HS

Date: 6-2-08