

Bureau of Environmental Health
 8930 Stanford Boulevard, Columbia, MD 21045
 Main: 410-313-2640 | Fax: 410-313-2648
 TDD 410-313-2323 | Toll Free 1-866-313-6300
www.hchealth.org
 Facebook: www.facebook.com/hocohealth

Maura J. Rossman, M.D., Health Officer

RECEIPT DATE: 9/16/22 **ONSITE SEWAGE DISPOSAL SYSTEM** P 572176

APPROVAL DATE: 11/23/2022 **PERMIT: TANK REPLACEMENT** A _____

PROPERTY ADDRESS: 13815 Dayton Meadows Court

SUBDIVISION: _____ LOT: _____ TAX ID: _____

CONTRACTOR: Fogle's Septic Clean Inc. EMAIL: kim@foglesinc.com

CONTRACTOR ADDRESS: 580 Obrecht Road, Sykesville, MD 21784 PHONE: 410-795-5670

PROPERTY OWNER: Brad Johns EMAIL: _____

OWNER ADDRESS: 13815 Dayton Meadows Court, Dayton, MD 21036 PHONE: _____

SEPTIC TANK SIZE (GALLONS): 2000g TANK MANUFACTURER: _____

PUMP MODEL: _____ PUMP SIZE: _____ PUMP TANK CAPACITY: _____

DISTRIBUTION SYSTEM: GRAVITY PRESSURE DOSED BEDROOMS: _____ APPLICATION RATE: _____


TRENCHES:	LINEAR FEET REQUIRED: _____	INLET DEPTH: _____
	TRENCH WIDTH: _____	MAXIMUM BOTTOM DEPTH: _____
	MINIMUM SPACE BETWEEN TRENCHES: _____	EFFECTIVE AREA BEGINNING DEPTH: _____
LOCATION:	INSTALL REPLACEMENT SEPTIC TANK PER PLAN	
NOTES:	<i>install new 2000g tank. Abandon and seal ex tank</i>	

ISSUED BY: CASHIG 001997 ISSUE DATE: 09/21/2022 EXPIRATION DATE: 09/21/2023

- NOTE: **CONTRACTOR MUST SCHEDULE A PRE-CONSTRUCTION INSPECTION PRIOR TO BEGINNING ANY INSTALLATION**
- NOTE: CONTRACTOR MUST SCHEDULE AN INSPECTION AND GAIN APPROVAL OF ALL COMPONENTS PRIOR TO COVERING
- NOTE: STONE MUST BE APPROVED BY HEALTH DEPARTMENT AND GRAVEL TICKET MUST BE AVAILABLE FOR REVIEW.
- NOTE: WATERTIGHT TANKS REQUIRED
- NOTE: ALL PARTS OF SEPTIC SYSTEM SHALL BE AT LEAST 100 FEET DOWNGRADIENT FROM ANY WATER WELL
- NOTE: MANHOLE RISERS REQUIRED ON ALL SEPTIC TANKS AND PUMP CHAMBERS
- NOTE: **AN ELECTRICAL PERMIT IS REQUIRED FOR INSTALLATION OF ANY ELECTRICAL COMPONENTS OF THE SYSTEM**
 ELECTRICAL PERMIT ISSUED E _____
- NOTE: **MDE RECOMMENDS SEPTIC TANKS, BAT, AND OTHER PRETREATMENT UNITS BE PUMPED AT A FREQUENCY ADEQUATE TO ENSURE THAT SOLIDS ARE NOT DISCHARGED TO THE DISPOSAL AREA**

**NEITHER THE HOWARD COUNTY COUNCIL NOR THE HEALTH DEPARTMENT IS RESPONSIBLE FOR THE SUCCESSFUL OPERATION OF ANY SYSTEM.
 PERMITTEE RESPONSIBLE FOR OBTAINING FINAL APPROVAL ON THIS PERMIT.
 CALL 410-313-1771 TO SCHEDULE INSPECTIONS.**

NOT TO SCALE ~ 1:40

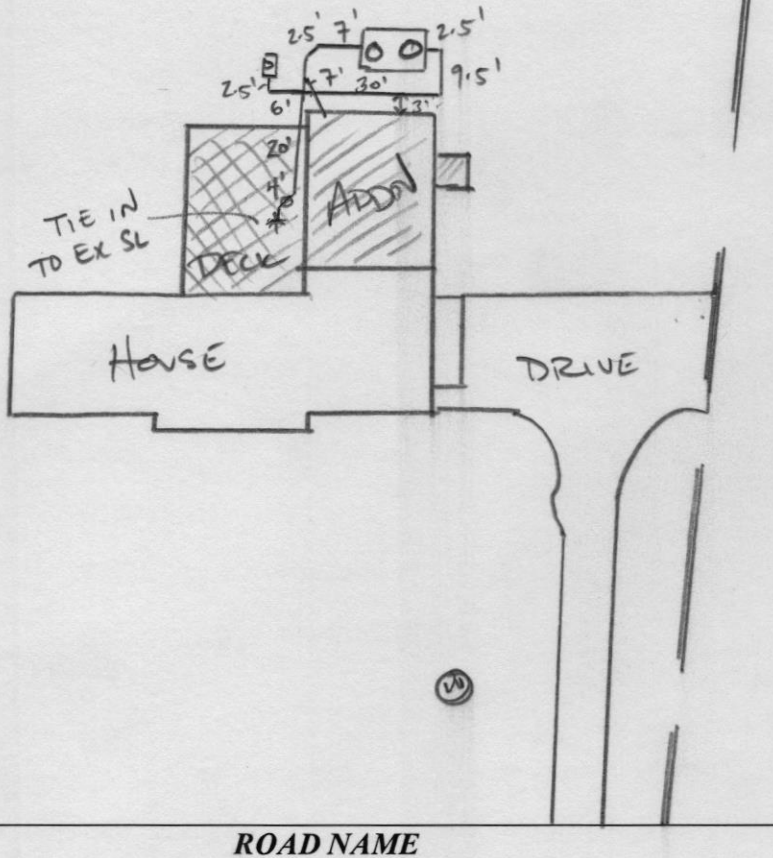

TRENCH/DRAINFIELD DATA

WIDTH INLET BOTTOM

EXISTING

NUMBER OF TRENCHES _____

TOTAL LENGTH _____

ABSORPTION AREA _____

DISTRIBUTION BOX LEVEL _____

DISTRIBUTION BOX BAFFLE _____

DISTRIBUTION BOX PORT _____

SEPTIC TANK DATA

SEPTIC TANK 1 LEVEL yes

MANUFACTURER Babylon

CAPACITY 2000 GAL

SEAM LOC top

TANK LID DEPTH 3'

BAFFLES yes

BAFFLE FILTER -

MANHOLE LOC front/back

6" PORT LOC -

WATERTIGHT TEST -

SLOTTED yes

DATE ON LID 11/03/2022

PUMP/SEPTIC TANK LEVEL _____

MANUFACTURER _____

CAPACITY _____ GAL

SEAM LOC _____

TANK LID DEPTH _____

BAFFLES _____

BAFFLE FILTER _____

MANHOLE LOC _____

6" PORT LOC _____

WATERTIGHT TEST _____

SLOTTED _____

DATE ON LID _____

PRE-CONSTRUCTION:

11/21/2022 Confirmed tank placement; addition plugged in the field. J

INSTALLATION:

11/23/2022 (AM) SL tied in, tank set. Original as-built showed more distance to D-Box than reality. Rotate tank (PM) back line to d-box completed. Ok to backfill. J

FINAL INSPECTOR

DATE OF APPROVAL

11/23/2022

Howard County Health Department

Bureau of Environmental Health, Columbia, MD 21045 - 410-313-1771

SEWAGE DISPOSAL PERMIT NO. A- _____ P- 572176

RESIDENTIAL PERMIT
(NUMBER OF BEDROOMS: _____)

COMMERCIAL PERMIT
(DESIGN FLOW: _____ GPD)

PERMITEE: Fogles Septic Clean Inc.

LOCATION: 13815 Dayton Meadows Court

****POST THIS CARD WHERE IT CAN BE SEEN FROM ROAD****

STOP ALL CONSTRUCTION ON SEWAGE
DISPOSAL SYSTEM AND CONTACT HEALTH
DEPARTMENT BEFORE CONTINUING

Inspector

Date

WORK IS SATISFACTORY, OK TO
CONTINUE

Inspector

Date

COMMENTS: _____


FINAL INSPECTION MADE, OK TO
COVER ALL WORK

Inspector

Date

3ERD
HENR/T/R

Dayton Meadows Ct

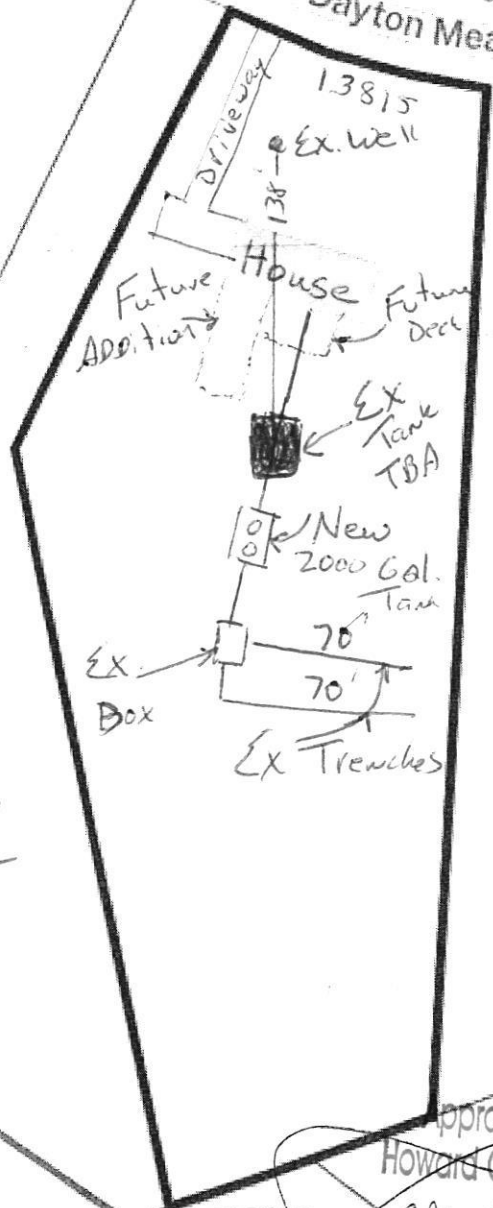

Dropped off
with permit
Application to
HCHD
ON 9-19-22


Approved Septic System Plan
Howard County Health Department

[Signature]
Signature Date

09/21/2022

3E RD
HENR T/R

Dayton Meadows Ct

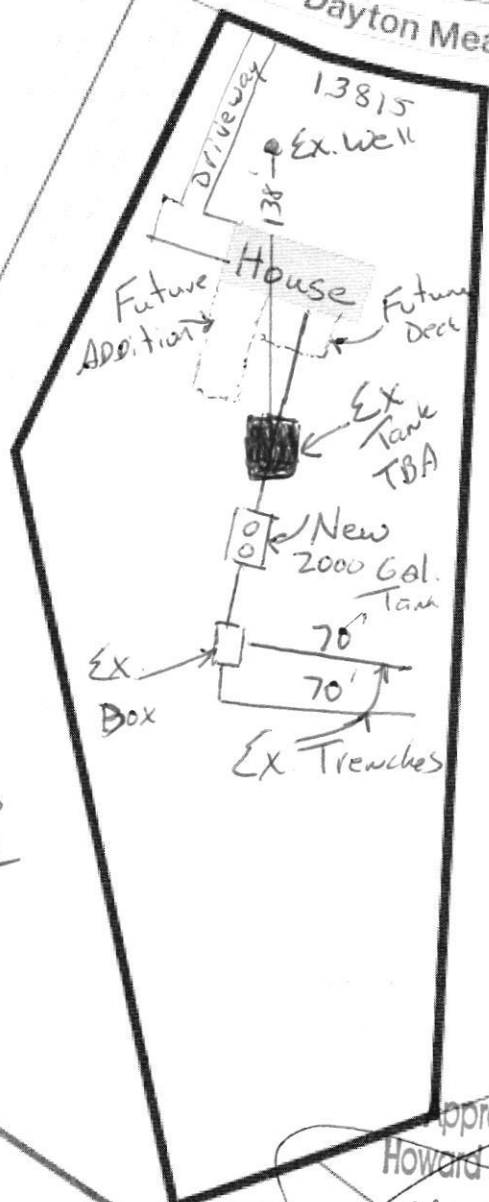

Dropped off
with permit
Application to
HCHD
ON 9-19-22

Approved Septic System Plan
Howard County Health Department

Signature

Date

[Handwritten Signature] 09/21/2022

SEP 19 2022
Environmental Health

Environmental Health
Department
1000 ...
[Illegible text]

1000 ...

