


**2 PART. SECOND FLOOR PLAN** W/OPT.030 - ADDITIONAL WALK IN CLOSET  
 A-120 SCALE: 1/4"=1'-0"  
 12/11/2010

- GENERAL PLAN NOTES**
- A. ALL ROOM PARTITIONS NOT DIMENSIONED ARE TO BE 3/4" FOR INTERIOR AND 5/8" FOR EXTERIOR WALLS UNLESS OTHERWISE NOTED.
  - B. ALL INTERIOR DIMENSIONS ARE TO FACE OF STUDS.
  - C. ALL EXTERIOR DIMENSIONS ARE TO FACE OF STUDS.
  - D. ALL DIMENSIONS GOVERN OVER SCALE.
  - E. ALL SMOKE DETECTORS ARE TO BE WIRED IN SUCH A MANNER THAT ACTIVATION OF ONE WILL ACTIVATE THEM ALL.
  - F. ENCLOSED ACCESSIBLE SPACE UNDER STAIRS SHALL HAVE WALLS AND SOFFITS PROTECT COLOR ENCLOSED AREA WITH 1/2" GYPSUM BOARD.
  - G. ALL WINDOW SIZES ARE NOTED IN FEET + INCHES AS MEASURED FROM SASH TO SASH.
  - H. REFER TO ELEVATIONS FOR WINDOW HEAD HEIGHTS.
  - I. ALL DOORS ARE TO BE 6'-8" HIGH UNLESS OTHERWISE NOTED.
  - J. NUMBER ALWAYS TO BE ON LEFT SIDE OF SYMBOL.
  - K. DIMENSIONS ALWAYS TO BE ON RIGHT SIDE OF DIM.

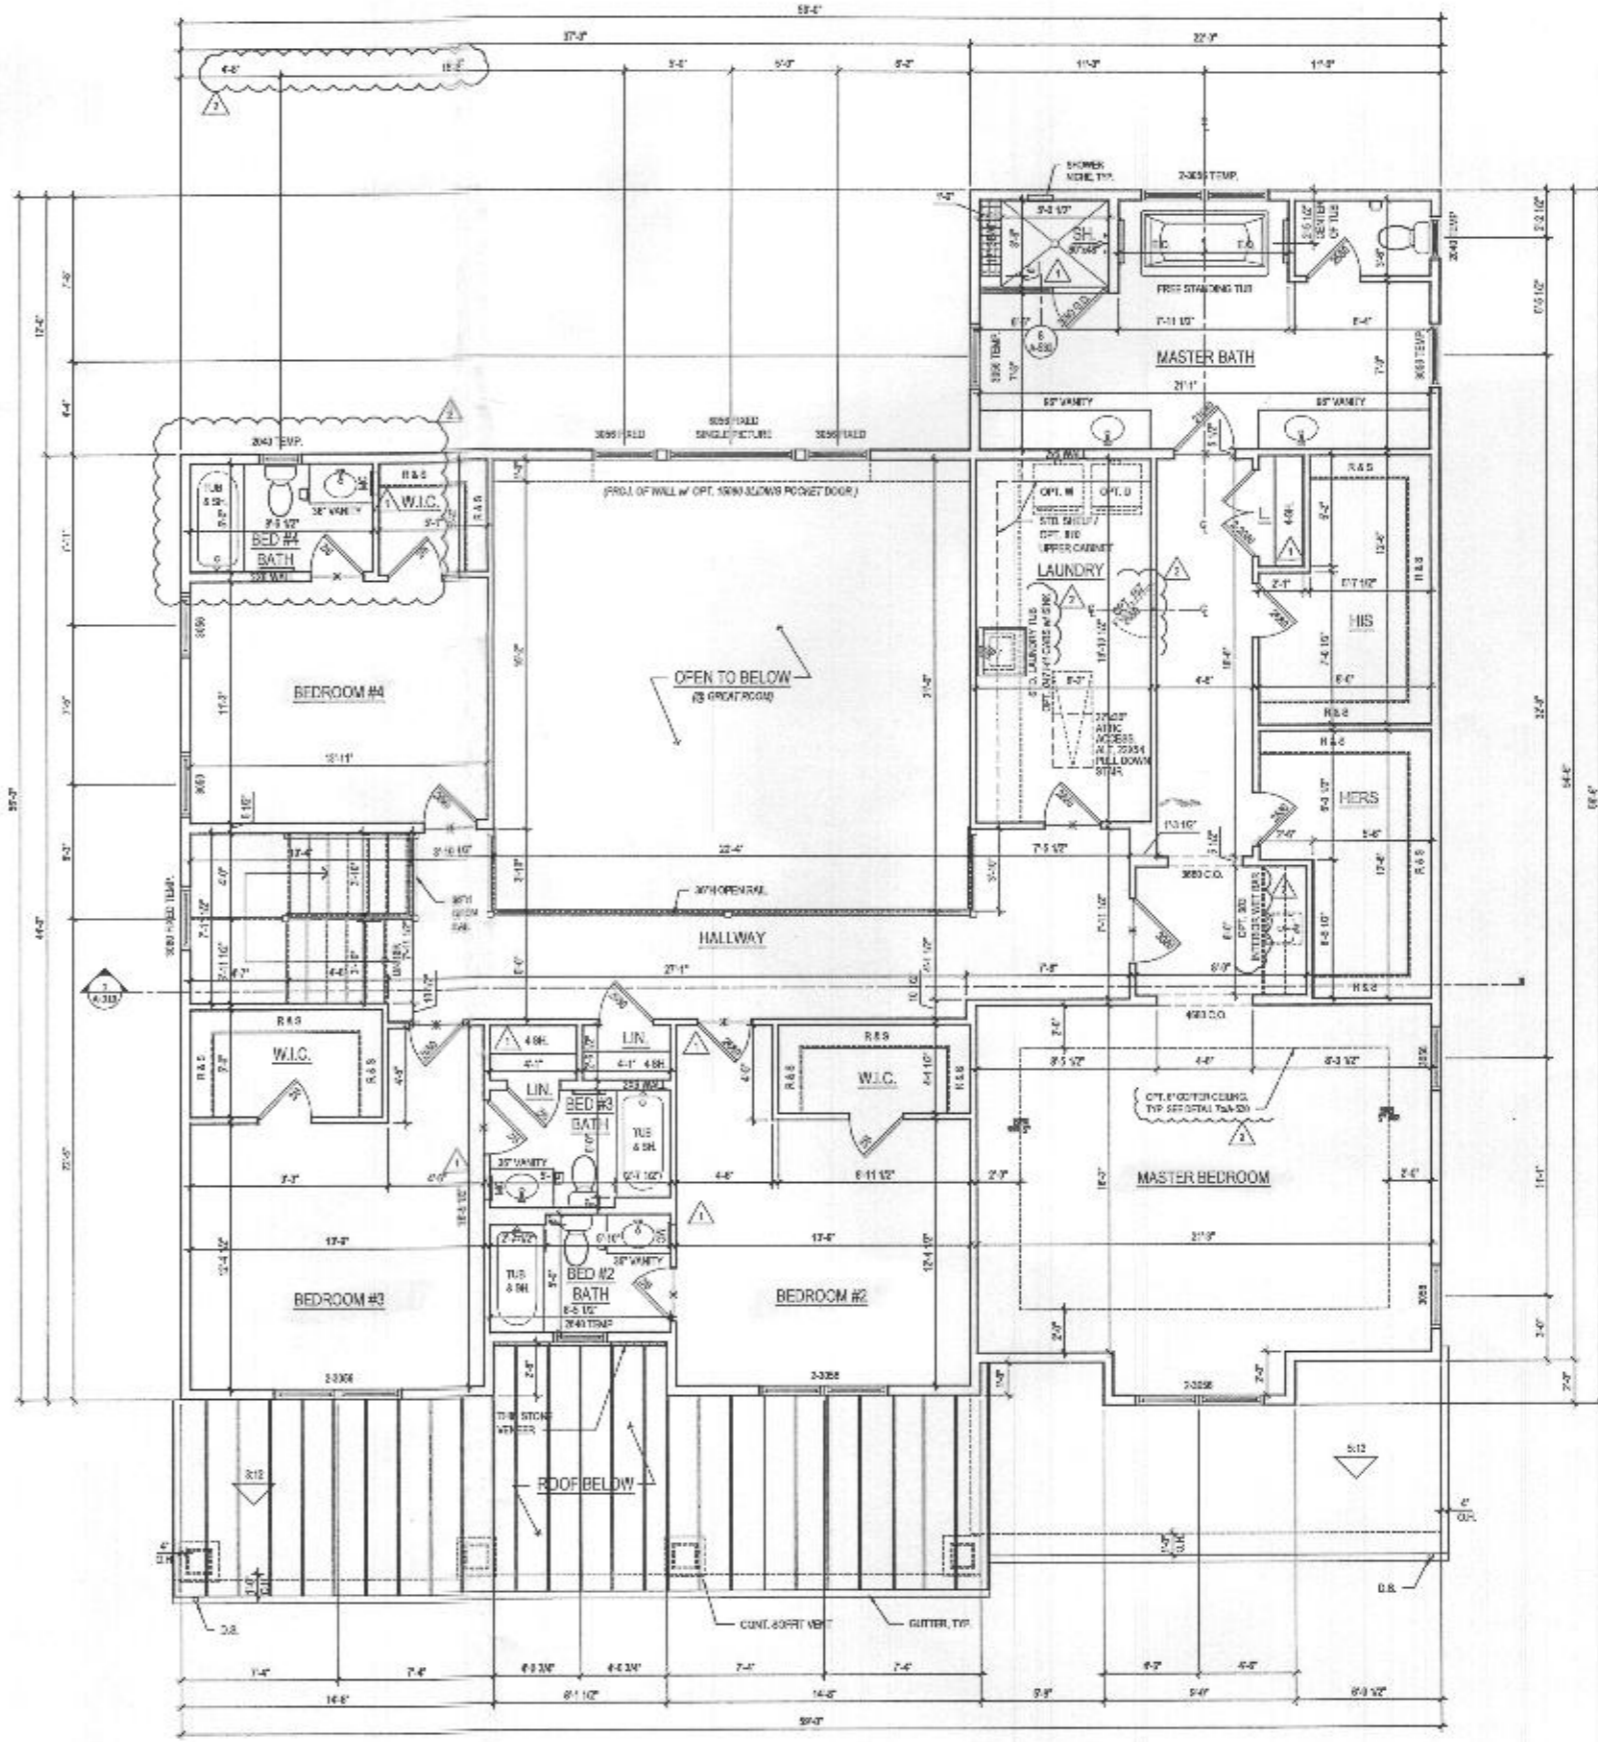

**1 SECOND FLOOR PLAN**  
 A-120 SCALE: 1/4"=1'-0"  
 12/11/2010

@ ELEV. 1 - CRAFTSMAN *Shown*  
 See additional pages for "Modern farmhouse" *ELV*

**lessard DESIGN**  
 8521 Leesburg Pike  
 Suite 700 | Vienna, VA 22182  
 P: 571.830.1800 | F: 571.830.1801  
 www.lessarddesign.com

OWNER:  
**TOLL BROTHERS**  
 19775 BELMONT EXECUTIVE PLAZA  
 ASPEN HILL, VA 20147  
 P: 571.291.8288  
 CONTACT: CHRISTINA LEMLEY  
 clemley@tollbrothers.com


PROJECT NAME:  
**MARYLAND PARKHURST FLOOR PLANS**

PROJECT NO.: 101.000  
 DRAWN BY: ACN/A  
 CHECKED BY: AP  
 PLOT DATE: Nov. 25, 2010  
 FILE NAME: 10101010\_A120.dwg


**A-120**

Plot By: *anah*  
 File No: TOLLBRO\_A120.dwg




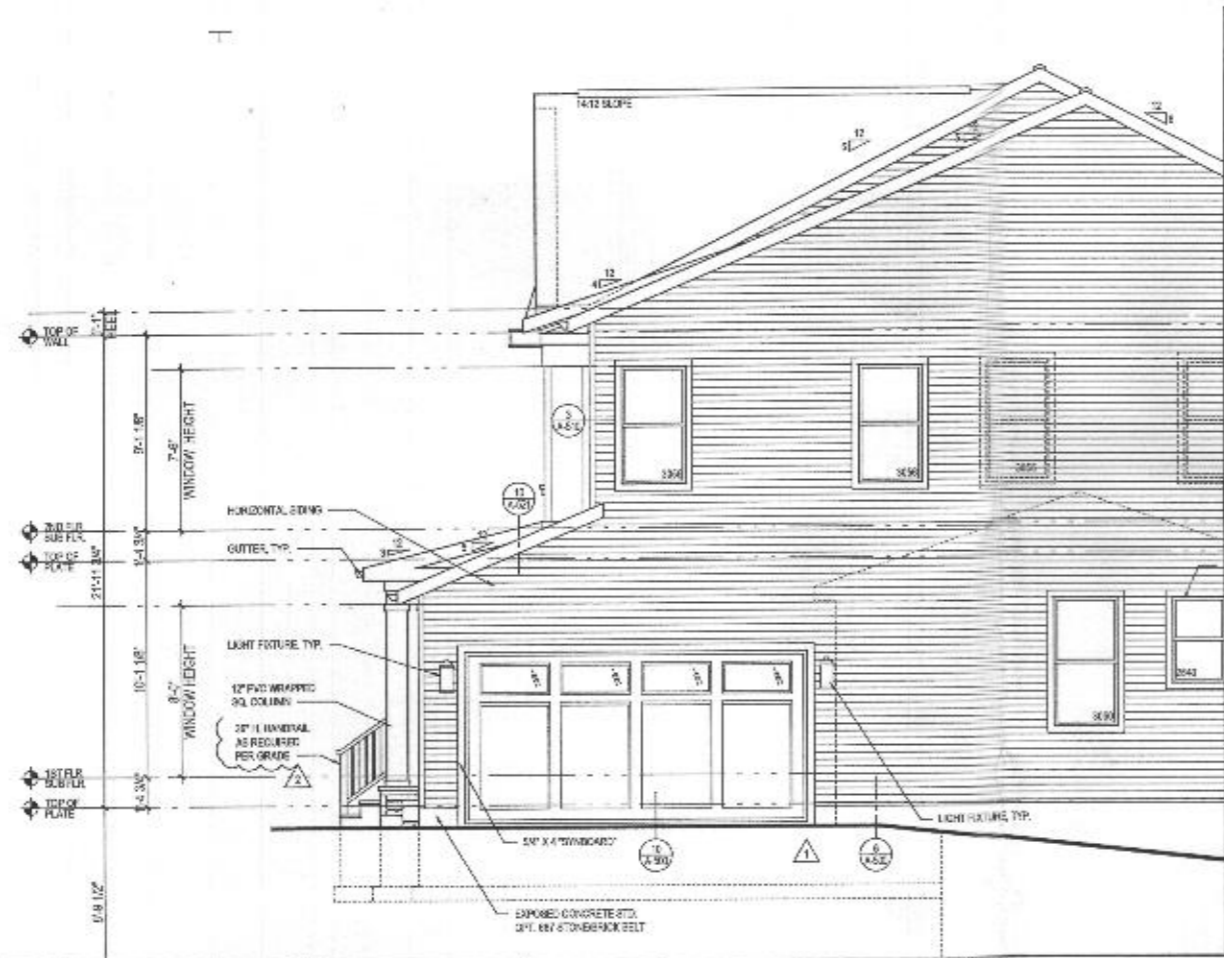

**4 PART. RIGHT SIDE ELEVATION** w/ OPT. 012 - SIDE LOAD GARAGE  
 A-400b SCALE: 1/4"=1'-0"  
 T-02-01-2020

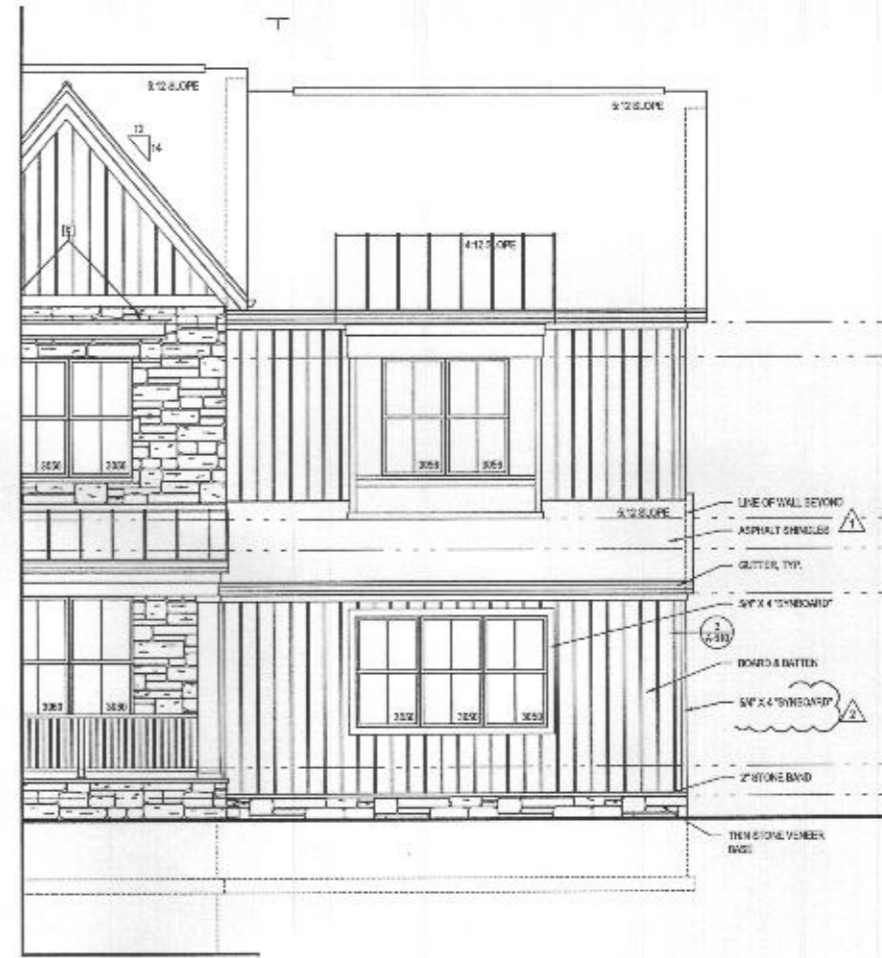


**3 PART. FRONT ELEVATION** w/ OPT. 012 - SIDE LOAD GARAGE  
 A-400b SCALE: 1/4"=1'-0"  
 T-02-01-2020

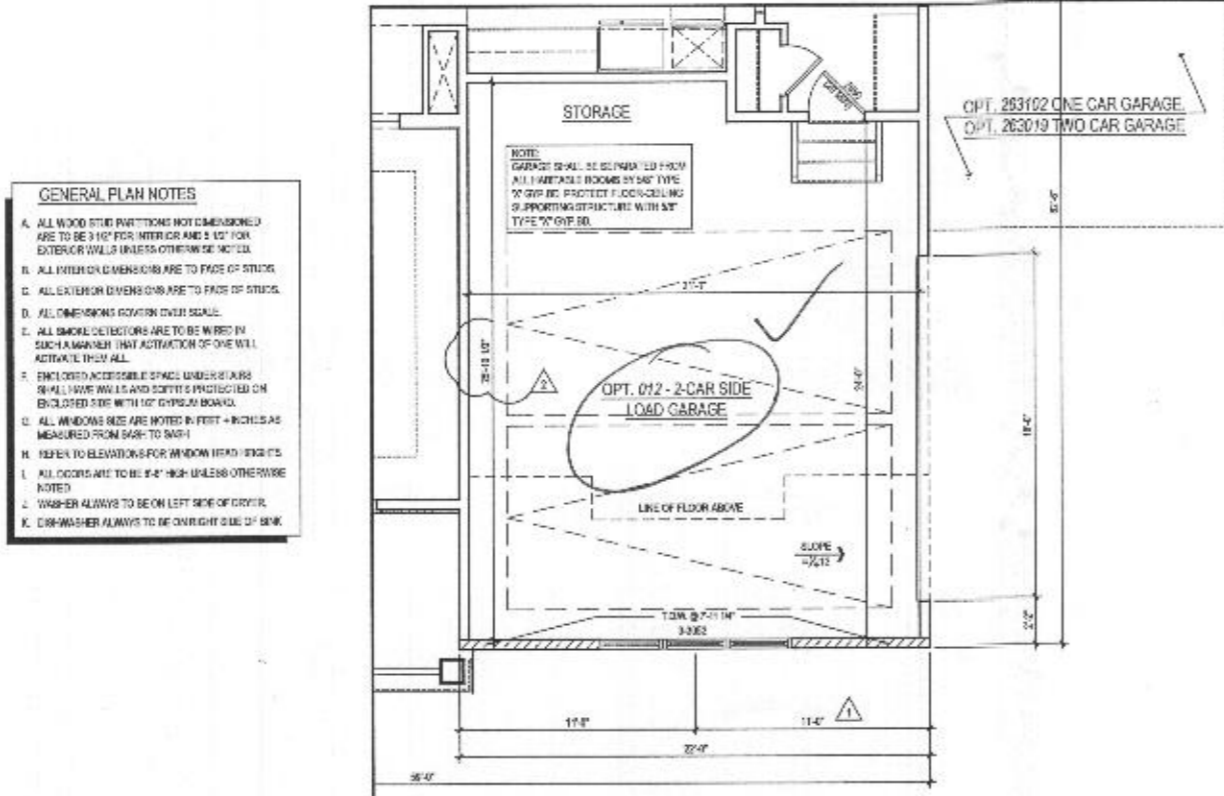

**GENERAL PLAN NOTES**

- ALL WOOD STUD PARTITIONS NOT DIMENSIONED ARE TO BE 3 1/2" FOR INTERIOR AND 2 1/2" FOR EXTERIOR WALLS UNLESS OTHERWISE NOTED.
- ALL INTERIOR DIMENSIONS ARE TO FACE OF STUDS.
- ALL EXTERIOR DIMENSIONS ARE TO FACE OF STUDS.
- ALL DIMENSIONS ROTATE OVER SCALE.
- ALL SMOKE DETECTORS ARE TO BE WIRED IN SUCH A MANNER THAT ACTIVATION OF ONE WILL ACTIVATE THEM ALL.
- ENCLOSED ACCESSIBLE SPACE UNDER STAIRS SHALL HAVE WALLS AND CEILING PROTECTED ON ENCLOSED SIDE WITH 1/2" GYP BOARD.
- ALL WINDOWS ARE MEASURED IN FEET + INCHES AS MEASURED FROM SASH TO SASH.
- REFER TO ELEVATIONS FOR WINDOW HEAD HEIGHTS.
- ALL DOORS ARE TO BE 6'-8" HIGH UNLESS OTHERWISE NOTED.
- WASHER ALWAYS TO BE ON LEFT SIDE OF CUPB.
- DISHWASHER ALWAYS TO BE ON RIGHT SIDE OF SINK.

**2 PART. FIRST FLOOR PLAN** w/ OPT. 012 - SIDE LOAD GARAGE  
 A-400b SCALE: 1/4"=1'-0"  
 T-02-01-2020

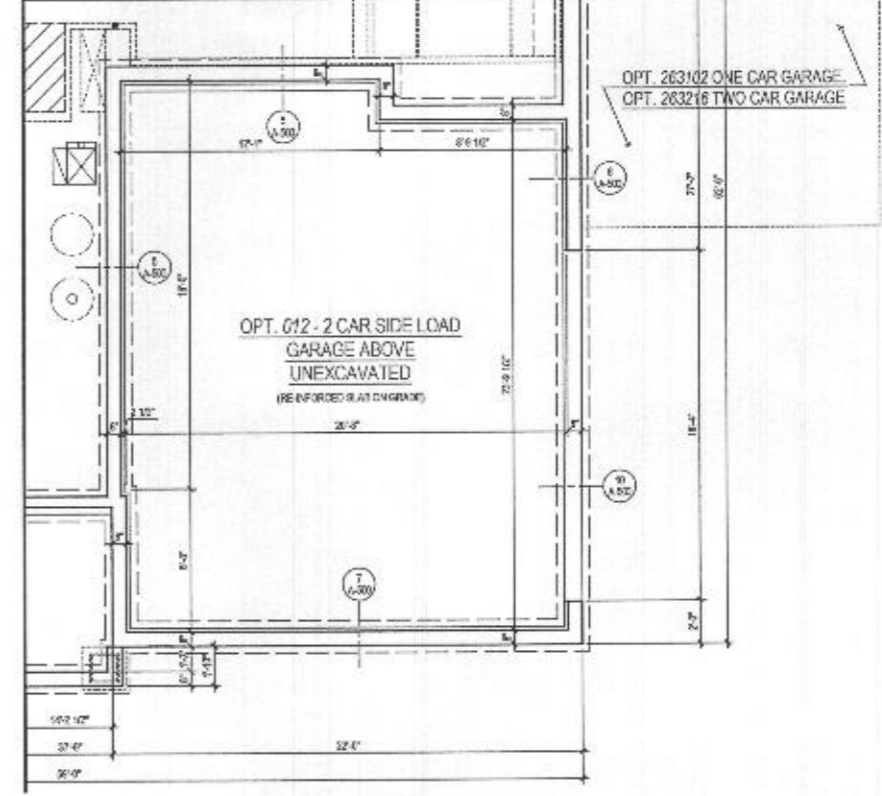

**1 PART. BASEMENT FLOOR PLAN** w/ OPT. 012 - SIDE LOAD GARAGE  
 A-400b SCALE: 1/4"=1'-0"  
 T-02-01-2020

ARCHITECT:

8521 Leesburg Pike  
 Suite 700 | Vienna, VA 22182  
 P: 571.830.1800 | F: 571.830.1801  
 www.lessarddesign.com

SEAL & SIGNATURE:

OWNER:

**TOLL BROTHERS**  
 15775 BELMONT EXECUTIVE PLAZA  
 ARLINGTON, VA 22207  
 P: 571.291.8068  
 CONTACT: C. RISTINA LEMLEY  
 clemley@tollbrothers.com

PROJECT NAME: MARYLAND PARKHURST OPTIONS

SHEET TITLE:

ISSUE / REVISION		
NO.	DESCRIPTION	DATE
1	ISSUE SET	02.23.20
2	PERMIT SET	06.15.20
1	NO NEW STANDARDS	09.15.20
2	REV #220211	12.11.20

PROJECT NO: TOL-0201-2020

DRAWN BY: M.L.B.

CHECKED BY: M.L.B.

PLUT DATE: Jan. 23, 2021

FILE NAME: TOL-0201-2020.dwg

**A-400b**

Plot By: msk

File Name: TOL0201\_A-400.dwg

