

B 1 2 3 4 5 6
5206
 SEQUENCE NO. (OEP USE ONLY)
 (THIS NUMBER IS TO BE PUNCHED IN COLS. 3-6 ON ALL CARDS)


STATE OF MARYLAND PERMIT TO DRILL WELL
 please print or type

OEP PERMIT NUMBER
40-81-2633
 fill in this form completely

Date Received **4/7/88**
071487
 OWNER INFORMATION
SPRING HILL ASSOC
 15 Last Name 13 Owner First Name 34
1432 RT 32
 36 Street or RFD 55
W FRIENDSHIP MD 21794
 57 Town 70 State 72 Zip 76

B 3
 LOCATION OF WELL **R-3965**
HOWARD
 8 COUNTY 21
MEADOWOOD
 23 SUBDIVISION 42
 SECTION **1** 44 46 LOT **26** 48 50
SYBERRY WOOD
 52 NEAREST TOWN 71
 MILES FROM TOWN (enter 0 if in town) **4** 73 76 77 78 MI

DRILLER INFORMATION
George F. Easterday
 Driller's Name 77 License No. 80 **40**
L. Franklin Easterday, Inc.
 Firm Name
9265 Br. Ch. Rd., Mt. Airy, Md. 21781
 Address
George F. Easterday **7/2/87**
 Signature Date

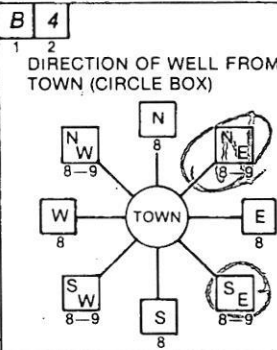

CRYSTAL RIDGE COURT
Idenington Rd
 11 NEAR WHAT ROAD 30
 ON WHICH SIDE OF ROAD (CIRCLE APPROPRIATE BOX)

 34 **8000** 37 DISTANCE FROM ROAD
 ENTER FT or MI **FT** 38 39

B 2
 WELL INFORMATION
 APPROX. PUMPING RATE (GAL. PER MIN.) **5** 8 12
 AVERAGE DAILY QUANTITY NEEDED (GAL. PER DAY) **500** 14 20

- USE FOR WATER (CIRCLE APPROPRIATE BOX)
 HOME (SINGLE OR DOUBLE HOUSEHOLD UNIT ONLY)
 FARMING (LIVESTOCK WATERING & AGRICULTURAL IRRIGATION)
 INDUSTRIAL, COMMERCIAL, STATE AND FEDERAL GOV. OTHER (REQUIRES APPROPRIATION PERMIT)
 PUBLIC OR PRIVATE WATER COMPANY (REQUIRES APPROPRIATION PERMIT AND STATE HEALTH DEPARTMENT APPROVAL)
 TEST, OBSERVATION, MONITORING (MAY REQUIRE APPROPRIATION PERMIT)

NOT TO BE FILLED IN BY DRILLER HEALTH DEPARTMENT APPROVAL
HOWARD
 COUNTY NAME
A 38157
 COUNTY NO.
 OEP SIGNATURE _____ STATE HEALTH INSERT S _____
 DATE ISSUED _____ EXP. DATE _____
132988
 43 CO SIGNATURE 48
 NORTH GRID **547000** 50 55 EAST GRID **087000** 57 63

APPROXIMATE DEPTH OF WELL **200** 24 28 FEET

APPROXIMATE DIAMETER OF WELL **6** NEAREST INCH

METHOD OF DRILLING (circle one)
 BORED (or Augered) JETTED Jetted & DRIVEN
 AIR-ROTARY 30 AIR-PERCussion 37 ROTARY (Hydraulic Rotary)
 CABLE REVERSE-ROTARY DRIVE-POINT
 other _____


REPLACEMENT OR DEEPEMED WELLS (CIRCLE APPROPRIATE BOX)
 THIS WELL WILL NOT REPLACE AN EXISTING WELL
 THIS WELL WILL REPLACE A WELL THAT WILL BE ABANDONED AND SEALED
 THIS WELL WILL REPLACE A WELL THAT WILL BE USED AS A STANDBY
 THIS WELL WILL DEEPEM AN EXISTING WELL
 PERMIT NUMBER OF WELL TO BE REPLACED OR DEEPEMED (IF AVAILABLE) _____

Not to be filled in by driller (OEP USE ONLY)
 APPROP. PERMIT NUMBER _____ GAP _____
 FORCE **SA** WRITE INITIALS IN BOX 67 68 PERMIT NO. **40-81-2633** 70 71 72 73 74 75 76 77 78 79

SPECIAL CONDITIONS

SHOW MAJOR FEATURES OF BOX & LOCATE WELL WITH AN X
 SOURCES OF DRILLING WATER
 1. WELL
 2.
 3.
 WRITE THE BOX NUMBER FROM THE MAP HERE
 E **820 0**
 N **640 7**
 DRAW A SKETCH BELOW SHOWING LOCATION OF WELL IN RELATION TO NEARBY TOWNS AND ROADS AND GIVE DISTANCE FROM WELL TO NEAREST ROAD JUNCTION

CRYSTAL RIDGE COURT

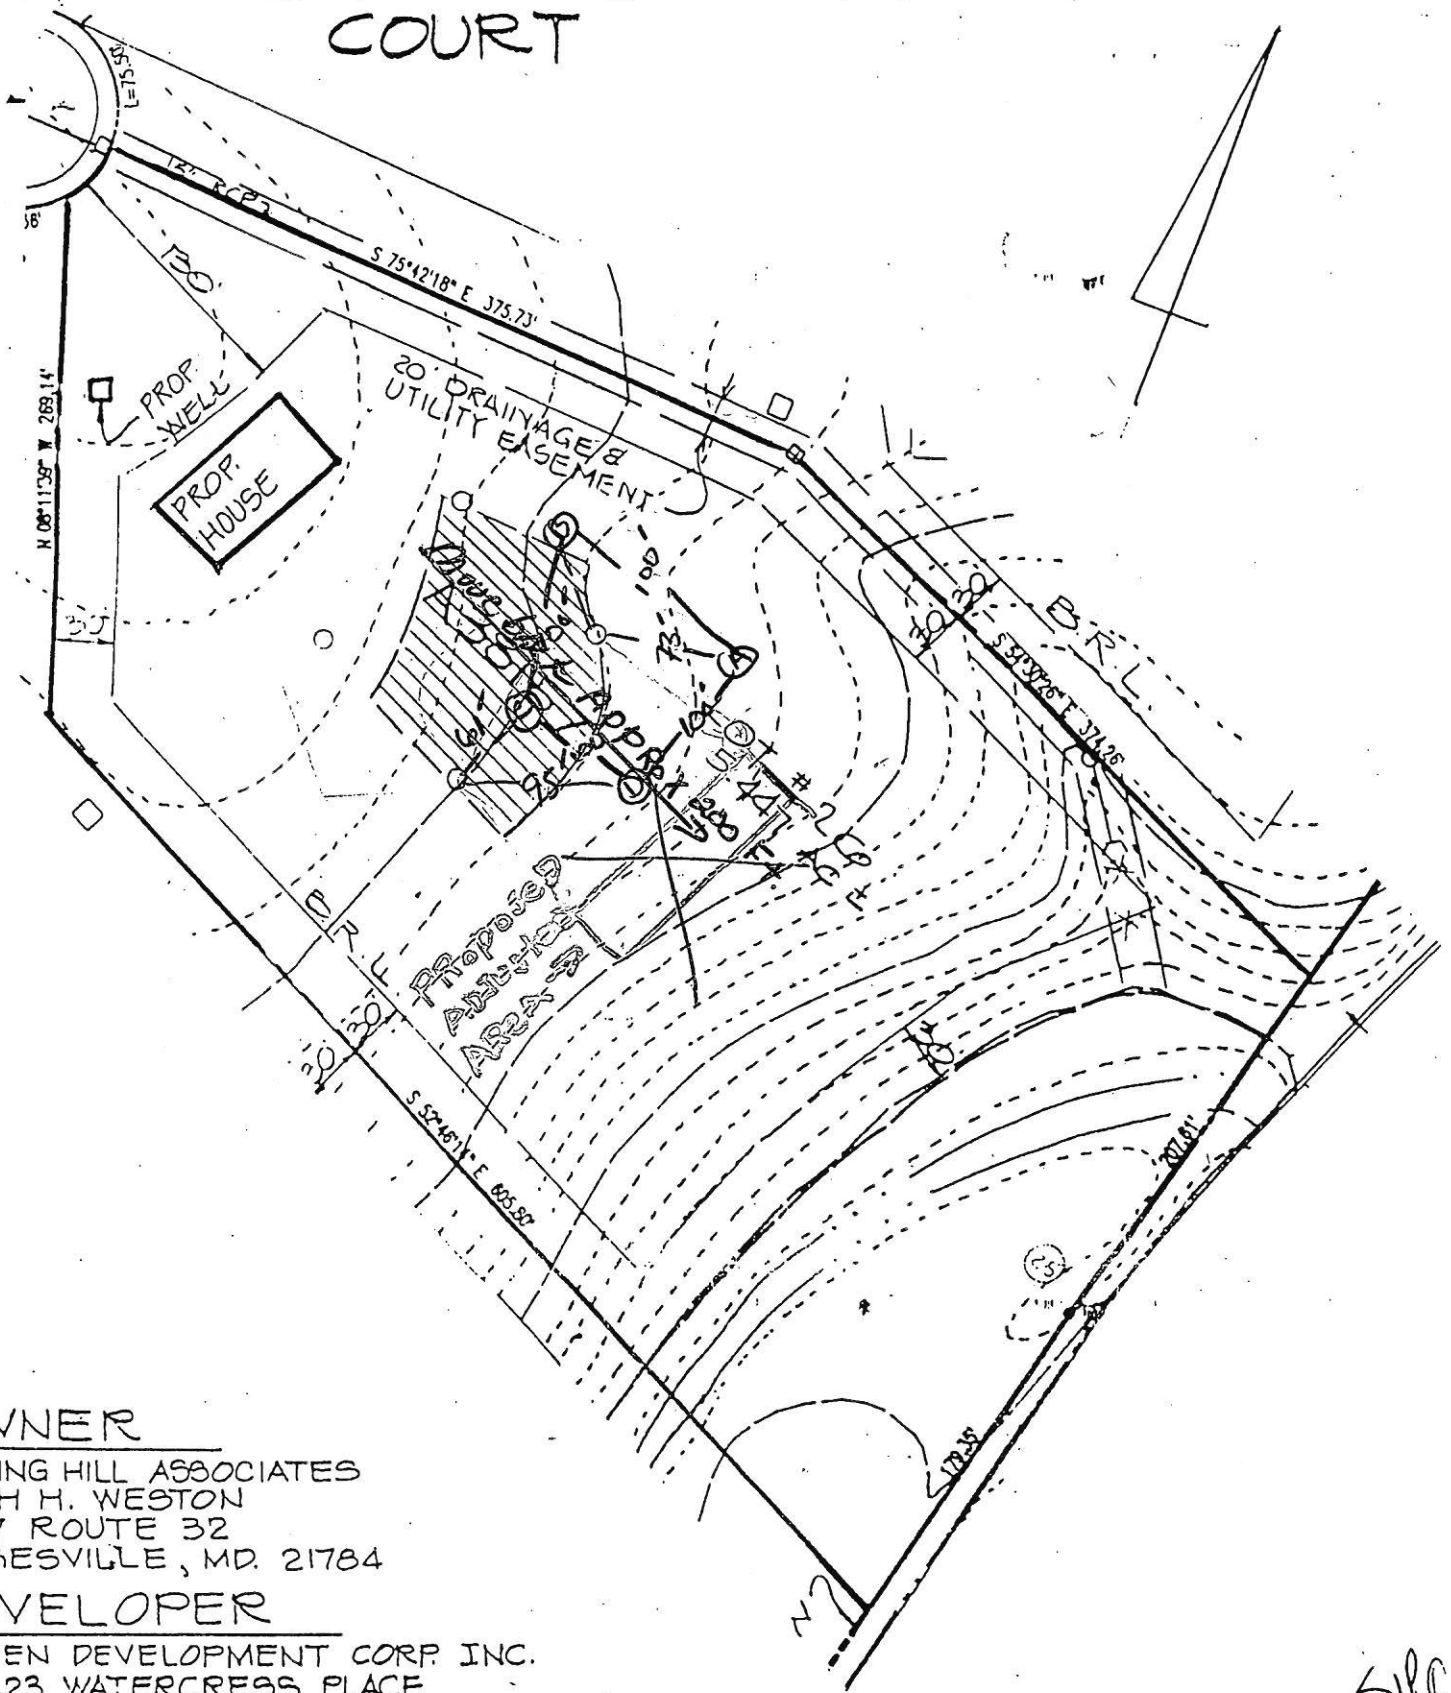

OWNER

SPRING HILL ASSOCIATES
 RUTH H. WESTON
 1427 ROUTE 32
 SYKESVILLE, MD. 21784

DEVELOPER

KÖREN DEVELOPMENT CORP. INC.
 5423 WATERCRESS PLACE
 COLUMBIA, MARYLAND 21045

P.S. Thaler & Assoc. Inc.
 CIVIL ENGINEERS • SURVEYORS
 LANDSCAPE ARCHITECTS
 11 WARREN ROAD
 BALTIMORE, MARYLAND 21208

This plat to be part of the contract *5/80*

LOT # 26 MEADOWOOD

SECTION ONE

TAP MAP 10 PARCEL 139
 3RD ELECTION DISTRICT HOWARD COUNTY, MARYLA

