



HOWARD COUNTY HEALTH DEPARTMENT

33959

DATE
08 / 09 / 10

PS

Received From

Jenkins Brothers Septic Service

PHONE # 410-751-7133

For

Septic repair - permit
710 Sweet Valley Drive

CASH

CHECK

NO.

3399

One hundred sixty five

Dollars

\$

165 | 00

Received By

[Signature]



DEPARTMENT OF HEALTH AND HUMAN SERVICES

30000

Form with multiple horizontal lines for text entry. Includes a box on the right with checkboxes labeled "DATE" and "CHECK".

PUB. SEWER STATUS VERIFIED BY _____

ISSUE DATE: 8-9-10

P 533959

APPROVAL DATE: 8/11/10

A REPAIR

PERMIT

Minor Septic Repair ON-SITE SEWAGE DISPOSAL SYSTEM HOWARD COUNTY HEALTH DEPARTMENT BUREAU OF ENVIRONMENTAL HEALTH

Jenkins Brothers Septic Service Inc. _____ IS PERMITTED TO INSTALL ALTER

ADDRESS: 7670 Smith Brothers Road Sykesville, MD 21784 PHONE NUMBER: 410-781-7133

SUBDIVISION: Sunset Valley Estates LOT NUMBER: 3

ADDRESS: 990 Sunset Valley Drive PROPERTY OWNER: Bill Gawl

SEPTIC TANK CAPACITY (GALLONS): 170 N/A

PUMP CHAMBER CAPACITY (GALLONS): _____

NUMBER OF BEDROOMS: 4

SQUARE FEET OF HOUSE: _____

LINEAR FEET OF TRENCH REQUIRED: _____

TRENCHES:	
LOCATION:	
PURPOSE:	Replace pump in pump chamber and add an alarm to the system. Line between the septic tank and pump chamber needs to be repaired.


PLANS APPROVED: Robert Bricker DATE: 8/9/10

- NOTE: PERMIT VOID AFTER 2 YEARS
- NOTE: CONTRACTOR RESPONSIBLE FOR SCHEDULING A PRE-CONSTRUCTION INSPECTION FOR ALL INSTALLATIONS
- NOTE: WATERTIGHT SEPTIC TANKS REQUIRED
- NOTE: ALL PARTS OF SEPTIC SYSTEM SHALL BE 100 FEET FROM ANY WATER WELL
- NOTE: MANHOLE RISERS REQUIRED ON ALL SEPTIC TANKS AND PUMP CHAMBERS

NEITHER THE HOWARD COUNTY COUNCIL OR THE HEALTH DEPARTMENT IS RESPONSIBLE FOR THE SUCCESSFUL OPERATION OF ANY SYSTEM PERMITTEE RESPONSIBLE FOR OBTAINING FINAL APPROVAL ON THIS PERMIT CALL 410-313-1771 FOR INSPECTION OF SEPTIC SYSTEM

Sunset Valley Dr.

NOT TO SCALE

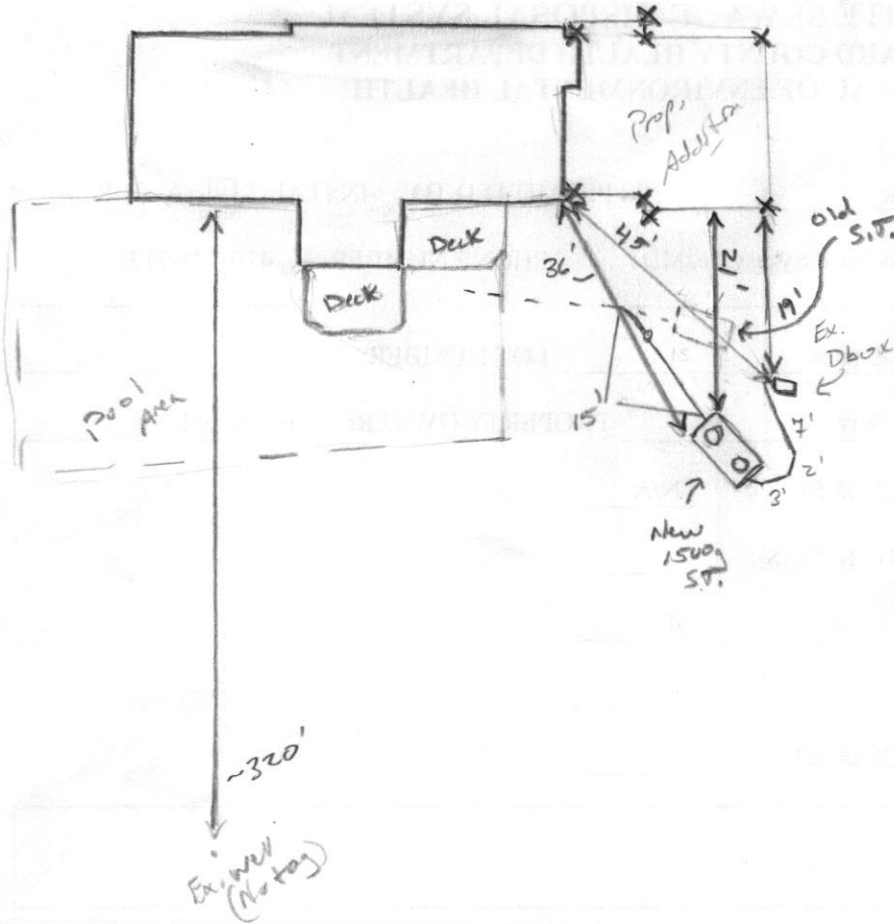

ROAD NAME

TRENCH/DRAINFIELD DATA

WIDTH	INLET	BOTTOM
_____	_____	_____
NUMBER OF TRENCHES	_____	_____
TOTAL LENGTH	_____	_____
ABSORPTION AREA	_____	_____
DISTRIBUTION BOX LEVEL	_____	_____
DISTRIBUTION BOX BAFFLE	_____	_____
DISTRIBUTION BOX PORT	_____	_____

SEPTIC TANK DATA

SEPTIC TANK 1 LEVEL	Yes
MANUFACTURER	Babylon
CAPACITY	1500 GAL
SEAM LOC	Top
TANK LID DEPTH	2'
BAFFLES	Yes
BAFFLE FILTER	_____
MANHOLE LOC	Front/Rear
6" PORT LOC	None
WATERTIGHT TEST	_____
SLOTTED	Yes
DATE ON LID	?

PUMP/SEPTIC TANK LEVEL

MANUFACTURER	_____
CAPACITY	_____ GAL
SEAM LOC	_____
TANK LID DEPTH	_____
BAFFLES	_____
BAFFLE FILTER	_____
MANHOLE LOC	_____
6" PORT LOC	_____
WATERTIGHT TEST	_____
SLOTTED	_____
DATE ON LID	_____

PRE-CONSTRUCTION:

INSTALLATION: 8/11/10 New plumbing re-routed further away from proposed addition. New S.T. set and re-plumbed back into ex. D box. Old S.T. pumped and collapsed. OK to backfill all work. S.T. set ~ 21' from proposed addition. Homeowner had addition corner started w/ flags (K)

FINAL INSPECTOR H. Wolf DATE OF APPROVAL 8/11/10

SEPTIC SYSTEM REPAIR / UPGRADE / EVALUATION REQUEST

Please fill out this form completely and check off the reason for the request:

Date requested: 8/9/10

Reason for Request

Failing System (includes surface discharge or inadequate treatment zone) No

Has the contractor verified through excavation/pumping evaluation, that there are no pipe blockages?

In support of a building permit. Type of building addition: _____

*System relocation for proposed addition for setback compliance _____

*Verification of adequate system capacity per COMAR 26.04.02.02D (4) _____

To replace collapsed septic tank or upgrade tank capacity X

To replace collapsed drywell No

Septic Contractor: Charles Jenkins T/A Jenkins Bros Septic Svc Inc.

Contractor's Address: 7670 Smiths Private Rd
Sykesville, Md. 21784

Contractor's Phone #: 410 781 7133

Property Address: 990 Sunset Valley Dr

Property (Subdivision) & Lot # Sykesville, Md 21784

Owner's Name: Bill GAWL

Is public sewer available/nearby: No

Names of Any Previous Owners: _____

Year House Built: _____

of Existing Bedrooms: _____

of Bedrooms after completion of addition: _____

Has this request been discussed previously with a Sanitarian, who? _____

If public sewer is close, further research will be performed to verify availability and possible hook up to public sewer.

A Sanitarian will be in contact within three business days depending upon the urgency of the situation to coordinate the scheduling of the repair /upgrade/evaluation. No inspection will be performed without fee collection at the office.

Environmental Sanitarian tentatively assigned Charles Jenkins