




Sharp HOCO

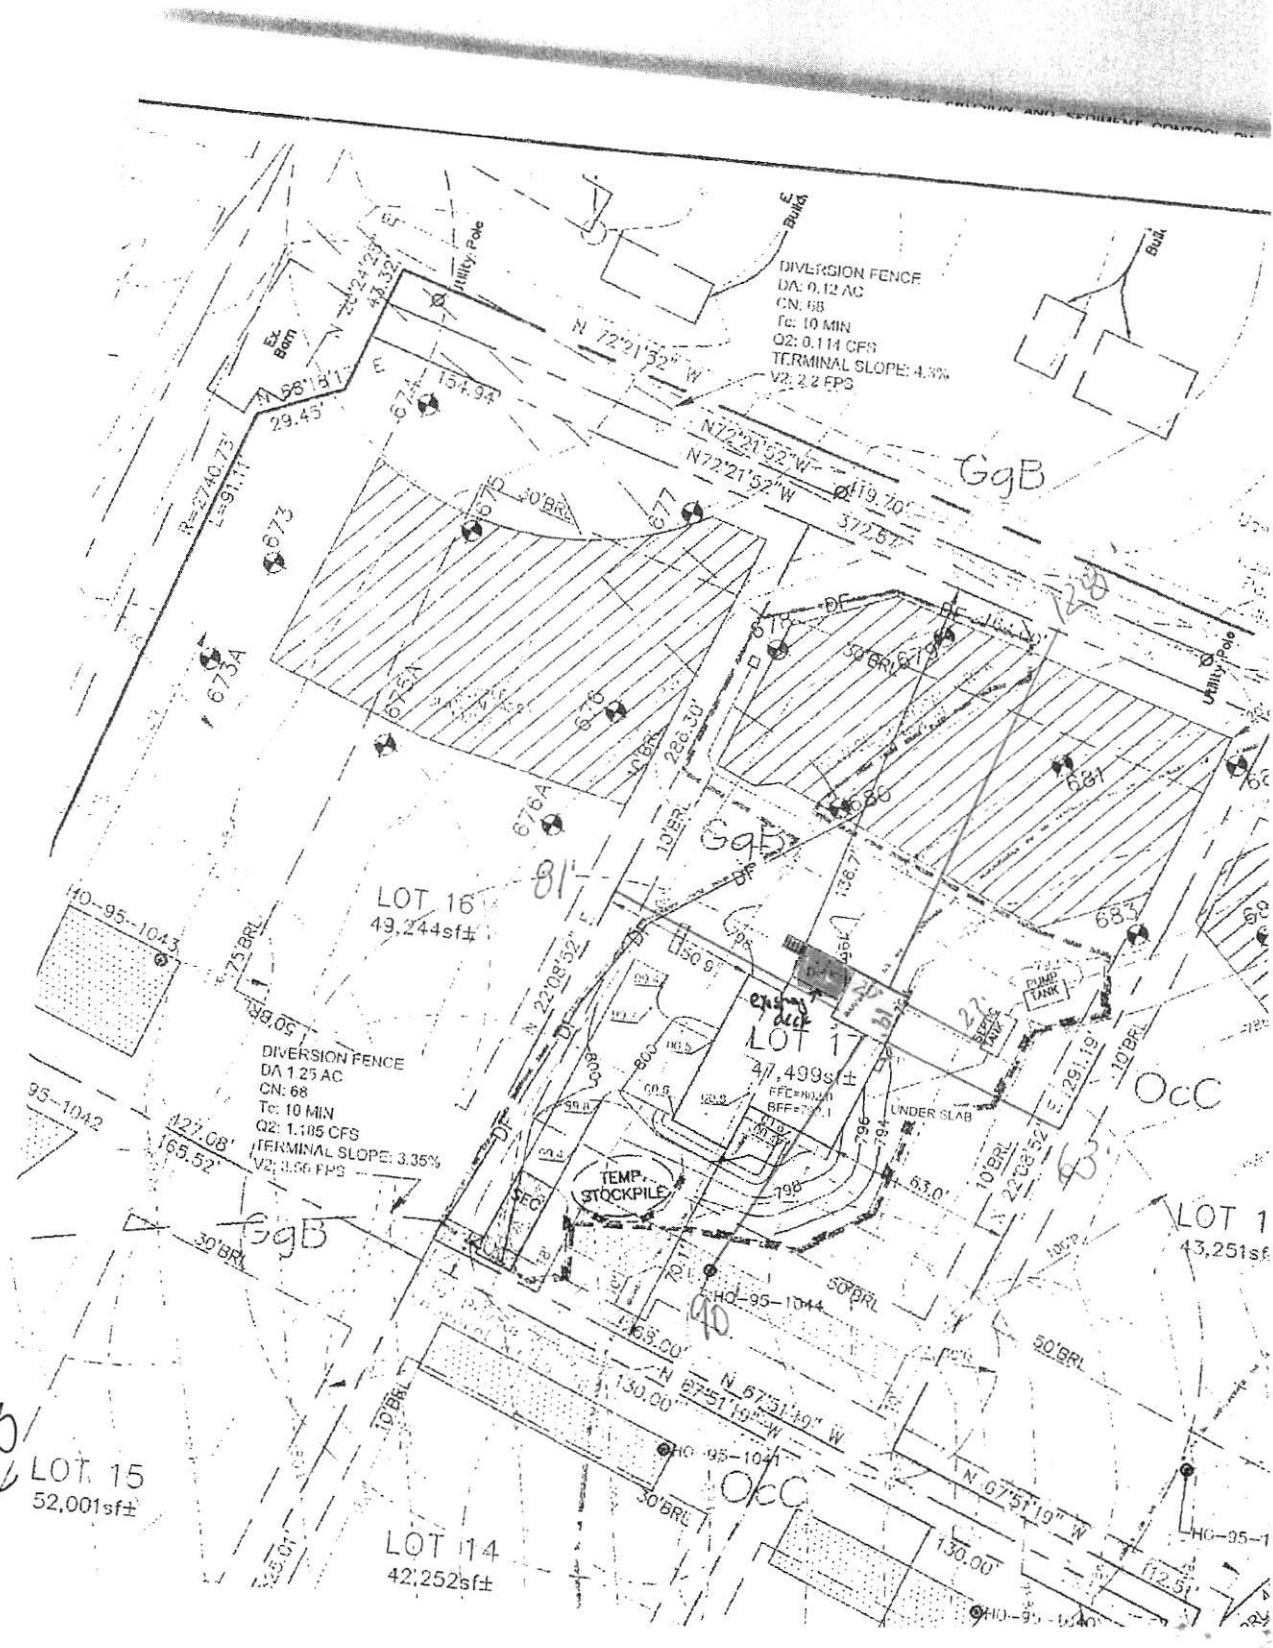

1" = 60'

● = existing deck

LOT 15  
52,001sf±

LOT 14  
42,252sf±

LOT 16  
49,244sf±

LOT 17  
47,499sf±

LOT 1  
43,251sf±

DIVERSION FENCE  
DA: 0.12 AC  
CN: 68  
Tc: 10 MIN  
Q2: 0.114 CFS  
TERMINAL SLOPE: 4.3%  
V2: 2.2 FPS

DIVERSION FENCE  
DA: 1.25 AC  
CN: 68  
Tc: 10 MIN  
Q2: 1.185 CFS  
TERMINAL SLOPE: 3.35%  
V2: 3.56 FPS