



1. THE LOT SHOWN HERE (NUMBER 23868. REFER EASEMENTS AND CONDI
2. THE EXISTING WELL SH (BY DAFT, McCUNE WAL
3. THERE ARE NO EXISTIN BOUNDARY EXCEPT AS
4. TOPOGRAPHY SHOWN W (FEBRUARY 2003 AND S
5. SEDIMENT AND EROSION CONSERVATION DISTRICT
6. ALL DRAINAGE AND STC COMPLY WITH THE APPI
7. ANY CHANGES TO A PE REVISED PERCOLATION (
8. ANY CHANGES TO THE APPROVED BY THE ENG
9. ANY ELECTRICAL WORK ELECTRICIAN.
10. THE SEPTIC TANK WILL
11. THE MAXIMUM EARTH C REQUIRE A HEAVY LOAD
12. ALL WELLS AND SEPTIC BOUNDARIES AND 200' BEEN SHOWN.

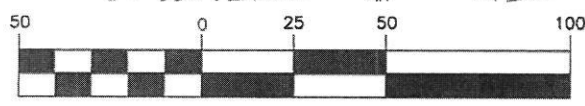

PLAN VIEW
1" = 50'

(IN FEET)
1 inch = 50 ft.

Approved Septic System Plan
Howard County Health Department
2000-gallon Septic Tank
To Gravity Distribution
for 6-Bedroom SFD
R. B. [Signature]
Signature 9/27/2021
Date

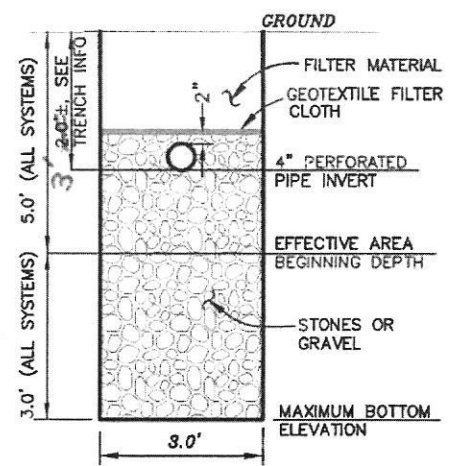

TYPICAL TRENCH DETAIL
NOT TO SCALE

OWNER/BUILDER:
KEYSTONE CUSTOM HOMES
227 GRANITE RUN DR
SUITE 100
LANCASTER, PA 1760
717-464-9060