

# RHINE

LANDSCAPING • CONSTRUCTION • POOLS

June 15, 2022

Howard County DILP  
3430 Court House Drive  
Ellicott City, MD 21043

RE: Amendment to Building Permit #B21003622

We would like to request an amendment to our building permit #B21003622 for the property located at 1715 Archers Glen in Sykesville, MD. The purpose of the amendment is to remodel the existing deck with new decking, railings, and a new set of stairs to grade.

I have enclosed four copies of the revised plat drawing showing the location of the proposed spa. Please let me know if you need any additional drawings or information. We have also enclosed a check for the \$25 fee.

Respectfully,



Dan Murphy  
Senior Landscape Architect  
410-442-2445 ext. 128  
dan@rhinelandscaping.com

RECEIVED

JUN 27 2022

LICENSES & PERMITS  
DIVISION

Approved Septic System Plan  
Howard County Health Department  
DBennard      7-1-22  
Signature                      Date


# ARCHERS GLEN

**REVISED**

Date: 6.27.22

Comments: Add new decking, railings, and steps to grade on existing deck

ARCHERS GLEN

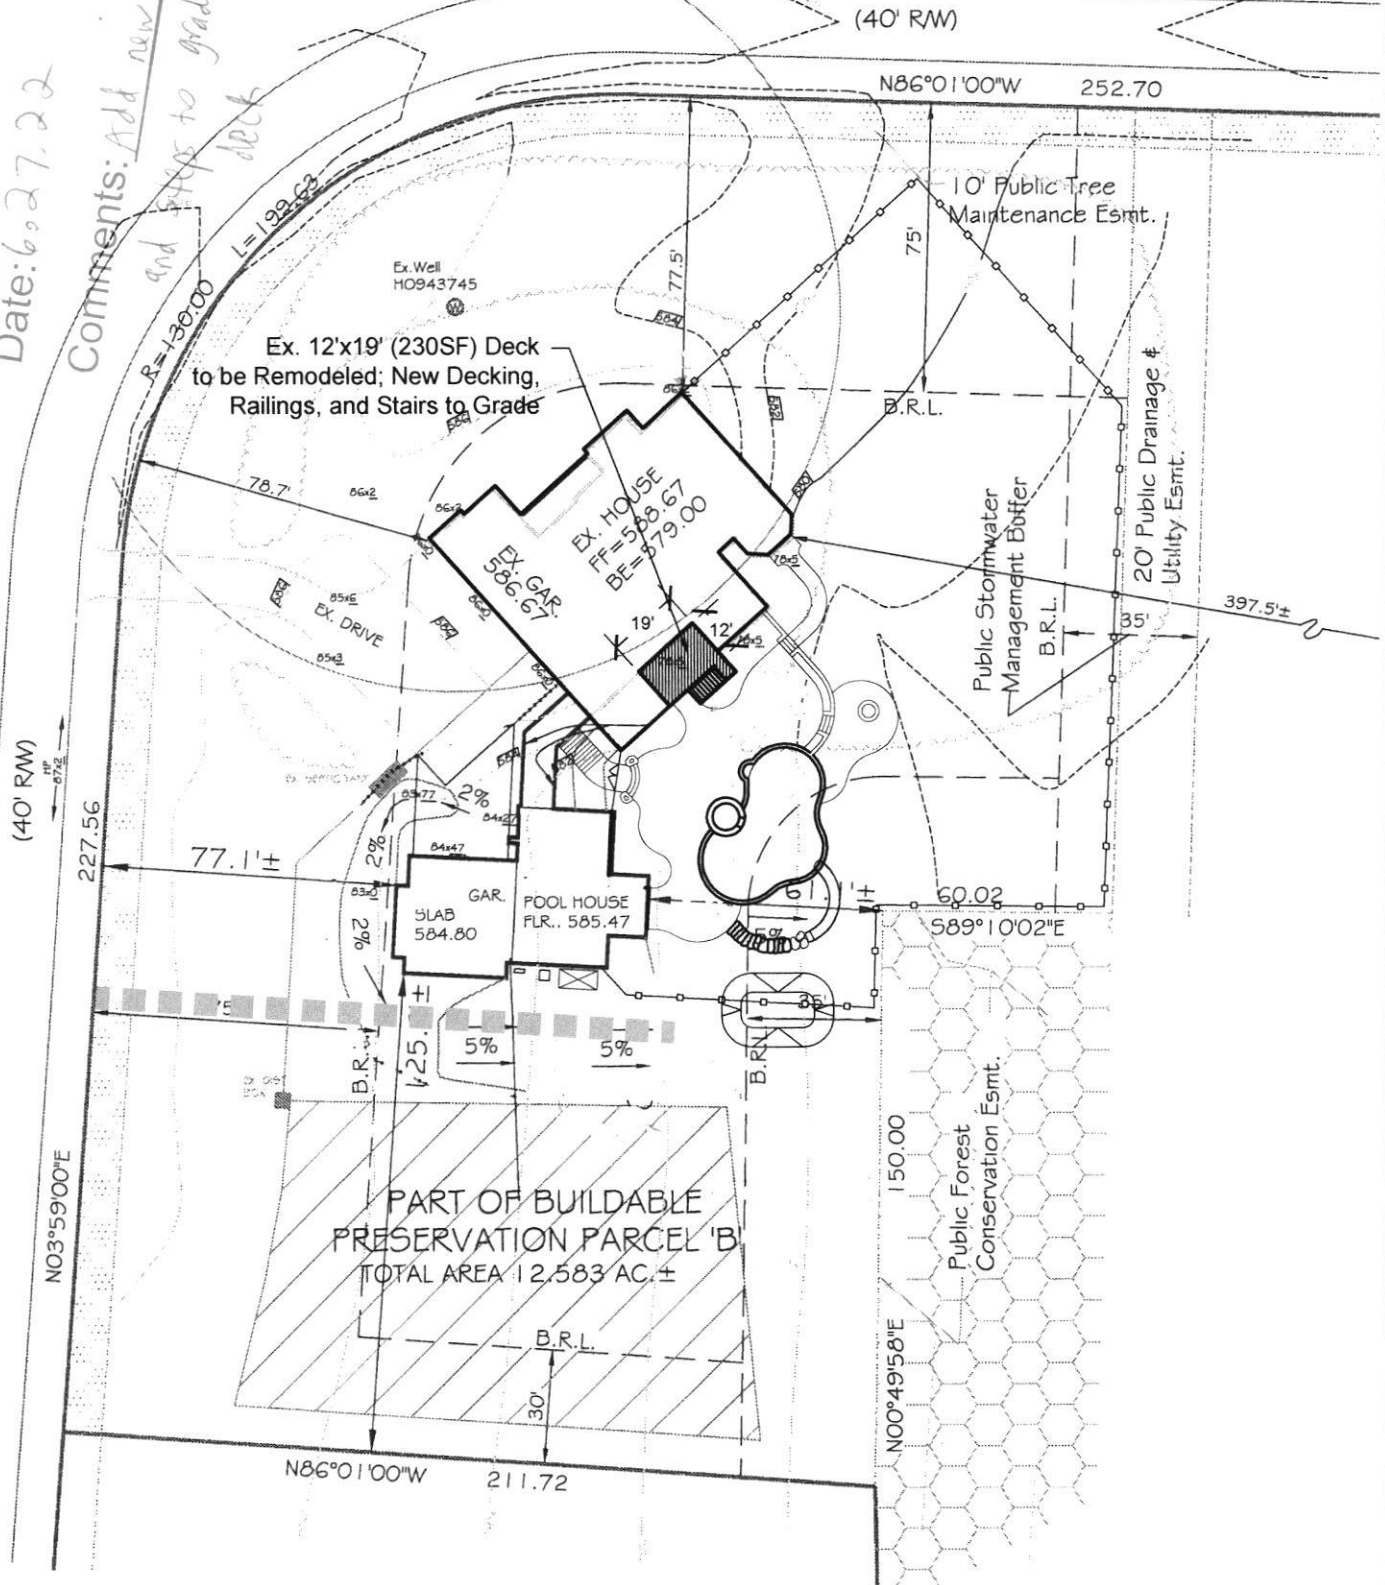

**AMENDMENT TO  
B210003622  
SITE PLAN  
SCALE: 1" = 50'-0"  
JUNE 15, 2022**

**PROPERTY INFORMATION:  
ADDRESS: 1715 ARCHERS GLEN  
SYKESVILLE, MD 21784  
PLAT: 16455  
TAX MAP: 9 GRID: 22 PARCEL: 301  
DESCRIPTION: BUILDABLE PRES. PARCEL 'B'**

**RHINE**  
LANDSCAPING • CONSTRUCTION • POOLS  
MHIC # 121739  
PO Box 1825, Sykesville, MD 410-442-2445  
www.rhinelandscaping.com • www.rhinepools.com