


Property known as: LOT 31  
 OAKWOOD OVERLOOK  
 LOTS 22 THRU 31  
 RESUB, LOTS 1 & 2 KENNARD WARFIELD JR. PROP.  
 SHEET 1 OF 2 PLAT 1087  
 5th ELECTION DISTRICT  
 HOWARD CO. MD


THIS PLAT CAN NOT BE USED TO ESTABLISH PROPERTY LINES OR CORNERS.

4/29/1988  
 BLOCK WALLS  
 F.F. 599.3'

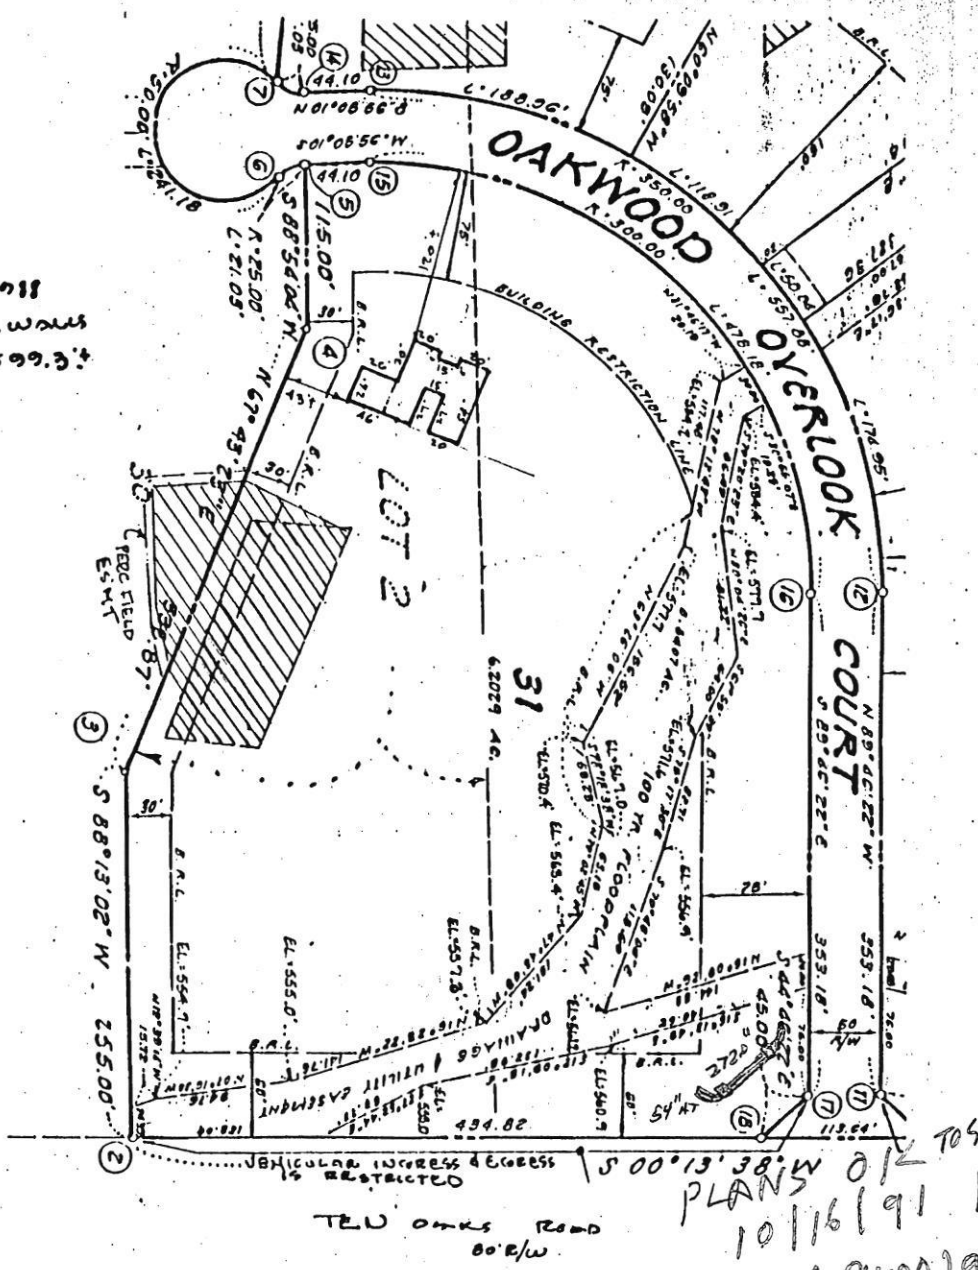

DESIGN  
 PLANS  
 10/16/91 RTI  
 8840029

LOCATION SURVEY PLAT

CERTIFICATION	SEAL	SCALE 1" = 100' DATE 4-29-1988
<p>This is to certify that I have surveyed the property known as: <u>4405 OAKWOOD OVERLOOK COURT</u></p> <p>for the purpose of locating the improvements thereon, and the improvements are located as shown.</p>	 <p>Walter Park</p>	<p>Columbia: 730-8060          Towson: 828-8060</p> <p>M &amp; H DEVELOPMENT ENGINEERS, INC          Surveyors and Subdivision Designers</p> <p>231 Harpers Choice Village Cent.          5485 Harpers Farm Road          Columbia, Md. 2104</p> <p>WALTER PARK          REG. L.S. 5539</p>