

**Bureau of Environmental Health**  
 8930 Stanford Boulevard, Columbia, MD 21045  
 Main: 410-313-2640 | Fax: 410-313-2648  
 TDD 410-313-2323 | Toll Free 1-866-313-6300  
[www.hchealth.org](http://www.hchealth.org)  
 Facebook: [www.facebook.com/hocohealth](http://www.facebook.com/hocohealth)

Maura J. Rossman, M.D., Health Officer

RECEIPT DATE: 3/17/23      **ONSITE SEWAGE DISPOSAL SYSTEM**      P 574043  
 INSTALLATION APPROVAL DATE: 3/27/23      **PERMIT**      A \_\_\_\_\_  
**SEWER HOUSE CONNECTION**

PROPERTY ADDRESS: 5192 Sheppard Lane  
 SUBDIVISION: \_\_\_\_\_ LOT: \_\_\_\_\_ TAX ID: \_\_\_\_\_  
 CONTRACTOR: South Carroll Backhoe      EMAIL: Scbackhoe@comcast.net  
 CONTRACTOR ADDRESS: 4410 Salem Bottom Road, Westminster, MD 21157      PHONE: 410-596-3618  
 PROPERTY OWNER: \_\_\_\_\_ EMAIL: \_\_\_\_\_  
 OWNER ADDRESS: 13762 Barberry Way, Sykesville, MD 21784      PHONE: \_\_\_\_\_

NUMBER OF BEDROOMS: VNK      CONNECTED TO PUBLIC WATER:       YES       NO


LOCATION:	INSTALL 4" SEWER LINE PER APPROVED SITE PLAN.
NOTES:	Flour drain needs to be disconnected. Replacing cast iron sewer line w/ PVC.

ISSUED BY: K. Wolf      ISSUE DATE: 3/24/23      EXPIRATION DATE: 3/24/24

- NOTE: HOWARD COUNTY BUREAU OF UTILITIES APPROVAL OF GRINDER PUMP INSTALLATION IS REQUIRED PRIOR TO SEPTIC PERMIT APPROVAL
- NOTE: CONTRACTOR MUST SCHEDULE AN INSPECTION AND GAIN APPROVAL OF ALL COMPONENTS PRIOR TO COVERING
- NOTE: AN ELECTRICAL PERMIT IS REQUIRED FOR INSTALLATION OF ANY ELECTRICAL COMPONENTS OF THE SYSTEM

**NEITHER THE HOWARD COUNTY COUNCIL NOR THE HEALTH DEPARTMENT IS RESPONSIBLE FOR THE SUCCESSFUL OPERATION OF ANY SYSTEM.  
 PERMITTEE RESPONSIBLE FOR OBTAINING FINAL APPROVAL ON THIS PERMIT.  
 CALL 410-313-1771 FOR INSPECTION OF SEPTIC SYSTEM.**

NOT TO SCALE

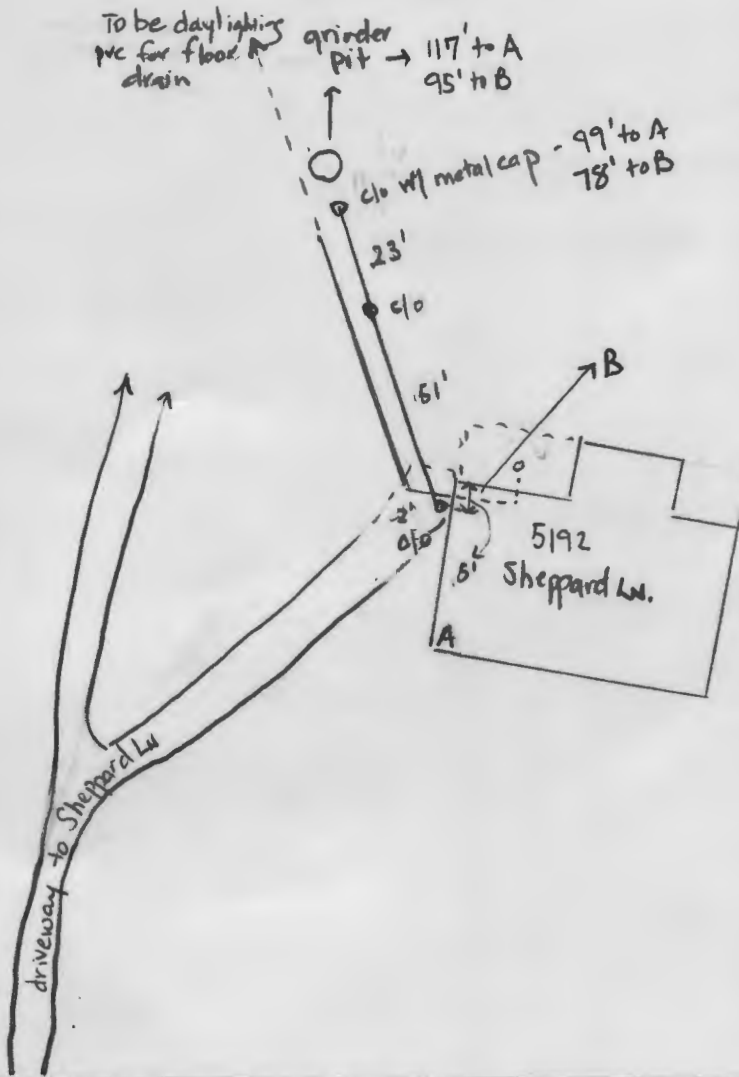

ROAD NAME

**TRENCH/DRAINFIELD DATA**

WIDTH	INLET	BOTTOM
_____	_____	_____
NUMBER OF TRENCHES _____		
TOTAL LENGTH _____		
ABSORPTION AREA _____		
DISTRIBUTION BOX LEVEL _____		
DISTRIBUTION BOX BAFFLE _____		
DISTRIBUTION BOX PORT _____		

**SEPTIC TANK DATA**

SEPTIC TANK 1 LEVEL _____	
MANUFACTURER _____	
CAPACITY _____	GAL
SEAM LOC _____	
TANK LID DEPTH _____	
BAFFLES _____	
BAFFLE FILTER _____	
MANHOLE LOC _____	
6" PORT LOC _____	
WATERTIGHT TEST _____	
SLOTTED _____	
DATE ON LID _____	
PUMP/SEPTIC TANK LEVEL _____	
MANUFACTURER _____	
CAPACITY _____	GAL
SEAM LOC _____	
TANK LID DEPTH _____	
BAFFLES _____	
BAFFLE FILTER _____	
MANHOLE LOC _____	
6" PORT LOC _____	
WATERTIGHT TEST _____	
SLOTTED _____	
DATE ON LID _____	

PRE-CONSTRUCTION:

[Replace cast iron w/ pvc]

INSTALLATION: 3/27/23 - site inspection, S. Carroll on site, the sewer line replacement was completed, the asphalt driveway was removed to do the work, the floor drain has it's own discharge system, contractor will daylight pvc for floor drain out in the yard past the grinder pit, contractor bedding some of the line w/ 57 stone, ok to backfill. (e)

(grinder pit connected to Walnut Grove Shared septic system)

FINAL INSPECTOR R. Peppercorn DATE OF APPROVAL 3/27/23



## Williams, Jeffrey

---

**From:** Williams, Jeffrey  
**Sent:** Tuesday, February 28, 2023 3:13 PM  
**To:** kwolf@howardcountymd.gov  
**Subject:** 5192 Sheppard Ln

Hey Kevin. I spoke to a plumber on this property. This is the old farmhouse on a pres parcel at Walnut Grove. He will be replacing some old cast iron sewer line leading to a new pump tank that apparently goes to the shared system. The online file for the address doesn't address any connection to the shared system, but I did not see an SDA for this parcel on the plat in GIS, so I think it is connected. He is just replacing a section of sewer line to meet up with new pvc prior to the pump tank, so I told him he can get a minor septic repair permit easily enough as long as he explains that he is just replacing in kind. Just giving you a heads up if he comes in.

He had another weird circumstance where a floor drain on a sunken patio was connected to the sewer line, so we discussed him disconnecting that as part of this work and sending it off to daylight somewhere else. I told him to work with DED on any stormwater issues.

Jeff Williams  
Deputy Director  
Bureau of Environmental Health  
Howard County Health Dept.  
8930 Stanford Blvd. Columbia, MD 21045  
410-313-4261  
[www.hchealth.org](http://www.hchealth.org)

DISCLAIMER: This e-mail is intended only for the individual to whom it is addressed. It may be used only in accordance with applicable laws. If you are not the intended recipient, you are strictly prohibited from reading, disseminating, distributing, or copying this message. If you received this e-mail by mistake, please notify the sender and destroy this e-mail

Maura J. Rossman, M.D., Health Officer

**INFORMATION FORM - SEPTIC SYSTEM REPAIR/UPGRADE**

**Reason for Request:**

- Failing System
- System relocation for proposed addition
- System upgrade for proposed addition
- Inadequate treatment zone
- Collapsed septic tank
- Collapsed drywell

**Has the septic tank been pumped within the last month?**

Yes      Date pumped: \_\_\_\_\_  
 No

**Was a visual inspection of the septic tank and/or drain fields conducted?**

Yes      Explain observation: \_\_\_\_\_  
 No

**Existing system design**

- Drywell
- Trench
- Mound
- Unknown
- Other: \_\_\_\_\_

**Was a visual inspection of the sewage line conducted?**

Yes  
 No

**Blockage Leading to the field**

Yes      Explain \_\_\_\_\_  
 No

**Is discharge surfacing on the ground?**

Yes  
 No

**Additional Comments:**

*Repeating existing C. Iron House  
 Sewer Pipe*

\*For REPAIRS, are the owners proposing, or do they plan to add in the future any additions or modifications to the property, i.e. pools, living space additions, garages, etc? This information must be disclosed at the time of this application. The Health Department will not be able to accommodate requests in the field for property modifications unrelated to the repair request. Such requests may require an additional fee, testing, and submittal of a Percolation Certification Plan, if the property does not meet current Code and Regulations.

Septic Contractor: *South Carol Baeher*

Contractor's Phone: *410.596.3618*

Contractor's Address: \_\_\_\_\_

Property Address: *5192 Sheppard Lane*

County File: \_\_\_\_\_

Subdivision: \_\_\_\_\_

Lot: \_\_\_\_\_ Year Built: \_\_\_\_\_

Owner's Name: \_\_\_\_\_

Existing bedrooms: \_\_\_\_\_

Name of previous owners: \_\_\_\_\_

Existing bedrooms: \_\_\_\_\_

Proposed bedrooms: \_\_\_\_\_

\*A Sanitarian will be in contact within three business days, depending upon the urgency of the situation, to coordinate the scheduling/review of the repair or upgrade.

\*Prior to scheduling inspections, scaled plans should be submitted to clarify the nature of the addition.\*

Print out a copy of Real Property Data via Dept. of Taxation website \_\_\_\_\_ Indexed file found \_\_\_\_\_

If soil/site conditions are limited and sewer and/or Metro District status is not conducive to connection, the Sanitarian may recommend pursuit of Emergency Sewer Extension or Emergency Metro District Inclusion. The Owner should contact the Bureau of Utilities for details.

No permit is to be issued nor inspection to be scheduled without prior fee collection at the office unless an emergency exists.

The contractor is to notify the office of the emergency as soon as possible.

**RECEIPT**

Howard County, MD  
HOWARD COUNTY HEALTH DEPARTMENT  
ASCEND ONE BUILDING  
Columbia, MD 21045  
8930 STANFORD BLVD

**Application:** WS-SP-APP-23-00065  
**Application Type:** EnvHealth/Well and Septic/Sewage Disposal System/Application  
**Address:** 5192 Sheppard LN,

---

<b>Receipt No.</b>	6109					
<b>Payment Method</b>	<b>Ref Number</b>	<b>Amount Paid</b>	<b>Payment Date</b>	<b>Cashier ID</b>	<b>Received</b>	<b>Comments</b>
Check	58920	\$165.00	03/17/2023	JUKING		Receipt 74043
<b>Work Description:</b>	Sewer House Connection/ 5192 Sheppard Lane					

Maura J. Rossman, M.D., Health Officer

**INFORMATION FORM - SEPTIC SYSTEM REPAIR/UPGRADE**

**Reason for Request:**

- Failing System
- System relocation for proposed addition
- System upgrade for proposed addition
- Inadequate treatment zone
- Collapsed septic tank
- Collapsed drywell

**Has the septic tank been pumped within the last month?**

Yes      Date pumped: \_\_\_\_\_  
 No

**Was a visual inspection of the septic tank and/or drain fields conducted?**

Yes      Explain observation: \_\_\_\_\_  
 No

**Existing system design**

- Drywell
- Trench
- Mound
- Unknown
- Other: \_\_\_\_\_

**Was a visual inspection of the sewage line conducted?**

Yes  
 No

**Blockage Leading to the field**

Yes      Explain \_\_\_\_\_  
 No

**Is discharge surfacing on the ground?**

Yes  
 No

**Additional Comments:**

*Replacing existing C. Iron House  
 Sewer w/ PVC*

\*For REPAIRS, are the owners proposing, or do they plan to add in the future any additions or modifications to the property, i.e. pools, living space additions, garages, etc? This information must be disclosed at the time of this application. The Health Department will not be able to accommodate requests in the field for property modifications unrelated to the repair request. Such requests may require an additional fee, testing, and submittal of a Percolation Certification Plan, if the property does not meet current Code and Regulations.

Septic Contractor: *South Carol Benthoe*

Contractor's Phone: *410-596-3618*

Contractor's Address: \_\_\_\_\_

Property Address: *5192 Sheppard Lane*      County File: \_\_\_\_\_

Subdivision: \_\_\_\_\_      Lot: \_\_\_\_\_ Year Built: \_\_\_\_\_

Owner's Name: \_\_\_\_\_      Existing bedrooms: \_\_\_\_\_

Name of previous owners: \_\_\_\_\_      Existing bedrooms: \_\_\_\_\_

Proposed bedrooms: \_\_\_\_\_

\*A Sanitarian will be in contact within three business days, depending upon the urgency of the situation, to coordinate the scheduling/review of the repair or upgrade.

\*Prior to scheduling inspections, scaled plans should be submitted to clarify the nature of the addition.\*

Print out a copy of Real Property Data via Dept. of Taxation website \_\_\_\_\_ Indexed file found \_\_\_\_\_

If soil/site conditions are limited and sewer and/or Metro District status is not conducive to connection, the Sanitarian may recommend pursuit of Emergency Sewer Extension or Emergency Metro District Inclusion. The Owner should contact the Bureau of Utilities for details.

No permit is to be issued nor inspection to be scheduled without prior fee collection at the office unless an emergency exists.

The contractor is to notify the office of the emergency as soon as possible.

2/2020