

Menu Save Reset Cancel Help

Record Detail (This section is required.)

Permit Type	Permit Number	Opened Date
Building/Residential/Misc/Tanks	B21000070	01/12/2021
Description of Work		
SFD/ INSTALL (1) 120 GALLON ABOVE-GROUND PROPANE TANK		

check spelling

Approved → DILP - 1/13/21
 " EH - 1/16/21 -
 When record added to
 ACCELA - (RB)

Address (This section is required.)

Search Reset Clear Get Parcel & Owner

Street #	Street Name	Street Type	
18019	SHAFFERS MILL	RD	
Unit Type	Unit #	X Coordinate	Y Coordinate
-Select-		-77.14055	39.32124
City	State	Zip Code	Primary
MOUNT AIRY	MD	21771	Yes

Parcel (This section is required.)

Search Reset Clear Get Address & Owner

GIS ID	Parcel	Parcel Area	Land Value	Improved Value	Exemption Value	Plan Area
916736	171	3	220000	544300	324300	RURAL
Legal Description						
IMPS3 A[]18019 SHAFFERS MILL RD[]MT AIRY						

check spelling

Block	Lot	Census Tract	Council Dist	Inspection Dist	Supervisor Dist	Map #	DAP Zone
		604001	5				
Plan Area	State Tax Id	Subdivision Name					
	1404309898						
Section	Area	Tax Map					
		6					
Grid	Zoning District	ADC Map					
6-23	RC-DEO	4690-H9					
SDP No.	Final Plan No.	WP File No.					
Record Plat No.	WS Contract No.	FDP No.	Primary				
			Yes				
Owner Occupied	Year Built	Historic District					
<input type="radio"/> Yes <input type="radio"/> No	1993	<input type="radio"/> Yes <input checked="" type="radio"/> No					
Historic District Registry No.	Stat Area	Flood Plain					
	4-04	<input type="radio"/> Yes <input checked="" type="radio"/> No					
Building No							

Owner * (This section is required)

Search Reset Clear

Name *
 MURPHY DONALD W

Address Line 1
 18019 SHAFERS MILL RD

Address Line 2

Address Line 3

Mail City **Mail State** **Mail Zip Code**
 MOUNT AIRY MD 21771

Phone **Primary**
 443-277-6920 Yes

E-mail
 jhoover@carrollhomeservices.com

Cell Number **Fax Number**

Professionals (This section is not required.)

Search Reset Clear

License # * **Business Name**
 20020008045 CARROLL HOME SERVICES

License Type * **First Name** **Middle Name** **Last Name**
 Plumb/Gas DANIEL MARSHALL

Primary **Address Line 1**
 Yes 2700 LOCH RAVEN RD., SUITE 200

Address Line 2

City **State** **ZIP Code**
 BALTIMORE MD 21218-0000

Phone 1 **Phone 2** **Fax**
 4434637036

E-mail
 DMARSHALL@CARROLLHOMESERVICES.COM

Applicant (This section is not required.)

Search As Owner As Lic. Prof As Contact

Type * **First Name** **MI** **Last Name**
 Applicant John Mazura

Relationship **Full Name**
 Applicant John Mazura

Primary **Organization Name**
 Yes Carroll Home Services.com

Street Address
 1105 Camberley Ct

Address Line 2

City **State** **Zip Code**
 ABINGDON MD 21009

Phone **Cell** **Fax**
 410-937-5882

E-mail *
 jmazura@carrollhomeservices.com

Addtl Info

Est Construction Cost *	Housing Units *	Number of Buildings *	Public Owned
600	0	0	No
Construction Type			
649 - All Other Buildings and Structures			

TANK INFORMATION

RESIDENTIAL TANK INFORMATION


Capital Project-No Fee *	Capital Project Number	Fee Exempt *	Roadside Tree Project Permit *	Roadside Tree Permit #
<input type="radio"/> Yes <input checked="" type="radio"/> No		<input type="radio"/> Yes <input checked="" type="radio"/> No	<input type="radio"/> Yes <input checked="" type="radio"/> No	
Existing Use	Number of Tanks Installed *	Number of Tanks Removed *		
SFD	1	0		
Water Supply	Sewage Disposal	Expiration Date	Relocate Existing Tank *	
Private	Private	7/12/2021	0	

PAYMENT INFORMATION

Check 1	Payee 1	Check 2	Payee 2	SAP Doc No	SAP Entered

Submit Cancel

Approved for HP Tank
 B21000070 AA
 1/13/21

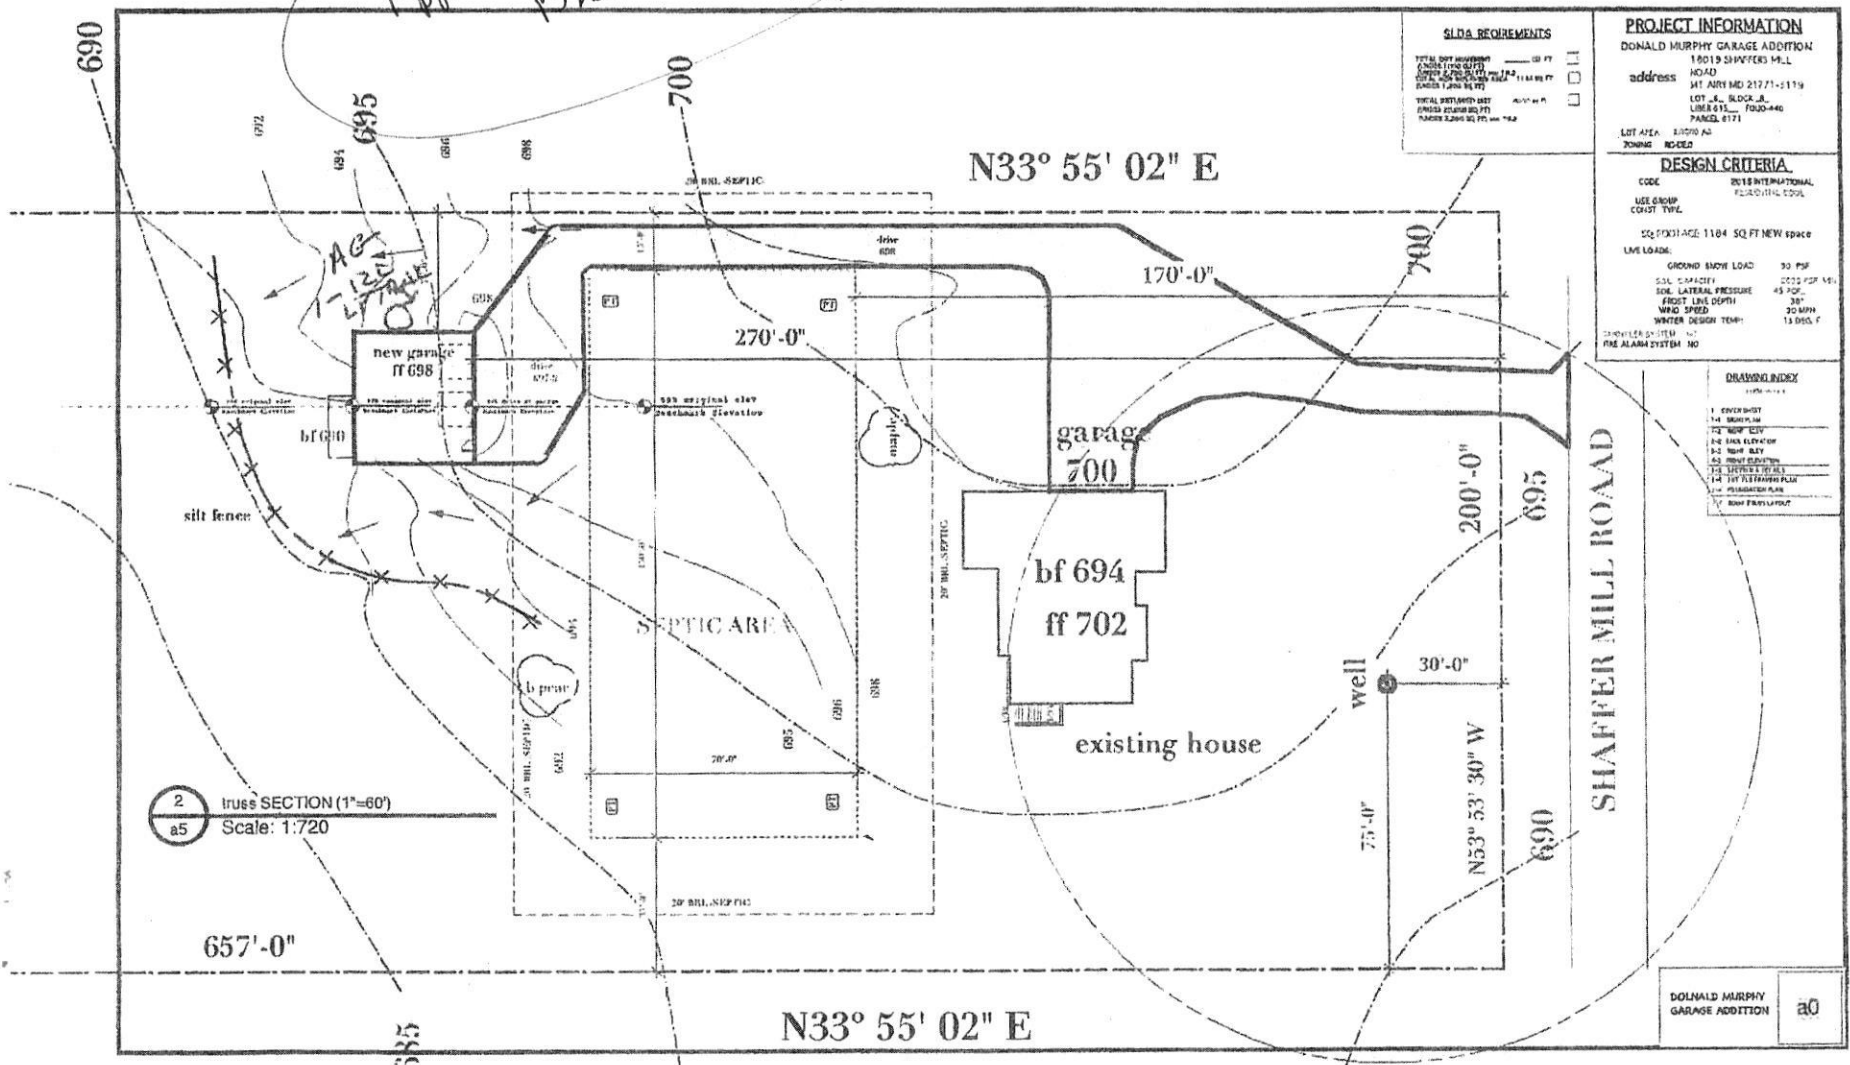

2 Truss SECTION (1"=60')
 a5 Scale: 1:720

SLDA REQUIREMENTS

TOTAL SQ. FOOTAGE	1184	1184	1184
NEW SQ. FOOTAGE	1184	1184	1184
EXISTING SQ. FOOTAGE	0	0	0
TOTAL SQ. FOOTAGE	1184	1184	1184

PROJECT INFORMATION

DONALD MURPHY GARAGE ADDITION
 18019 SHAFER MILL
 1040
 141 AVE MD 21271-5119
 address
 LOT 6, BLOCK A
 LIBERTY, FOLIO 440
 PARCEL 6171
 LOT AREA: 81000 SQ. FT.
 ZONING: R-2000

DESIGN CRITERIA

CODE: 2018 INTERNATIONAL
 FOUNDATIONAL CODE
 USE GROUP: RESIDENTIAL
 COST TYPE: 1
 SQ. FOOTAGE: 1184 SQ. FT. NEW SPACE
 LIVE LOAD: 30 PSF
 GROUND SNOW LOAD: 30 PSF
 SOIL CAPACITY: 2000 PSF/15'
 SOIL LATERAL PRESSURE: 45 SOE
 FROST LINE DEPTH: 30"
 WIND SPEED: 30 MPH
 WINTER DESIGN TEMP: 15 DEGS. F
 SCHEDULER SYSTEM: 107
 FIRE ALARM SYSTEM: 30

DRAWING INDEX

1	GENERAL NOTES
2	TRUSS SECTION
3	NEW ELEV.
4	EXIST. ELEVATION
5	SEPTIC AREA
6	WELL
7	FOUNDATION PLAN
8	FOUNDATION PLAN
9	FOUNDATION PLAN

DONALD MURPHY GARAGE ADDITION a0