



Buckner Enterprises

Wholesalers of Named Brands

919 - 11TH STREET, N. W.

WASHINGTON 1, D. C.

PHONE 347-3299



May 3 1962

Howard County Health Dept
Sanitation Division
at Mr Winc


This will confirm appointment at 1⁰⁰ PM May 8

1962

I will meet your inspector at the intersection
of Nichols Drive & Brighton Dam Rd at the above
stated time.

See sketch below.


Thank you
Oliver W. Smith

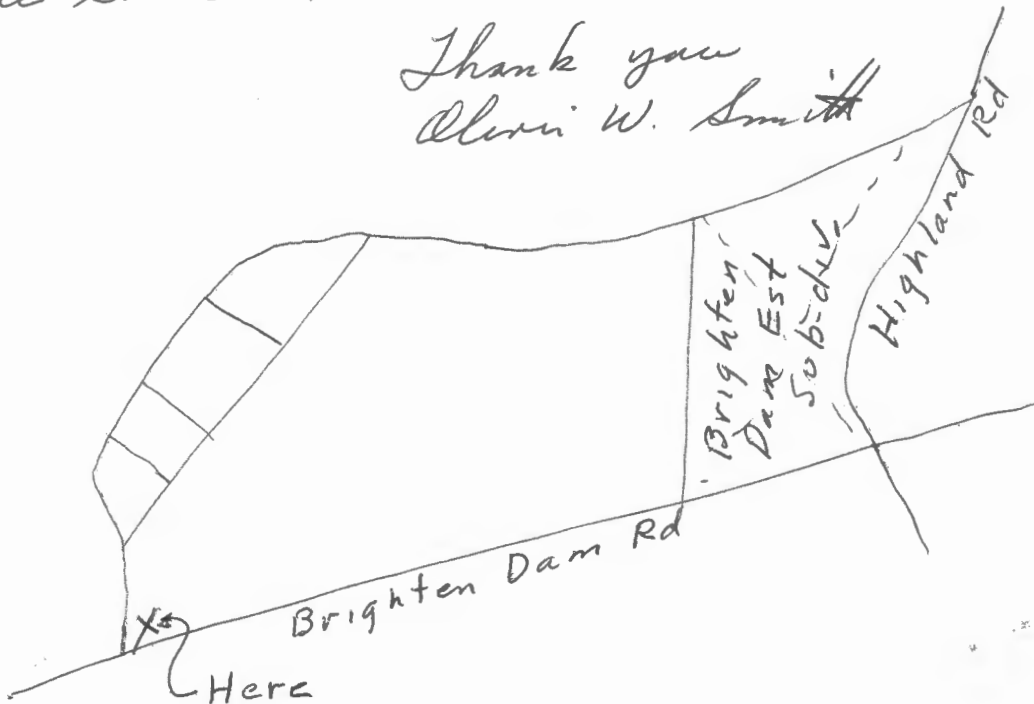

P.S. I did not enclose check for 15⁰⁰ fee as I
understand it has already been paid but will bring
over

with me to be sure.

Thank you again.

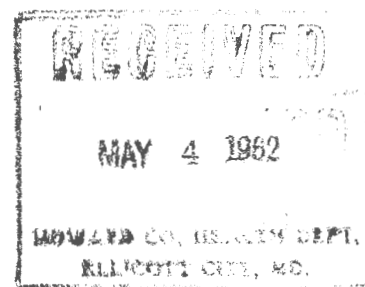

8/12/74

APPLICATION

A 04696

*Land must
be re-tested
2-12 ft. below
53 ft. apart*

SEWAGE DISPOSAL TESTING

P _____

MARYLAND STATE DEPARTMENT OF HEALTH

HOWARD COUNTY

ELLICOTT CITY

DISTRICT 5

DATE ~~1/4~~ 1/5/62

Septic Tank - 750 gal.

Tile Field - 400 sq ft. absorbent bottom area

Tile Field to be 35 to 85 ft from left side of surface from front of lot and about 100 to 150 ft from rear of lot.

Trench depth not to exceed 3 ft.

9/26/74

Void - no more perc on this lot. U.W.M.

TO: THE COUNTY HEALTH OFFICER
ELLICOTT CITY, MARYLAND

I, HEREBY, APPLY FOR THE NECESSARY TESTS IN ORDER TO CONSTRUCT (OR RECONSTRUCT) A SEWAGE DISPOSAL SYSTEM.

PROPERTY OWNER Jones, Wood ^{and} ~~row~~

*Harry & Pat Van Der Wouwen
4616 Olympia Avenue
Beltsville, Md.*

ADDRESS 32 West Diamond Street - Gaithersburg PHONE WA 6-1296

937-7692

PROPERTY LOCATION:

SUBDIVISION _____ LOT NO. _____

ROAD AND DESCRIPTION Nichols Ave. off Brightam Dam Rd. $\frac{1}{4}$ of a mile back from intersection of above mentioned roads, on the left, 3 houses before you come to this lot. *lot is on right side of Nichols Drive*

OCCUPANT _____ PHONE _____

PERSON TO CONSTRUCT SYSTEM _____

ADDRESS _____ PHONE _____

SIZE OF LOT 182' X 200' TYPE BLDG. 3 NUMBER OF BEDROOMS _____

IF NOT SINGLE RESIDENCE DESCRIBE _____

SIGNATURE OF APPLICANT A. V. Mano


APPROVED BY Donald W. Manogon FOR Tile Field DATE 5-15-62

REJECTED BY _____ FOR _____ DATE _____

HOLD PENDING FURTHER TESTS PH DATE 9 Jan 61

REASONS FOR REJECTION OR HOLDING _____

THIS IS NOT A PERMIT

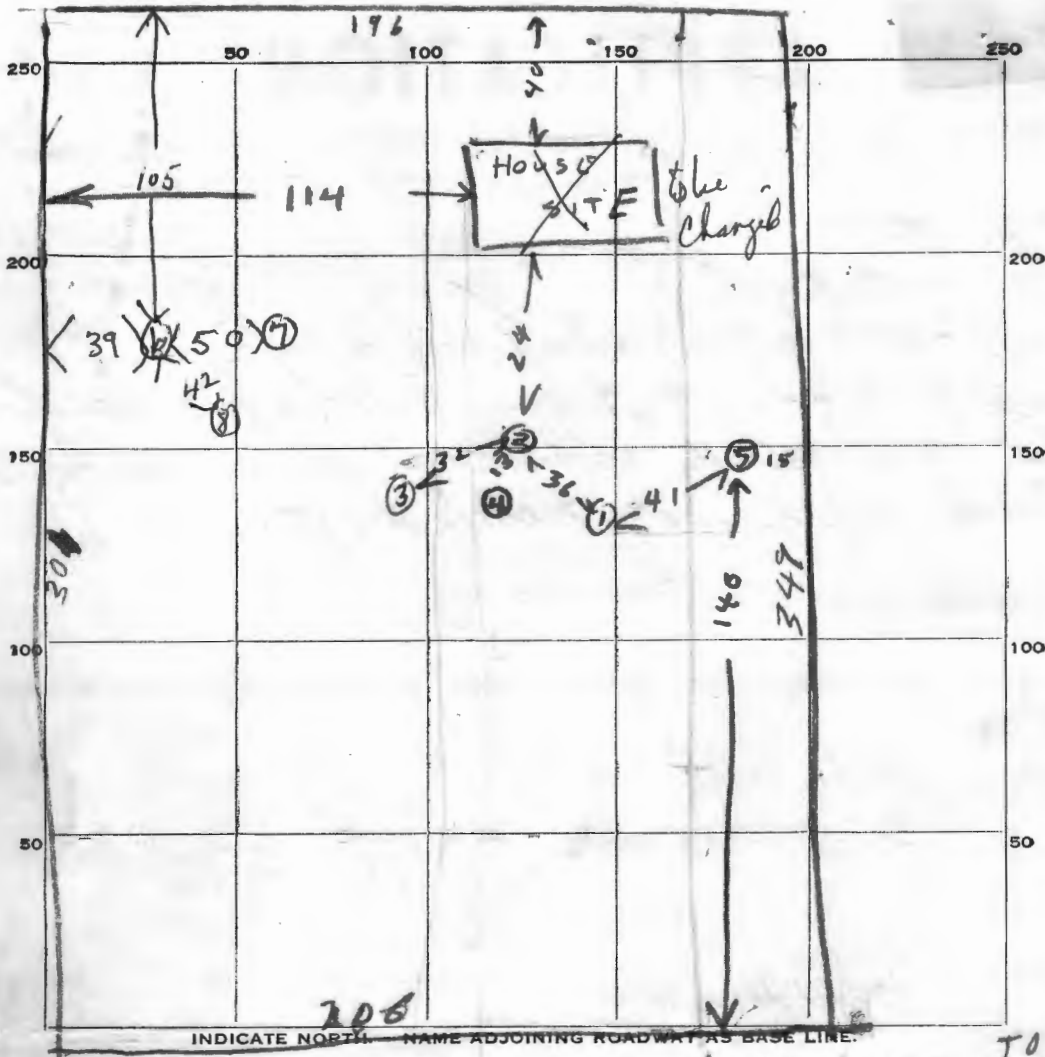

INDICATE NORTH. NAME ADJOINING ROADWAY AS BASE LINE.

NICHOLS AVENUE

TO BRISTON DAM RD.

DATE	TEST NO.	DEPTH	PRE-WET		TEST - 1" DROP		TIME
			START	STOP	START	STOP	
8 May 62	1	3	115	136	136	213	37 min
" "	2	3	118	225	1st inch	1st inch	17 min
Field Out	3	3	121	123	123	126	23
" "	4	8	Water in post hole (Could not tell if rain or spring)				
" "	5	3	154	245	little pore		
5-15-62	6	3	110	134	134	206	32 min
↓	7	3	115	117	117	123	6 min
↓	8	3	120	127	127	145	18 min

19 min

ALSO PRESENT

~~SOIL ALICER FINDING~~

8 May 62 O.W. Smith - 5-15-62

TESTED BY

9 Jan 61 B.H. 8 May 62 Raymond Hodger

REMARKS

2nd hole under ground water at 2 to 3 ft on front of lot

ALSO PRESENT

9 Jan 61 O.W. Smith

LOT NO.

Fill out in triplicate.
Make fee of \$15.00 payable to:
HOWARD COUNTY HEALTH DEPT. SANITATION
Fill out only checked blanks.

APPLICATION

A _____
P _____

SEWAGE DISPOSAL TESTING

MARYLAND STATE DEPARTMENT OF HEALTH

HOWARD COUNTY

ELLICOTT CITY

✓ DISTRICT 5th

DATE _____

BUCKNER ENTERPRISES
919 - 11th Street, N. W.
Washington 1, D. C.
Phone 347-3299

TO: THE COUNTY HEALTH OFFICER
ELLICOTT CITY, MARYLAND

I, HEREBY, APPLY FOR THE NECESSARY TESTS IN ORDER TO CONSTRUCT (OR RECONSTRUCT) A SEWAGE DISPOSAL SYSTEM.

✓ PROPERTY OWNER Woodward ~~Woodrow~~ JONES

✓ ADDRESS 32 W. DIAMOND AVE ✓ PHONE WA 6-1296
GAITHERSBURG Md

PROPERTY LOCATION:

✓ SUBDIVISION X ✓ LOT NO. X

✓ ROAD AND DESCRIPTION Nichols Drive, NEAR Interx Brighton
Dam Rd (See map on back) Nichols Dr is graded dirt
See Inclosure Letter

OCCUPANT _____ PHONE _____

PERSON TO CONSTRUCT SYSTEM _____

ADDRESS _____ PHONE _____

✓ SIZE OF LOT 1 1/2 Ac Approx ✓ TYPE BLDG. 3
NUMBER OF BEDROOMS

IF NOT SINGLE RESIDENCE DESCRIBE _____

✓ SIGNATURE OF APPLICANT Oliver W. Smith (agent) 2745 So. Vhle st Arl, Va
OT 46353

APPROVED BY _____ FOR _____ (KIND OF SYSTEM) DATE _____

REJECTED BY _____ FOR _____ (KIND OF SYSTEM) DATE _____

HOLD PENDING FURTHER TESTS _____ DATE _____

REASONS FOR REJECTION OR HOLDING _____

THIS IS NOT A PERMIT

APPLICATION

SEWAGE DISPOSAL TESTING

A _____

P _____

MARYLAND STATE DEPARTMENT OF HEALTH

HOWARD COUNTY

ELLICOTT CITY

DISTRICT 5th

DATE _____

BUCKNER ENTERPRISES
919 - 11th Street, N. W.
Washington 1, D. C.
Phone 347-3299

TO: THE COUNTY HEALTH OFFICER
ELLICOTT CITY, MARYLAND

I, HEREBY, APPLY FOR THE NECESSARY TESTS IN ORDER TO CONSTRUCT (OR RECONSTRUCT) A SEWAGE DISPOSAL SYSTEM.

PROPERTY OWNER WOODROW JONES

ADDRESS 32 W DIAMOND AVE PHONE WA 6-1296
GAITHERSBURG MD

PROPERTY LOCATION:

SUBDIVISION _____ LOT NO. _____

ROAD AND DESCRIPTION Nichols Drive, Near Intx Brighten Dam
Rd. Nichols Dr is graded dirt

OCCUPANT _____ PHONE _____

PERSON TO CONSTRUCT SYSTEM _____

ADDRESS _____ PHONE _____

SIZE OF LOT 1 1/2 Ac Approx TYPE BLDG. 3
NUMBER OF BEDROOMS

IF NOT SINGLE RESIDENCE DESCRIBE _____

SIGNATURE OF APPLICANT Oliver W. Smith (agent) 2745 So Vhle st Arl, Va
OT46353

APPROVED BY _____ FOR _____ DATE _____
(KIND OF SYSTEM)

REJECTED BY _____ FOR _____ DATE _____
(KIND OF SYSTEM)

HOLD PENDING FURTHER TESTS _____ DATE _____

REASONS FOR REJECTION OR HOLDING _____

THIS IS NOT A PERMIT

APPLICATION

SEWAGE DISPOSAL TESTING

MARYLAND STATE DEPARTMENT OF HEALTH

HOWARD COUNTY

ELLICOTT CITY

DISTRICT 5th

DATE _____

BUCKNER ENTERPRISES
919 - 11th Street, N. W.
Washington 1, D. C.
Phone 347-3299

TO: THE COUNTY HEALTH OFFICER
ELLICOTT CITY, MARYLAND

I, HEREBY, APPLY FOR THE NECESSARY TESTS IN ORDER TO CONSTRUCT (OR RECONSTRUCT) A SEWAGE DISPOSAL SYSTEM.

PROPERTY OWNER Woodrow Jones

ADDRESS 32 W Diamond Ave PHONE Wa 6-1296
Gaithersburg Md

PROPERTY LOCATION:

SUBDIVISION _____ LOT NO. _____

ROAD AND DESCRIPTION Nichols Drive, Near Interx Brighton Dam Rd
Nichols Drive is graded dirt

OCCUPANT _____ PHONE _____

PERSON TO CONSTRUCT SYSTEM _____

ADDRESS _____ PHONE _____

SIZE OF LOT 1 1/2 Ac Approx TYPE BLDG. 3
NUMBER OF BEDROOMS

IF NOT SINGLE RESIDENCE DESCRIBE _____

SIGNATURE OF APPLICANT Oliver W Smith (agent) 2745 So Uhle st Arl 6 Va
ct 46353

APPROVED BY _____ FOR _____ DATE _____
(KIND OF SYSTEM)

REJECTED BY _____ FOR _____ DATE _____
(KIND OF SYSTEM)

HOLD PENDING FURTHER TESTS _____ DATE _____

REASONS FOR REJECTION OR HOLDING _____

THIS IS NOT A PERMIT